



September 2, 2022

PND Proj. No. 194022.02

Mr. Jeff Griffin
Port Manager
Port of Bandon
390 1st Street SW
Bandon, OR 97411

Re: Port of Bandon Marina Geotechnical Evaluation

Dear Mr. Griffin:

As a part of the Port of Bandon's marina redevelopment design work, PND is tasked with providing a geotechnical evaluation of the marina basin with the purpose of determining the pile size and construction methods for installing float piles to support the new marina floats.

For this evaluation, PND researched geological records, past geotechnical investigations, and queried West Coast Contractors about historic construction methods to construct the float piles within the boat basin. PND did not perform any new geotechnical investigations or geotechnical lab analysis as a part of this evaluation but rather used past data historical data to develop this evaluation.

Site Geology

The marina is located within the boat basin at the mouth of the Coquille River and sited in a region of complex of soil formations. South of the marina, much of Bandon's Old Town is sited on manmade fill. The area around the mouth of the river also contains alluvial deposits, foredune deposits, Pleistocene sedimentary rock, and a mélange of Sixes River Cretaceous and Jurassic rock outcroppings. See Attachment C for a geologic map of the region. Given the complexity of the geology in the proximity of the boat basin, an evaluation of the previous geotechnical exploration of the basin is of critical importance to determine the appropriate pile type and installation methods for the new marina.

Previous Geotechnical Investigation

In 1983, a geotechnical investigation of the boat basin was performed by HGE, Inc. The investigation included 94 water jet probes, three (3) test holes, and three (3) drilled holes. All holes were located within the extent of the existing basin. A map of the probes, drilled holes, and test holes is included in Attachment D.

The 94 water jet probes were used to infer the vertical elevation of the bedrock surface elevation at the location tested. Based on the quantity of probe locations, a bedrock contour map was developed which shows the bedrock varying from El. -4 feet to El. -14 feet within the basin.

The three test holes were used to determine the mudline elevation and overburden characteristics at the location tested. For the three test holes, the ground elevation varied from -0.4 feet to -3 feet with the overburden varying in thickness from 0 feet to more than 12.7 feet. For the two test holes with overburden present, the overburden was reported to be sand and gravel.

The drilled holes were used to determine the mudline elevation, overburden thickness and characteristics, and the bedrock surface elevation and characteristics. The overburden thickness varied from 3 to 4 feet and was reported to be sand and gravel. The bedrock elevation ranged from -2.5 to -10.6 feet and consisted of sandstone and silt stone. The maximum drilled hole depth was elevation -12.6 feet.

Past Pile Construction Methods

The HGE drawings of existing marina, provided in Attachment B, show that the pile installation depths range from El. -25.5 feet to El. -29.5 feet. West Coast Contractors provided feedback on the installation methods for the existing piles and indicated that the piles were predrilled 15 feet into bedrock. The existing piles include both 12-inch diameter timber piles and 12.75-inch diameter steel pipe piles.

In addition to the drawings and historic geotechnical data, photos of the original construction of the marina are included in Attachment D. These photos show the marina dammed and dredged in the dry prior to construction of the marina floats.

Initial Pile Size

The pile size to support the marina floats will be controlled by the water depth and the forces associated with wind, waves, current, and vessel size within the marina. Based on an initial evaluation of controlling forces, PND recommends installing 16-inch-diameter, 0.5-inch-thick steel pipe piles spaced at approximately 20 feet along the length of Float C. The recommended pile size on Float C is controlled by the wave loading on this outside float. The interior floats are subject to lower forces associated with wind and vessel impact and smaller piles may be considered. Floats A, B, D, and E may be supported by 12.75-inch-diameter, 0.5-inch-thick steel pipe piles spaced at approximately 40 feet along the floats. However, the cost of mobilizing and reconfiguring the socketing equipment for the smaller pile size may be cost prohibitive. Therefore, in the 30% design, PND has shown 16-in-diameter, 0.5-inch-thick steel piles throughout the marina.

For this initial pile size analysis, tsunami loads are not considered. Consideration of tsunami loads on the marina would significantly increase the size and cost of the piles and marina, in general.


Recommended Installation Methods

Based on the shallow bedrock encountered in the drilled test holes from the previous geotechnical investigation along with construction procedures from the original marina construction, PND recommends that all piles should be socketed a minimum of 15 feet into the bedrock. Pile

socketing into bedrock will increase construction costs over traditional pile driving. However, this method is recommended to achieve the necessary embedment to laterally-support the piles so that they can resist the applied forces from the wind, waves, and vessels to the floats.

This geotechnical evaluation has been developed to support the 30% design of the Port of Bandon marina redevelopment. Please let me know if you have any questions on this evaluation.

Sincerely,
PND Engineers, Inc.

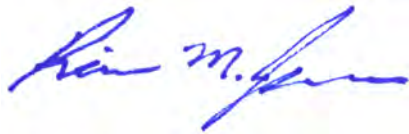


Rian M. Johnson, P.E., S.E., P.Eng.
Principal

Attachment:

- A) Port of Bandon Marina Redevelopment 30% Design Float Layout and Pile Plan
- B) Port of Bandon Coquille River Boat Basin Original Layout Drawings
- C) Geologic Map of Bandon
- D) Previous Geotechnical Data and Original Construction Photos
- E) Wind and Wave Loading on Piles

Attachment A: Port of Bandon Marina Redevelopment
30% Design Float Layout and Pile Plan

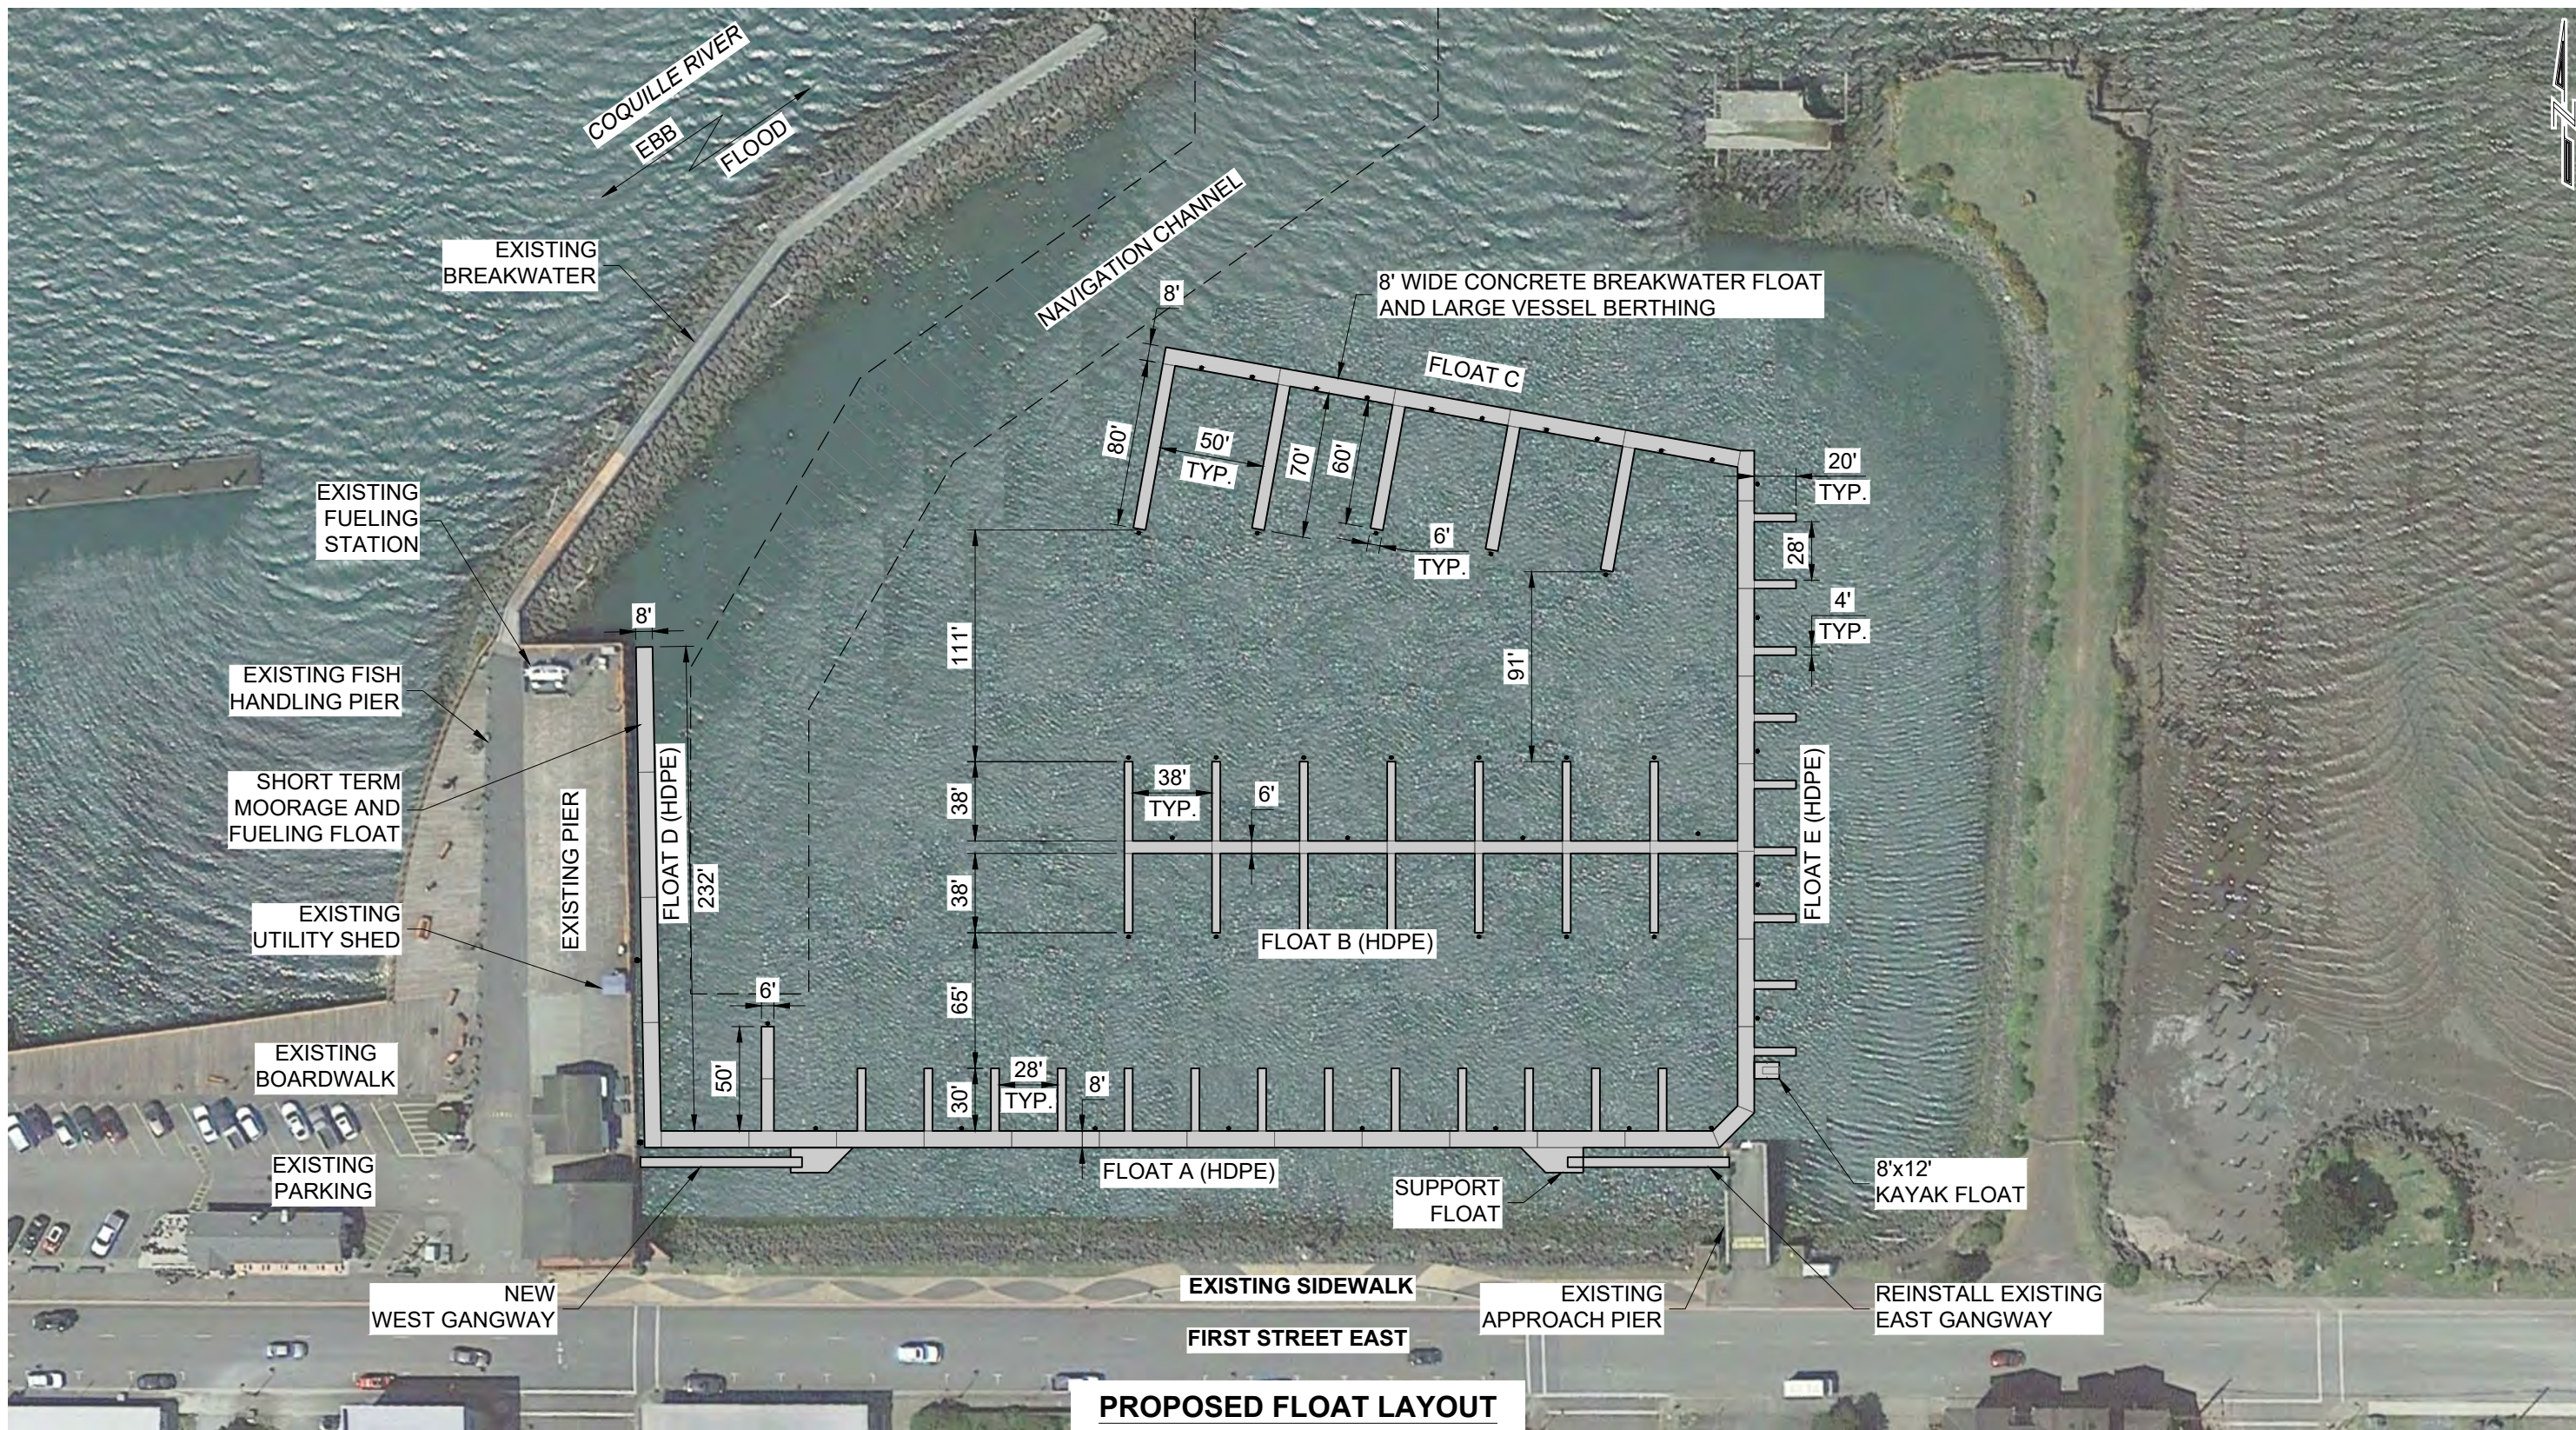

PROPOSED FLOAT LAYOUT



30% LEVEL PRELIMINARY PLANS (REV.1)

1736 Fourth Avenue S., Suite A
 Seattle, Washington 98134
 P: 206.624.1387
 www.pndengineers.com

REVISIONS		
REV	DATE	DESCRIPTION


PND ENGINEERS, INC. IS NOT RESPONSIBLE FOR SAFETY PROGRAMS, METHODS OR PROCEDURES OF OPERATION, OR THE CONSTRUCTION OF THE DESIGN SHOWN ON THESE DRAWINGS. WHERE SPECIFICATIONS ARE GENERAL OR NOT CALLED OUT, THE SPECIFICATIONS SHALL CONFORM TO STANDARDS OF INDUSTRY. DRAWINGS ARE FOR USE ON THIS PROJECT ONLY AND ARE NOT INTENDED FOR REUSE WITHOUT WRITTEN APPROVAL FROM PND. DRAWINGS ARE ALSO NOT TO BE USED IN ANY MANNER THAT WOULD CONSTITUTE A DETRIMENT DIRECTLY OR INDIRECTLY TO PND.

PROJECT:
PORT OF BANDON
BANDON MARINA REDEVELOPMENT

TITLE:
PROPOSED FLOAT LAYOUT

DESIGNED BY: CM	PROJECT NO: 194022	SHEET NO:
DRAWN BY: DM	DATE: JUNE 2020	4 OF 10
CHECKED BY: RJ	SCALE: NOTED	


6420 - DREW - UPDSEAF5019DRAWINGS/2019/194022 - BANDON MARINA/30% DESIGN REV 1194022 - BANDON MARINA.DWG

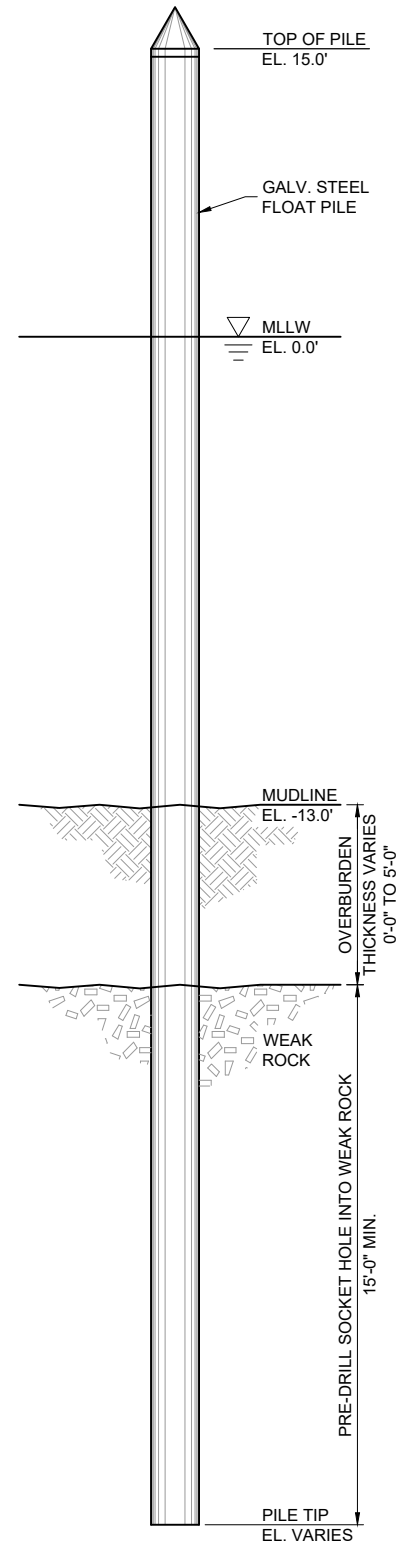

TYPICAL FLOAT PILE

PILE SCHEDULE			
FLOAT	PILE SIZE	THICKNESS	PILE COUNT
A	16"Ø	0.500"	9
B	16"Ø	0.500"	18
C	16"Ø	0.500"	15
D	16"Ø	0.500"	2
E	16"Ø	0.500"	5
TOTAL	--	--	49

30% LEVEL PRELIMINARY PLANS (REV.1)

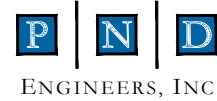

1736 Fourth Avenue S., Suite A
 Seattle, Washington 98134
 P: 206.624.1387
 www.pndengineers.com

REVISIONS		
REV	DATE	DESCRIPTION

PROJECT: **PORT OF BANDON
BANDON MARINA REDEVELOPMENT**

TITLE: **PILE DETAILS**

PND ENGINEERS, INC. IS NOT RESPONSIBLE FOR SAFETY PROGRAMS, METHODS OR PROCEDURES OF OPERATION, OR THE CONSTRUCTION OF THE DESIGN SHOWN ON THESE DRAWINGS. WHERE SPECIFICATIONS ARE GENERAL OR NOT CALLED OUT, THE SPECIFICATIONS SHALL CONFORM TO STANDARDS OF INDUSTRY. DRAWINGS ARE FOR USE ON THIS PROJECT ONLY AND ARE NOT INTENDED FOR REUSE WITHOUT WRITTEN APPROVAL FROM PND. DRAWINGS ARE ALSO NOT TO BE USED IN ANY MANNER THAT WOULD CONSTITUTE A DETRIMENT DIRECTLY OR INDIRECTLY TO PND.

DESIGNED BY: CM	PROJECT NO: 194022	SHEET NO:
DRAWN BY: DM	DATE: JUNE 2020	5 OF 10
CHECKED BY: RJ	SCALE: NOTED	


6/4/20 - DREW - UPDATES/REVISED DRAWINGS/2019/194022 - BANDON MARINA/30% DESIGN REV 1194022 - BANDON MARINA DWG

Attachment B: Port of Bandon Coquille River Boat Basin
Original Layout Drawings


PORT OF BANDON

COQUILLE RIVER BOAT BASIN DEVELOPMENT

COOS COUNTY, OREGON

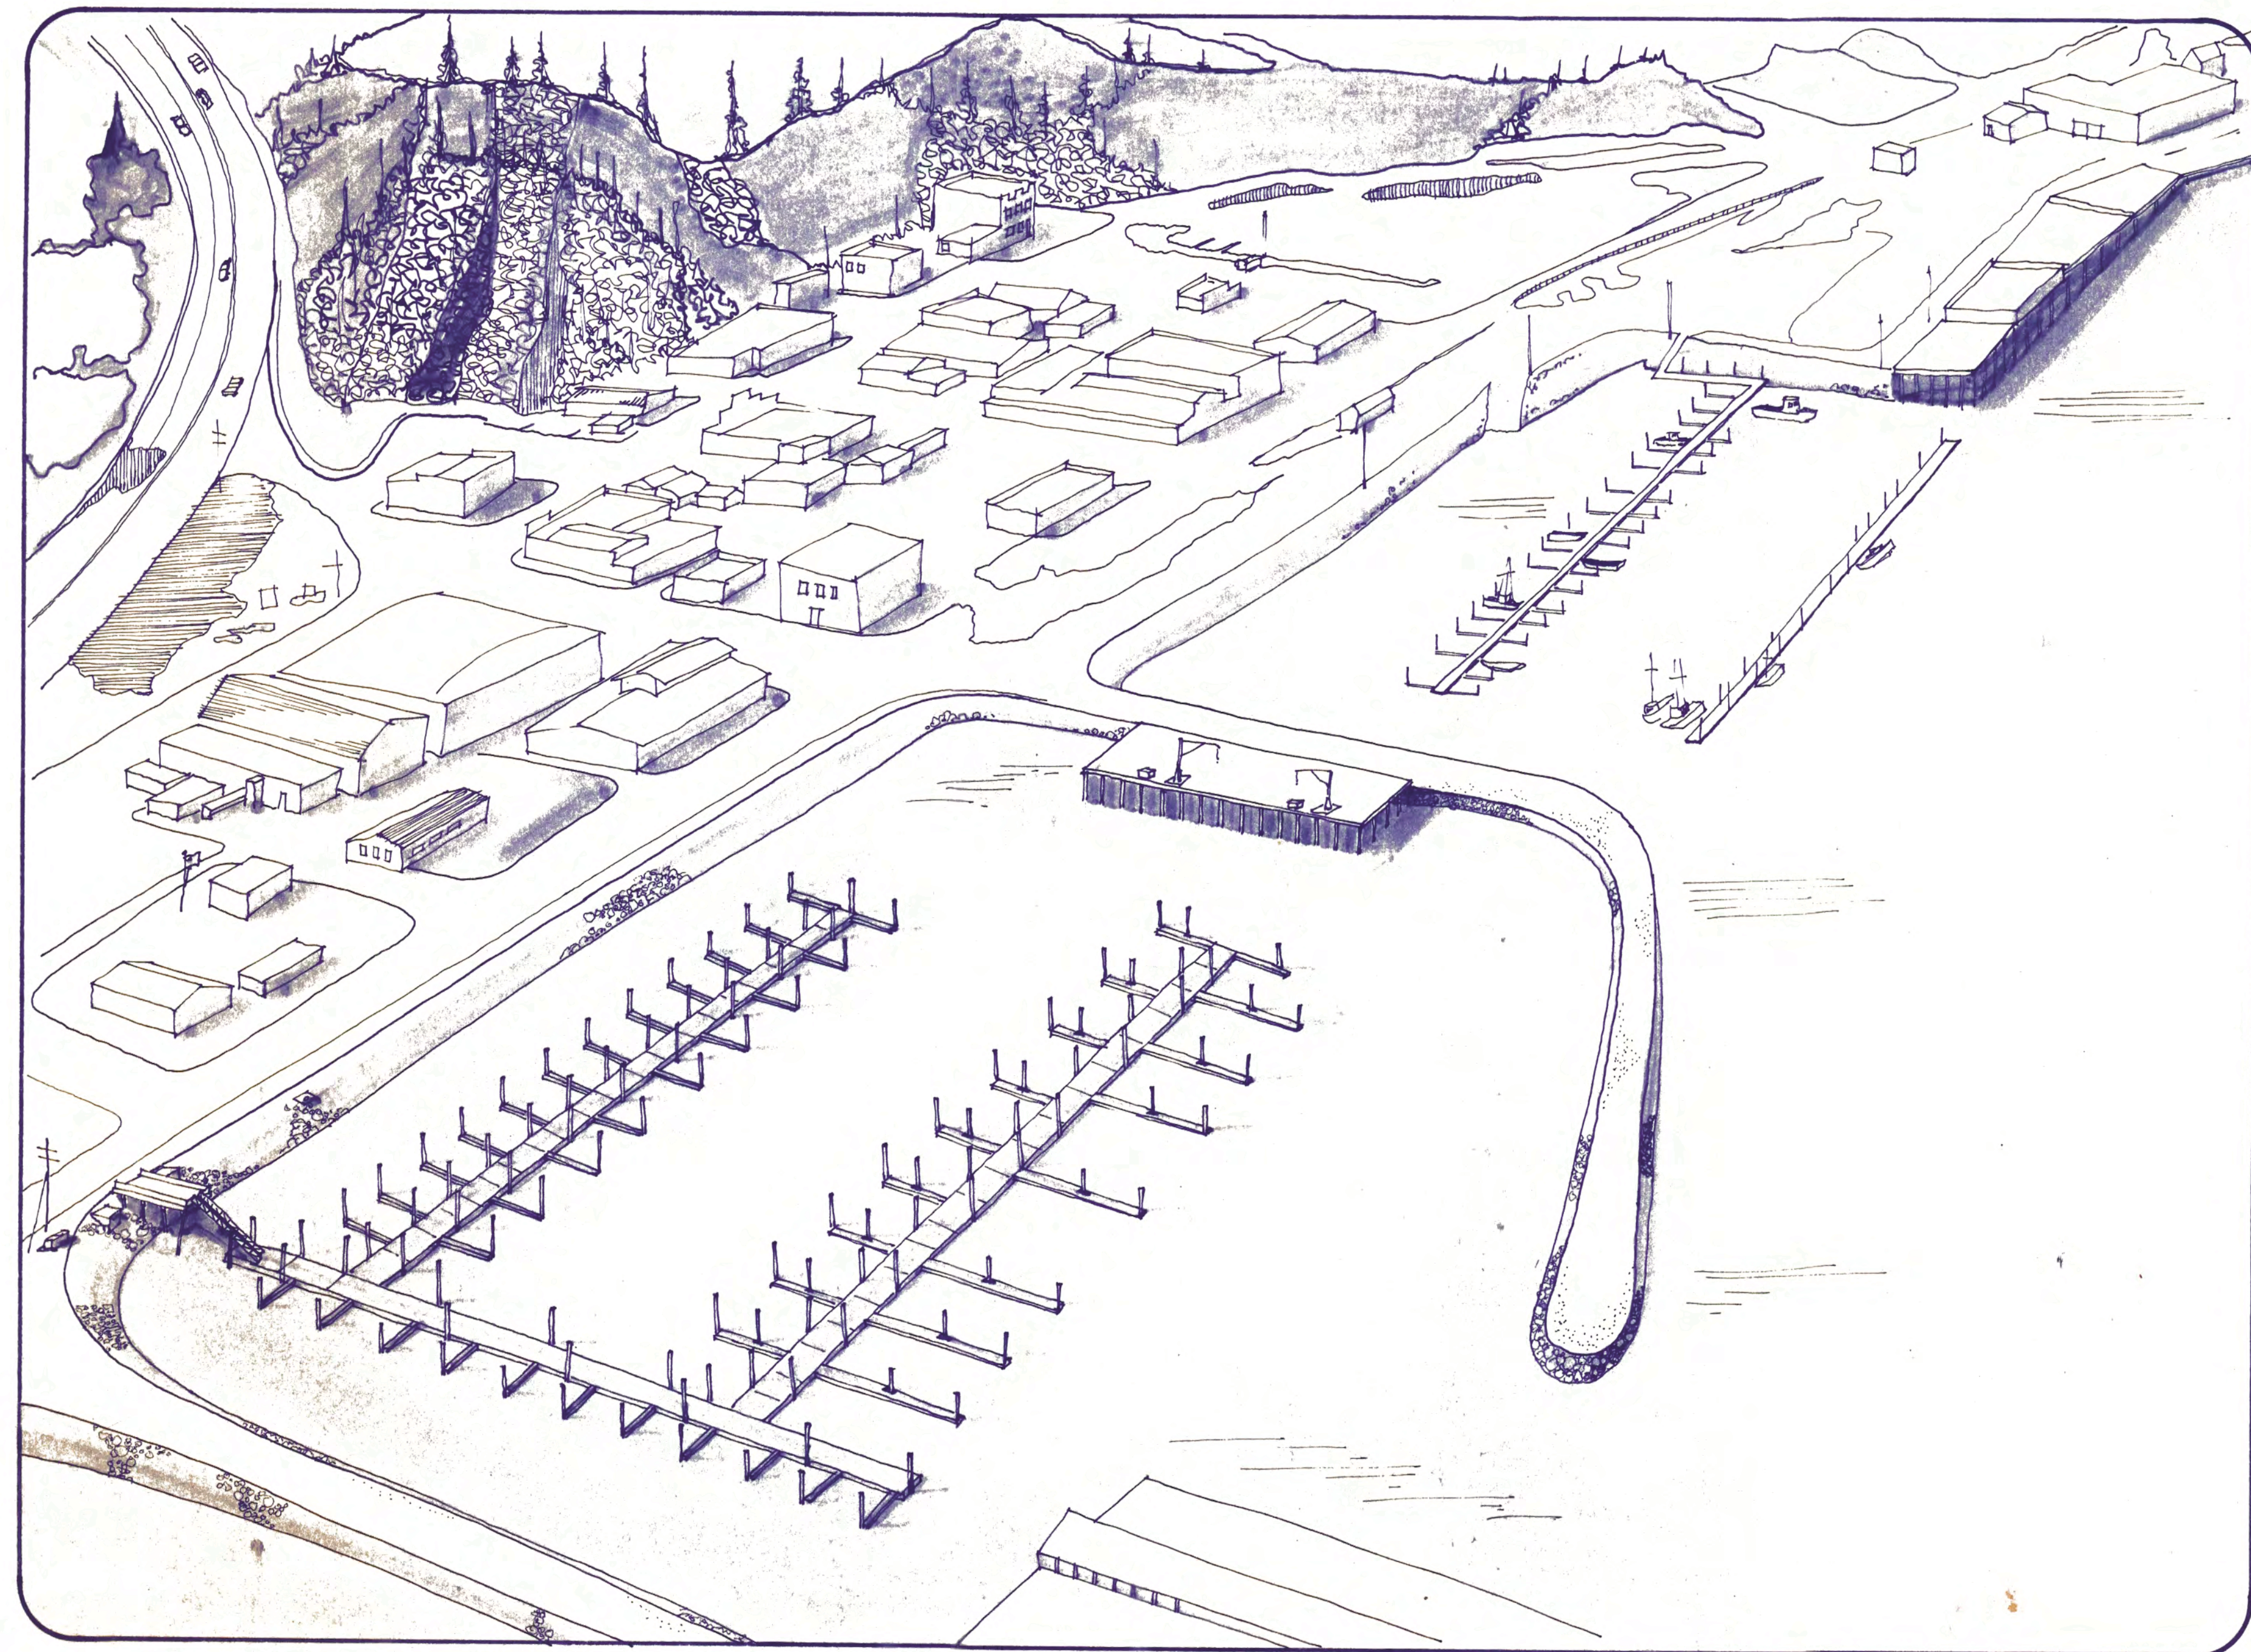

LOCATION MAP

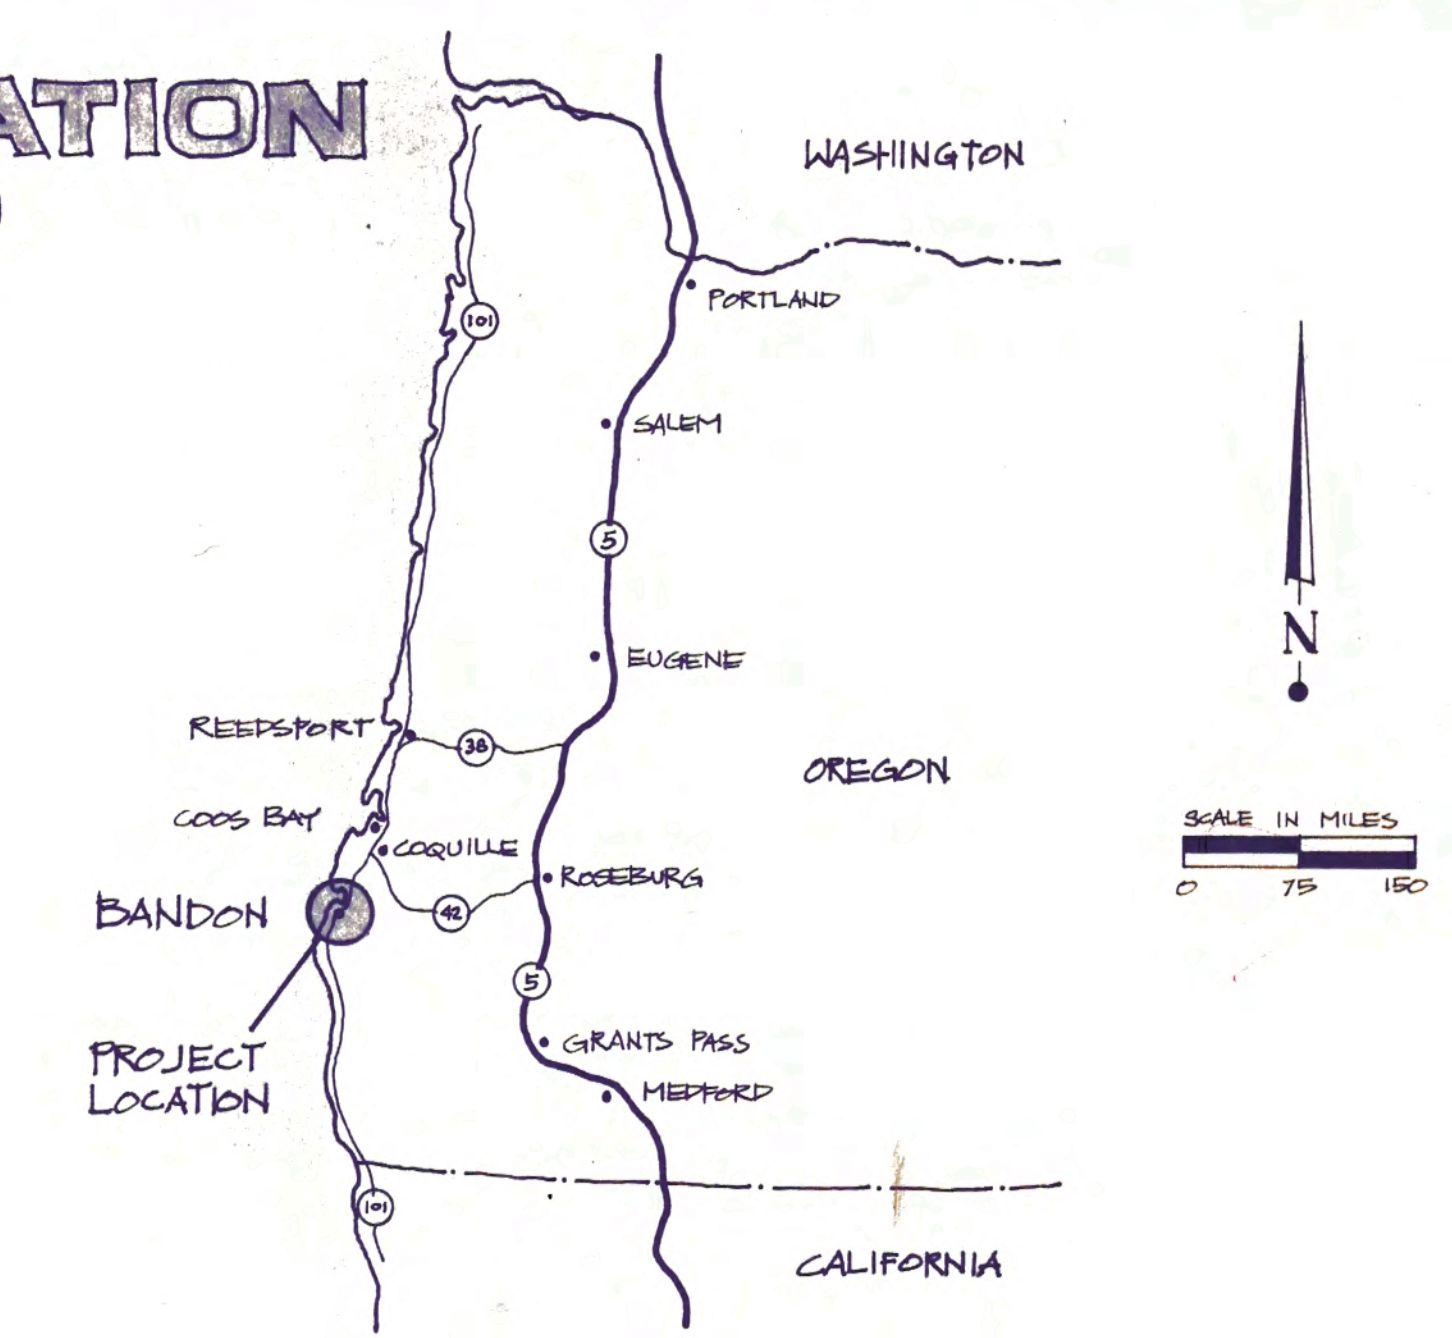

JULY, 1982

PROJECT NO. 2071

EDA PROJECT NO. 07-01-02549

SHEET INDEX

- 1 — CONTOUR AND DEMOLITION PLANS
 - 2 — SITE PLAN
 - 3 — SPOILS SITE PLAN
 - 4 — SECTIONS
 - 5 — PILING PLAN
 - 6 — DOCK PLAN
 - 7 — ACCESS DOCK
 - 8 — FISH HANDLING DOCK
 - 9 — WASTE OIL TANK
 - 10 — FLOATS
 - 11 — FLOATS
 - 12 — FLOATS
 - 13 — FLOATS
 - 14 — HINGE DETAILS
 - 15 — DETAILS
 - 16 — DETAILS
 - 17 — GANGWAY PLAN
 - 18 — GANGWAY DETAILS
 - M1 — MECHANICAL SITE PLAN
 - M2 — WATERLINE DETAILS
 - M3 — MECHANICAL DETAILS
 - E1 — ELECTRICAL SITE PLAN
 - E2 — ELECTRICAL DETAILS
 - E3 — ELECTRICAL DETAILS
- 8A — FISH HANDLING DOCK EXTENSION

PRELIMINARY




RECORD DRAWING 1/83 R.V.

SHEET NO. OF PROJECT DATE SHEET TITLE

HCE INC./ENGINEERS & PLANNERS
Coos Bay, Oregon / 375 Park Avenue 97420 / (503) 269-1166
Portland, Oregon / 19 N. W. 5th Ave. 97209 / (503) 222-1887
Albany, Oregon / 300 Ellsworth St. So. 97321 / (503) 926-0064



WATER JET PROBE RESULTS									
PROBE #	REFUSAL ELEV.	PROBE #	REFUSAL ELEV.	PROBE #	REFUSAL ELEV.	PROBE #	REFUSAL ELEV.	PROBE #	REFUSAL ELEV.
P.1	-8.3	P.16	-9.2	P.31	-5.6	P.46	-4.6	P.68	-9.7
P.2	-11.8	P.17	-11.0	P.32	-0.7	P.47	-11.5	P.69	-12.3
P.3	-7.2	P.18	-9.7	P.33	-1.8	P.48	-2.6	P.70	-15.7
P.4	-15.7	P.19	-9.6	P.34	-3.0	P.49	-1.5	P.71	-3.7
P.5	-15.7	P.20	-9.4	P.35	-4.0	P.50	-1.0	P.72	-15.3
P.6	-1.6	P.21	-9.1	P.36	-9.5	P.51	-0.4	P.73	-12.8
P.7	-4.5	P.22	-10.1	P.37	-9.5	P.52	-2.0	P.74	-5.6
P.8	-2.5	P.23	-11.0	P.38	-4.3	P.53	-1.8	P.81	-4.9
P.9	-2.4	P.24	-8.8	P.39	-11.1	P.54	-1.6	P.91	-4.3
P.10	-2.3	P.25	-10.7	P.40	-11.0	P.55	-1.6	P.92	-9.7
P.11	-4.3	P.26	-1.7	P.41	-12.0	P.56	-1.0	P.93	-4.6
P.12	-4.3	P.27	-1.7	P.42	-6.8	P.57	-0.9	P.94	-4.9
P.13	-0.3	P.28	-8.7	P.43	-10.7	P.58	-1.5		
P.14	-2.2	P.29	-7.7	P.44	-11.7	P.59	-1.5		
P.15	-4.2	P.30	-6.6	P.45	-3.6	P.62	-4.0		

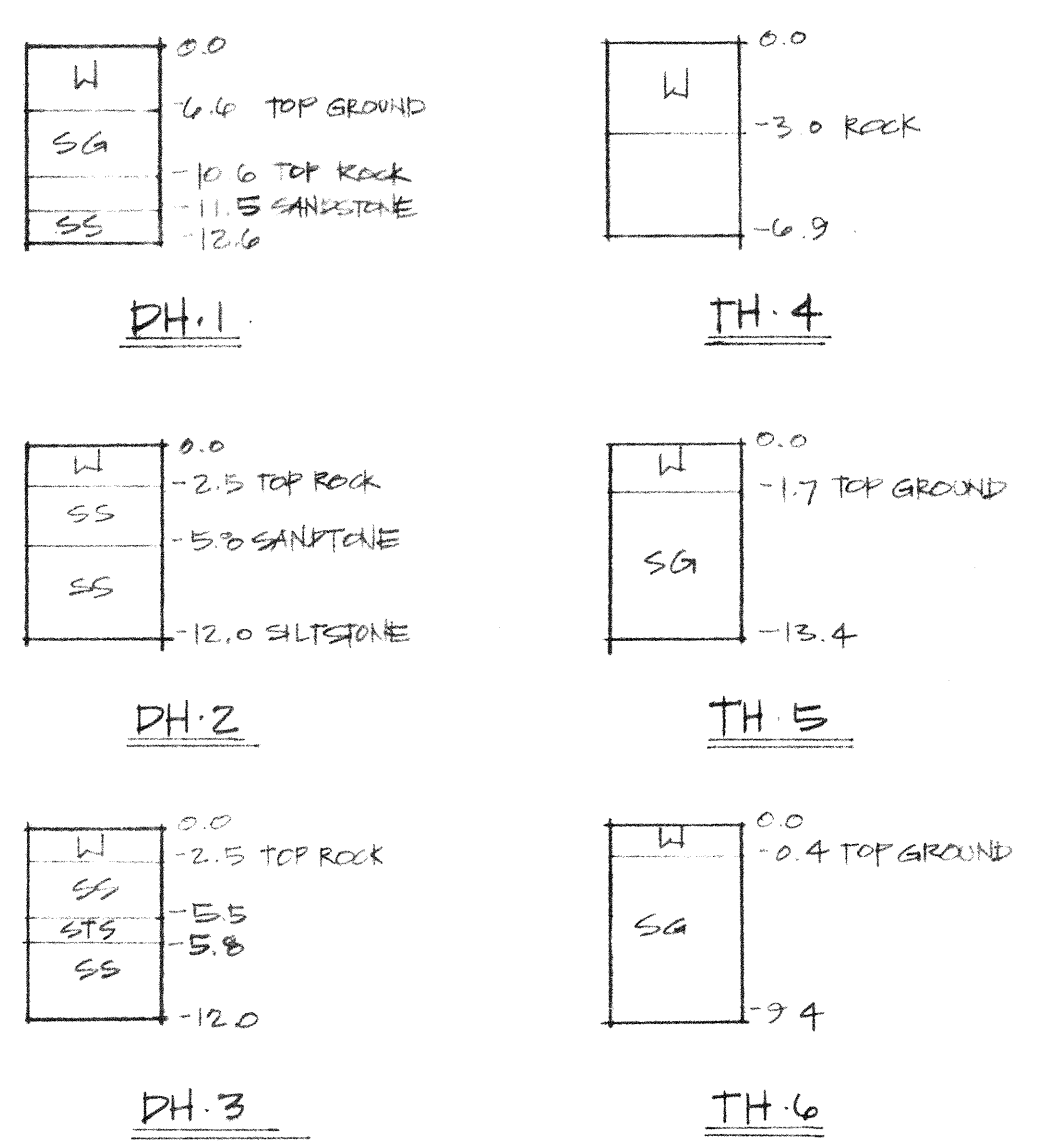

LEGEND


- EXISTING ELEVATION
- TOP OF RIP RAP SLOPE
- A.C. PAVEMENT
- EXISTING CONTOUR LINE W/ELEV.
- EXIST. TOP OF BANK
- EXIST. TOE OF BANK
- EXIST. EDGE OF GRAVEL

CORE DRILLING ABBREVIATIONS


- W - WATER
- SS - SANDSTONE
- STS - SILTSTONE
- SG - SAND AND GRAVEL

NOTES:


- INFERRED SANDSTONE/SILTSTONE ROCK CONTOURS FROM GEO. RECON INTERNATIONAL LTD'S GEO-PHYSICAL SURVEY.
- INFERRED SANDSTONE/SILTSTONE ROCK CONTOURS BASED ON GEOM. REFRACTION SURVEY RESULTS.
- ELEVATIONS SHOWN ARE MEAN LOWER LOW WATER (MLLW) DATUM.
- EXISTING ELEVATIONS AND SURFACE CONTOURS BASED ON SURVEYS OF AUGUST 11, 1980
- CORE DRILLING AND TRIGON DRILLING LOGS AND PROBE RESULTS, P.1 THRU P.59 FROM US. ARMY CORP OF ENGINEERS' SURVEYS OF JUNE 1978.
- PROBE RESULTS P.60 THRU P.101, FROM US. ARMY CORP OF ENGINEERS' SURVEYS OF FEBRUARY, 1982.
- BEARING - LAMBERT PROJECTION OF OREGON, SOUTH ZONE

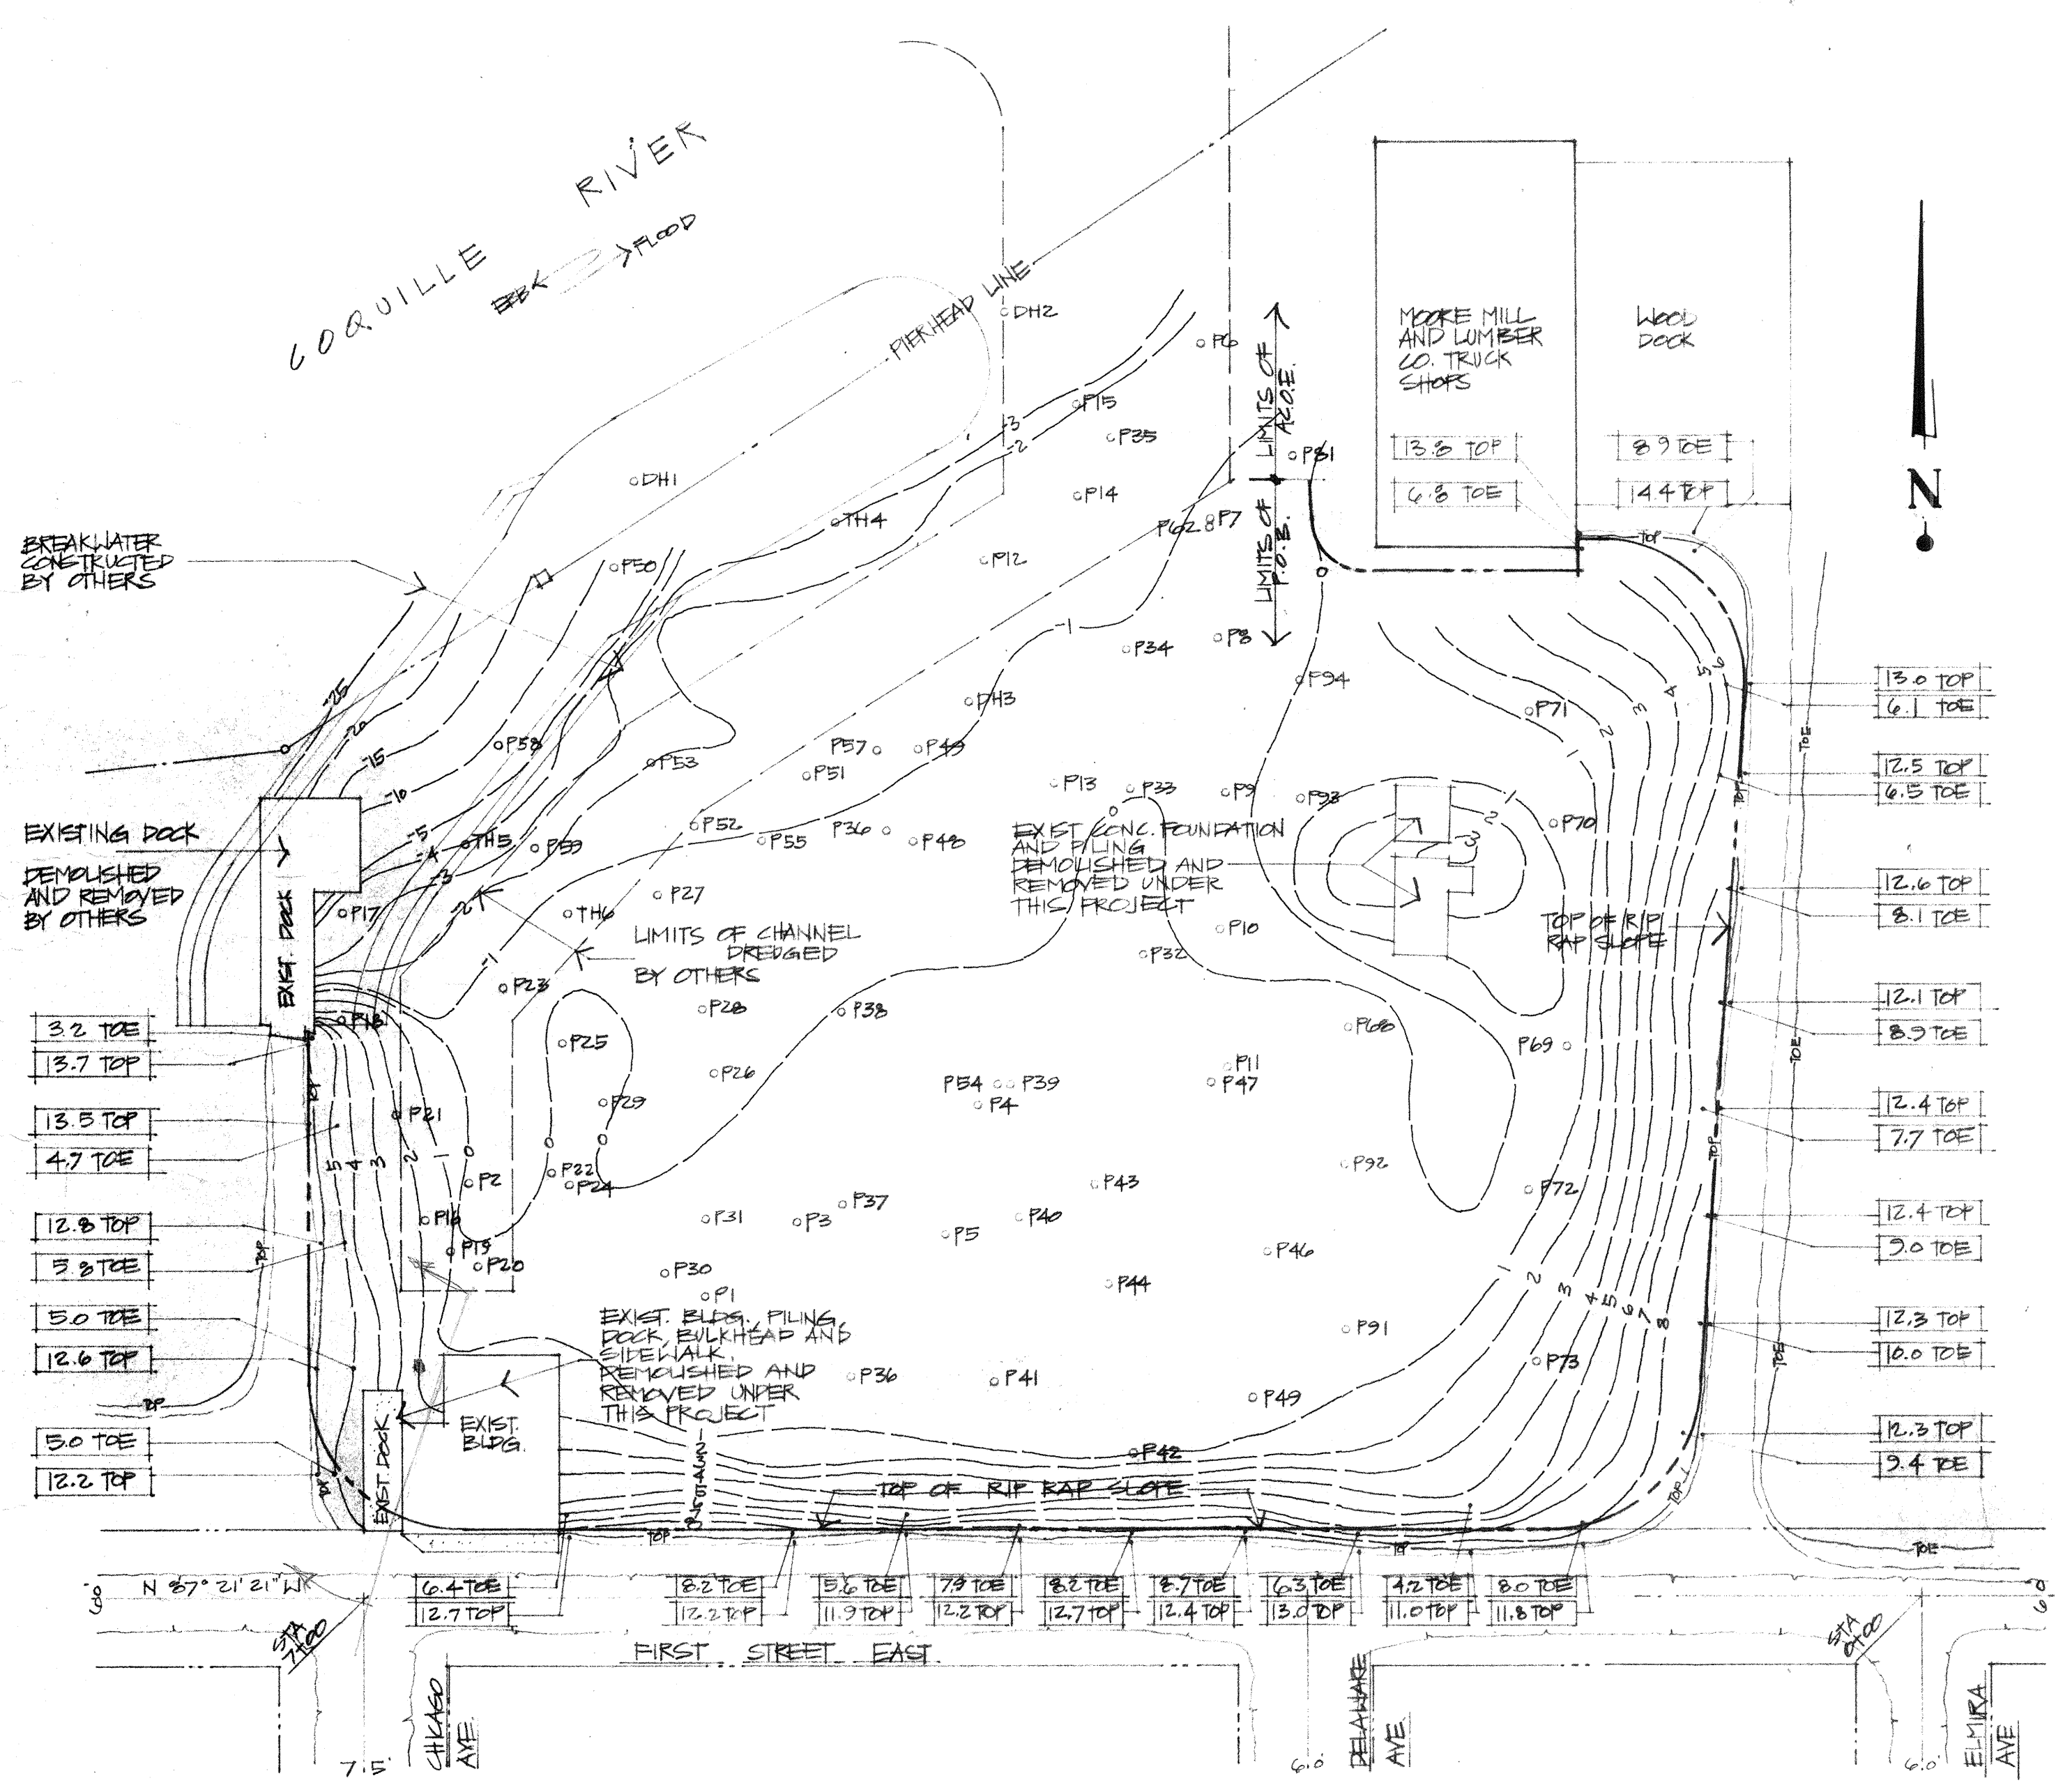

SURFACE CONTOURS AND DEMOLITION PLAN
1" = 60'

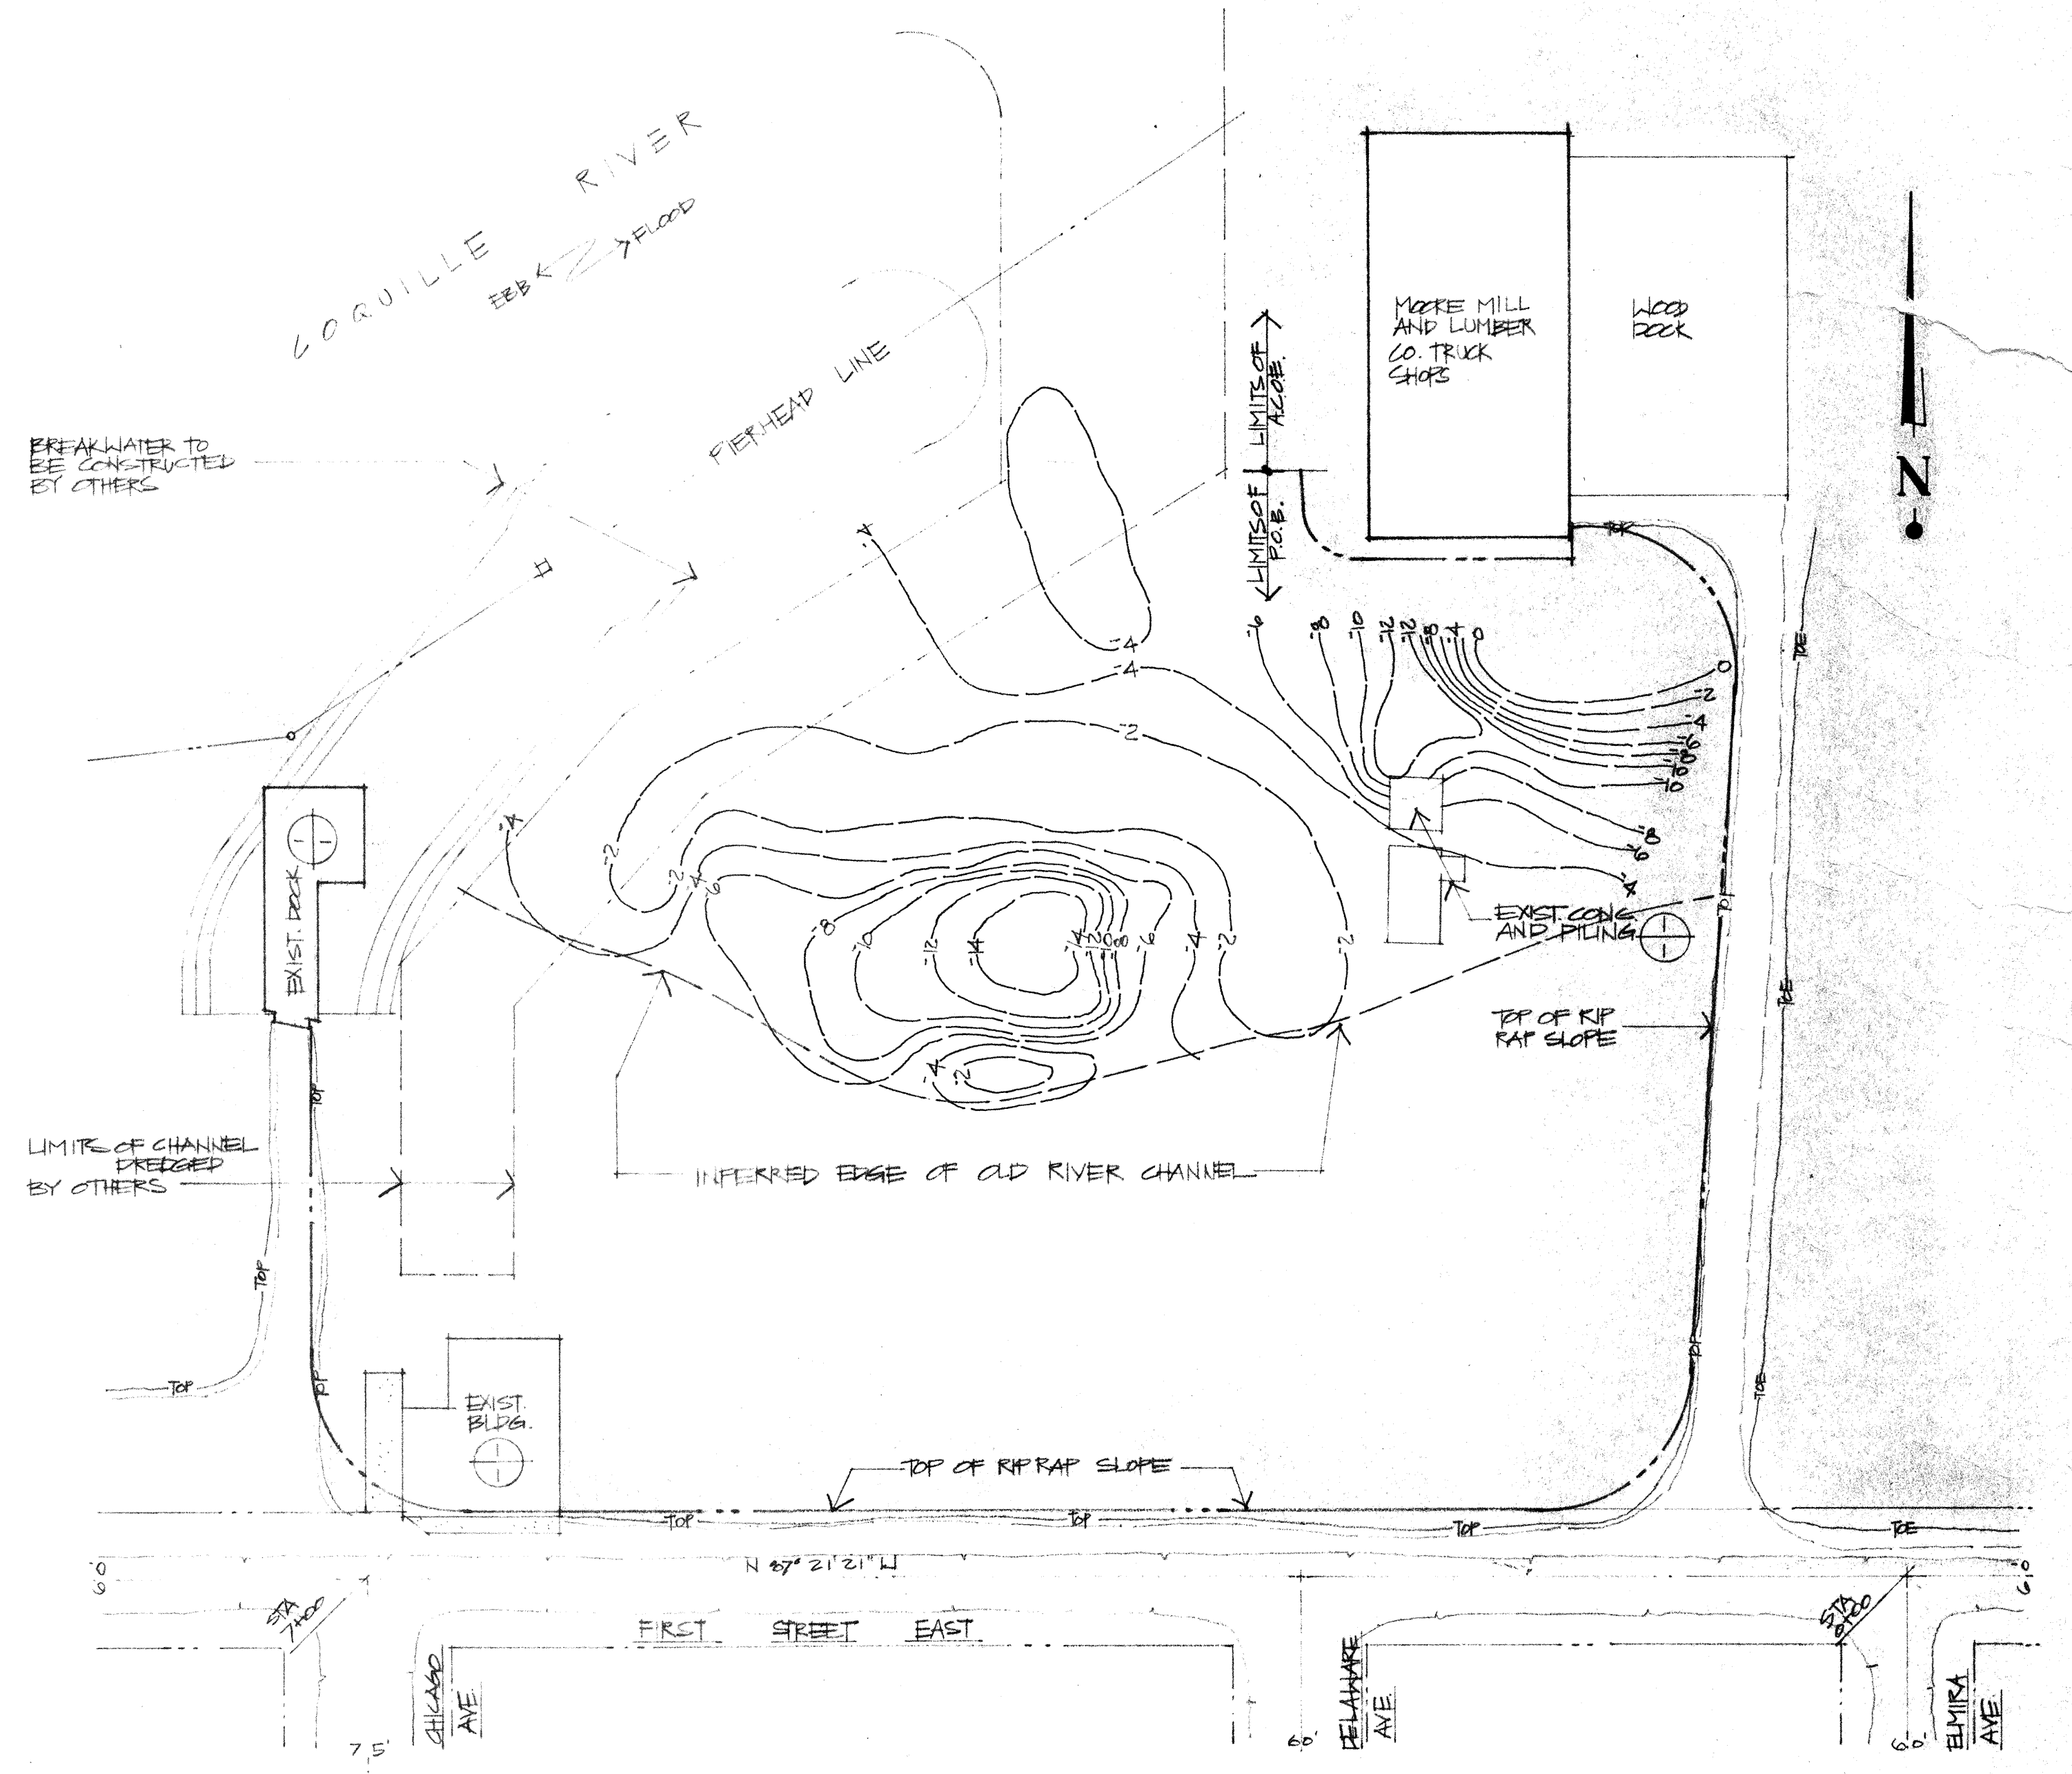


INFERRED ROCK CONTOURS
1" = 60'

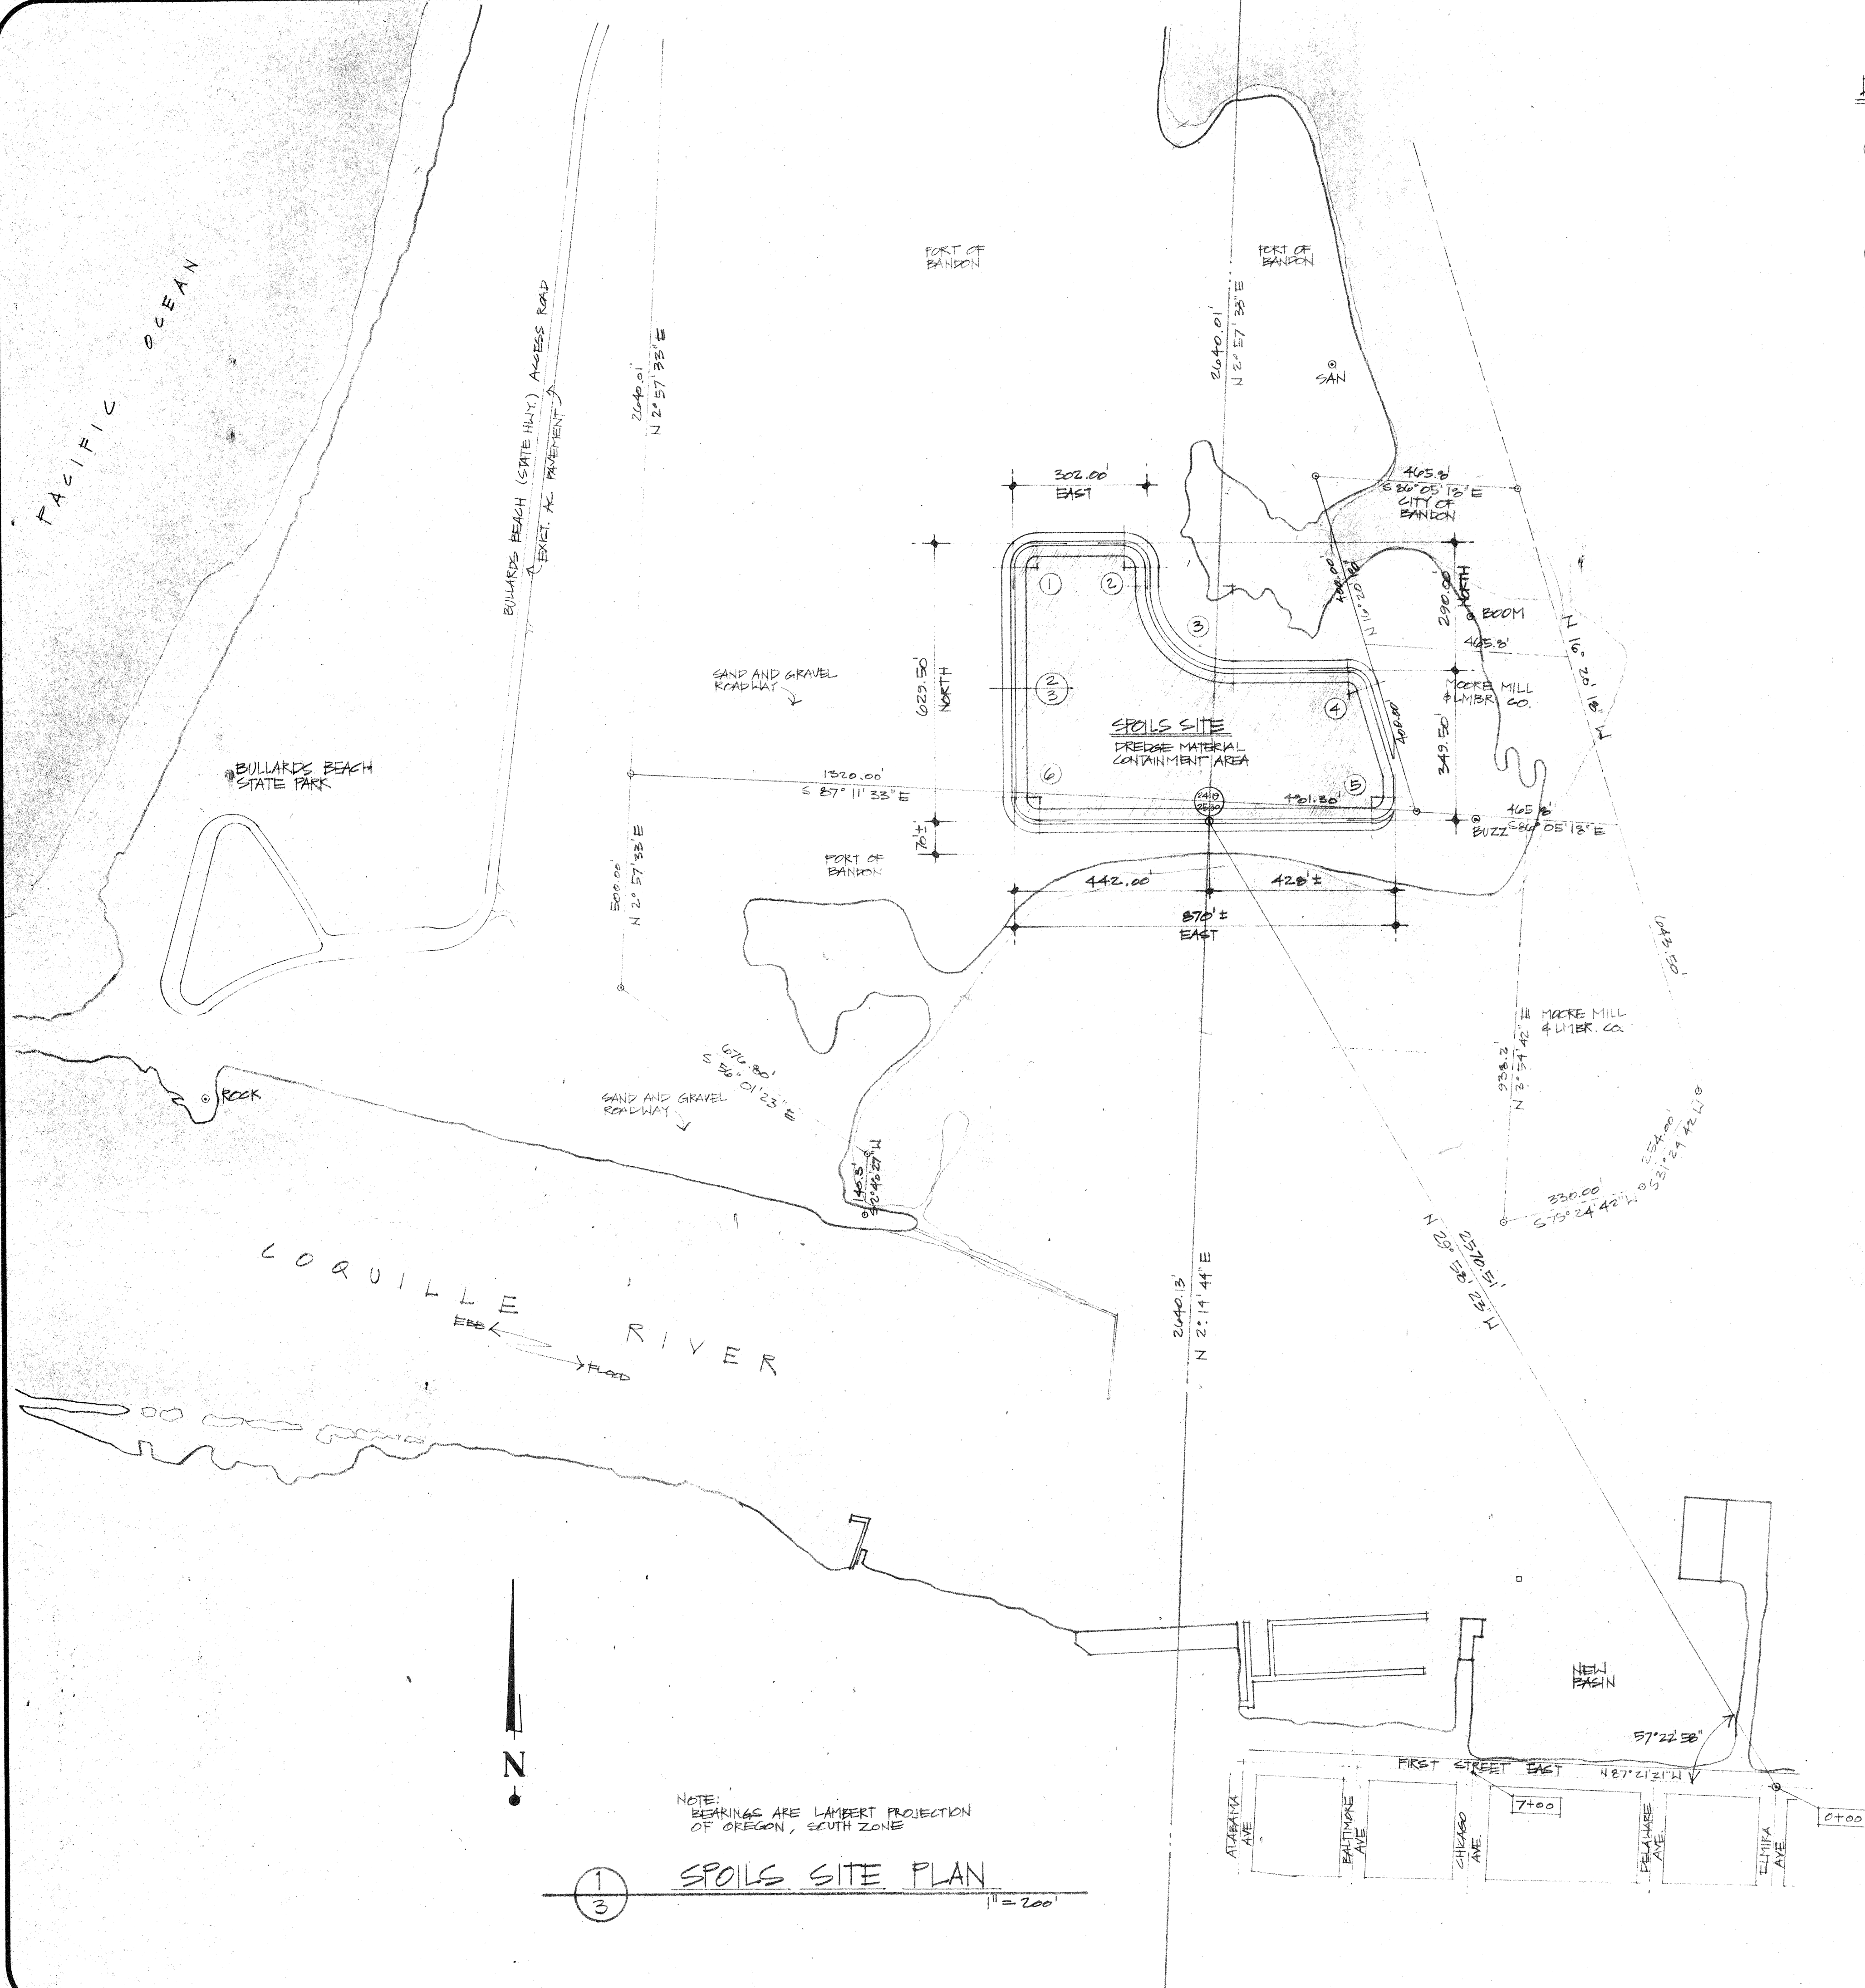

DIKE & CURVE DATA:
(SEE SECTION BELOW)

- | | | |
|--|---|--|
| ① $\Delta = 90^{\circ}00'00''$
R = 50.00'
T = 50.00'
L = 78.54' | ③ $\Delta = 90^{\circ}00'00''$
R = 200.00'
T = 200.00'
L = 314.16' | ⑤ $\Delta = 90^{\circ}00'00''$
R = 50.00'
T = 50.00'
L = 78.54' |
| ② $\Delta = 90^{\circ}00'00''$
R = 50.00'
T = 50.00'
L = 78.54' | ④ $\Delta = 73^{\circ}37'42''$
R = 50.00'
T = 37.45'
L = 64.28' | ⑥ $\Delta = 90^{\circ}00'00''$
R = 50.00'
T = 50.00'
L = 78.54' |

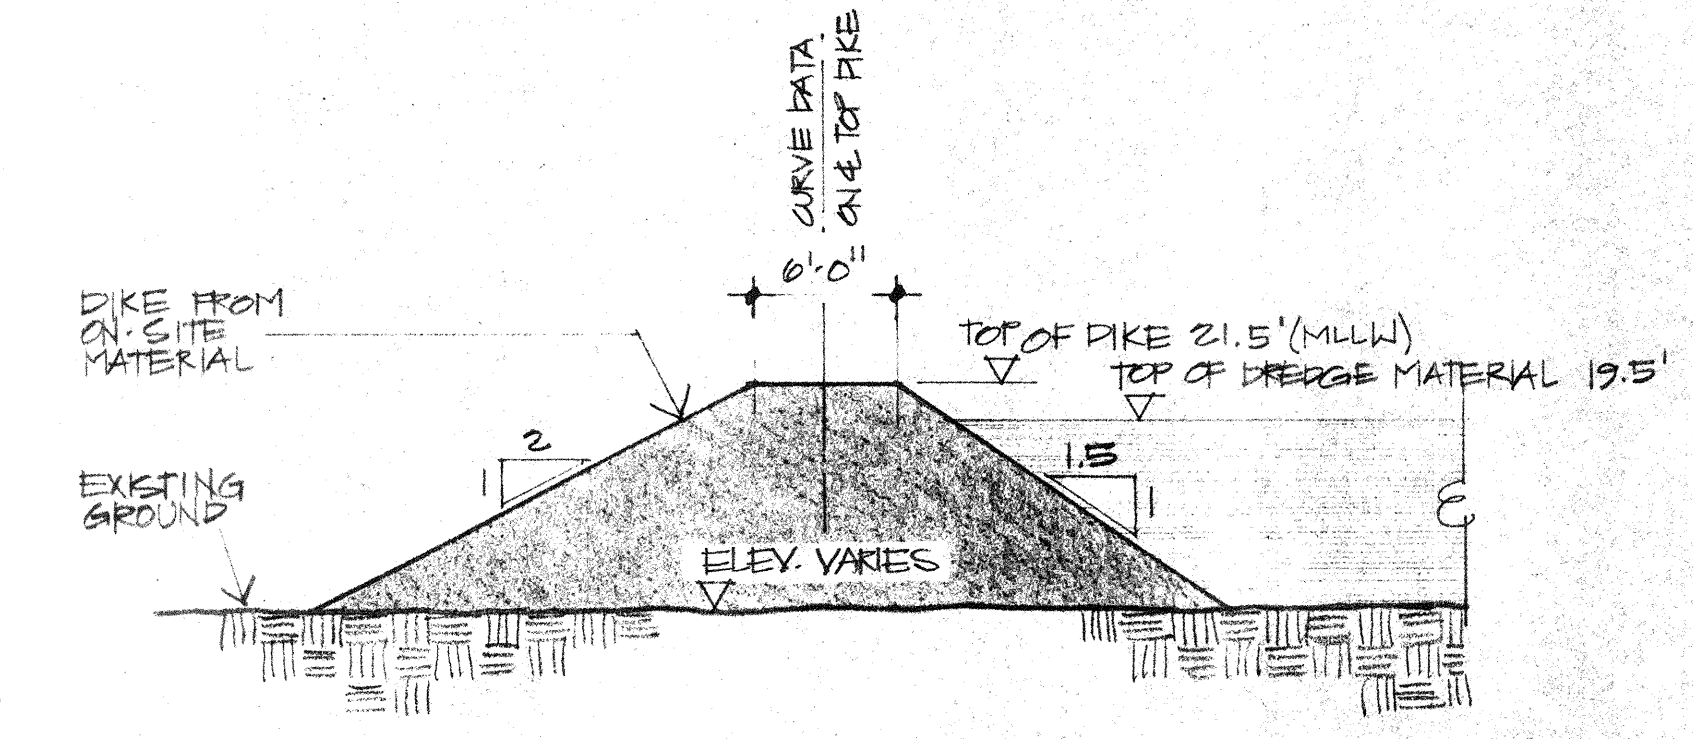

SECTION @ DIKE
1/8" = 1'-0"

NOTE: DIKES CONSTRUCTED BUT,
SPOILS SITE NOT UTILIZED


NOTE: BEARINGS ARE LAMBERT PROJECTION
OF OREGON, SOUTH ZONE

1
3
SPOILS SITE PLAN
1" = 200'


RECORD DRAWG. 1/83 E.K.

EDA PROJECT NO. 07-01-02549




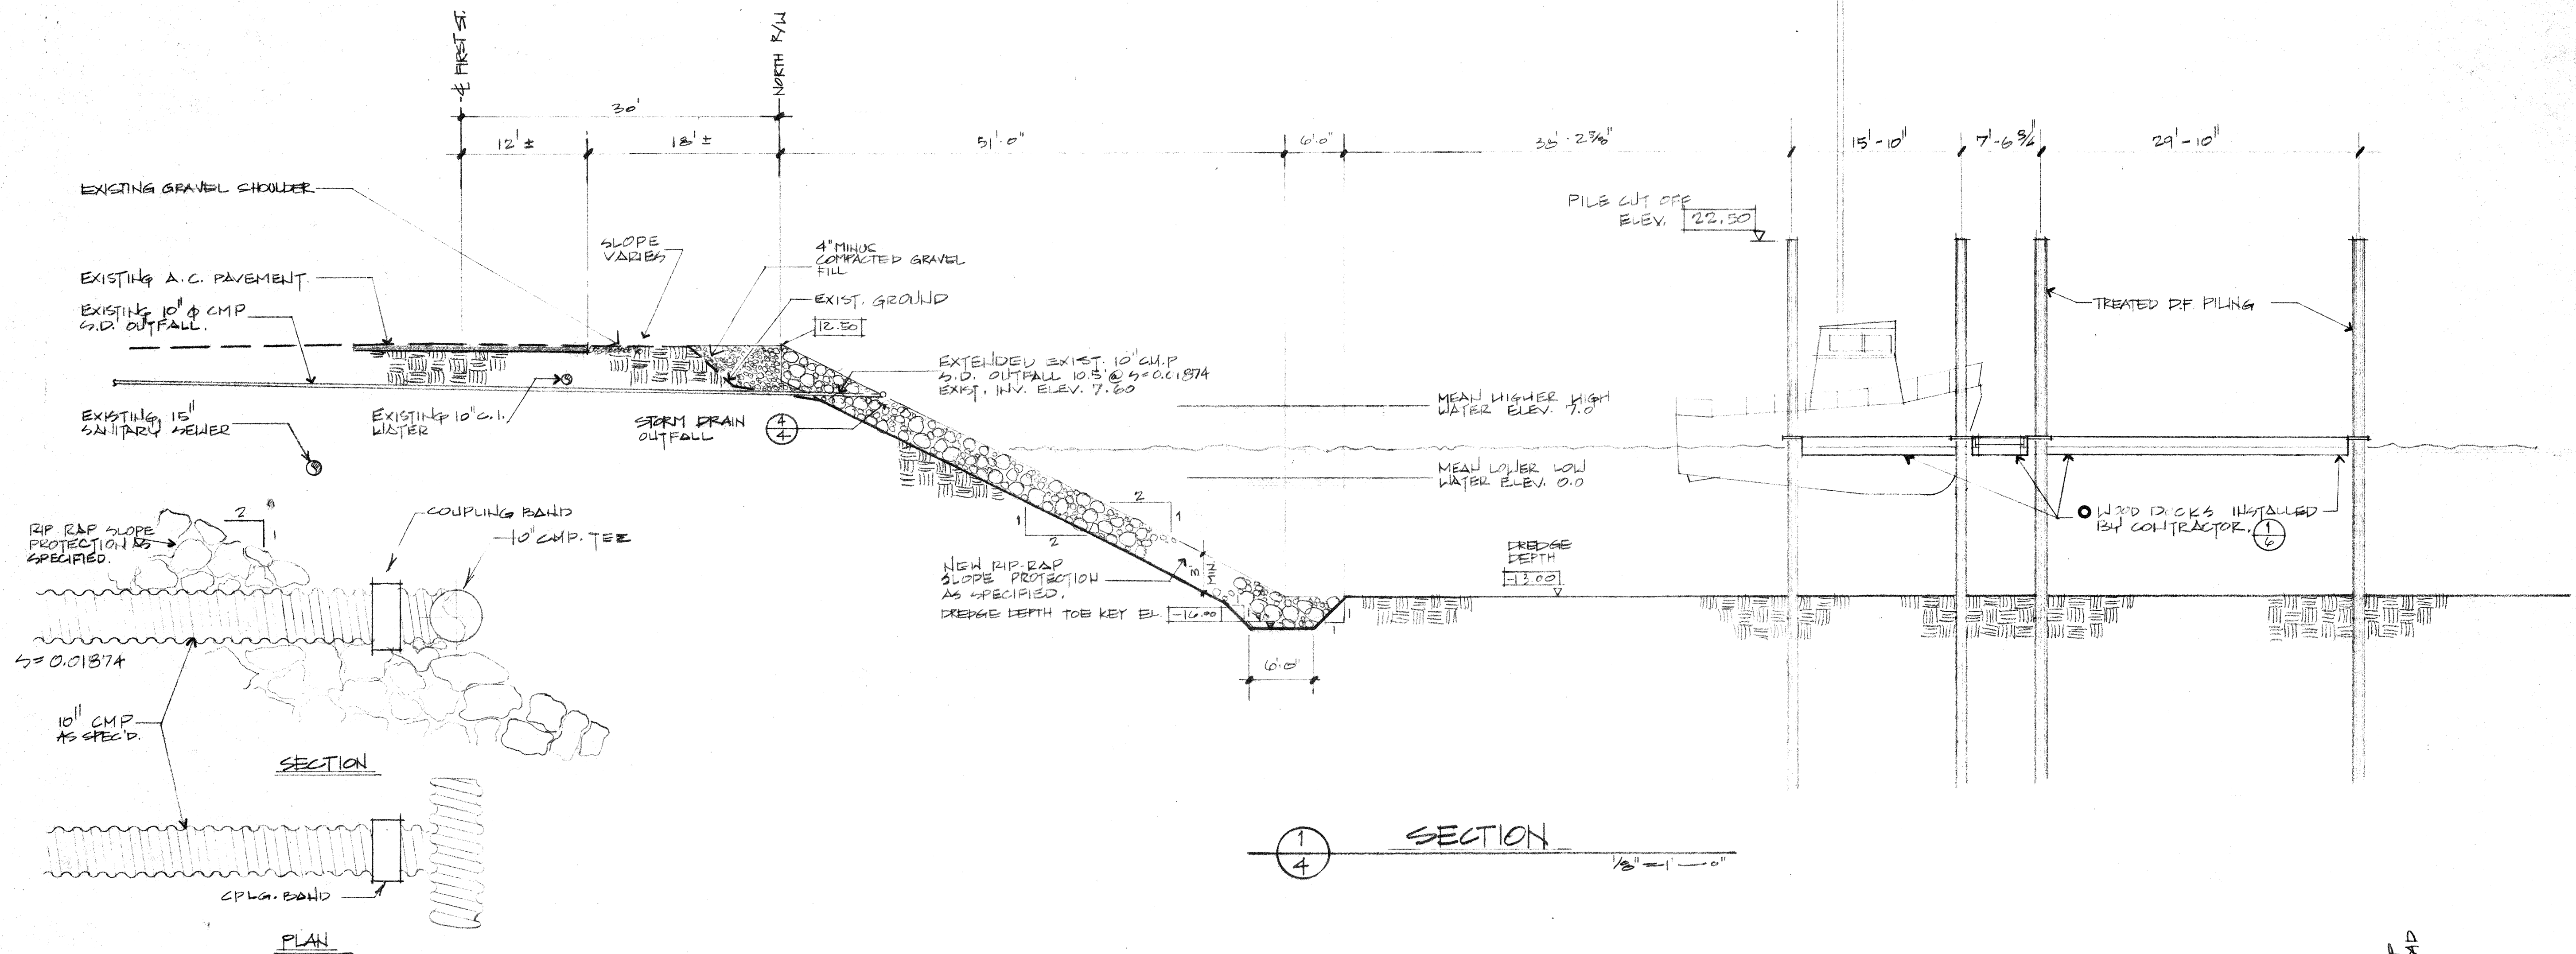

④ STORM DRAIN OUTFALL
3/4" = 1'-0"

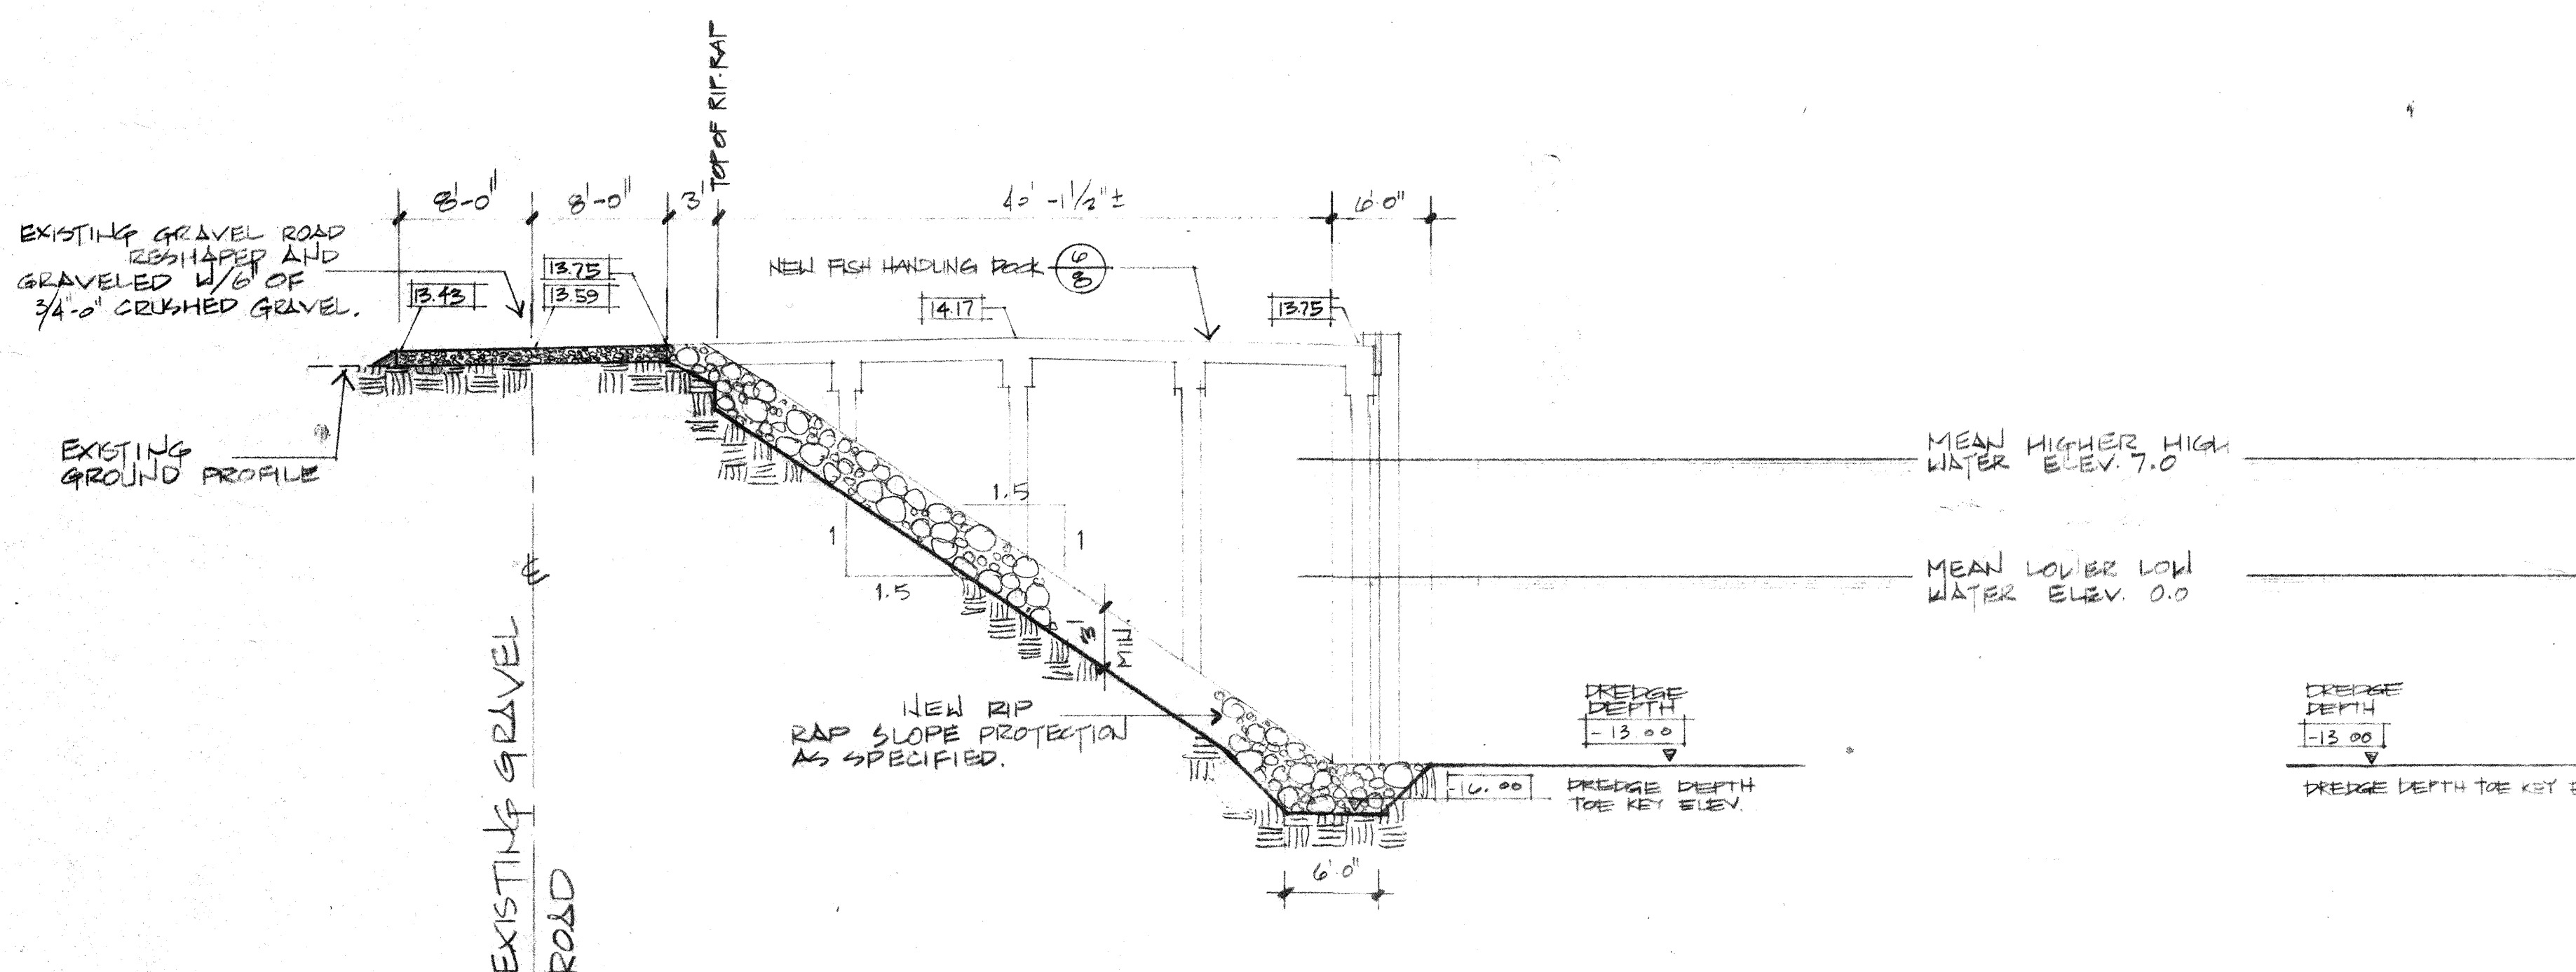

② SECTION
1/8" = 1'-0"

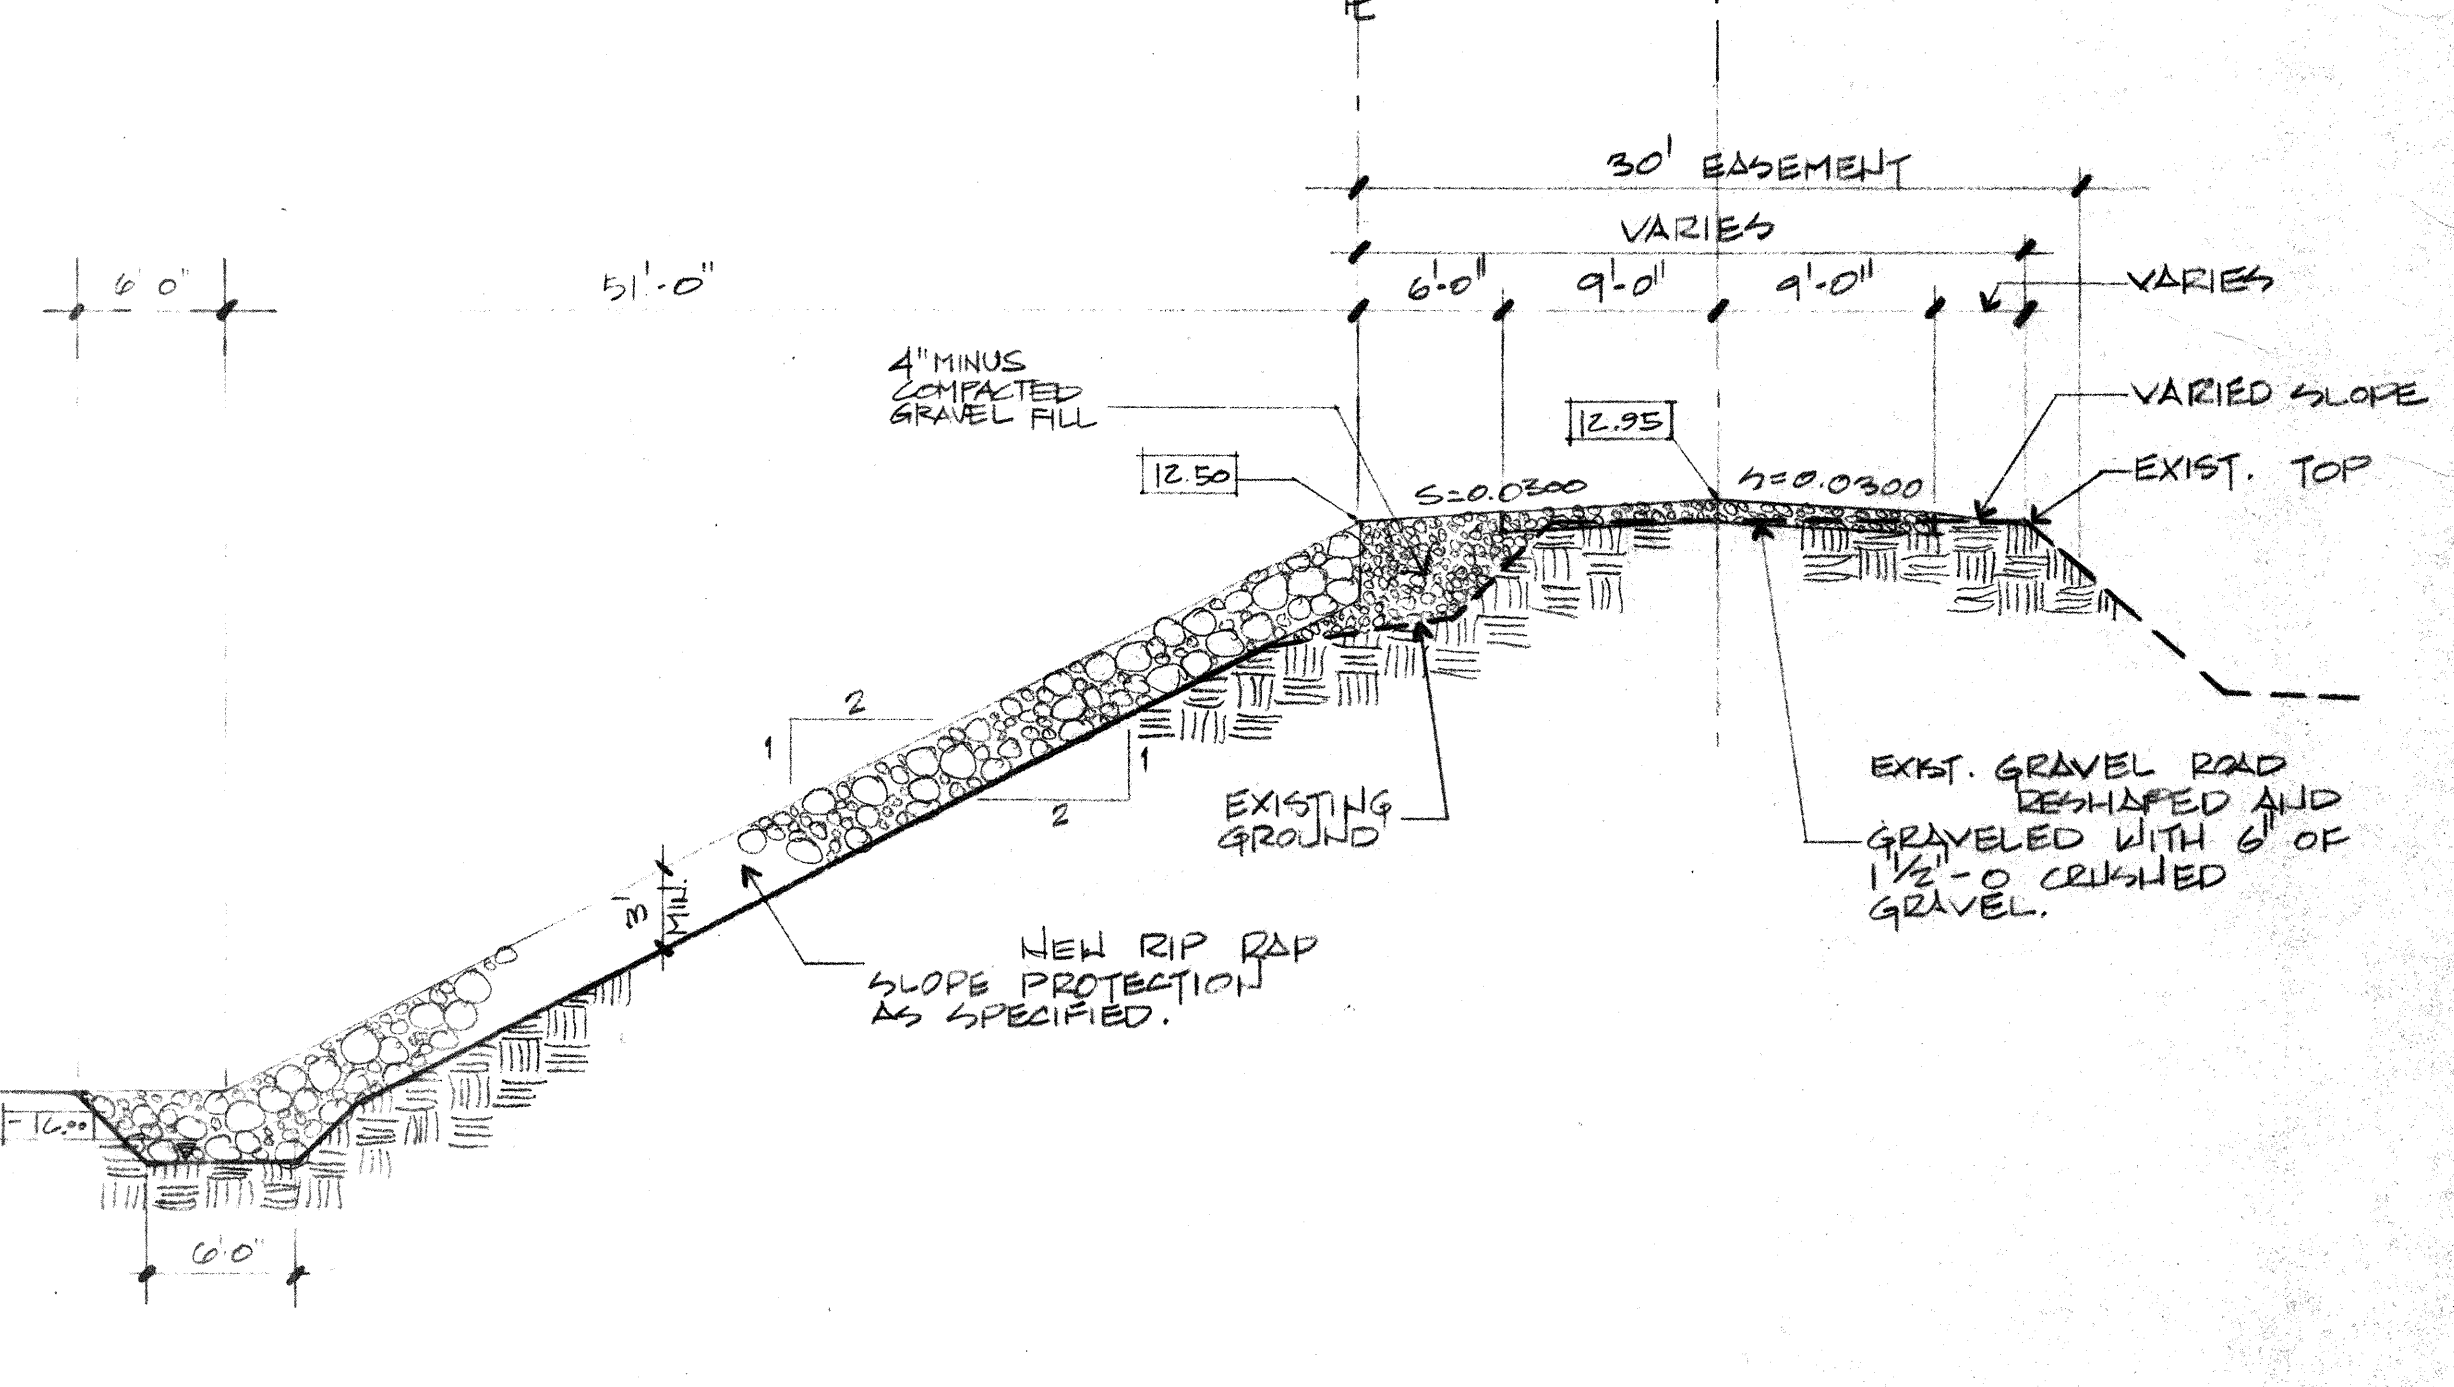

③ SECTION
1/8" = 1'-0"

○ - DENOTES FURNISHED BY OWNER.

RECORD DELG. 1/35 R.K.



HCE INC./ENGINEERS & PLANNERS
Coos Bay, Oregon / 375 Park Avenue, 97430 / (503) 268-1166
Portland, Oregon / 19 N. W. 5th Ave. 97209 / (503) 222-1687
Albany, Oregon / 300 Elsworth St. So. 97321 / (503) 926-0084



SECTIONS


SHEET TITLE

PROJECT PART OF BANDON
CORVILLE RIVER BOAT BASIN
COOS COUNTY, OREGON

PROJECT # 2071
DATE JULY, 1982

SHEET NO.

4

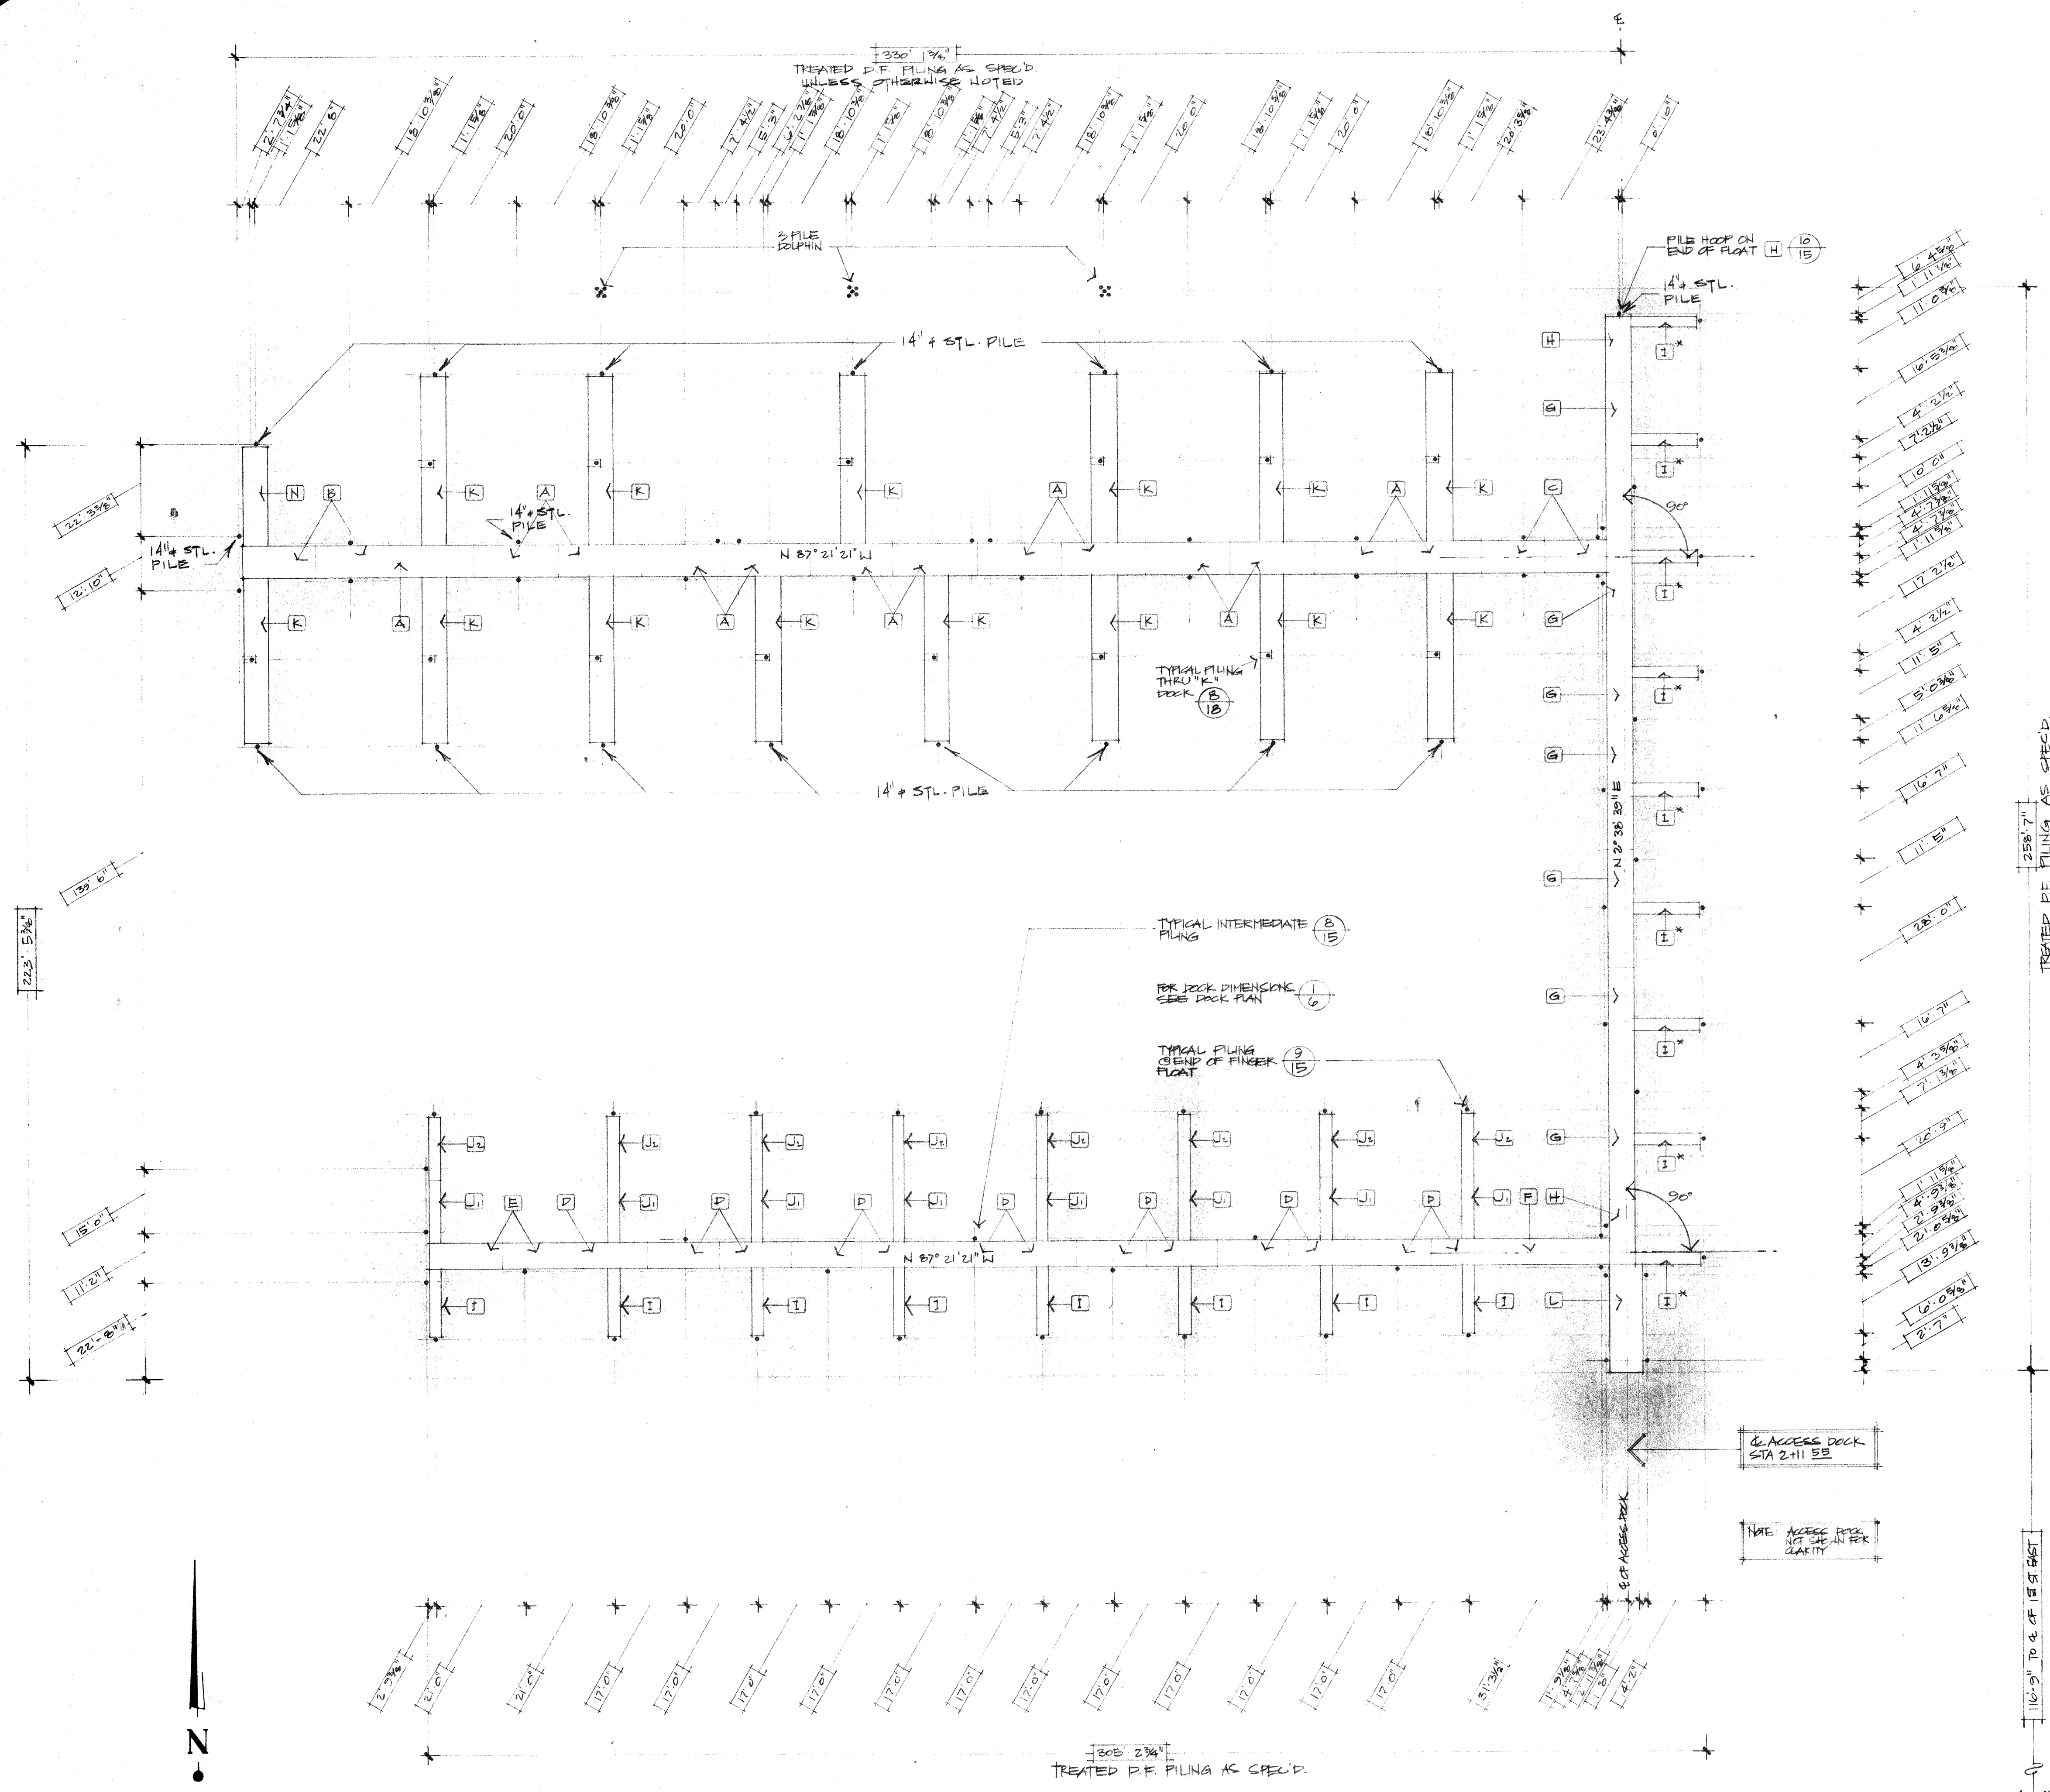

FLAT OR PILE DESIGNATION	PILE LENGTH (FT.)	MINIMUM PENETRATION TO ELEVATION
A B C K N	52	-29.5
D E F J I	49	-26.5
G H I*	45	-23.5
L	45	-23.5
5 PILE DOLPHIN	52	-29.5

*EAST BERTHS ONLY - SEE PILING PLAN


NOTES:


- ① FLAT SECTIONS SUPPLIED BY OWNER.
- ② BREAKING - LAMBERT PROJECTION OF OREGON, SOUTH ZONE

①
PILING PLAN
1" = 20'

RECORD DRAWING 1/32 K

EDA PROJECT NO. 07-01-02549

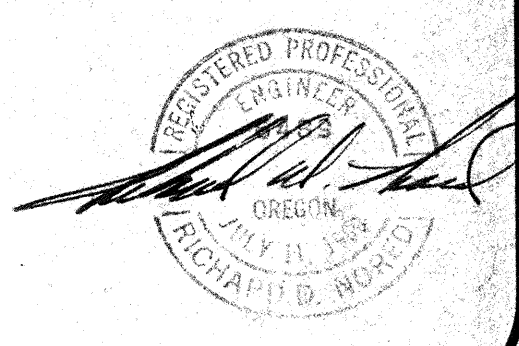

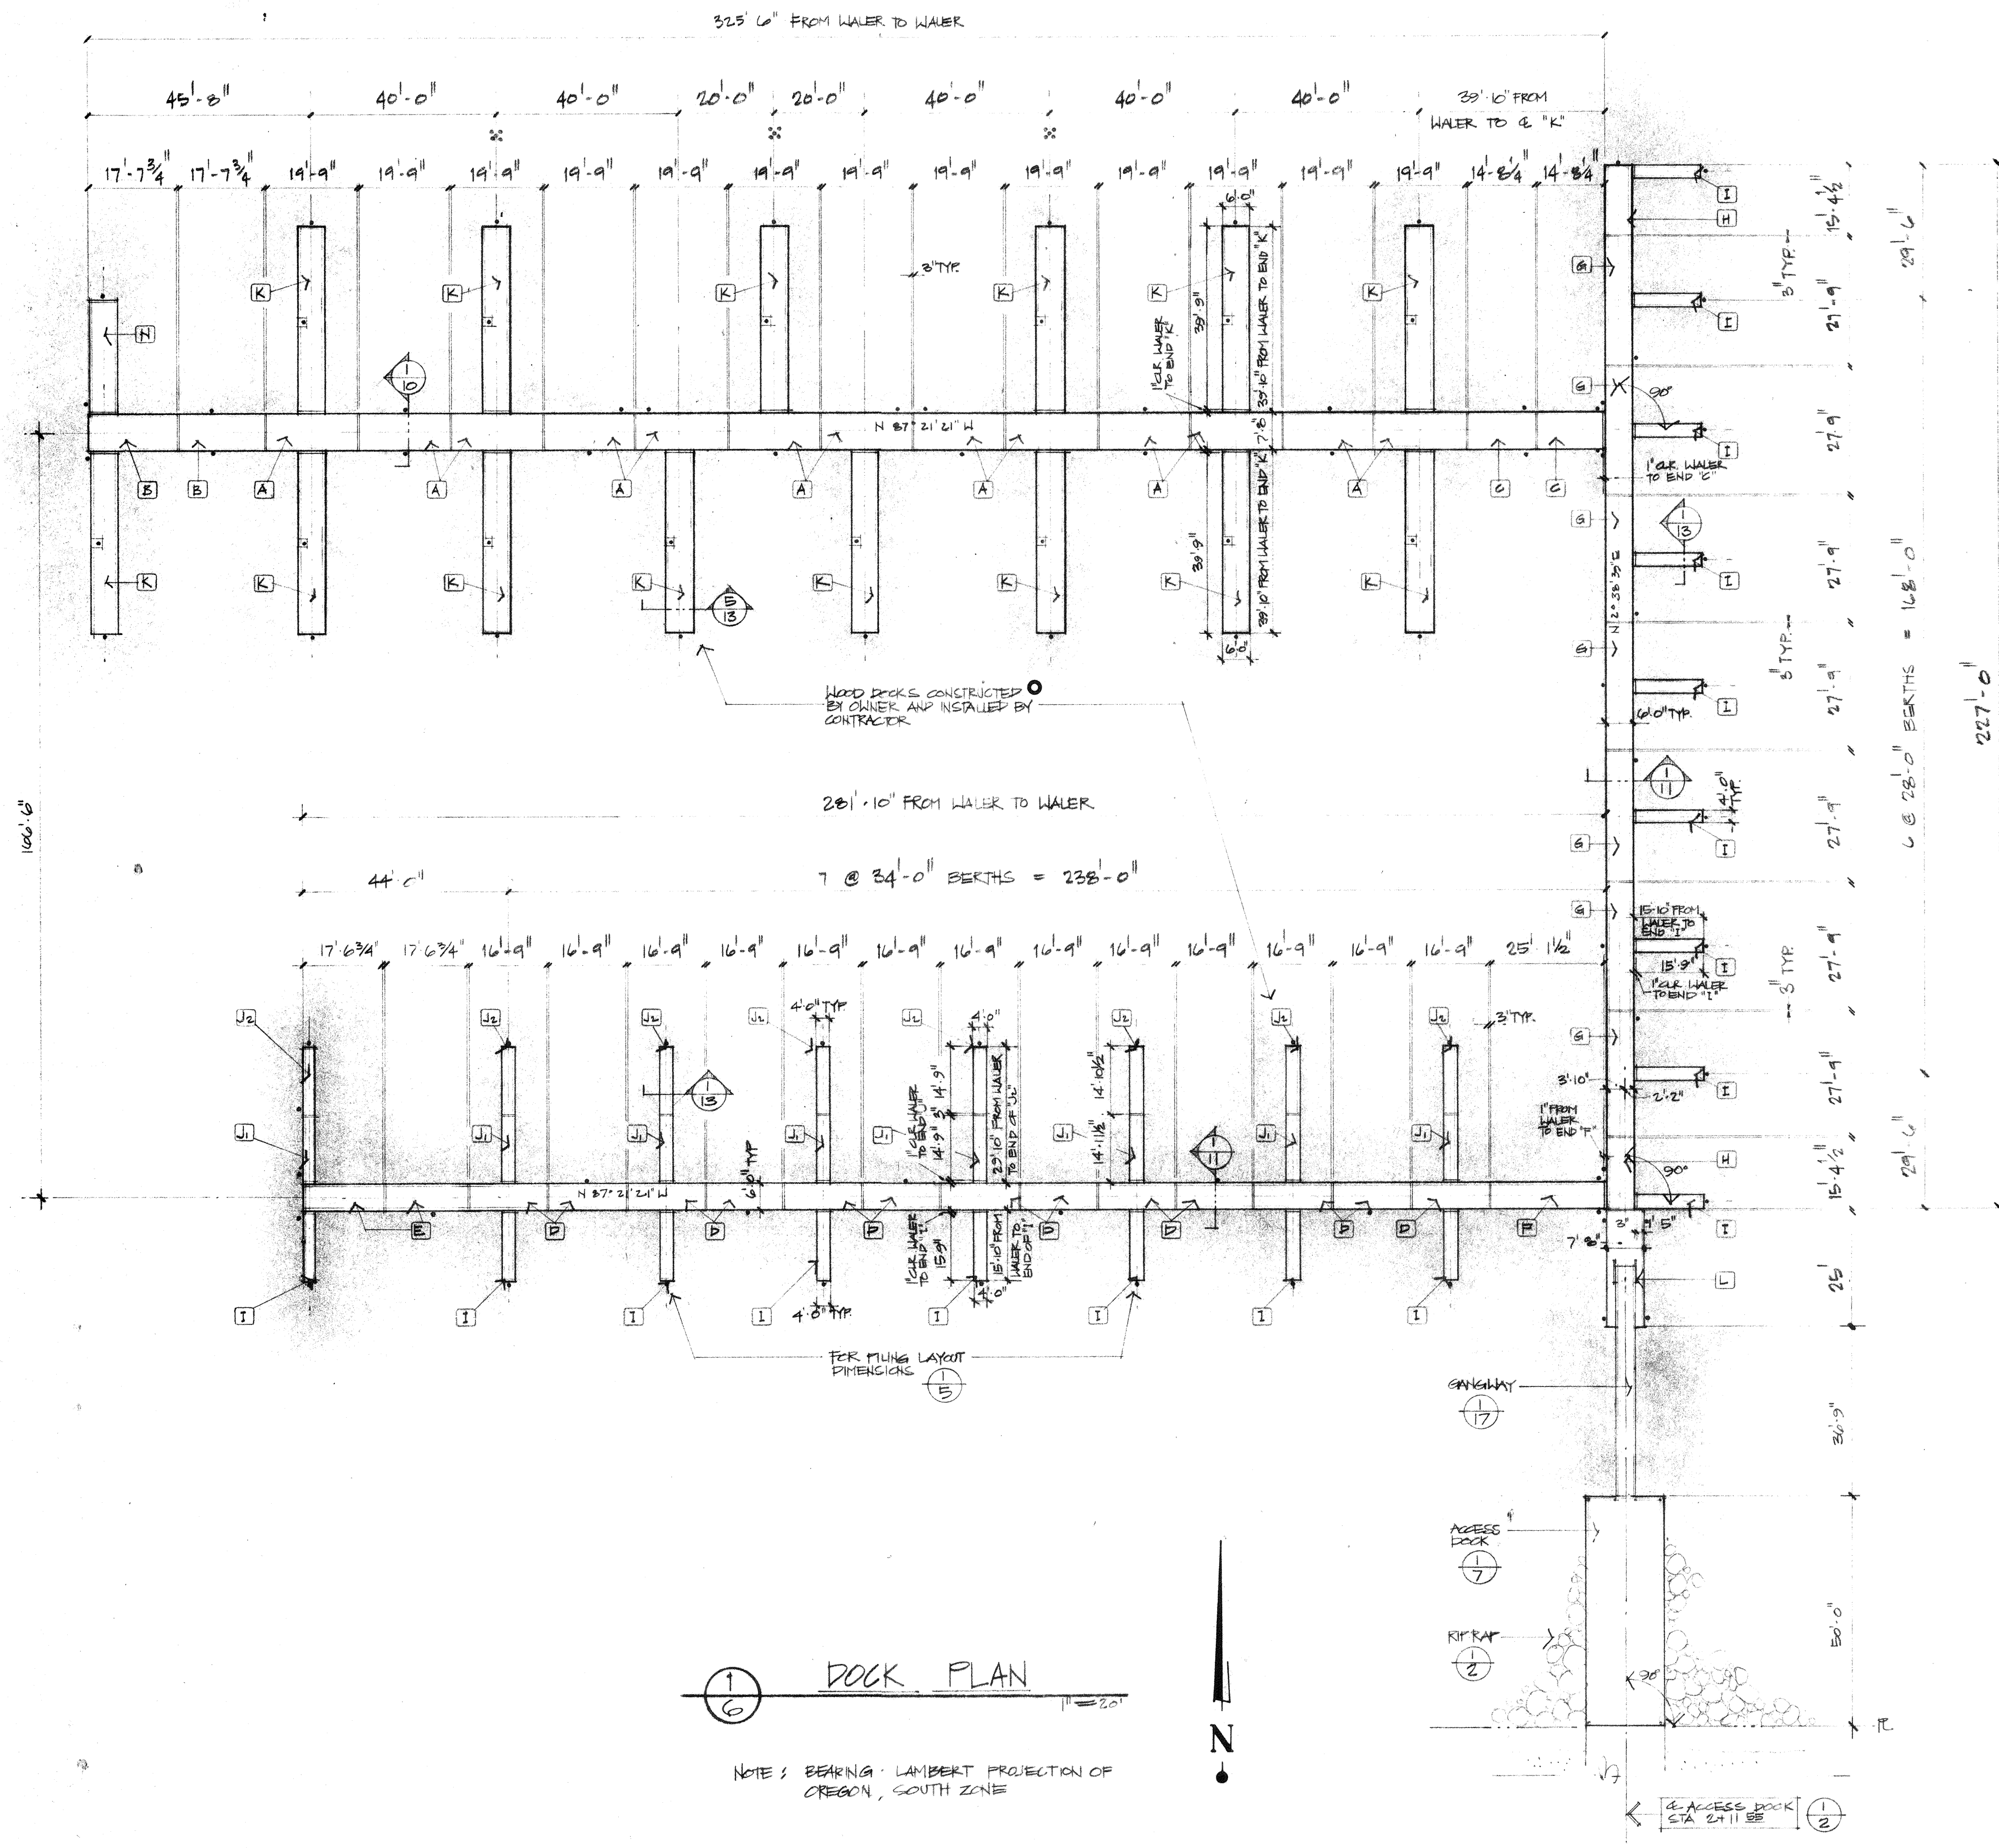


1
6 DOCK PLAN

NOTE: BEARING - LAMBERT PROJECTION OF OREGON, SOUTH ZONE











○ - PILETOPS FURNISHED BY OWNER

RECORD DRAWING 1/33 R.K.

EDA PROJECT NO. 07-01-02548

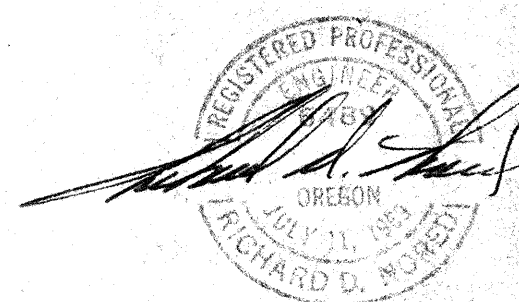


SHEET NO. 01	PROJECT # 2071	PROJECT TITLE PORT OF BANDON COQUILLE RIVER BOAT BASIN COOS COUNTY, OREGON	SHEET TITLE DOCK PLAN	HCE INC./ENGINEERS & PLANNERS Coos Bay, Oregon / 375 Park Avenue 97420 / (503) 289-1186 Portland, Oregon / M. St. Ave. 97209 / (503) 222-0687 Albany, Oregon / 300 Ellsworth St. 97321 / (503) 928-0004
	DATE JULY, 1982			

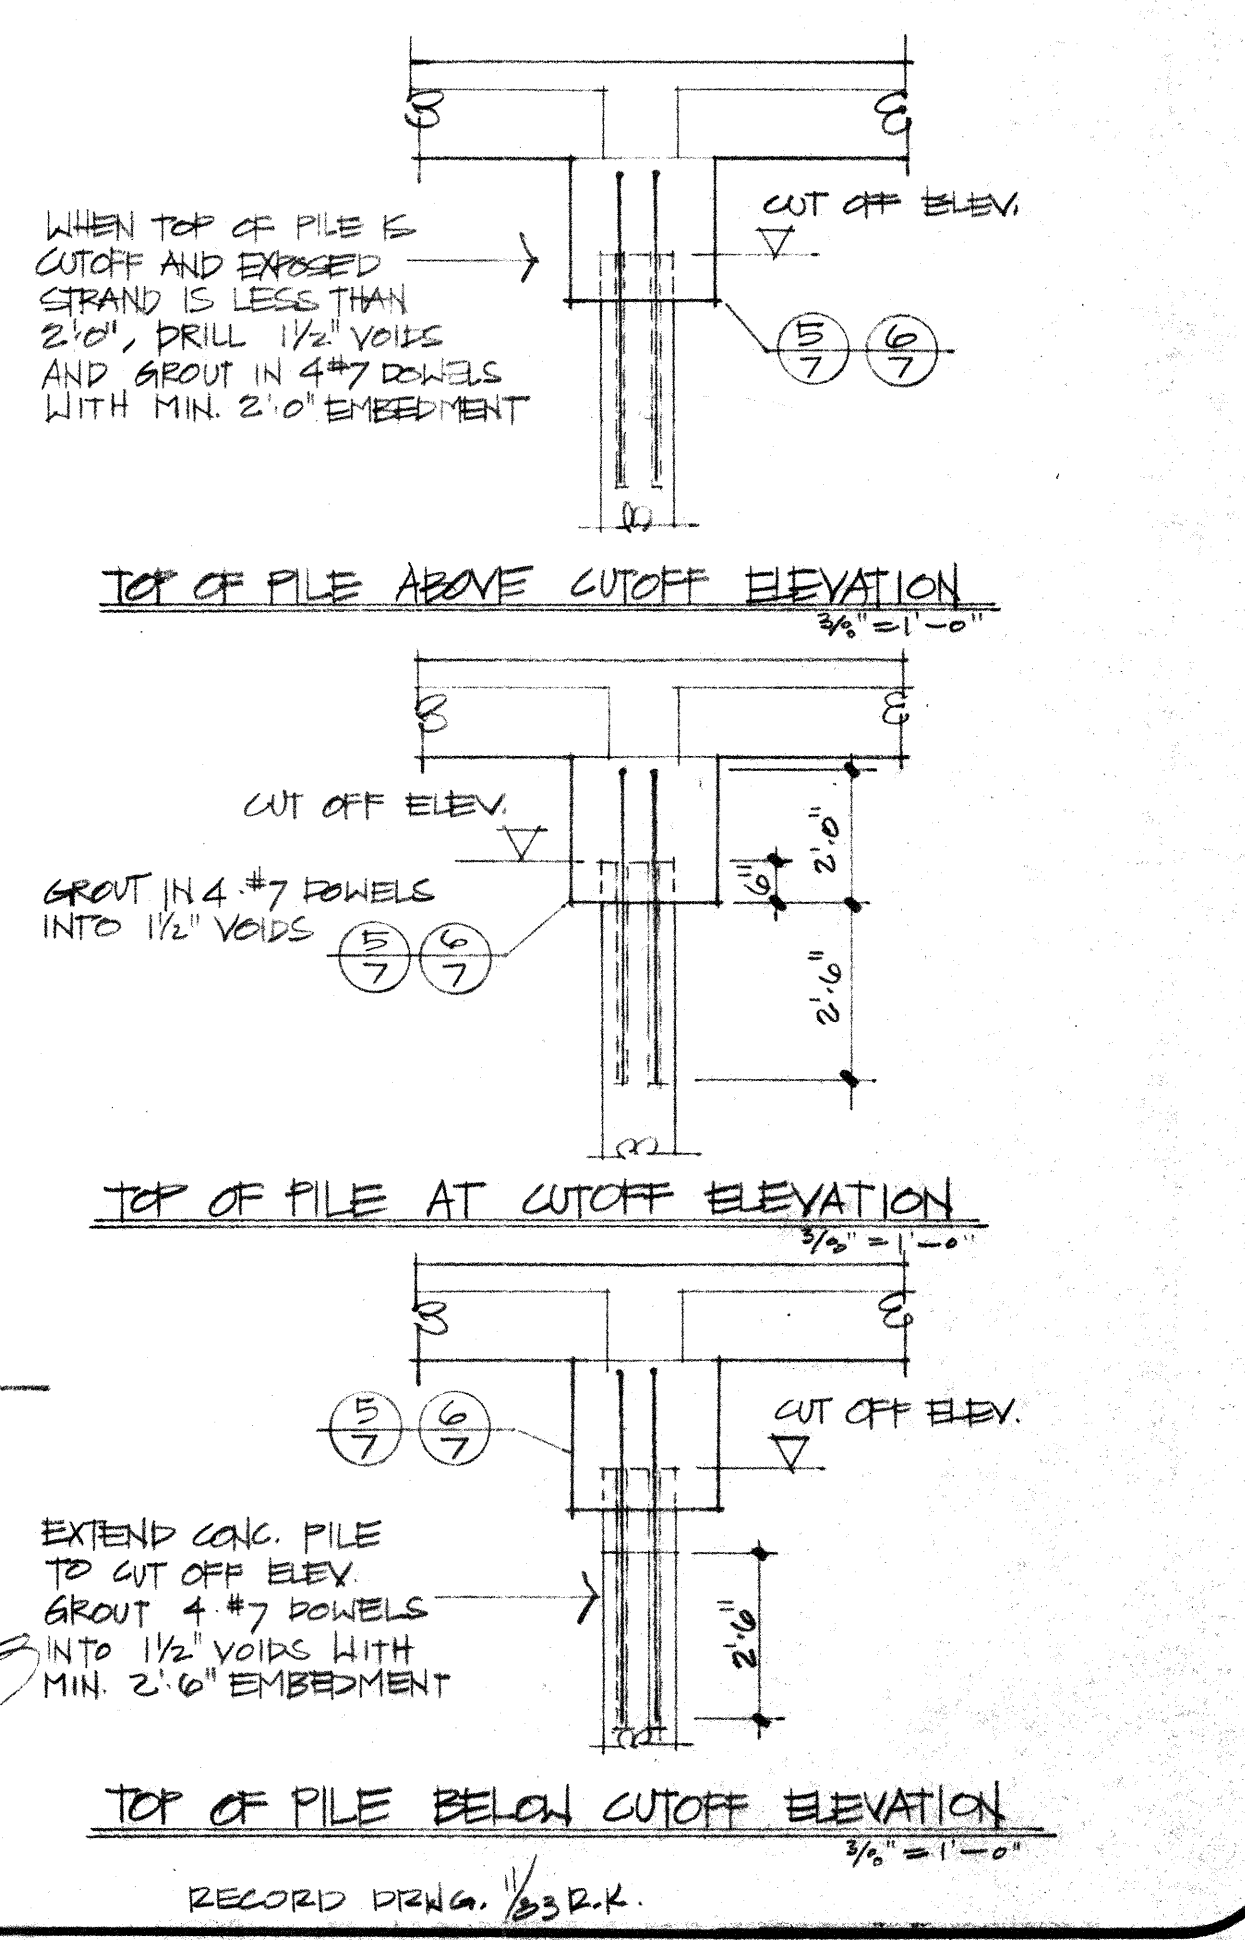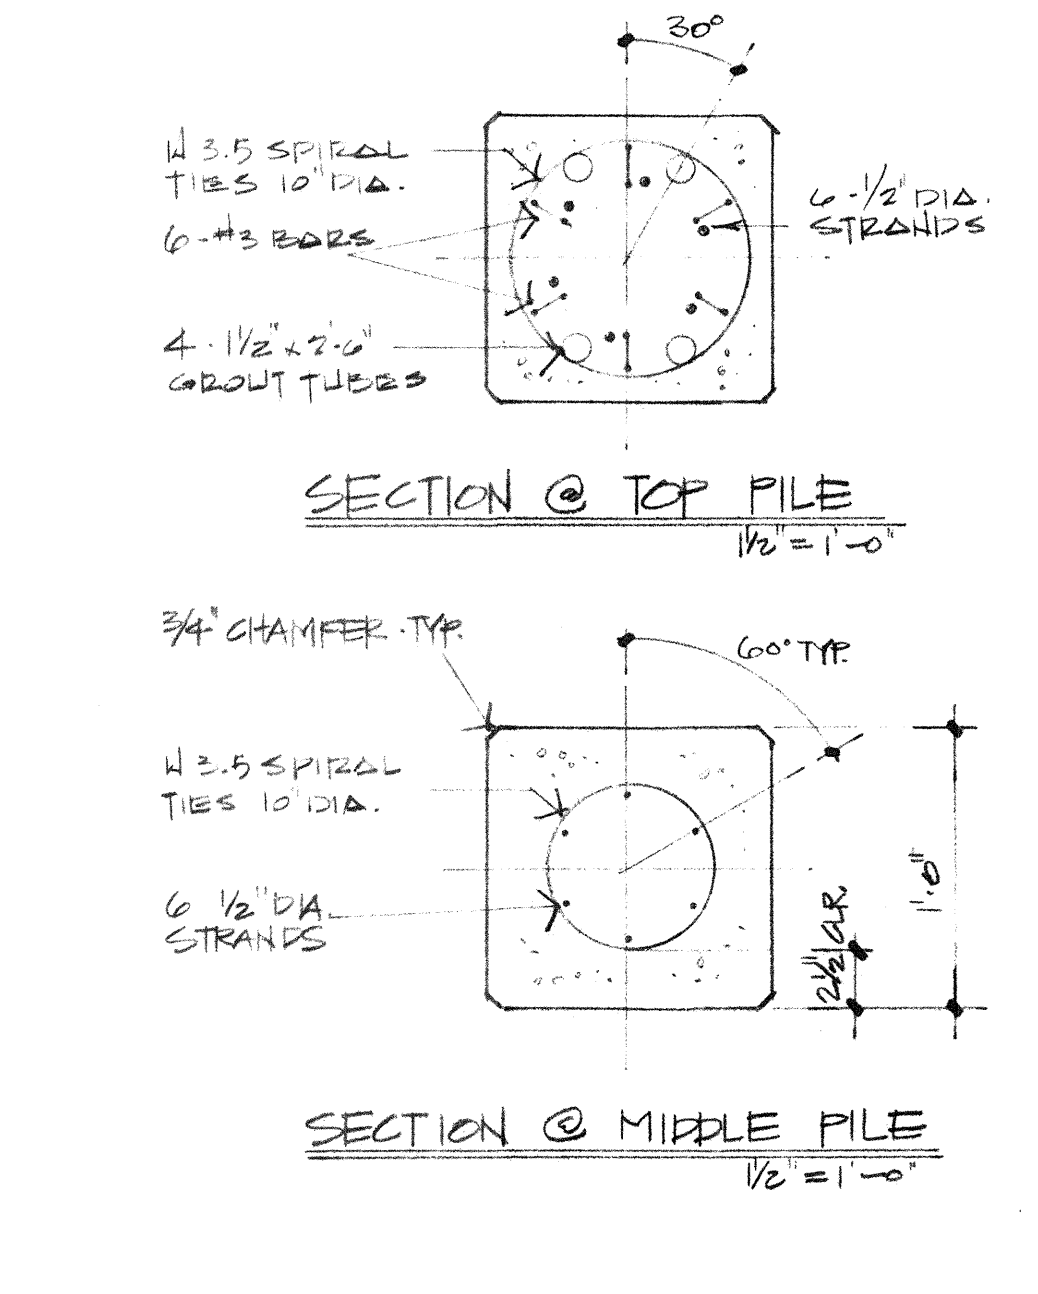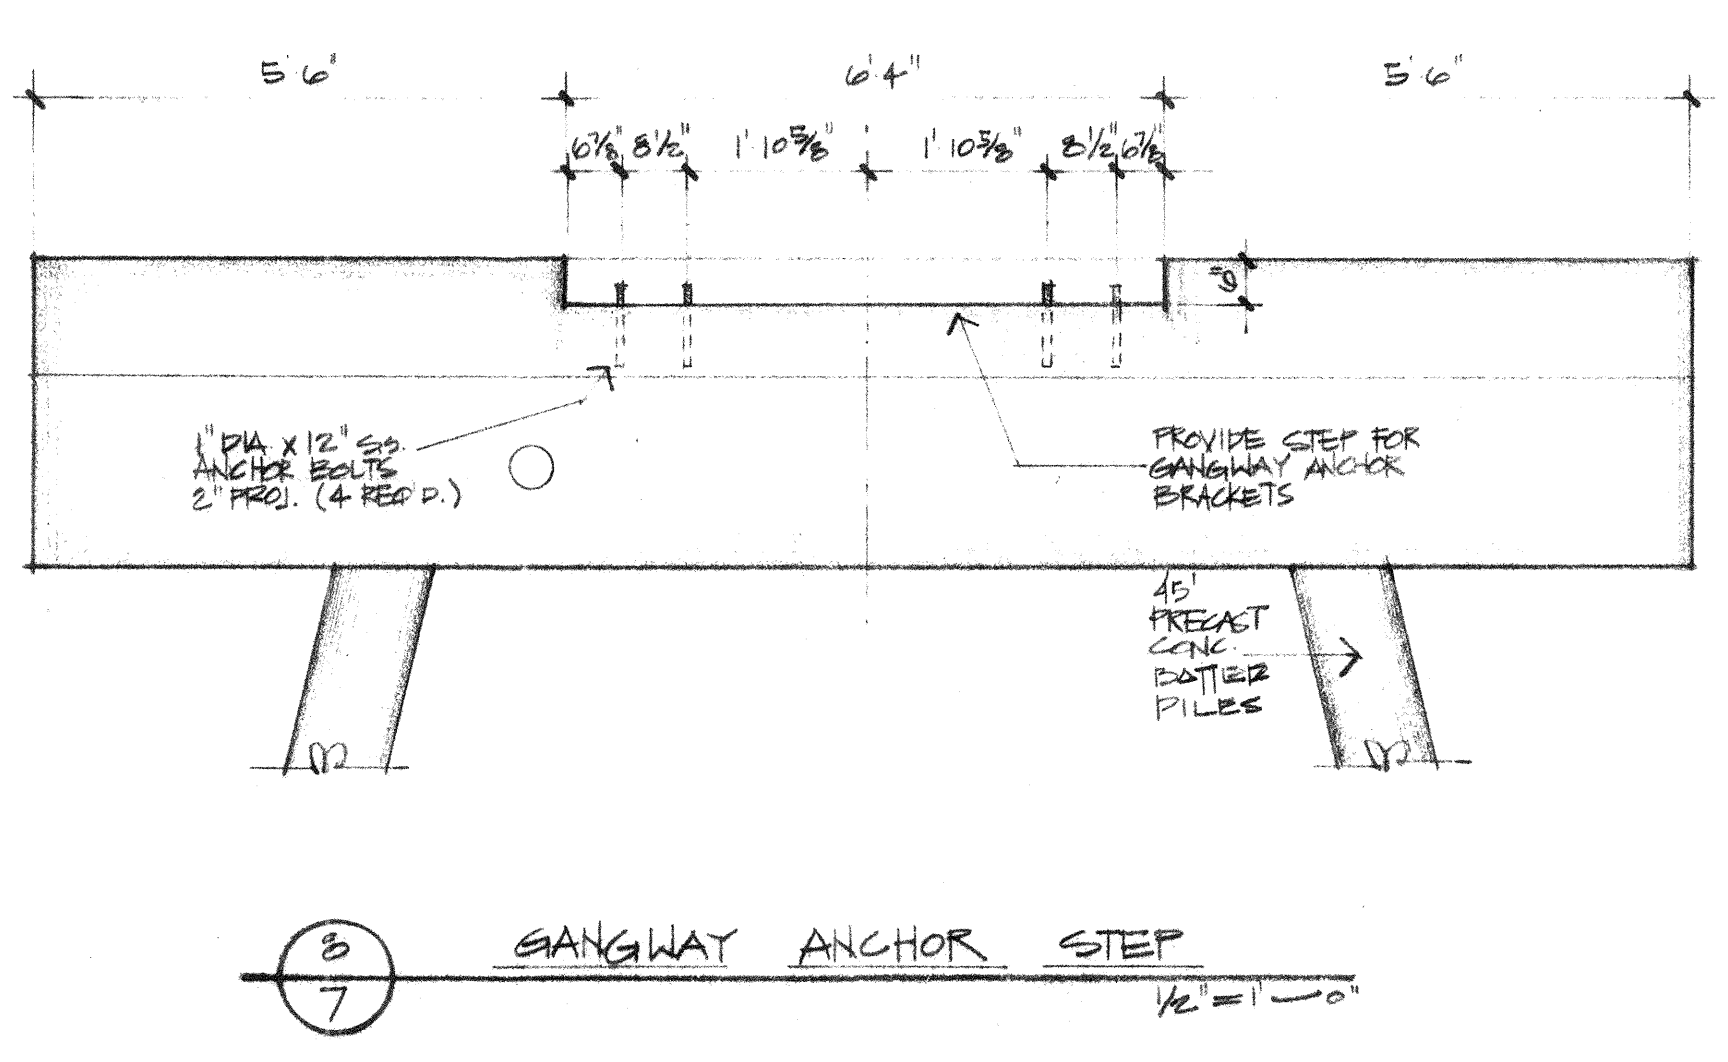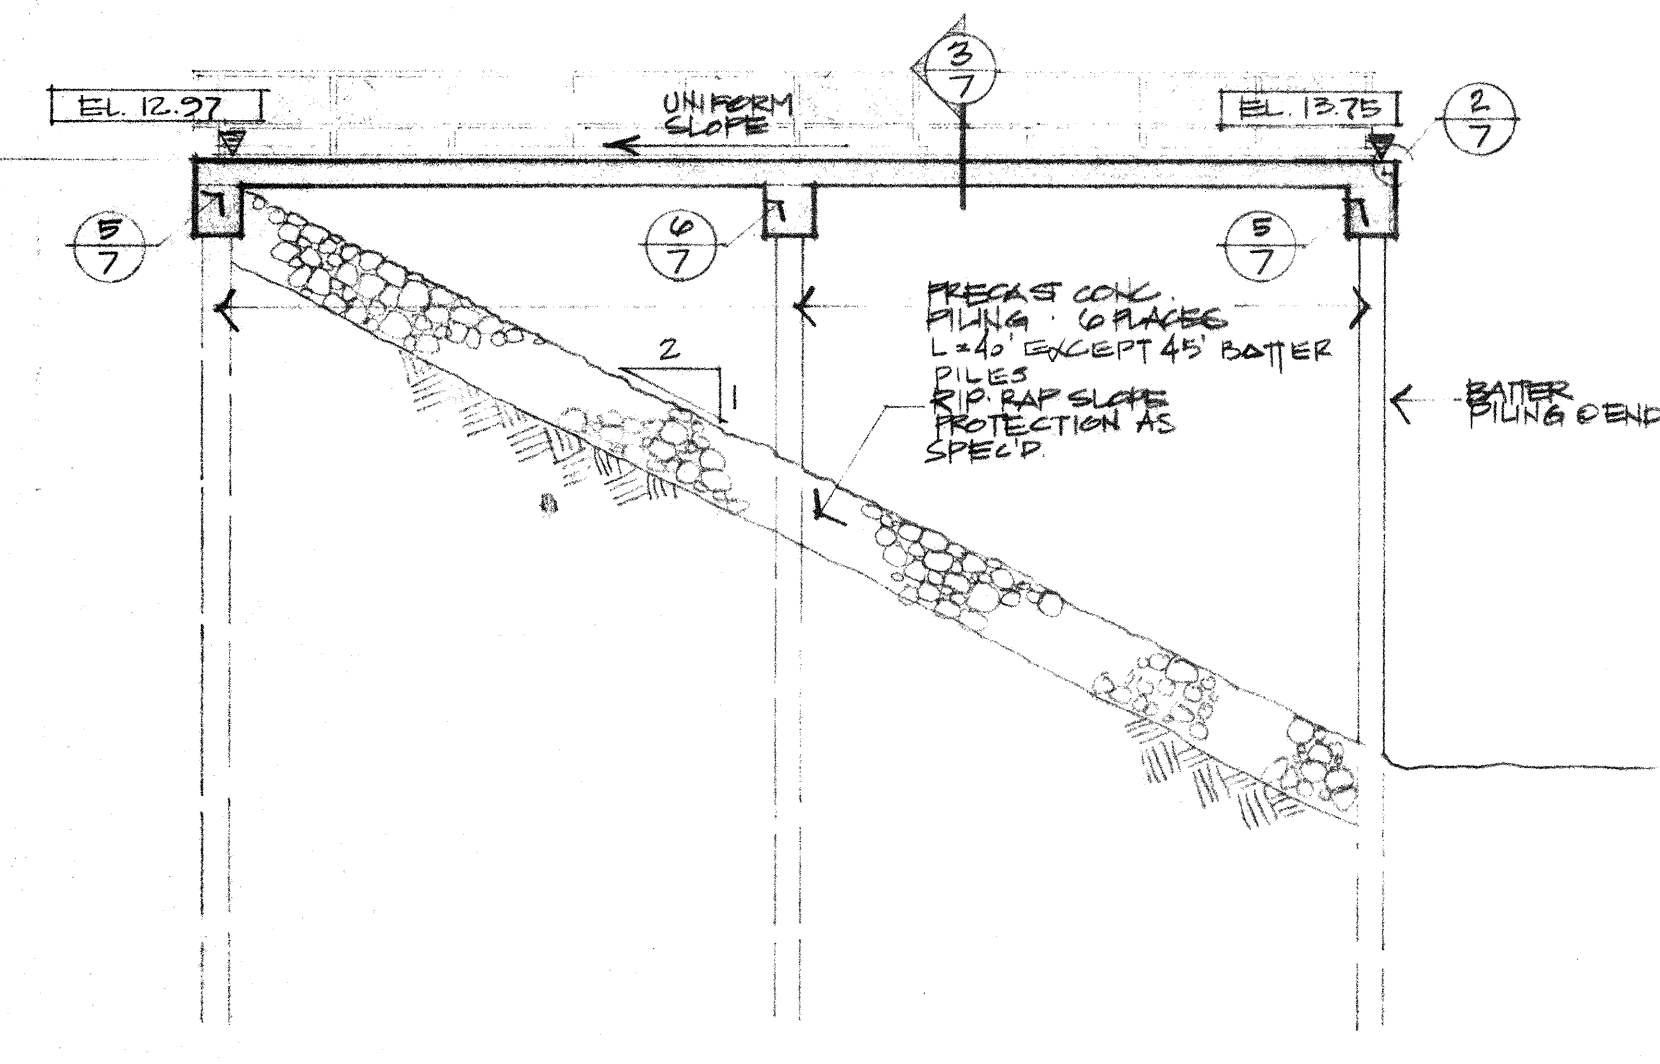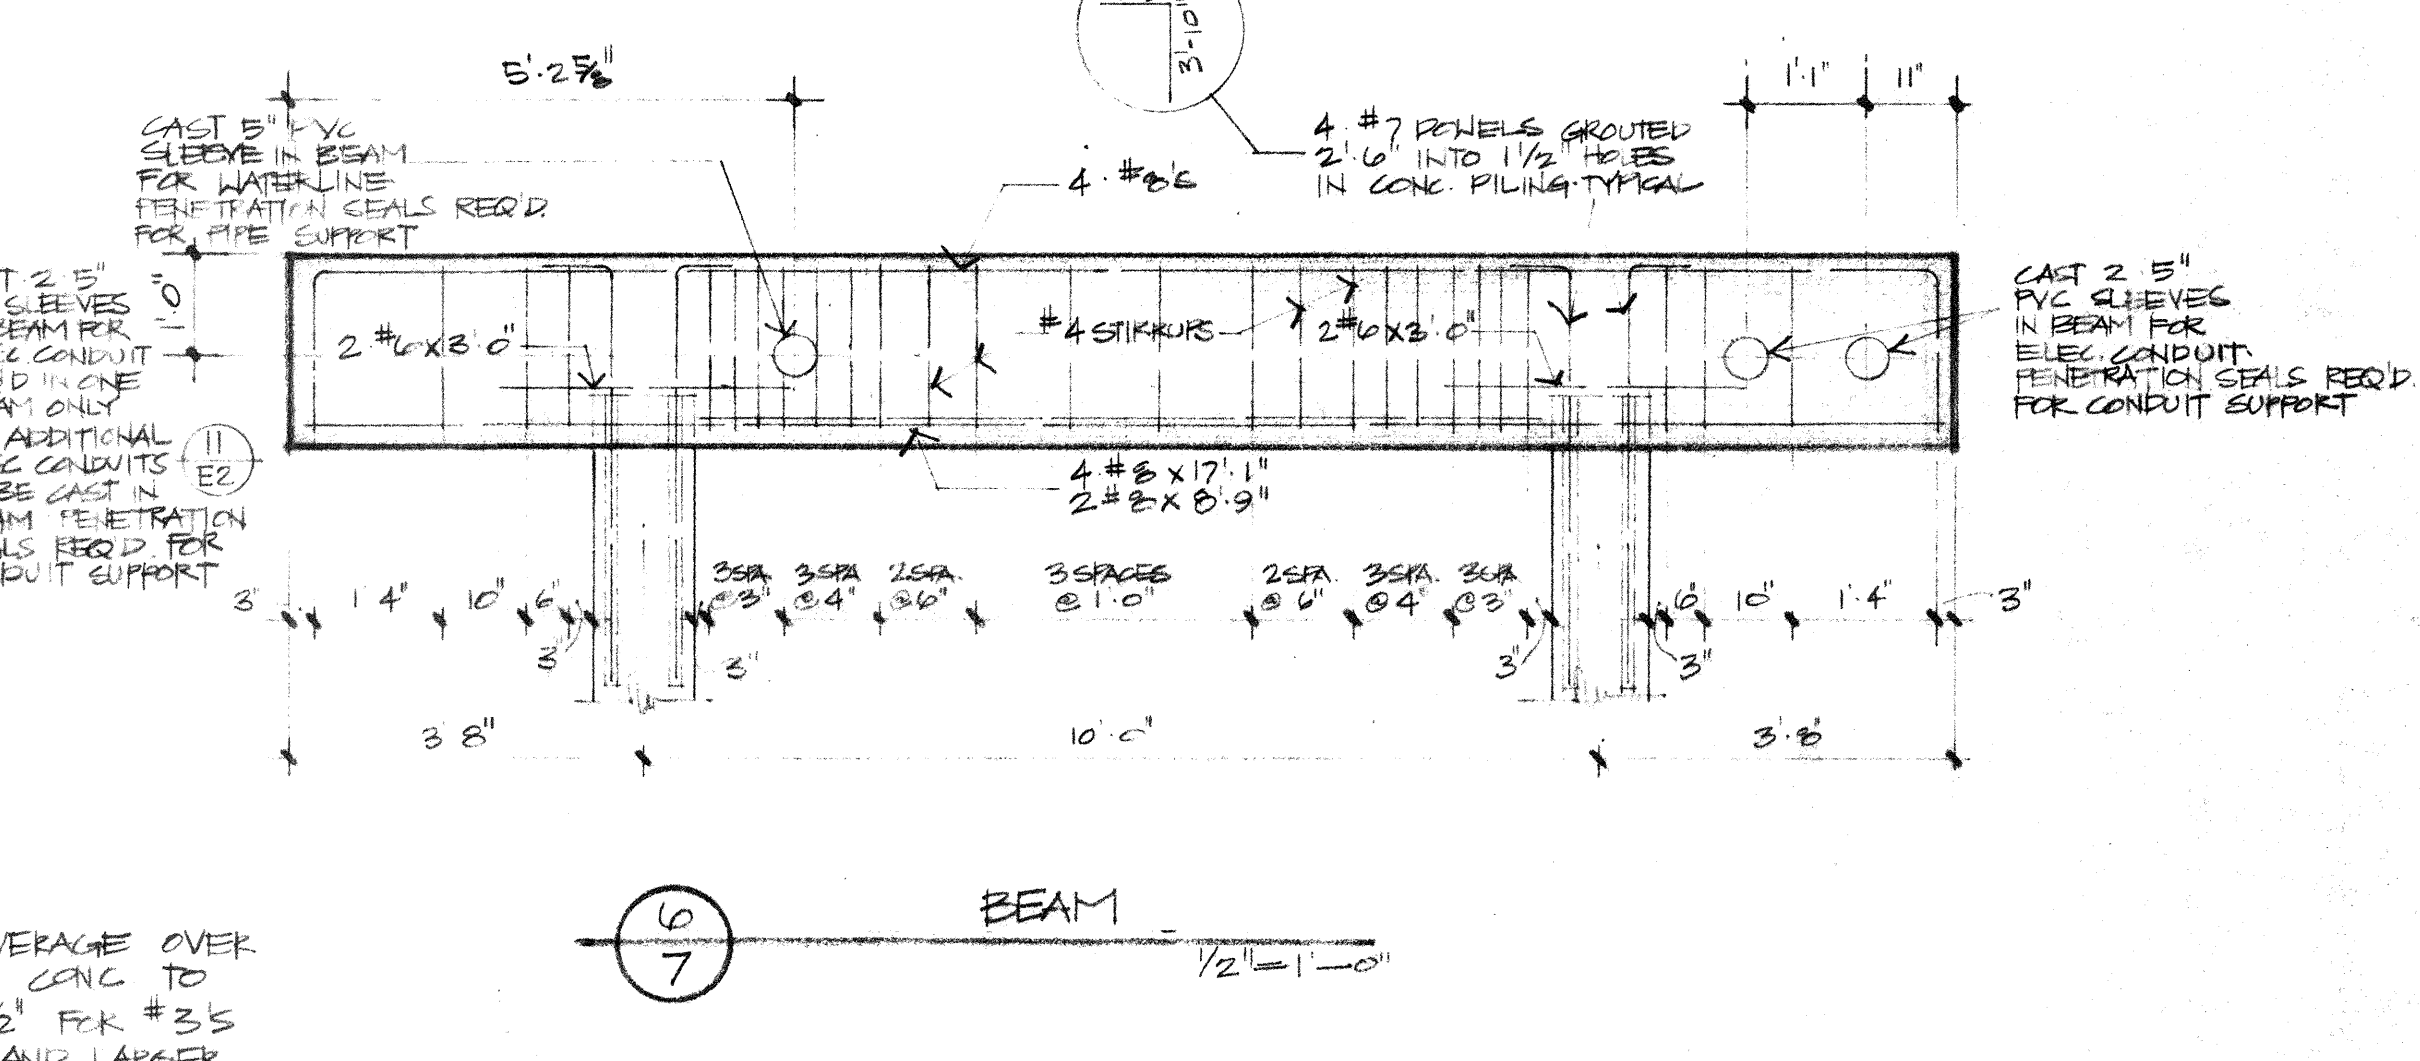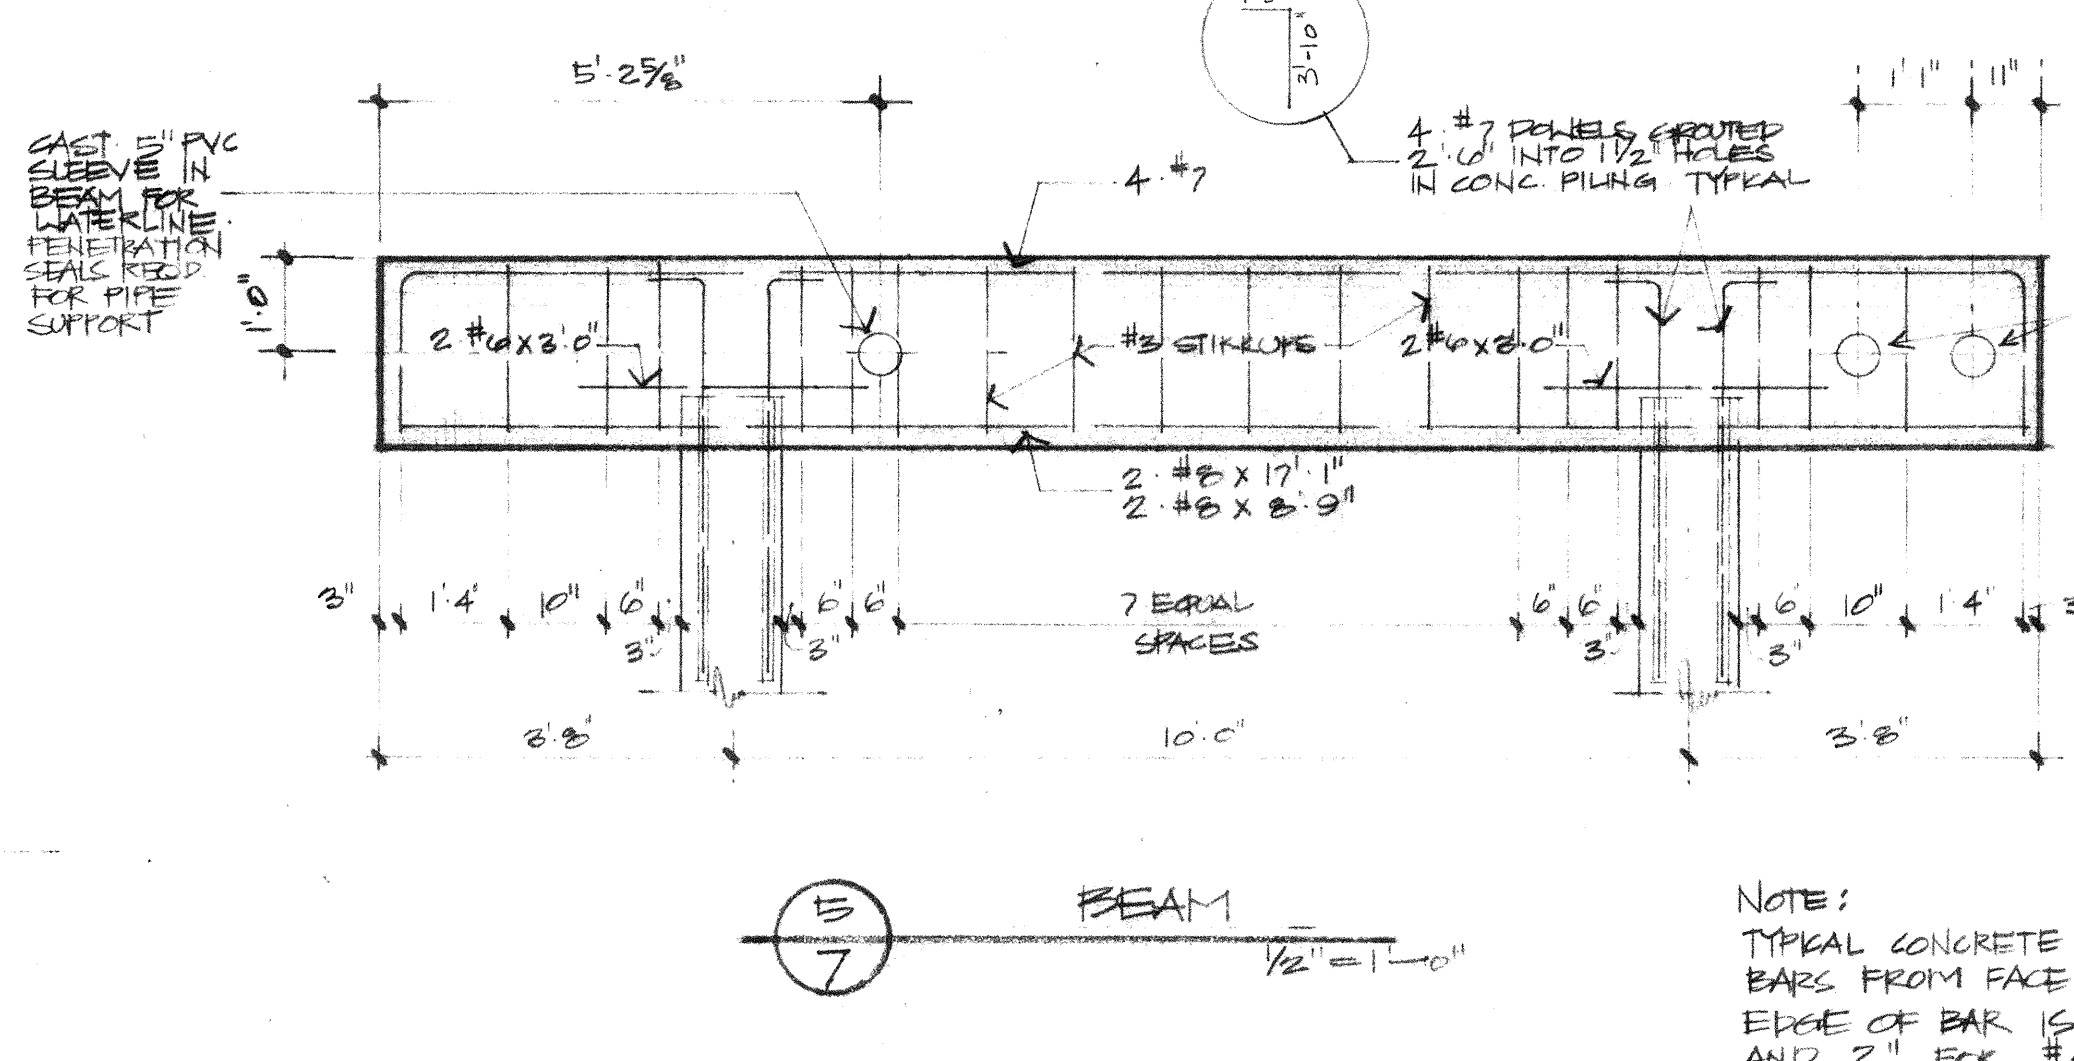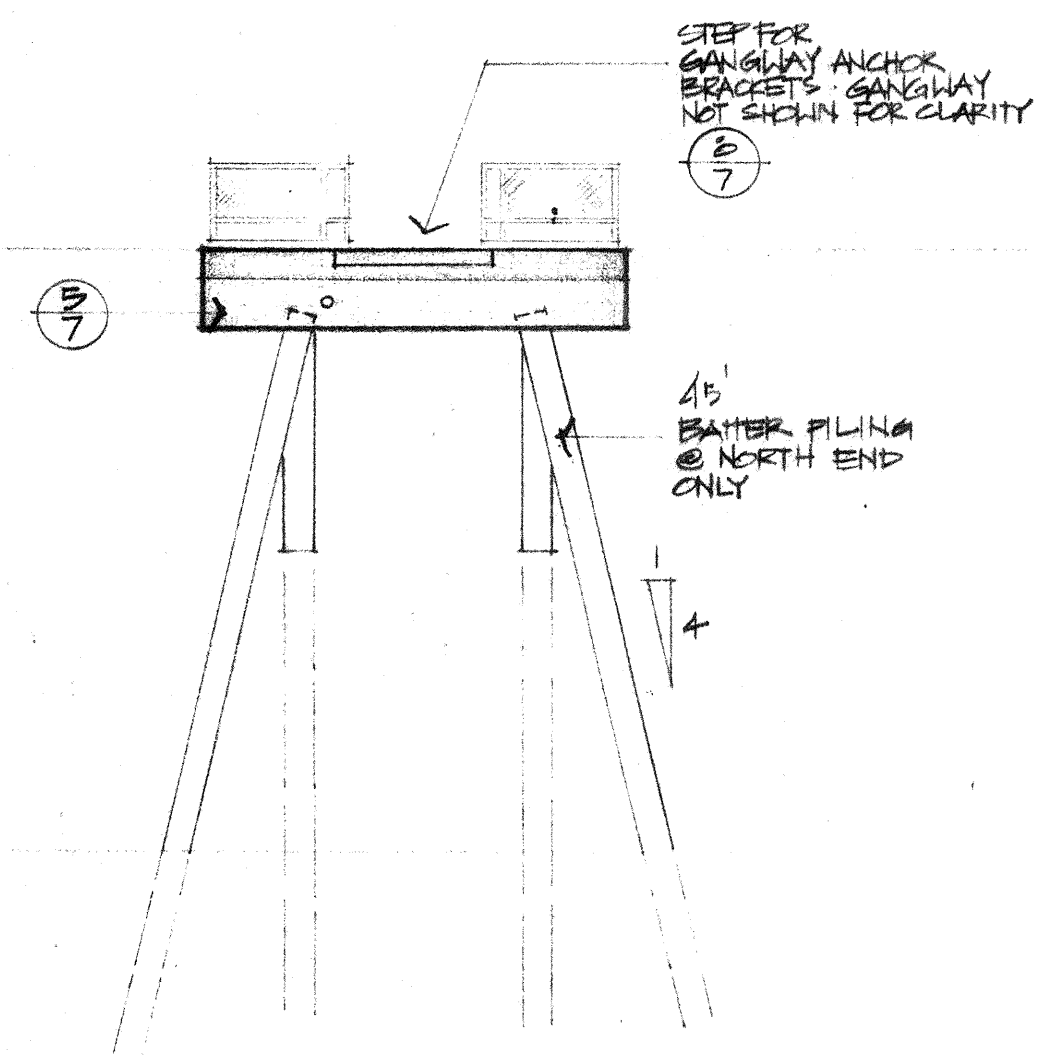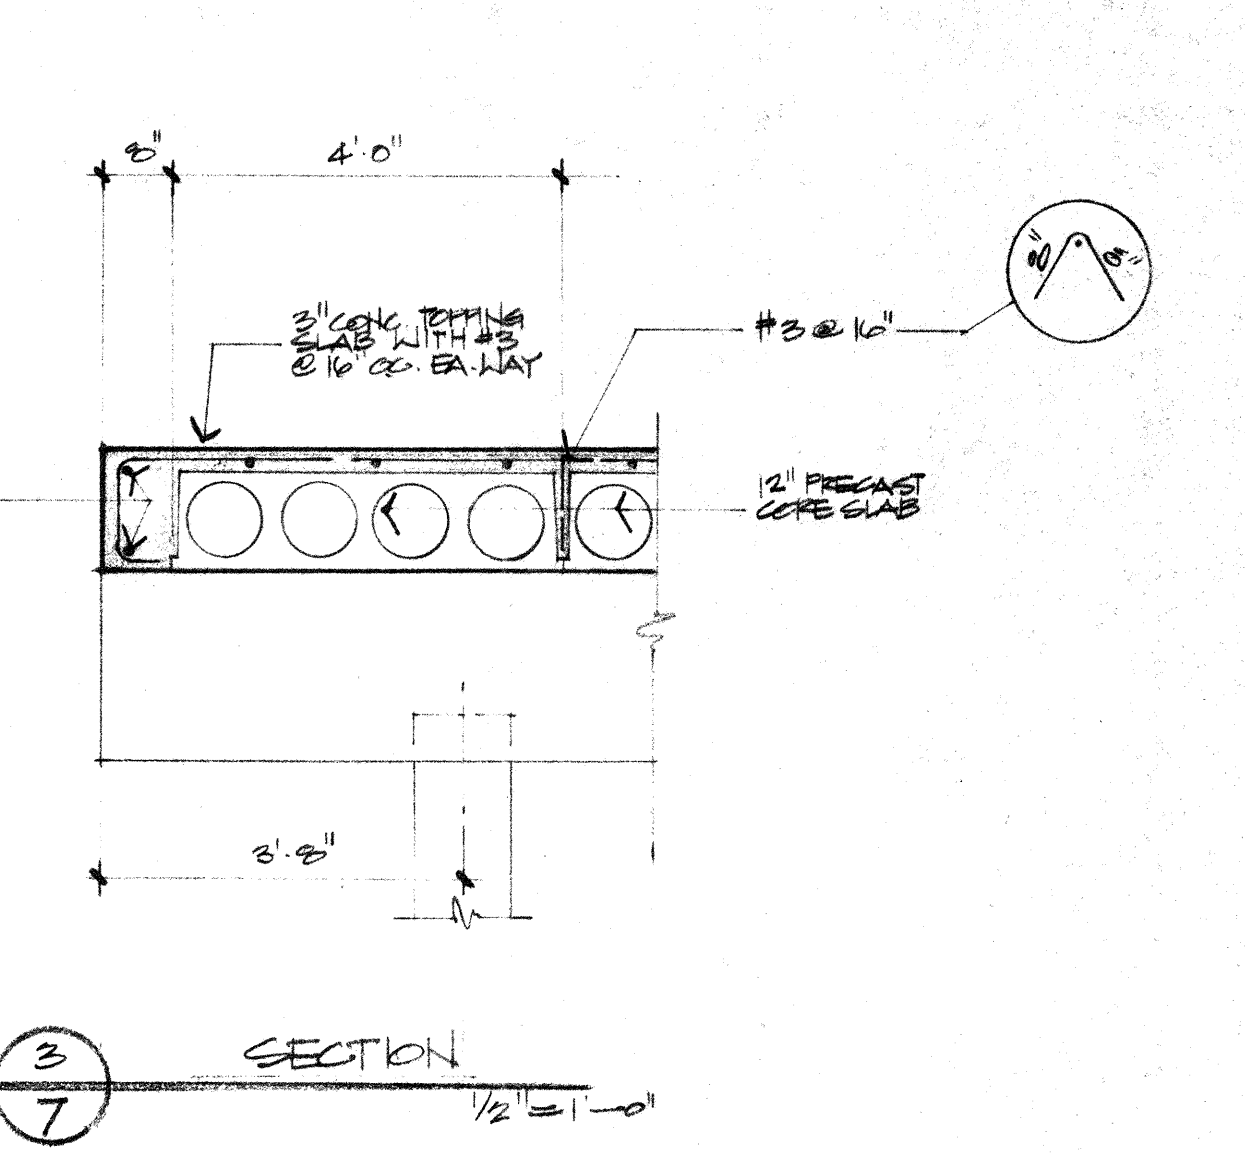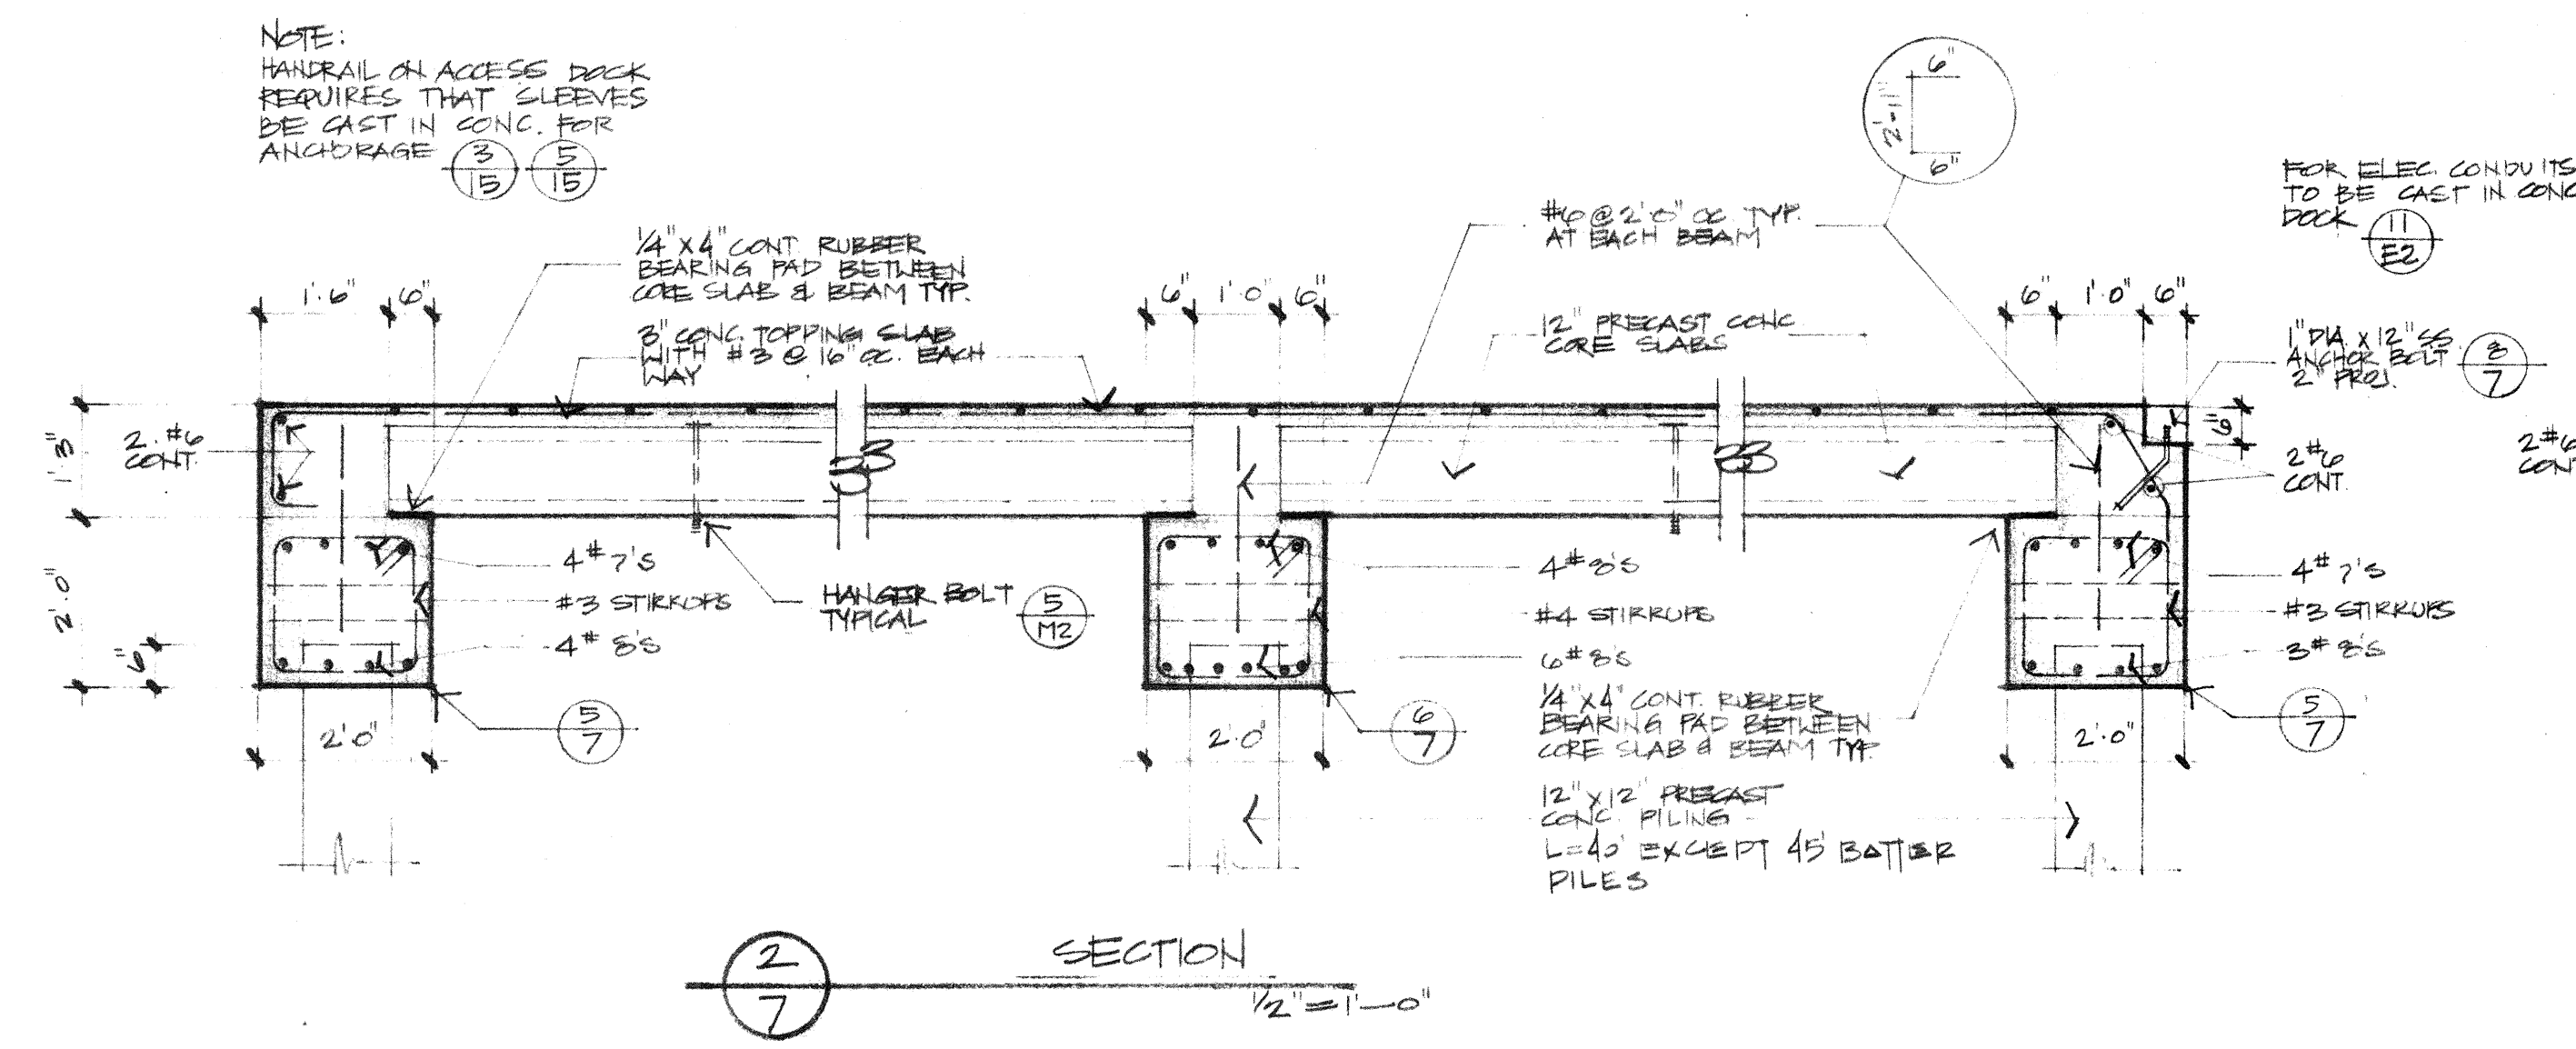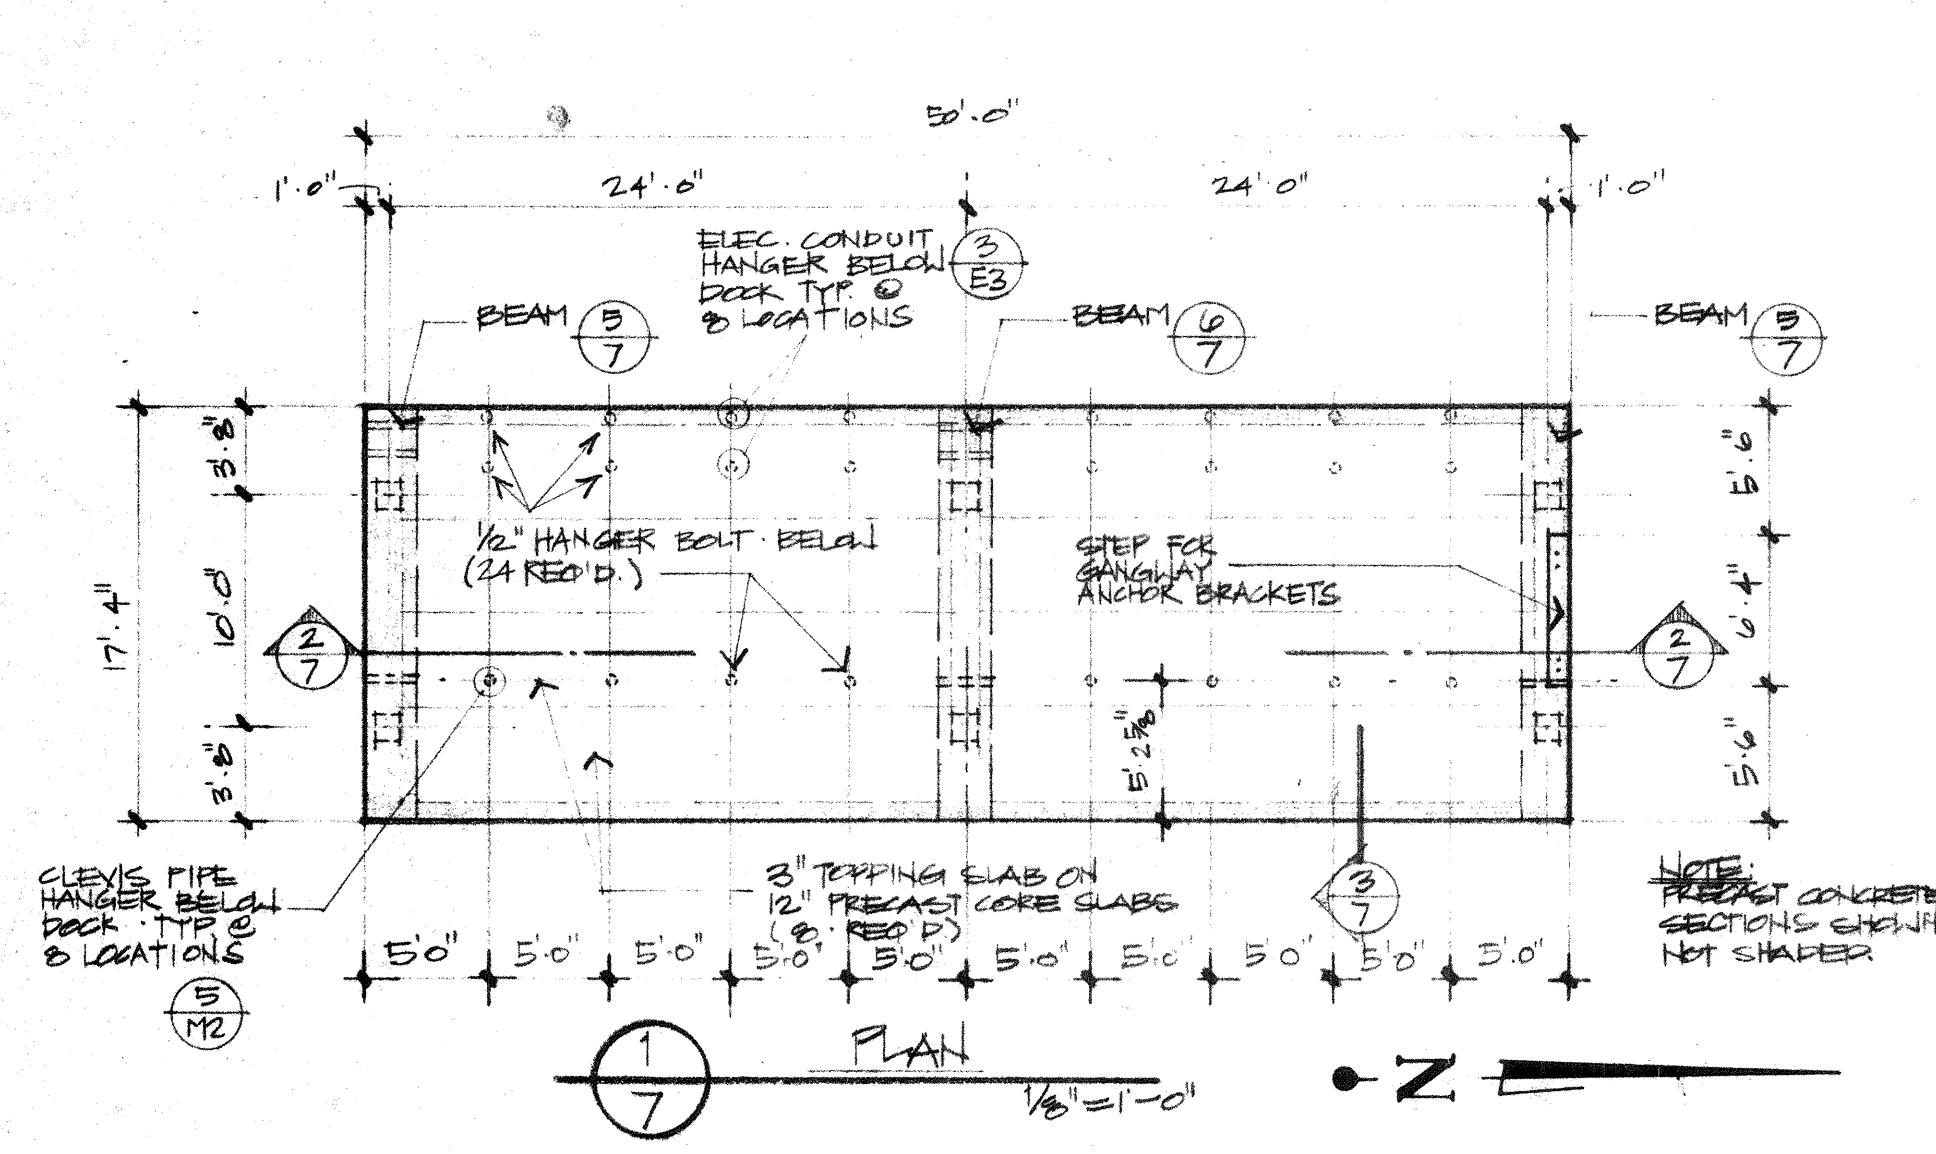


RECORD DRAWING 1/8" = 1'-0"

EDA PROJECT NO. 07-01-02549


NOTE: HANGER BOLT LOCATIONS ARE SHOWN DOTTED. LOCATIONS TO BE UTILIZED REQUIRE INSTALLATION OF CLEVIS PIPE HANGERS. ALL FUTURE LOCATIONS REQUIRE INSTALLATION OF 1/2" HANGER BOLTS ONLY. ALL UTILITY RUNS REQUIRE 3/8" HANGER BOLTS EXCEPT FOR 2 1/2" PRESSURE MAIN WHICH REQUIRES 1/2" HANGER BOLTS.

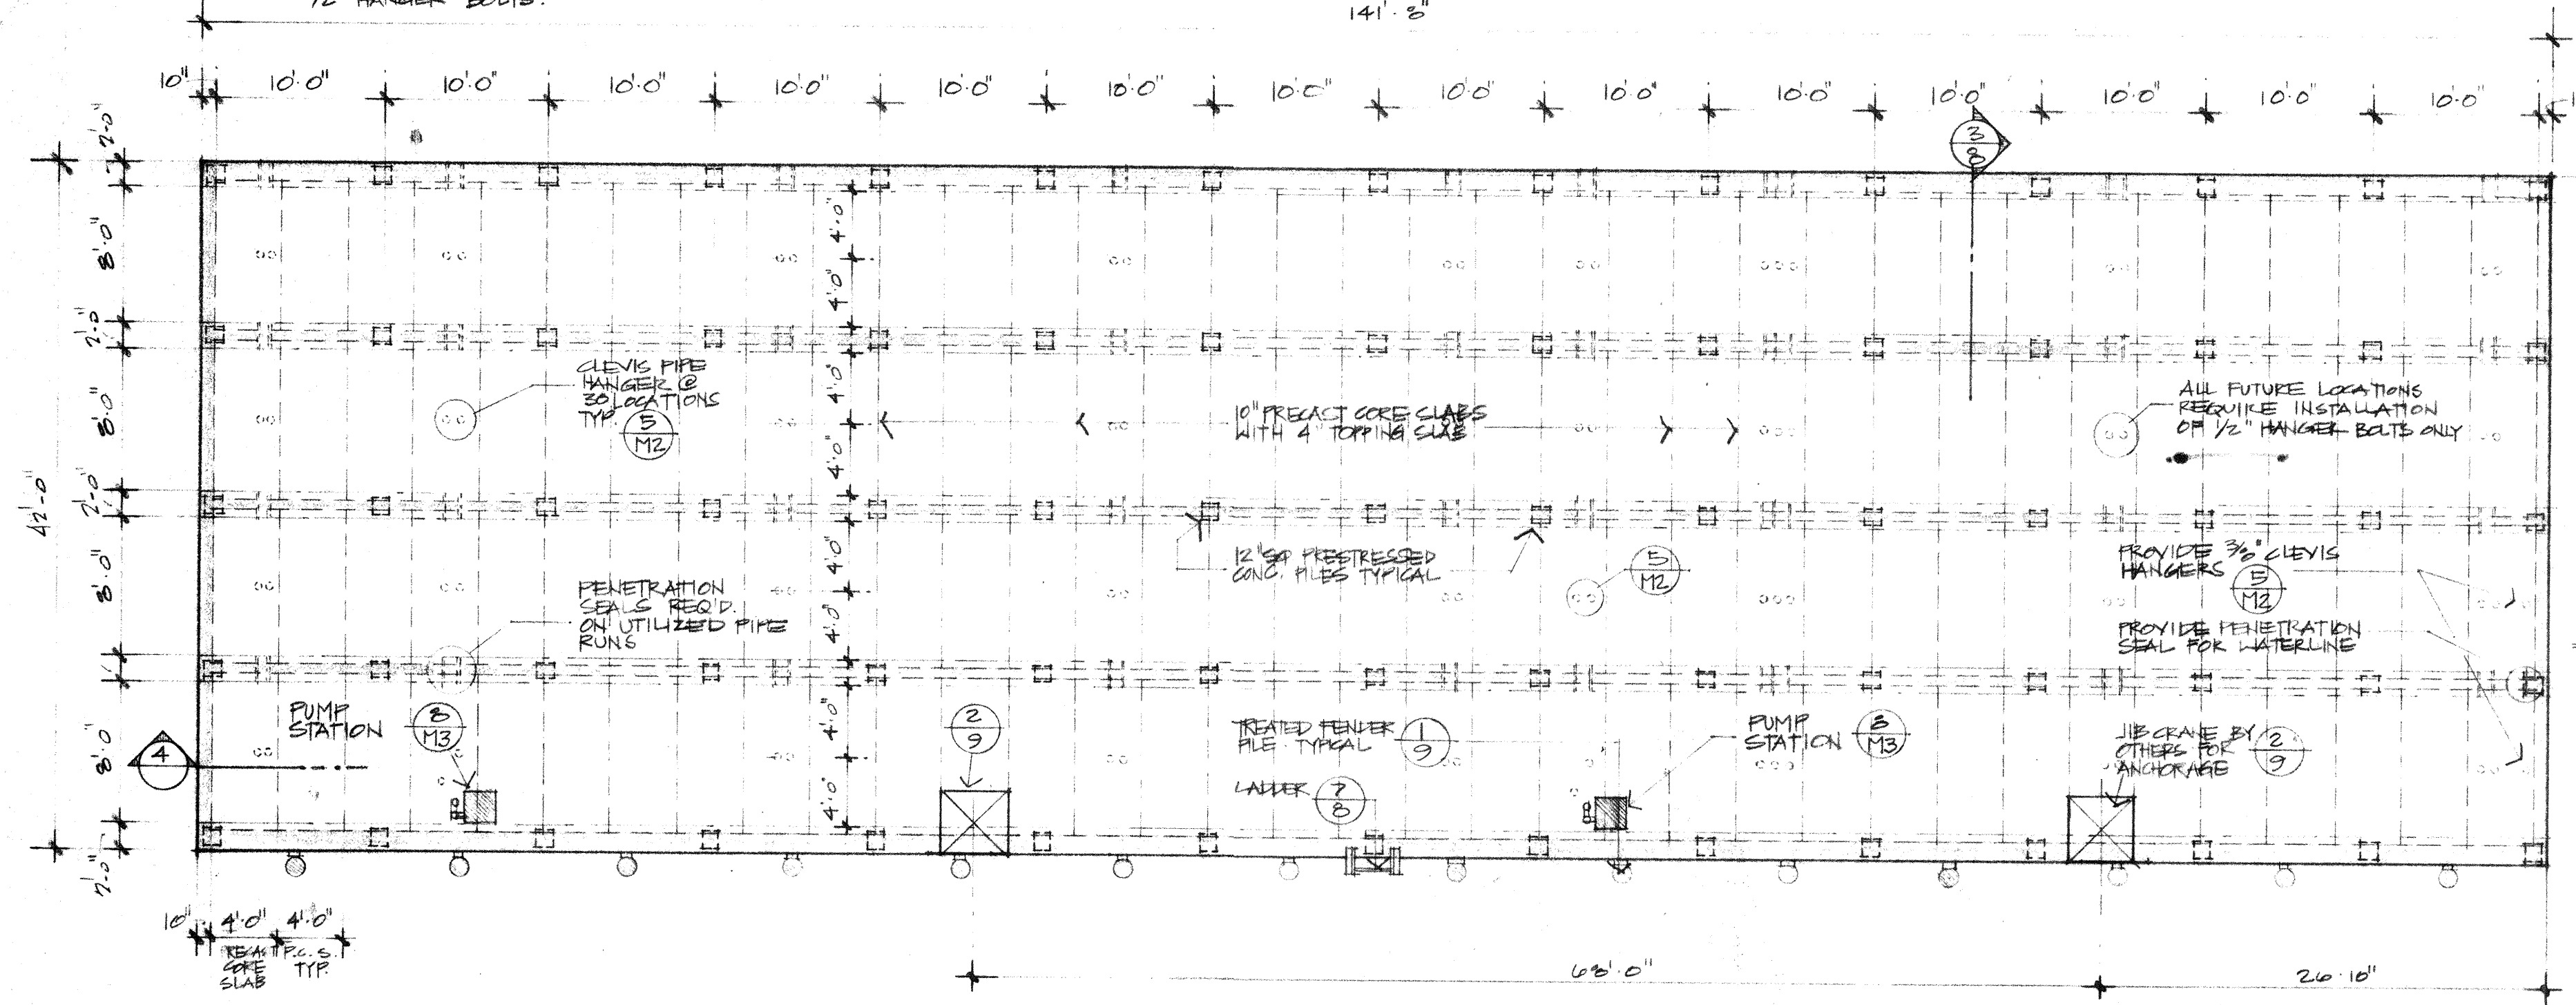

1 PLAN @ FISH HANDLING DOCK

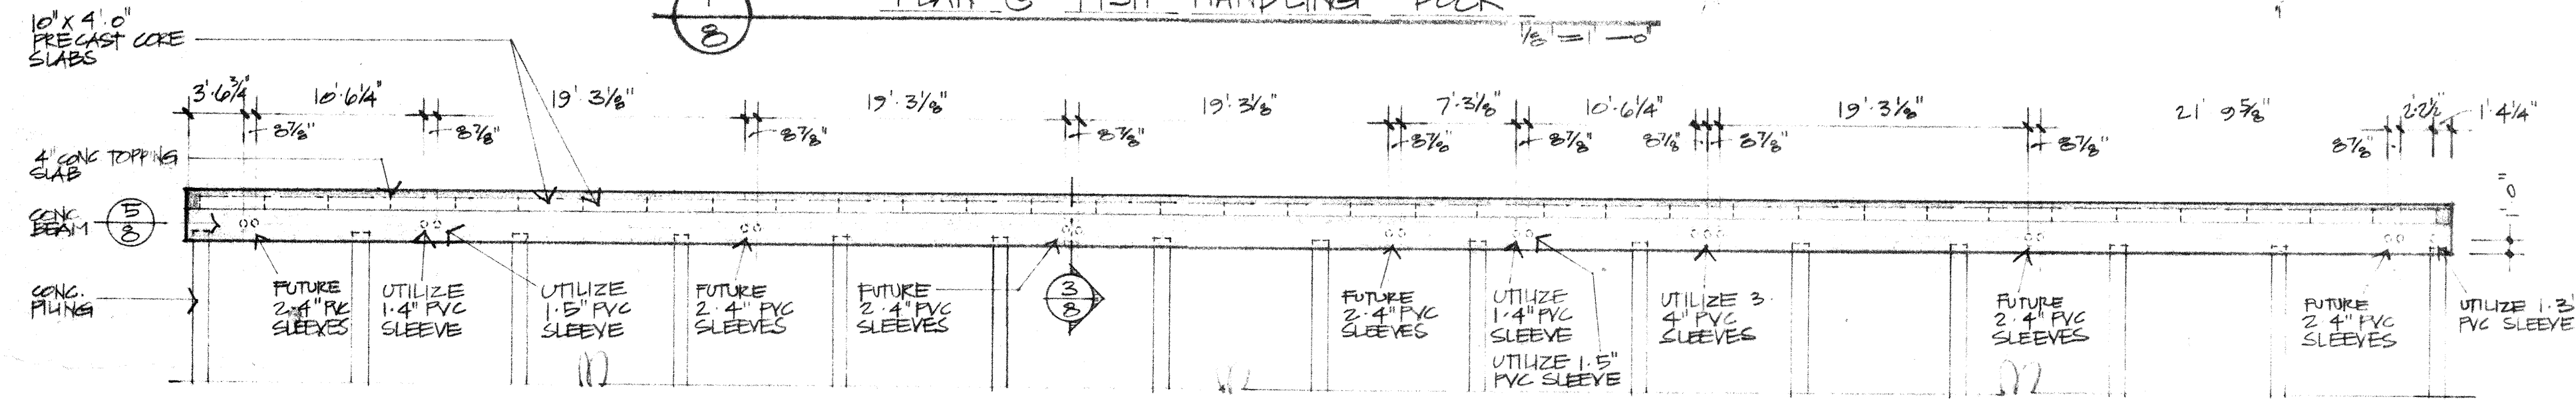


2 ELEVATION @ FISH HANDLING DOCK

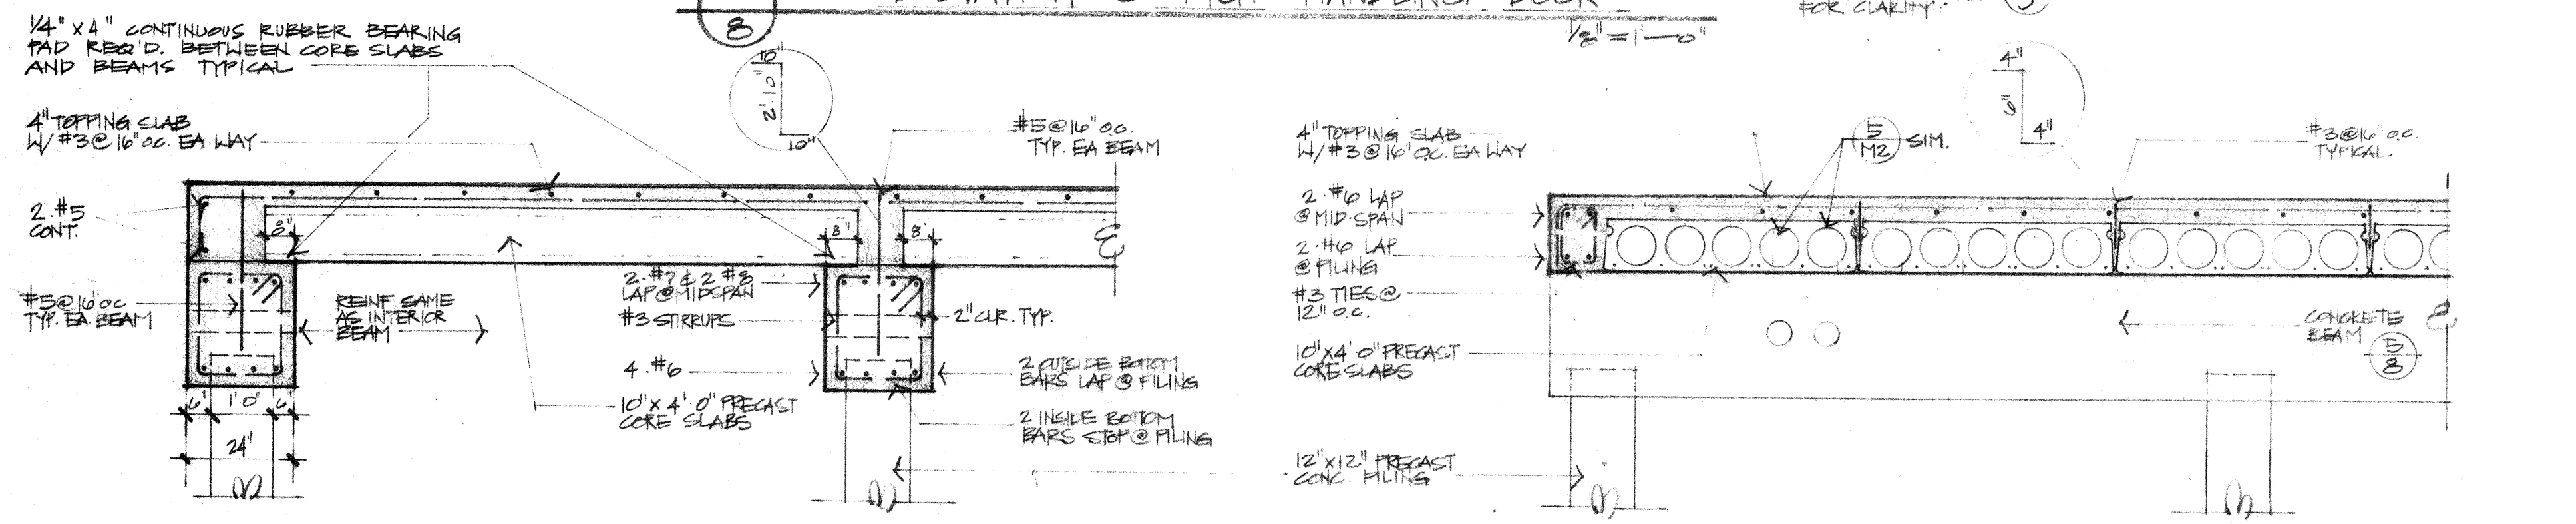


3 SECTION


4 SECTION

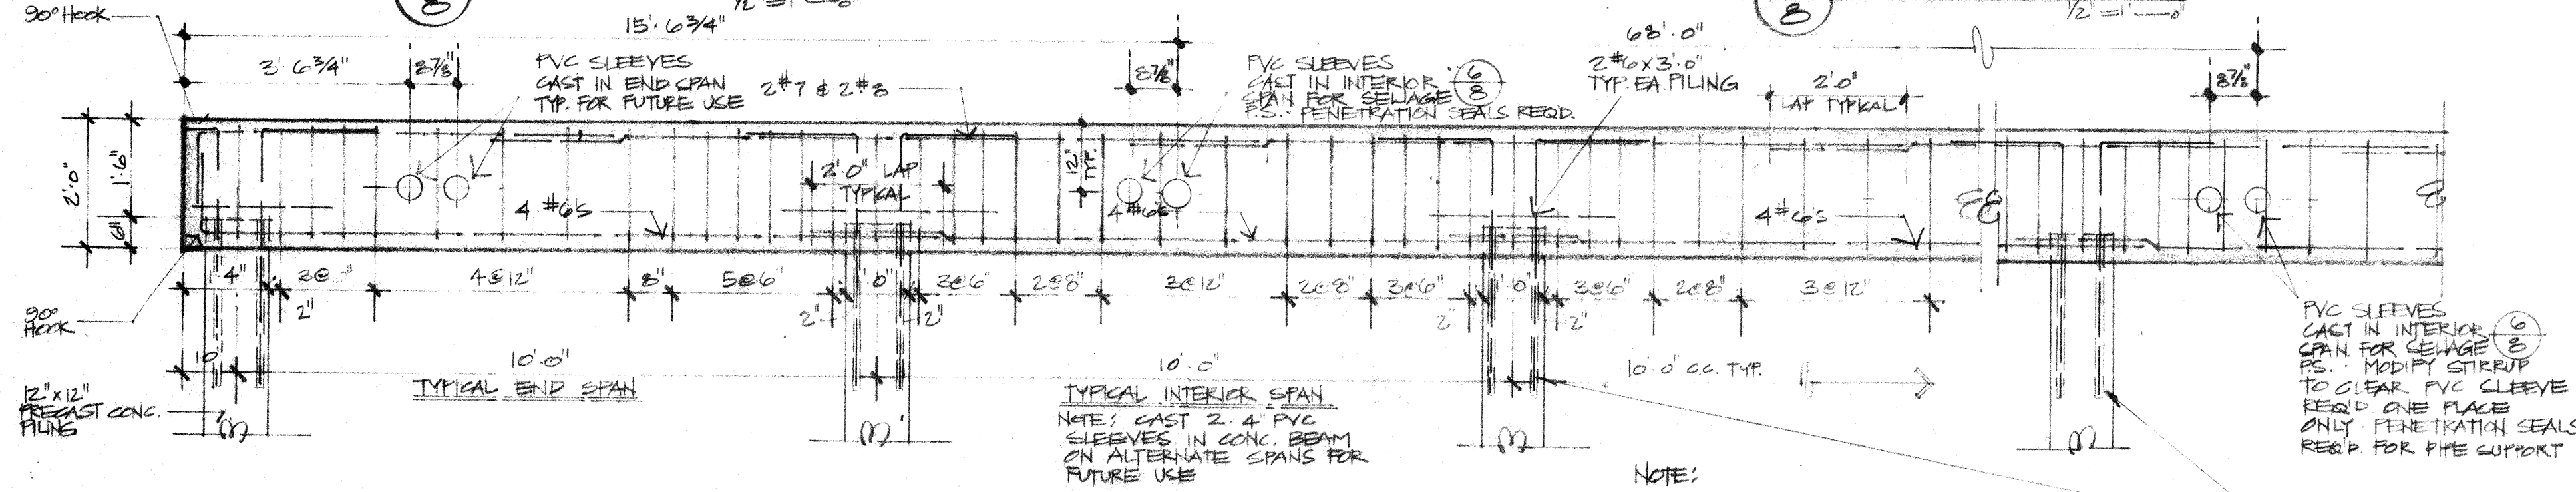

5 TYPICAL CONCRETE BEAM

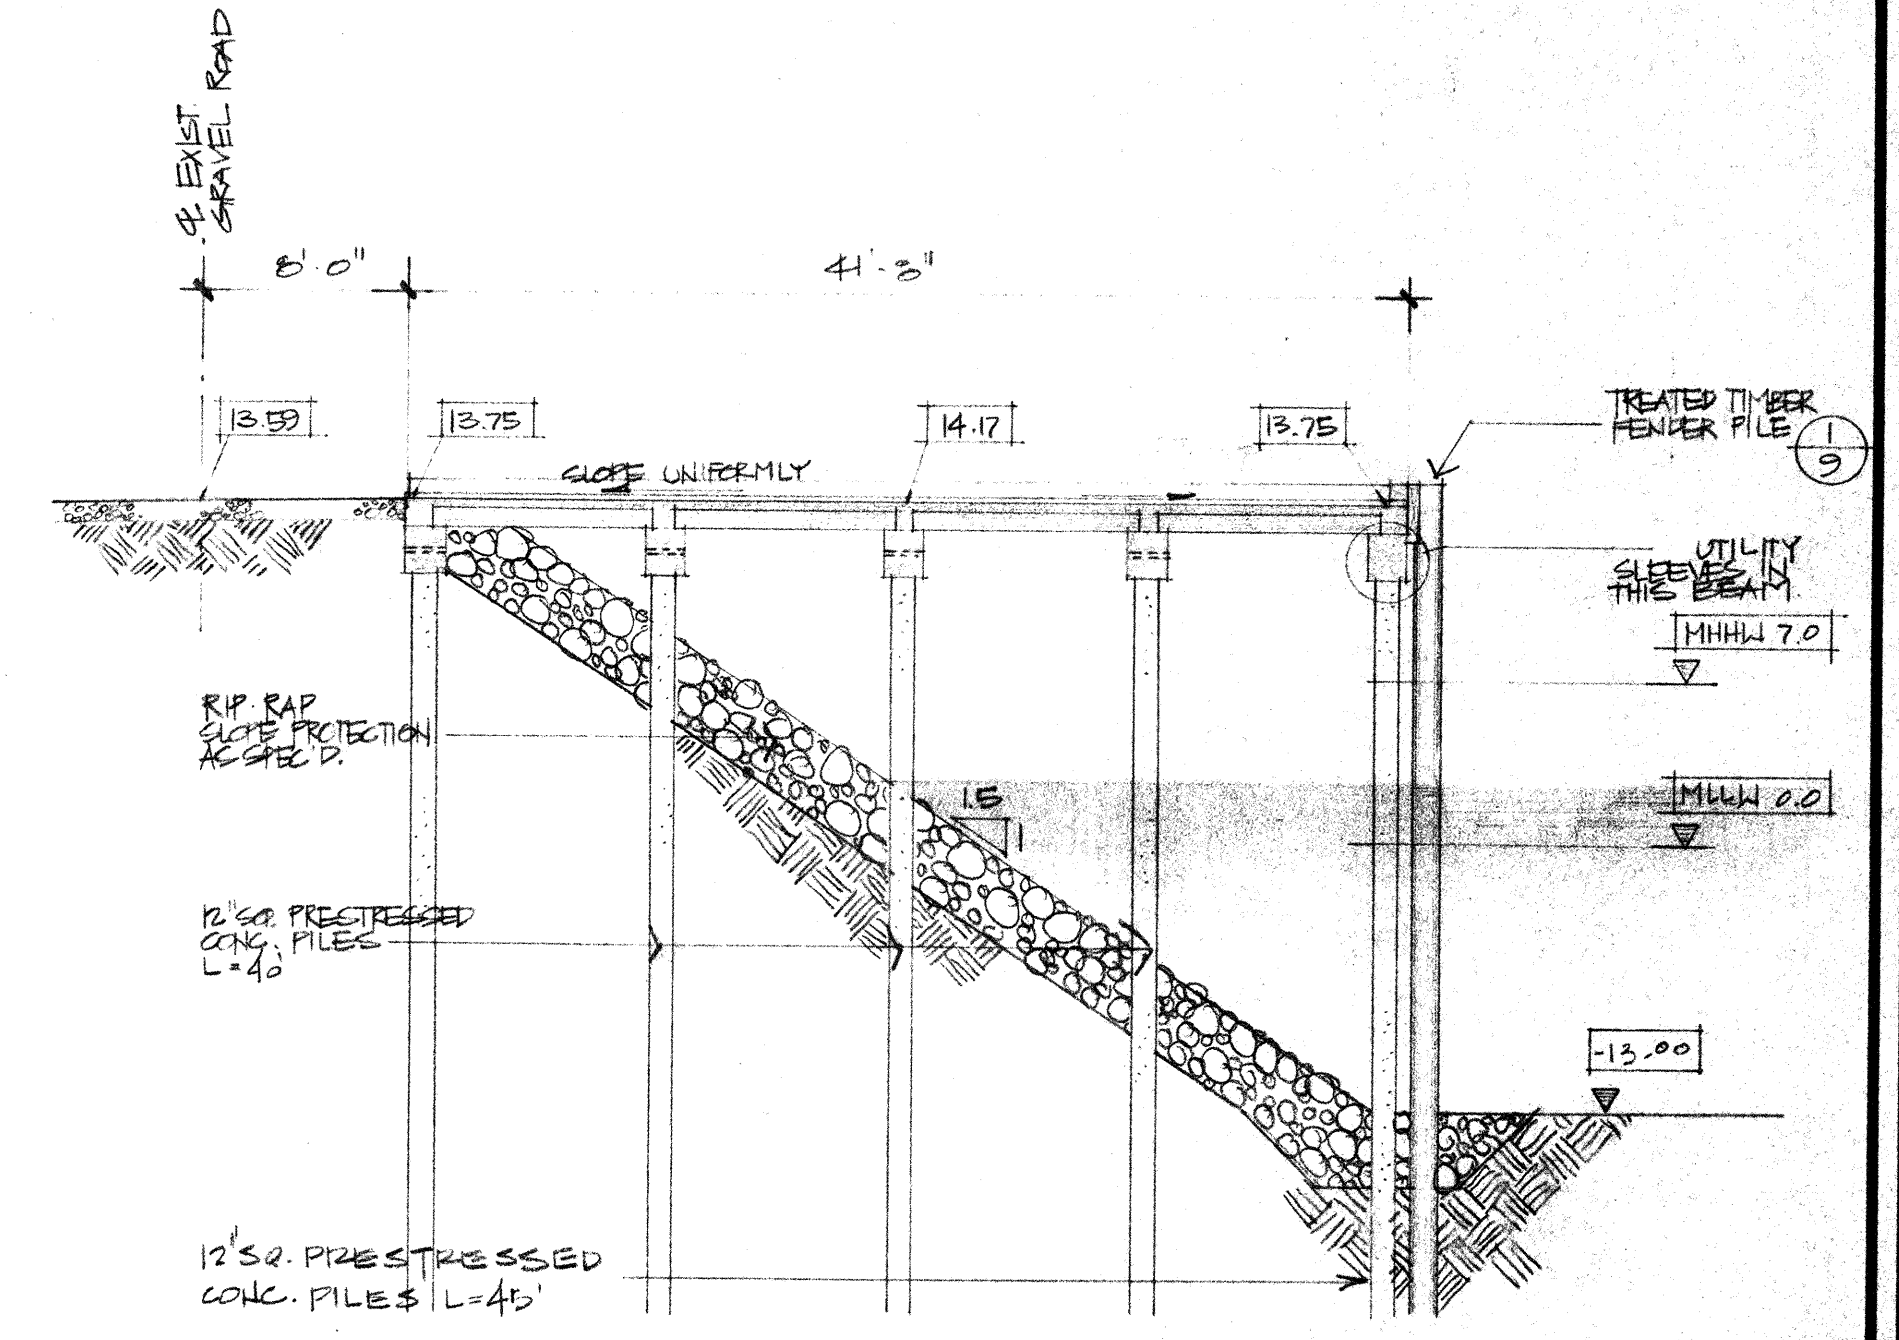

6 SECTION @ FISH HANDLING DOCK

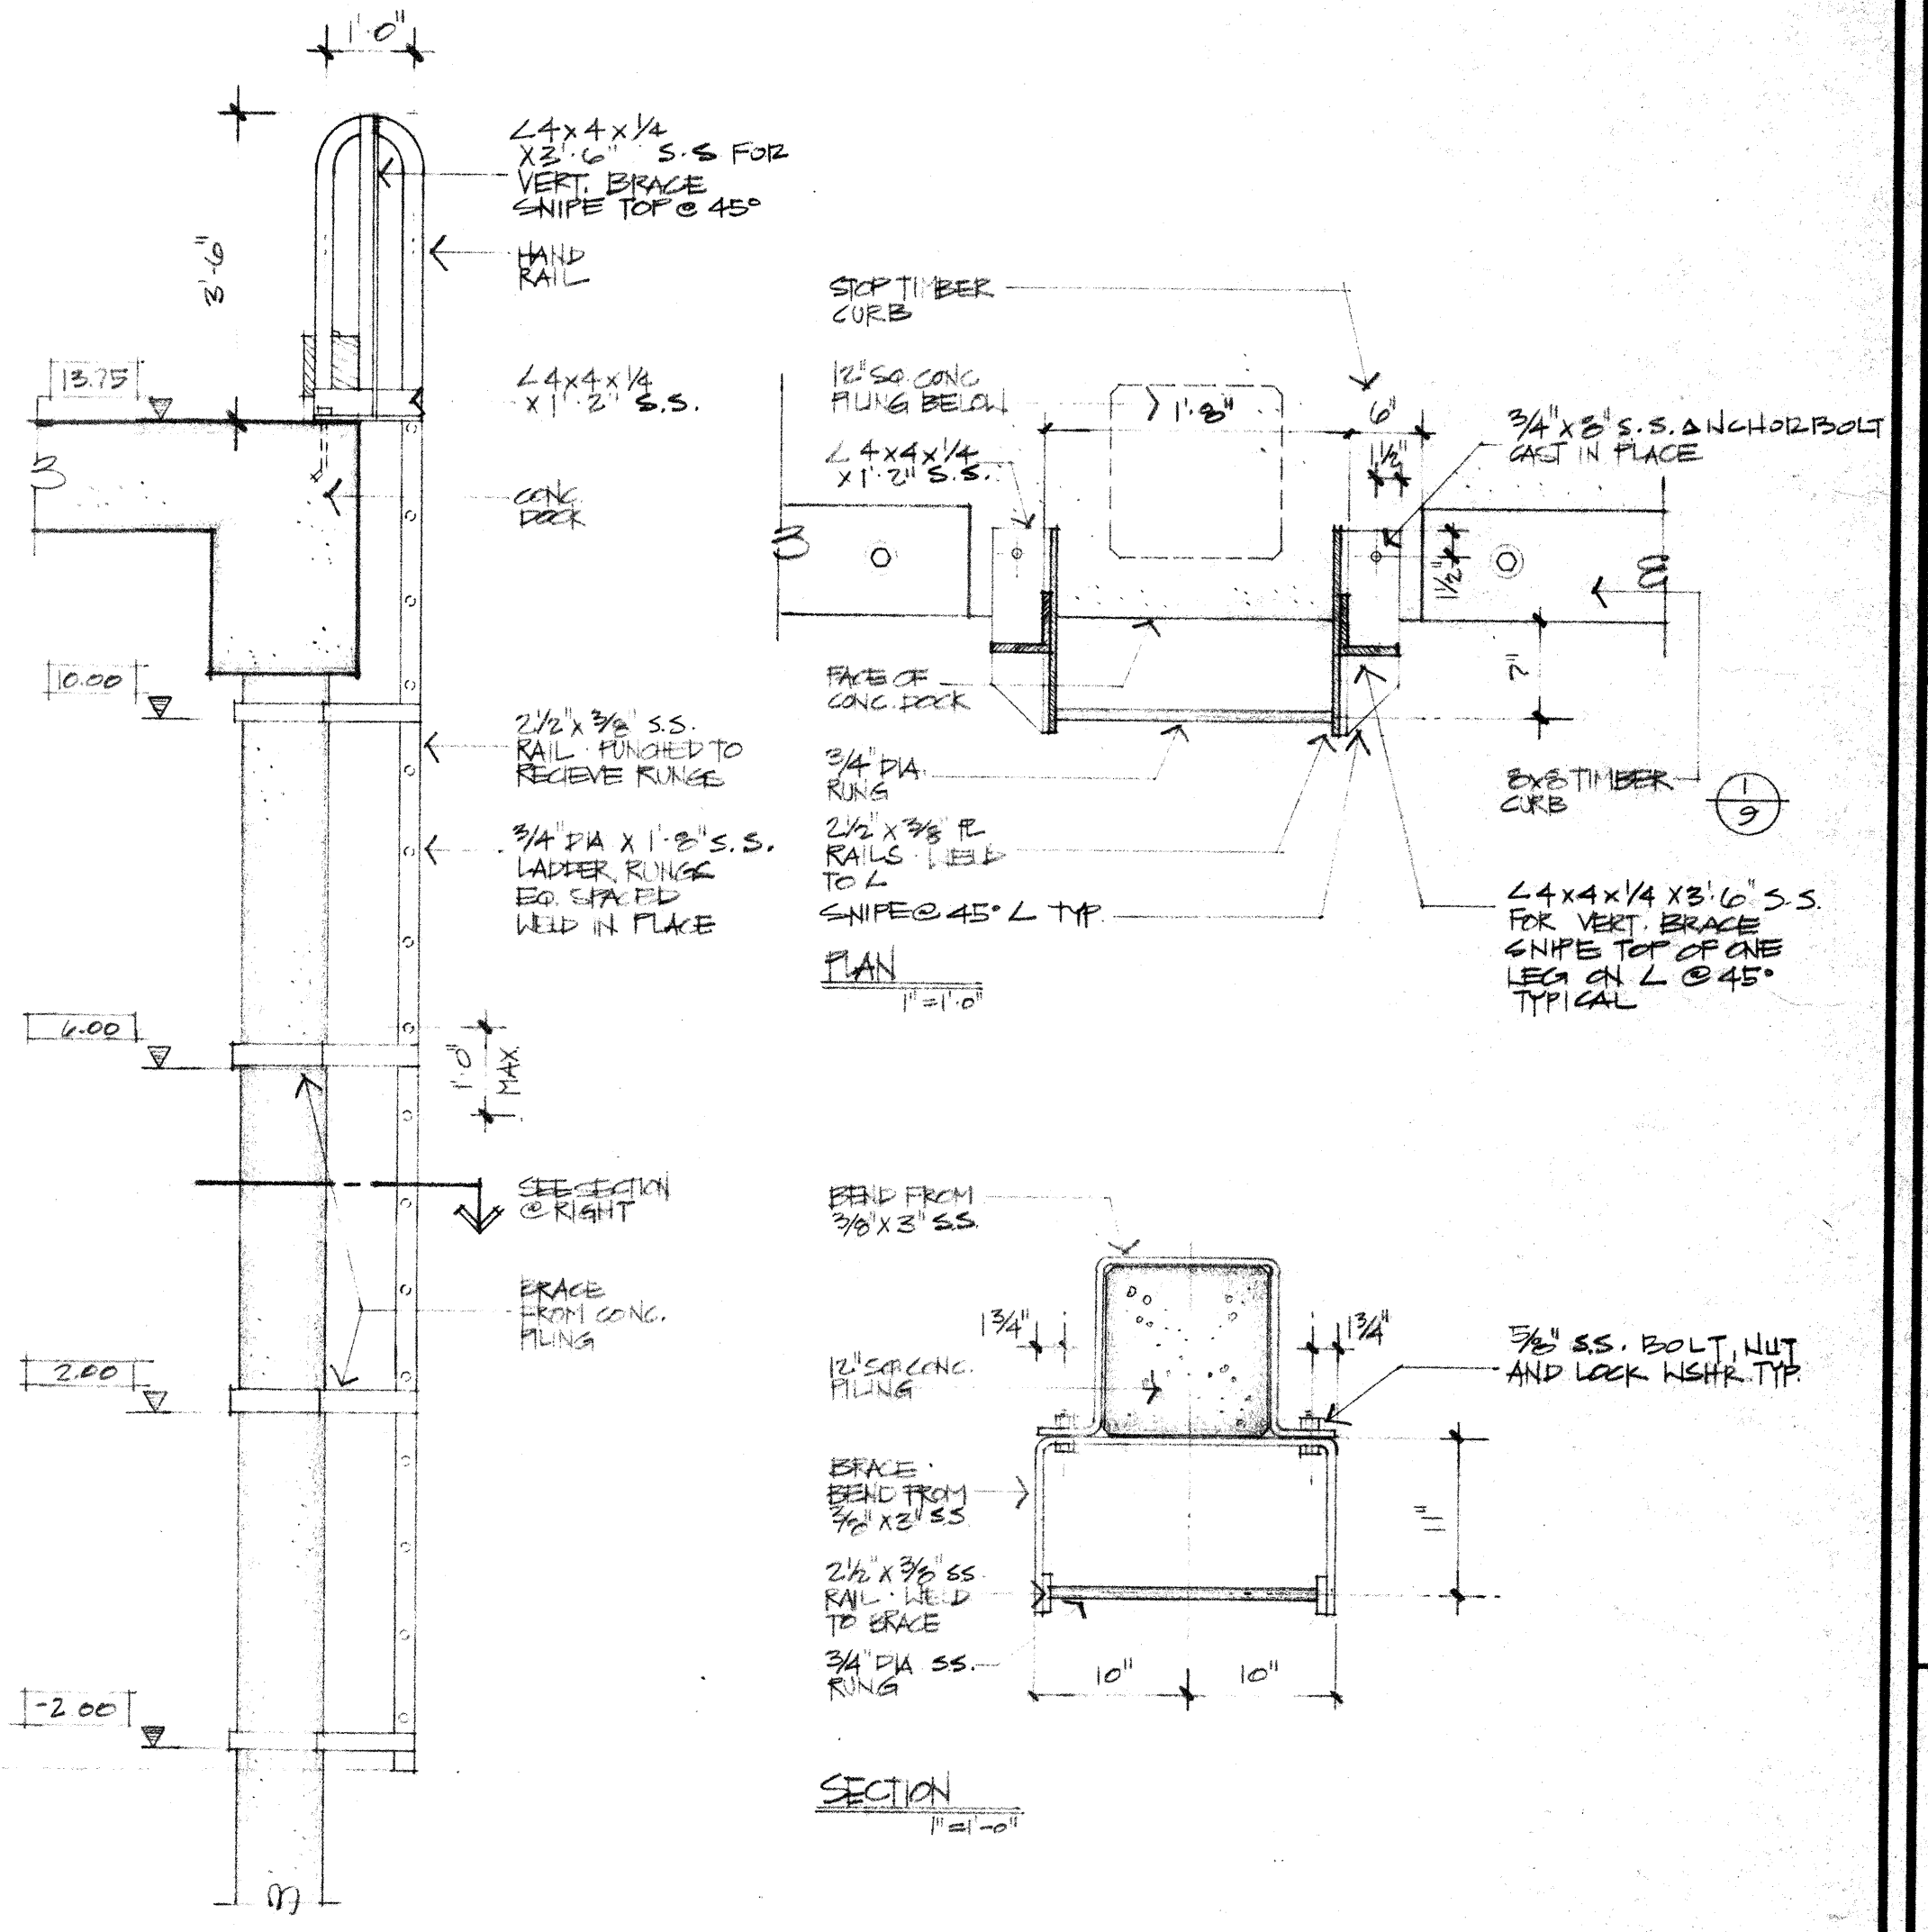

7 LADDER DETAILS

0 PARTS FURNISHED BY OWNER


NOTE: BEAM REQUIR. 5 PLACES PVC SLEEVES FOR UTILITIES IN 4 BEAMS ONLY. NO SLEEVES IN EAST BEAM.

NOTE: TYPICAL CONCRETE COVERAGE OVER BARS FROM FACE OF CONC. TO EDGE OF BAR IS 1 1/2" FOR #3'S AND 2" FOR #4'S AND LARGER.

PVC SLEEVES CAST IN INTERIOR SPAN FOR UTILITY RUNS. NOTE: PENETRATION SEALS REQ'D FOR PIPE SUPPORT.

NOTE: ELEV'S ARE MLLW DATUM

RECORD DRAWING 1/35 E.K.

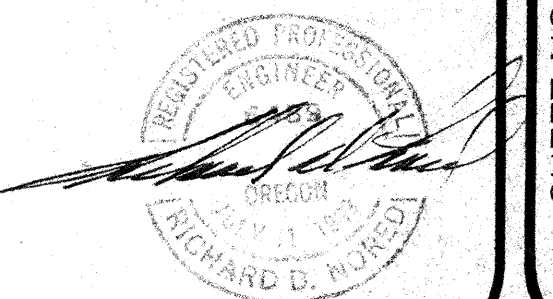

HCE INC./ENGINEERS & PLANNERS
Coos Bay, Oregon / 375 Park Avenue 97420 / (503) 269-1166
Portland, Oregon / 19 N. W. 5th Ave. 97209 / (503) 222-1887
Albany, Oregon / 300 Ellsworth St. So. 97321 / (503) 926-0064






SHEET TITLE
FISH HANDLING DOCK

PROJECT
PORT OF BANTON
COQUILLE RIVER BOAT BASIN
COOS COUNTY, OREGON

PROJECT #
20771


DATE
JULY, 1982

SHEET NO.
00

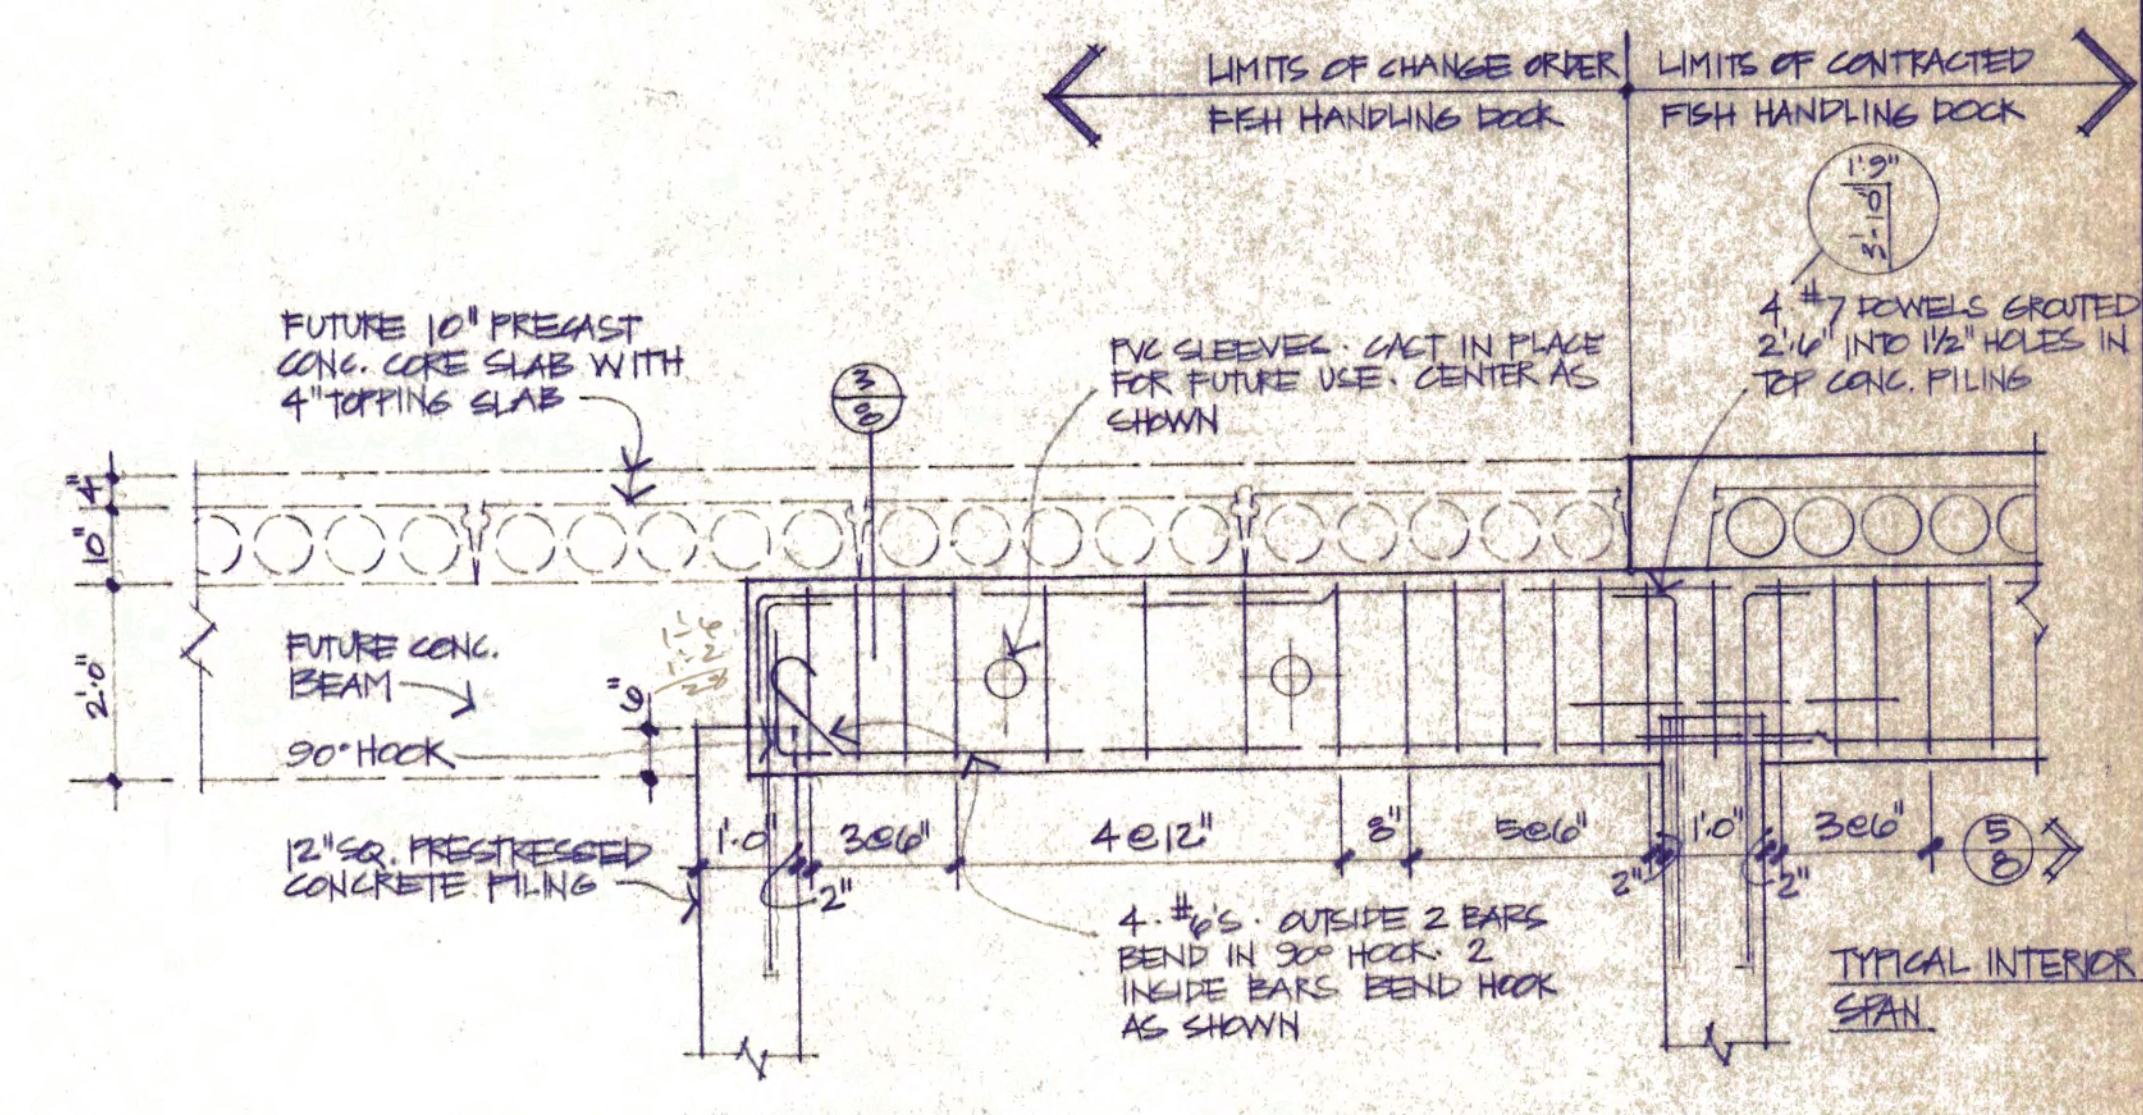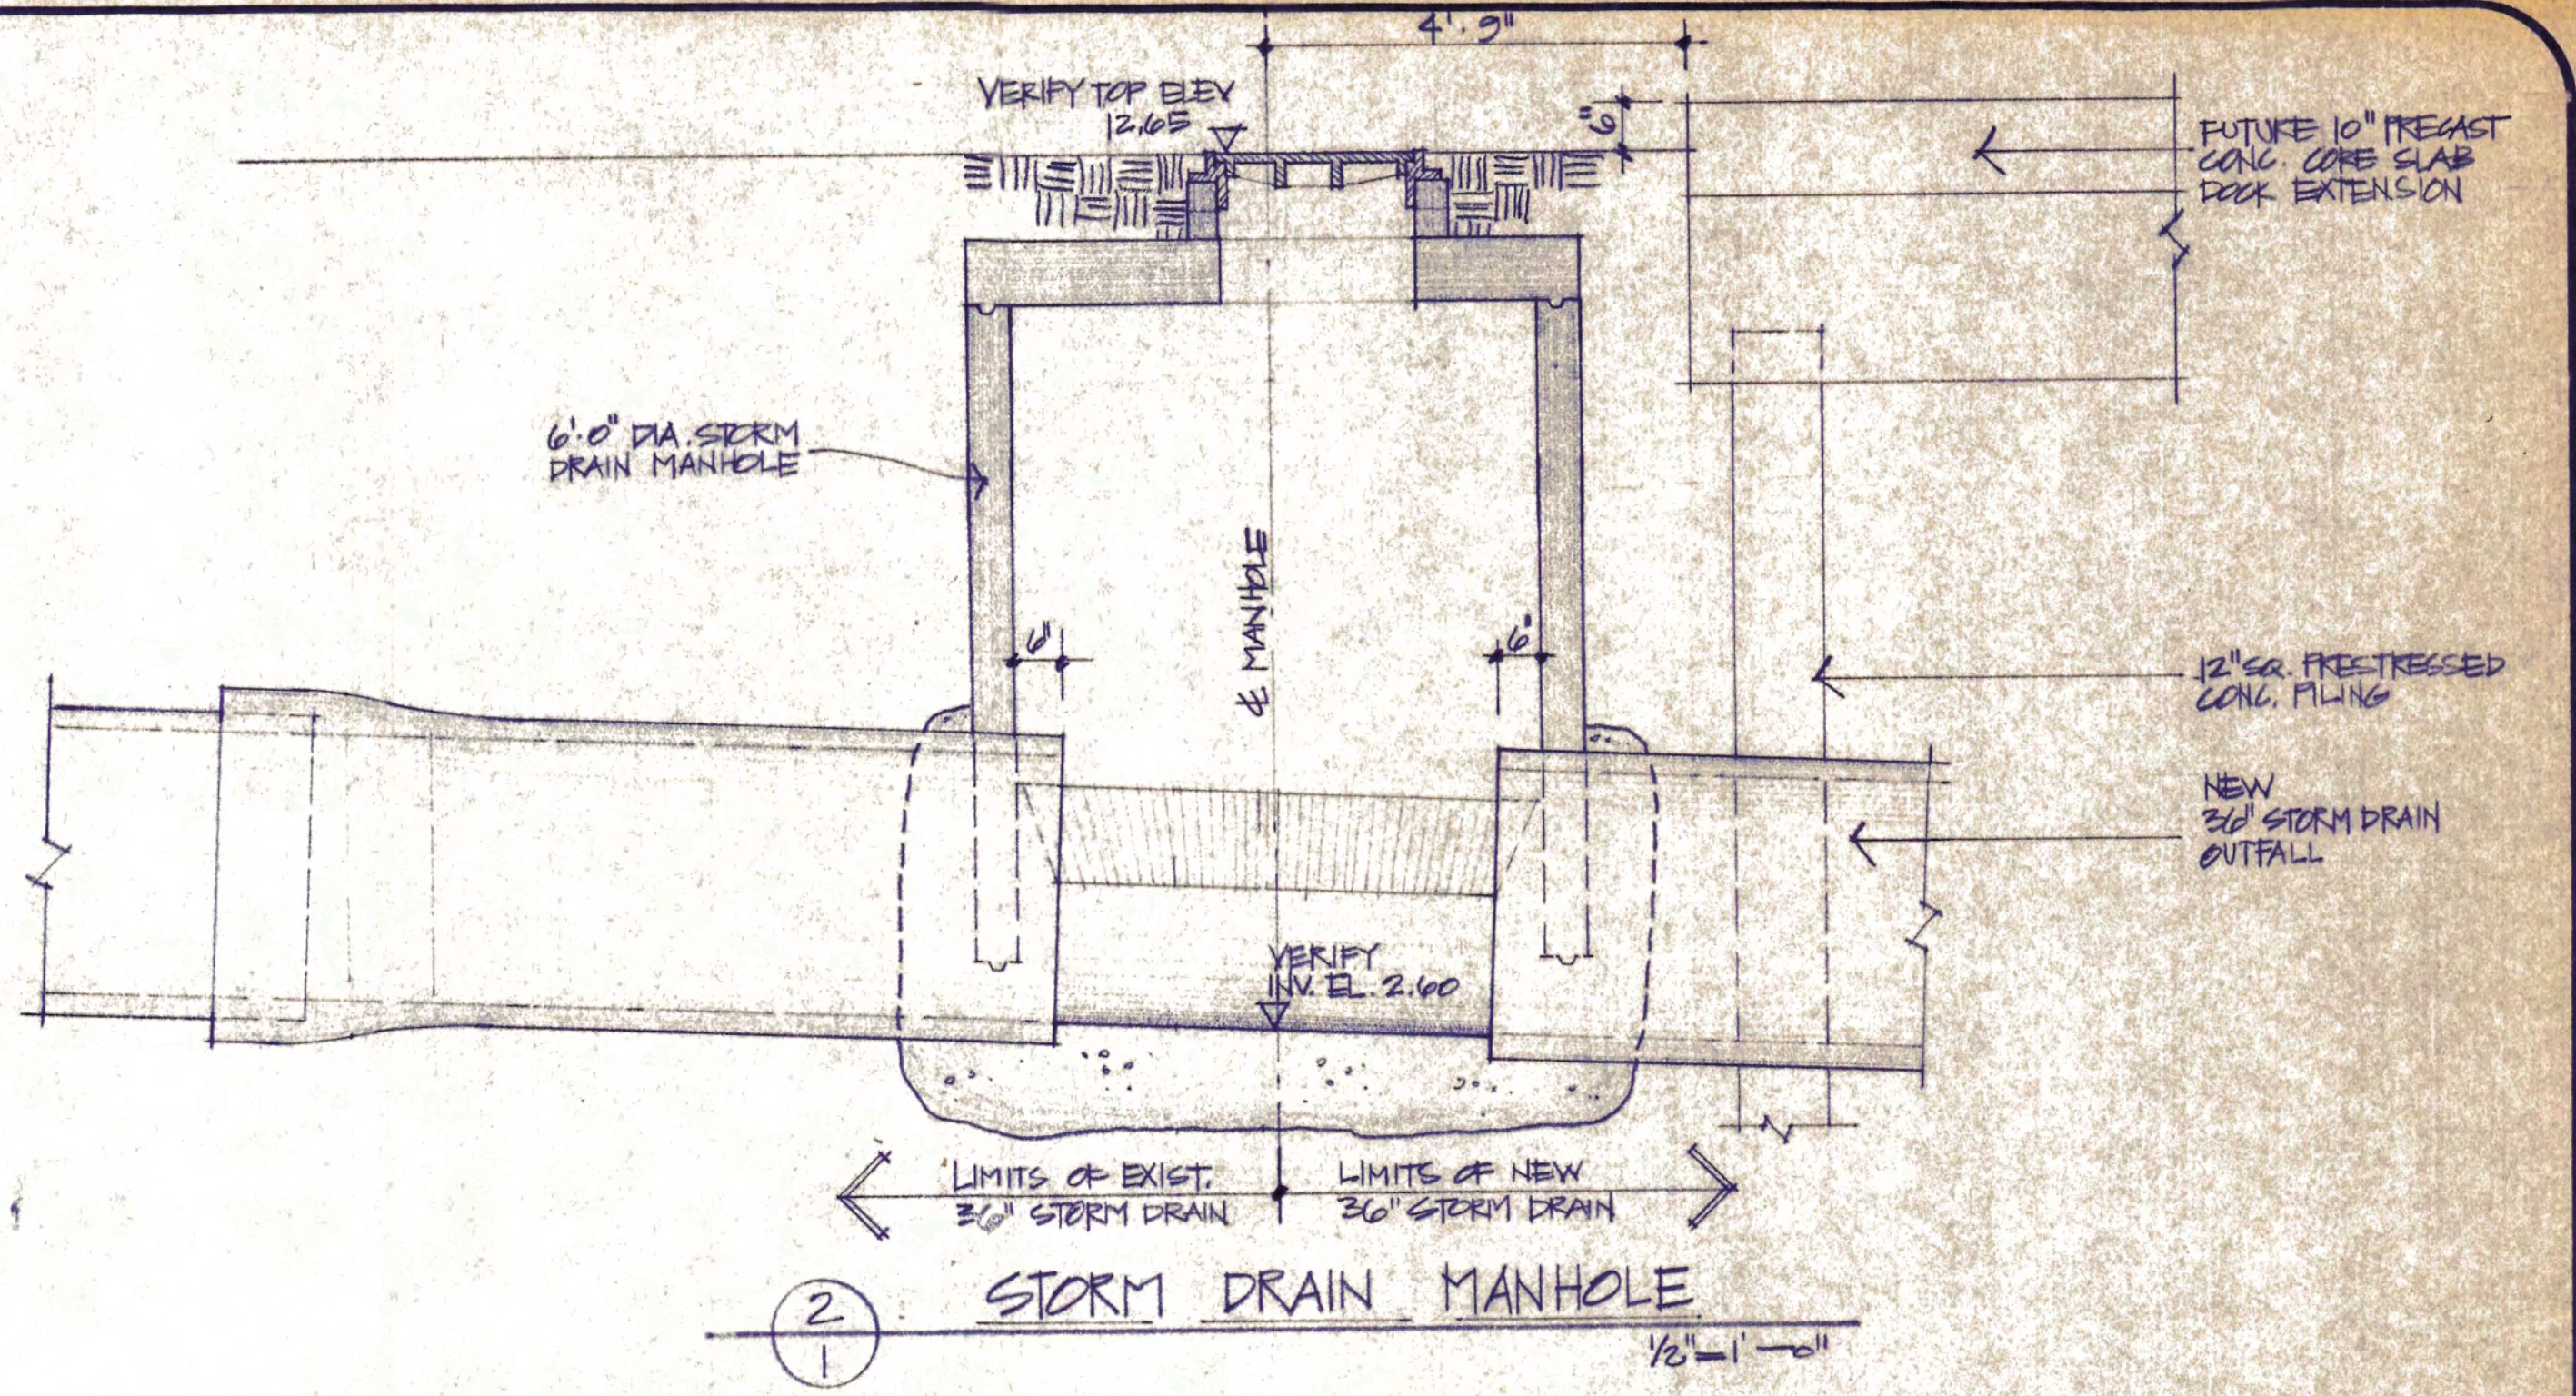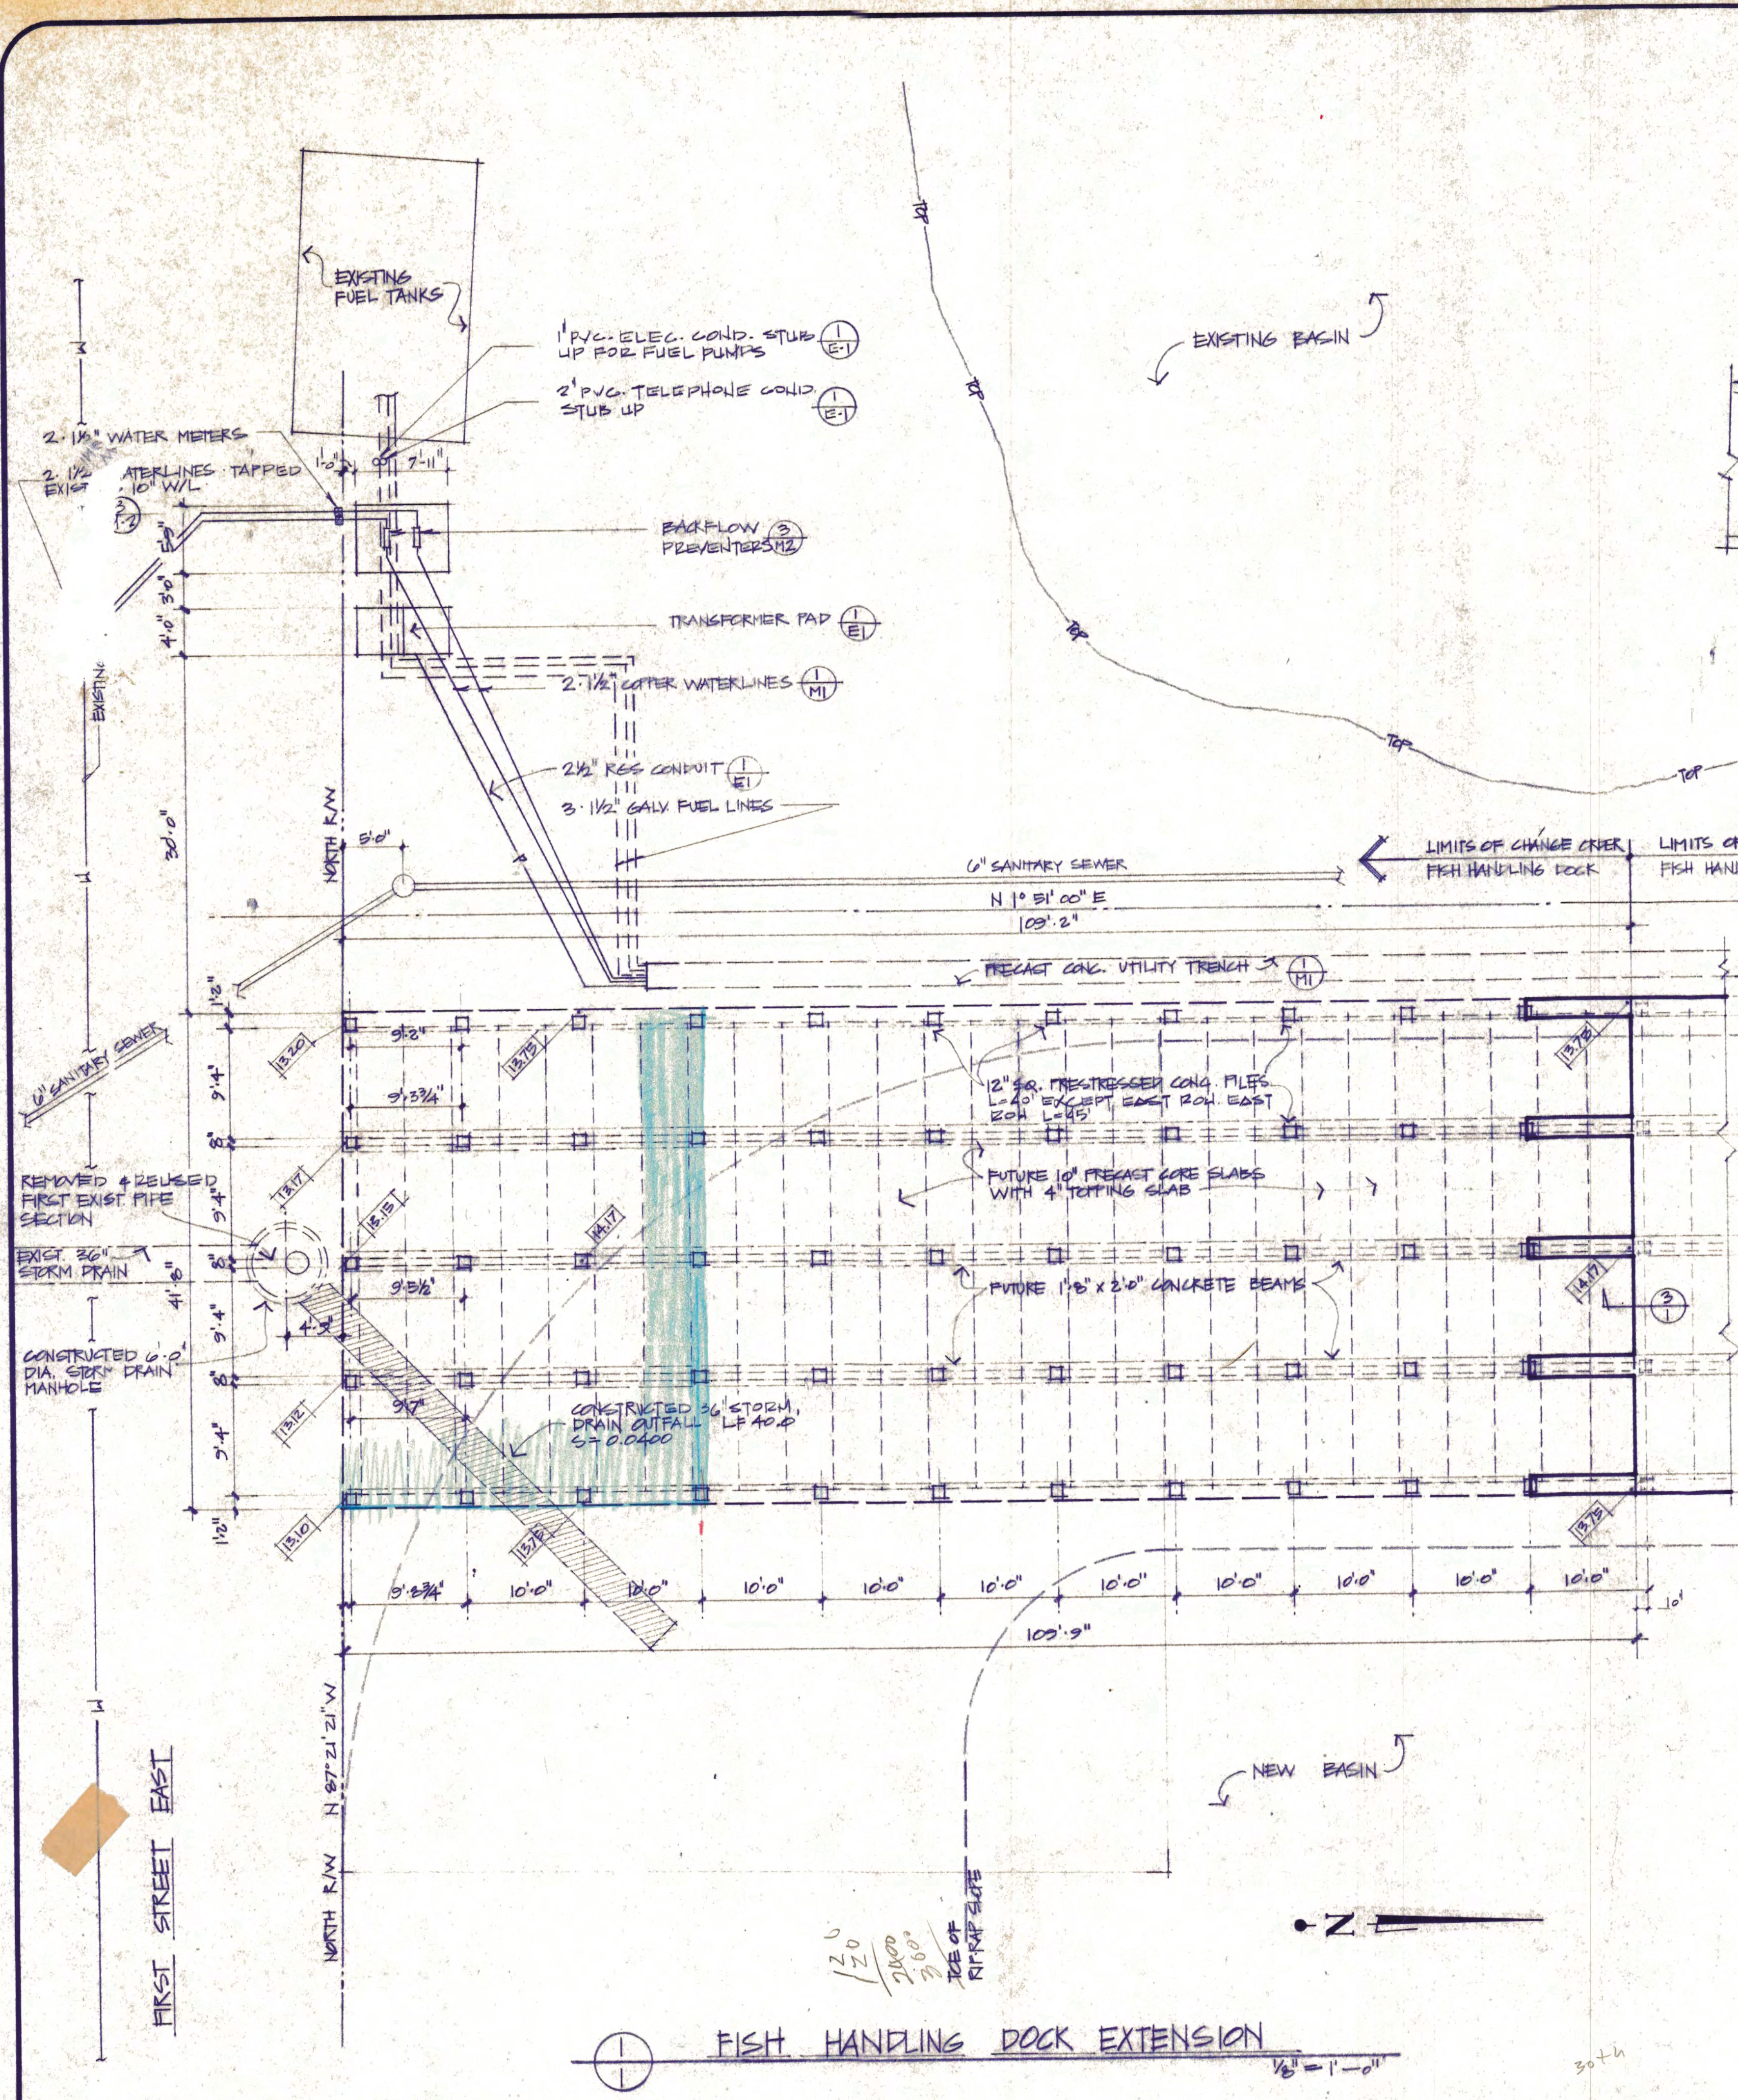


- NOTES:
- ① ELEVATION SHOWN ARE FINISH GRADE OF 4" TOPPING SLAB.
 - ② ELEVATIONS ARE MLLWD.
 - ③ BEARINGS ARE LAMBERT PROJECTION OF OREGON, SOUTH ZONE.


14.17	1.125	
15.295		
13.5		
12		
13.79		
14.17	1.125	MLLWD
15.295		
13.5		
12		
13.79		

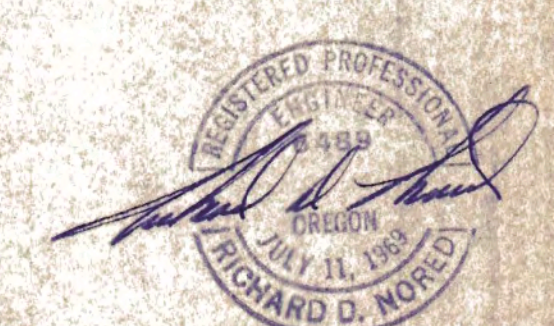


RECORDED DRWG. 1/25 P.K.
 REVISED STORM DRAIN LOCATION AND DETAIL. 1-12-83

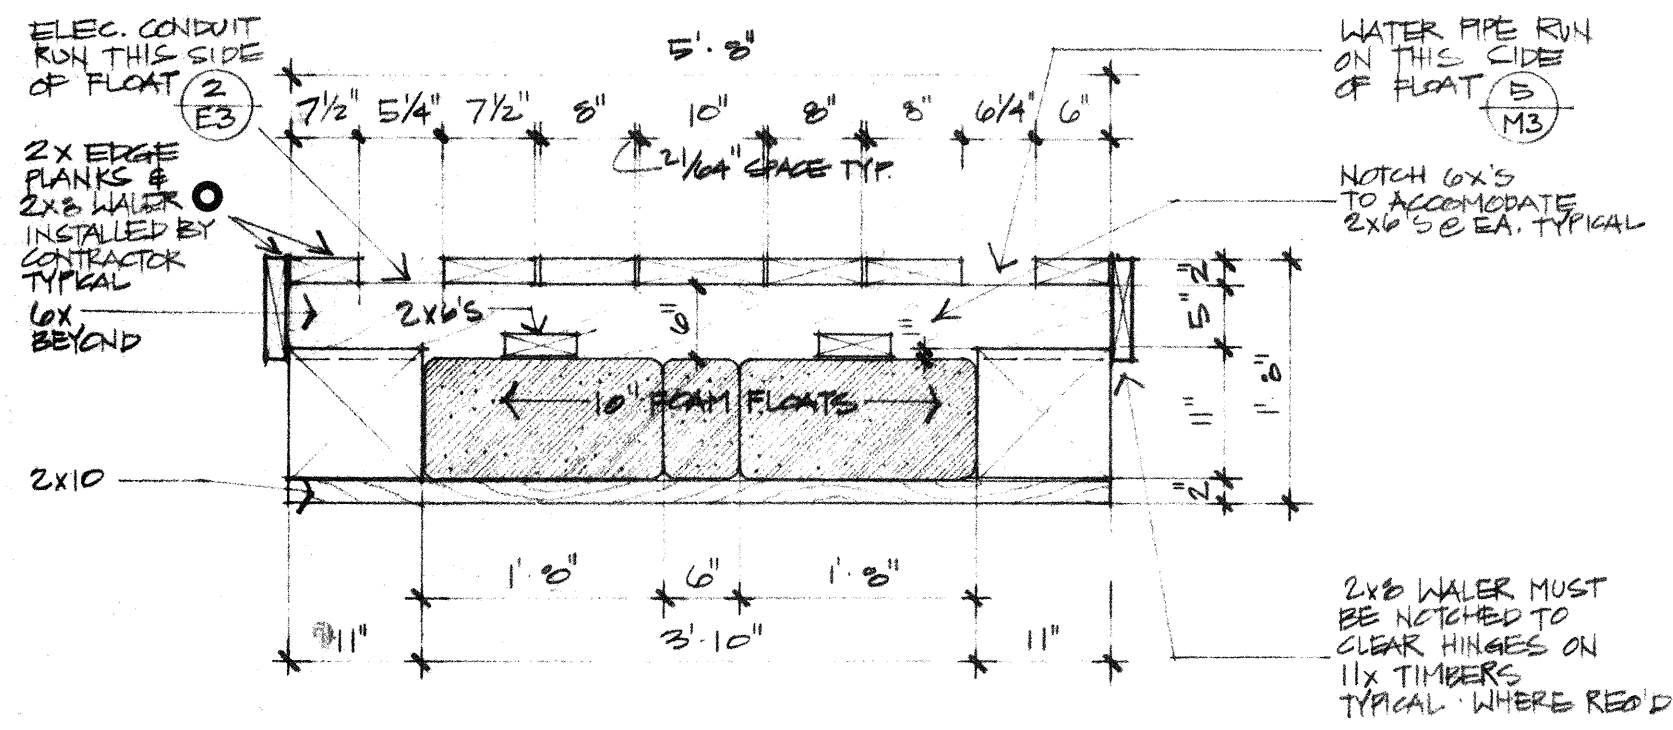


SECTION @ FLOATS
NOTE: TYPICAL VIEW @ FLOATS
D | E | F | G | AND | H

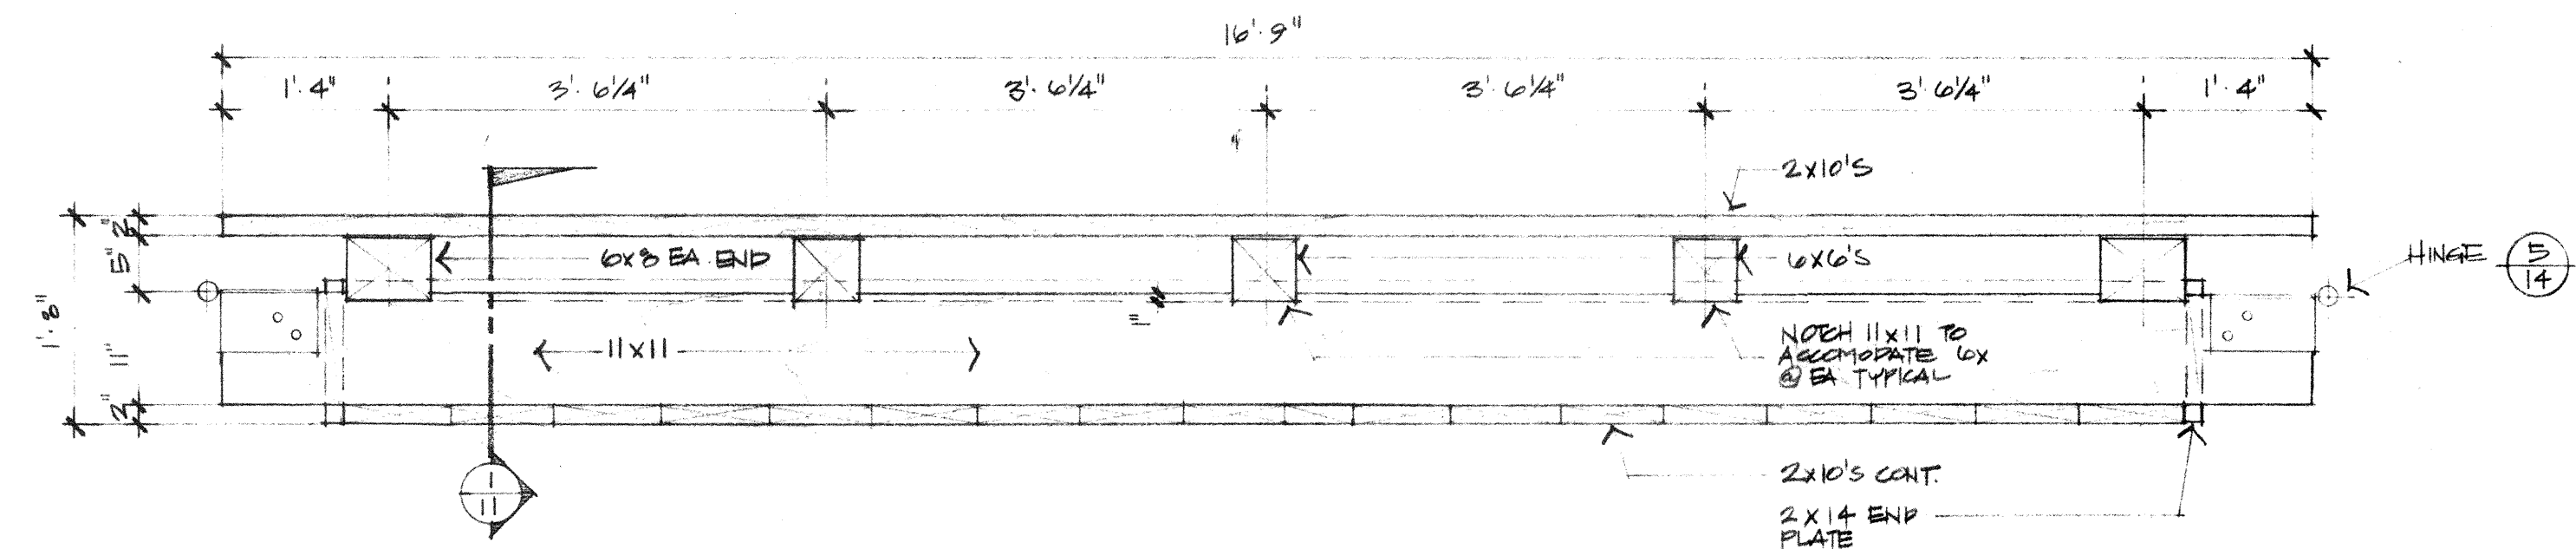


ELEVATION @ FLOAT (D)
NOTE: 2x6 WALKER OMITTED FOR CLARITY

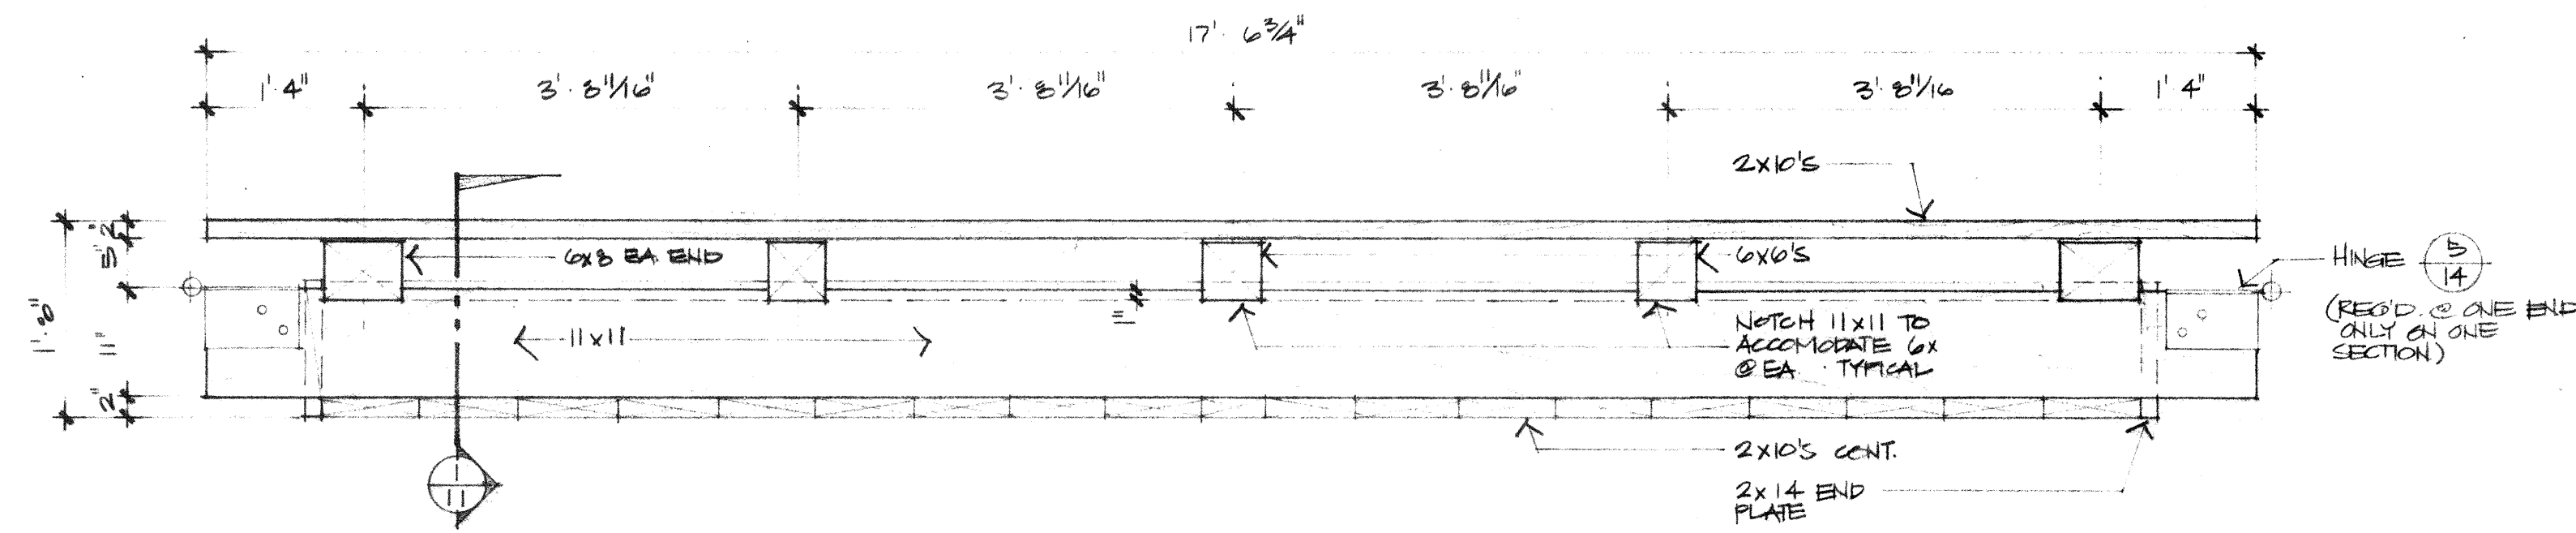

ELEVATION @ FLOAT (E)
NOTE: 2x6 WALKER OMITTED FOR CLARITY

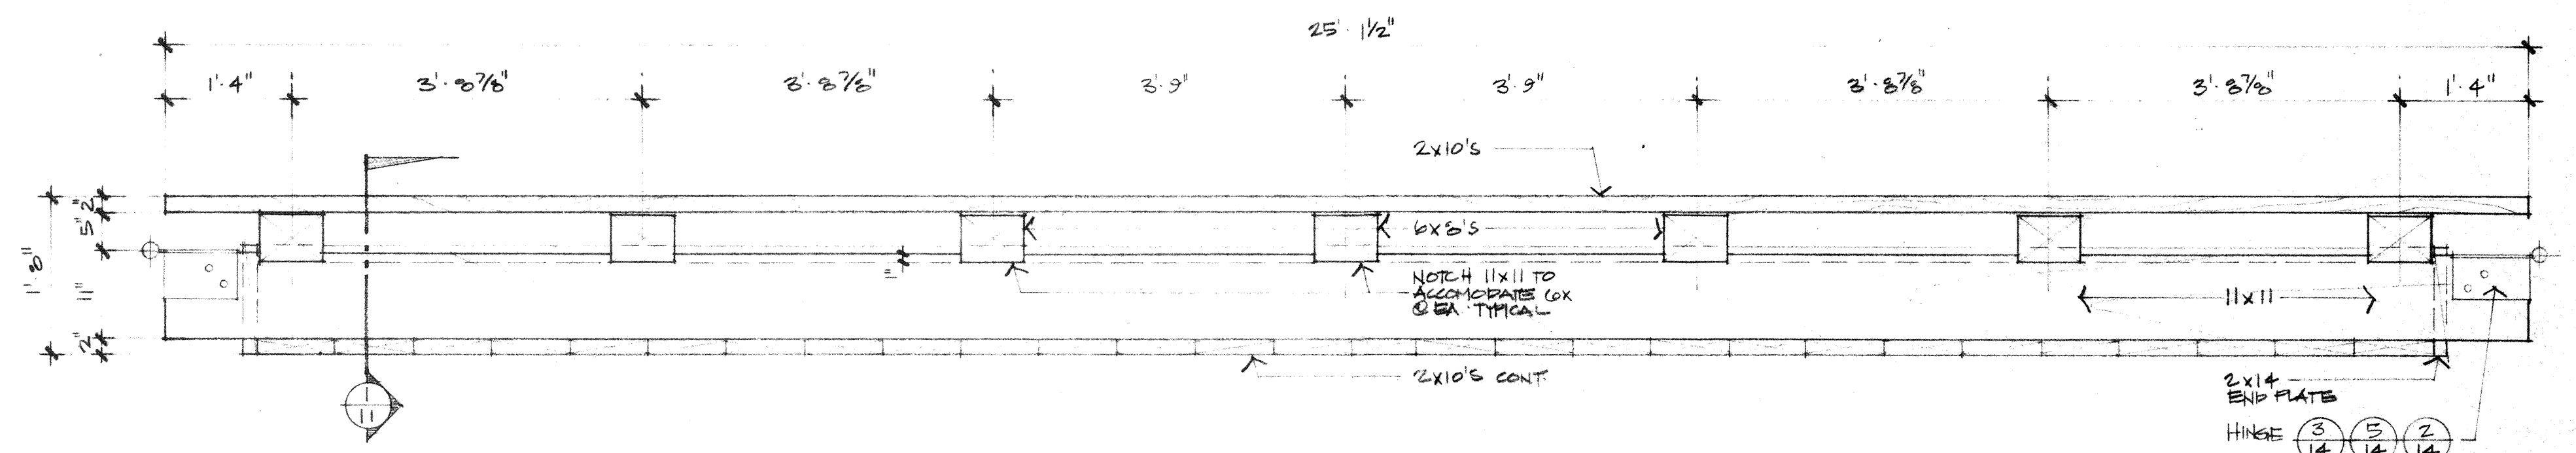


ELEVATION @ FLOAT (F)
NOTE: 2x6 WALKER OMITTED FOR CLARITY

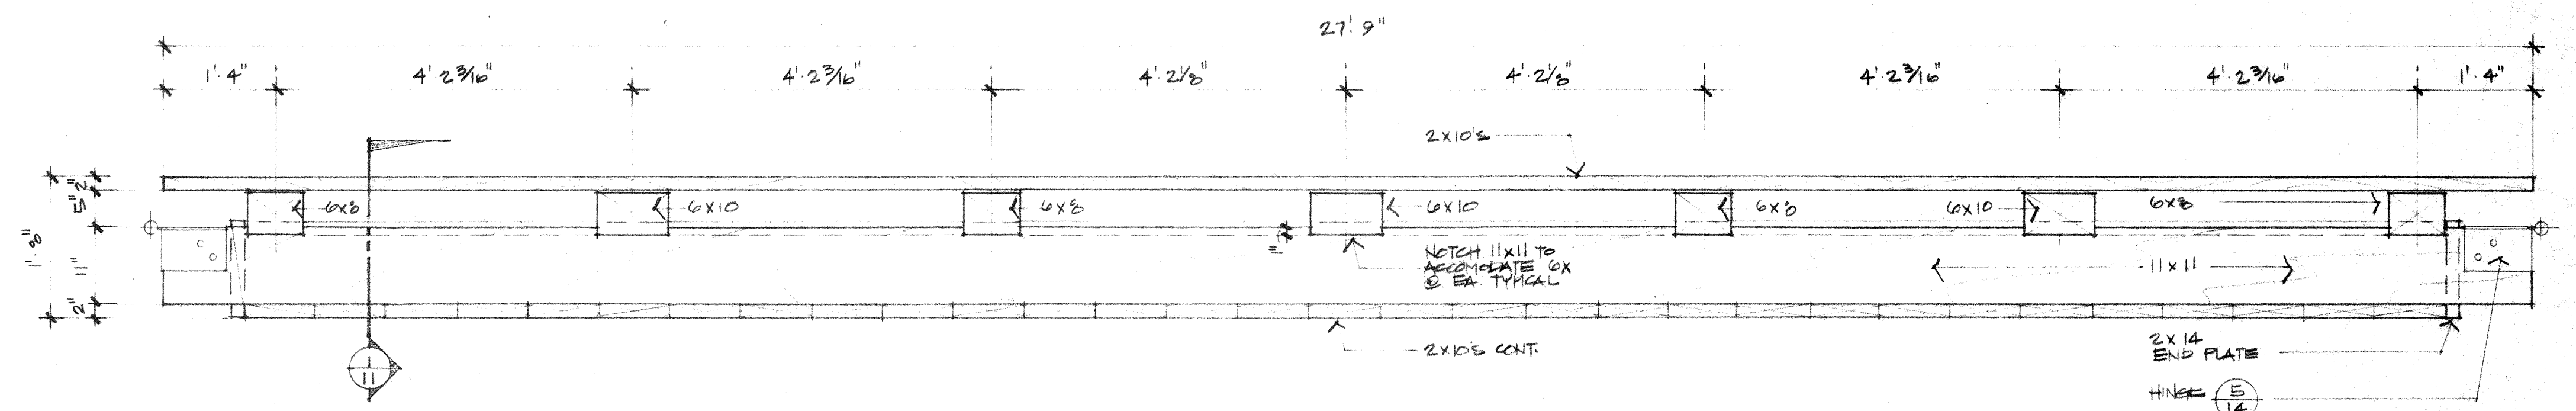


ELEVATION @ FLOAT (G)
NOTE: 2x6 WALKER OMITTED FOR CLARITY


○ - DENOTES FURNISHED BY OTHER

RECORDS DESIGN: 1/25 R-K

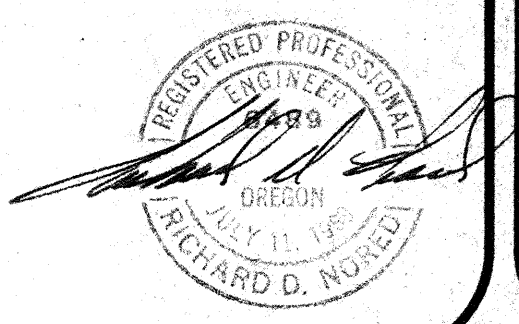


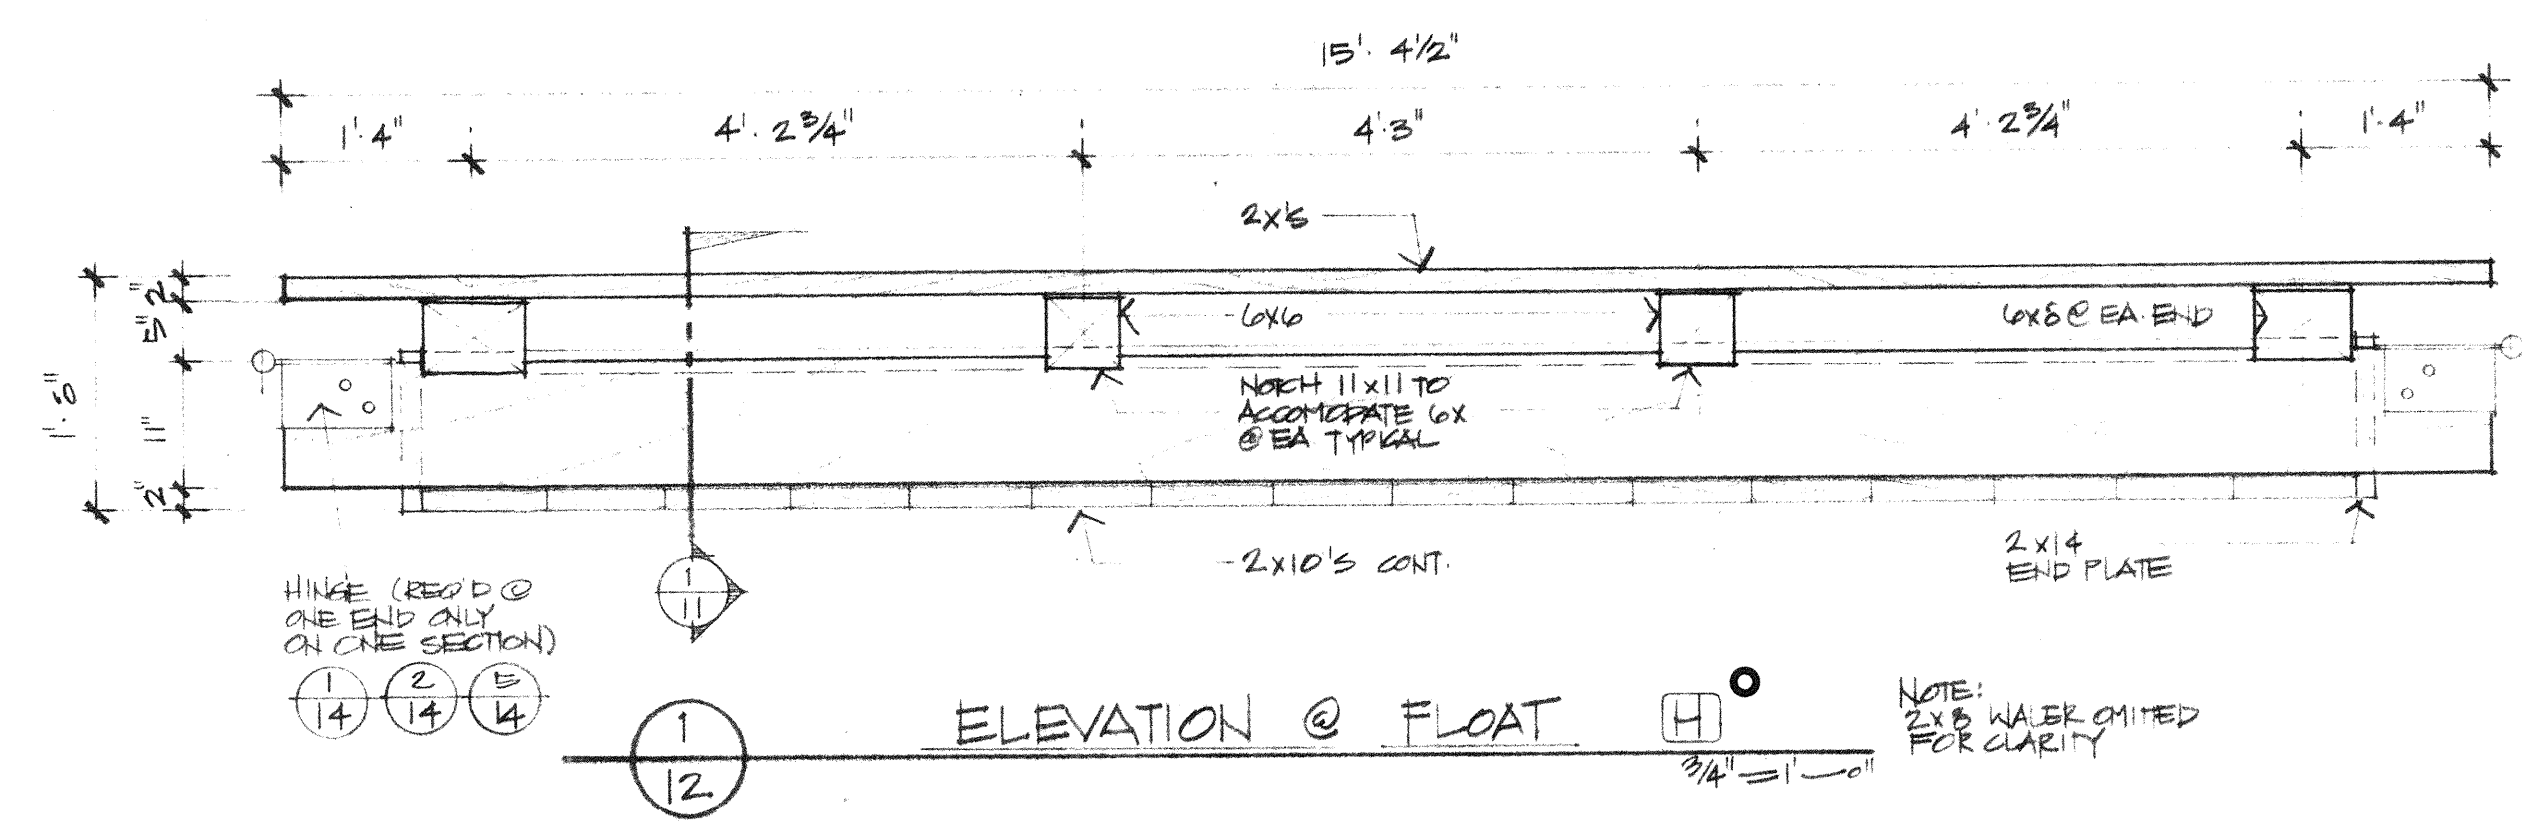


① ELEVATION @ FLOAT H
 3/4" = 1' - 0"

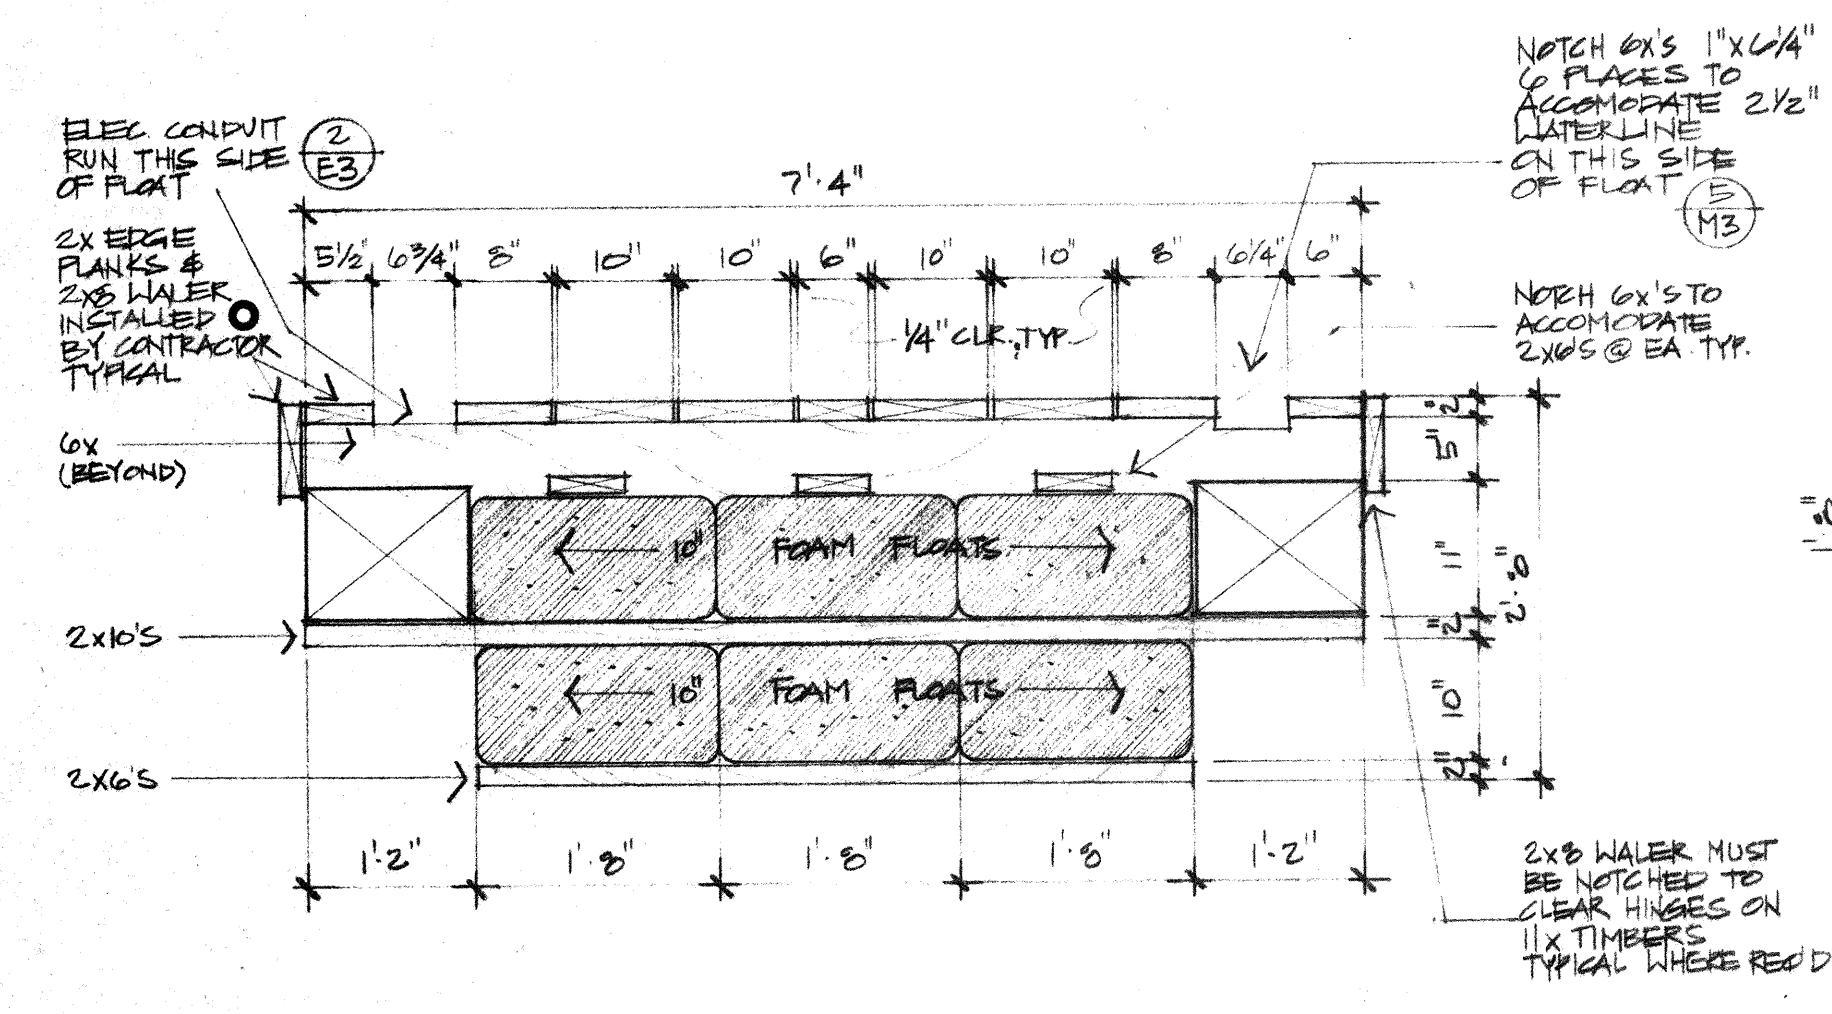


② SECTION @ FLOAT L
 3/4" = 1' - 0"

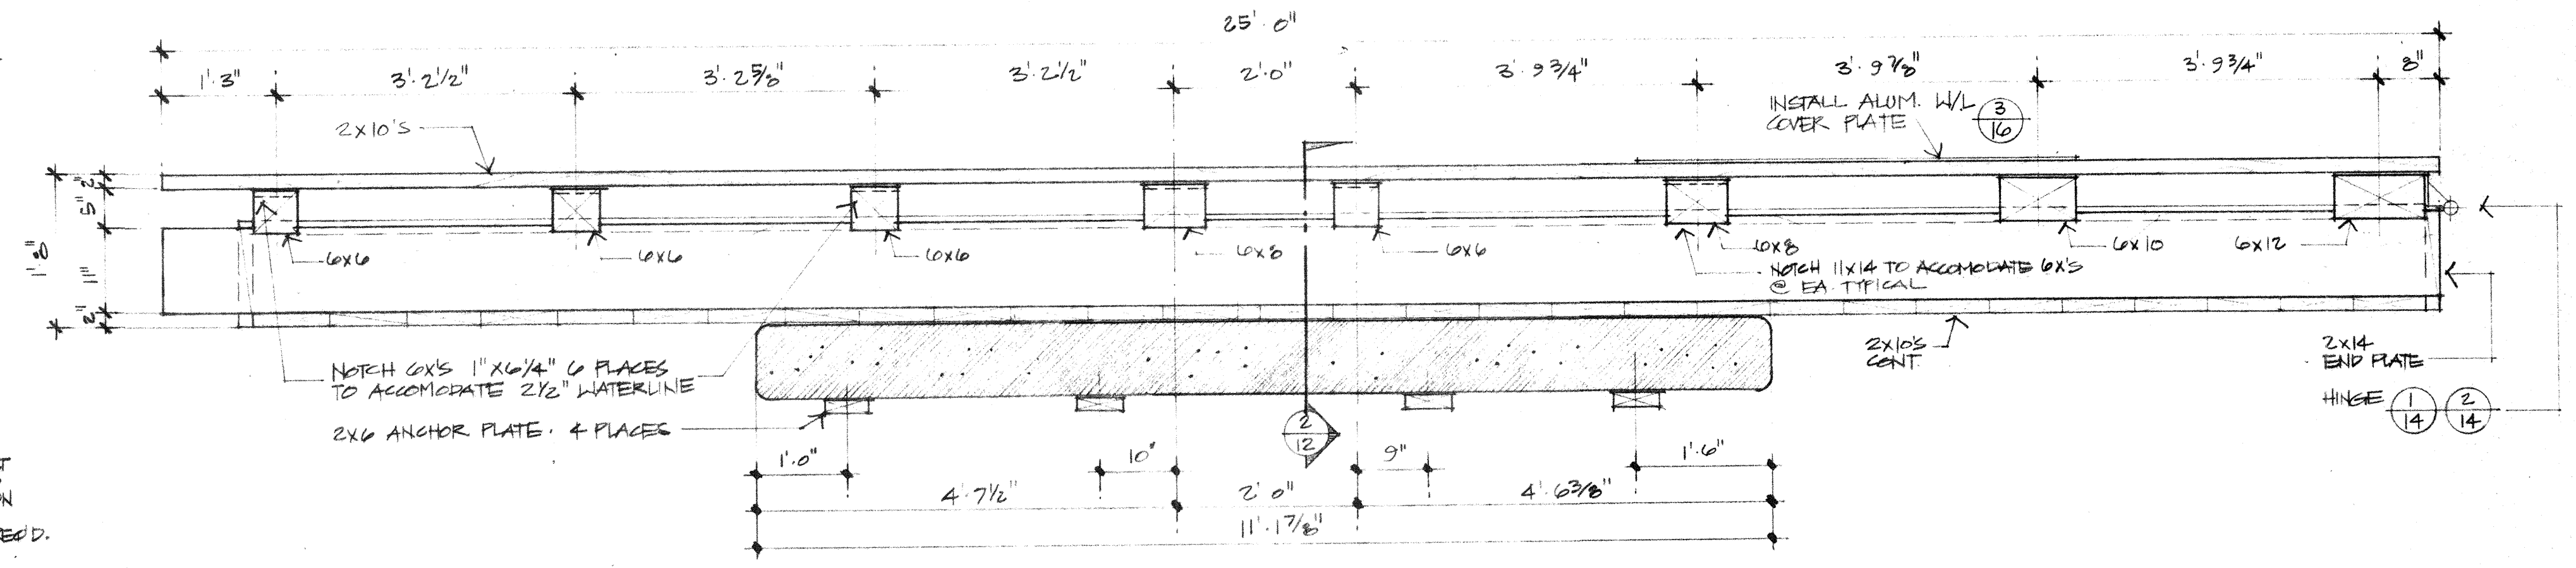


③ ELEVATION @ FLOAT L
 3/4" = 1' - 0"

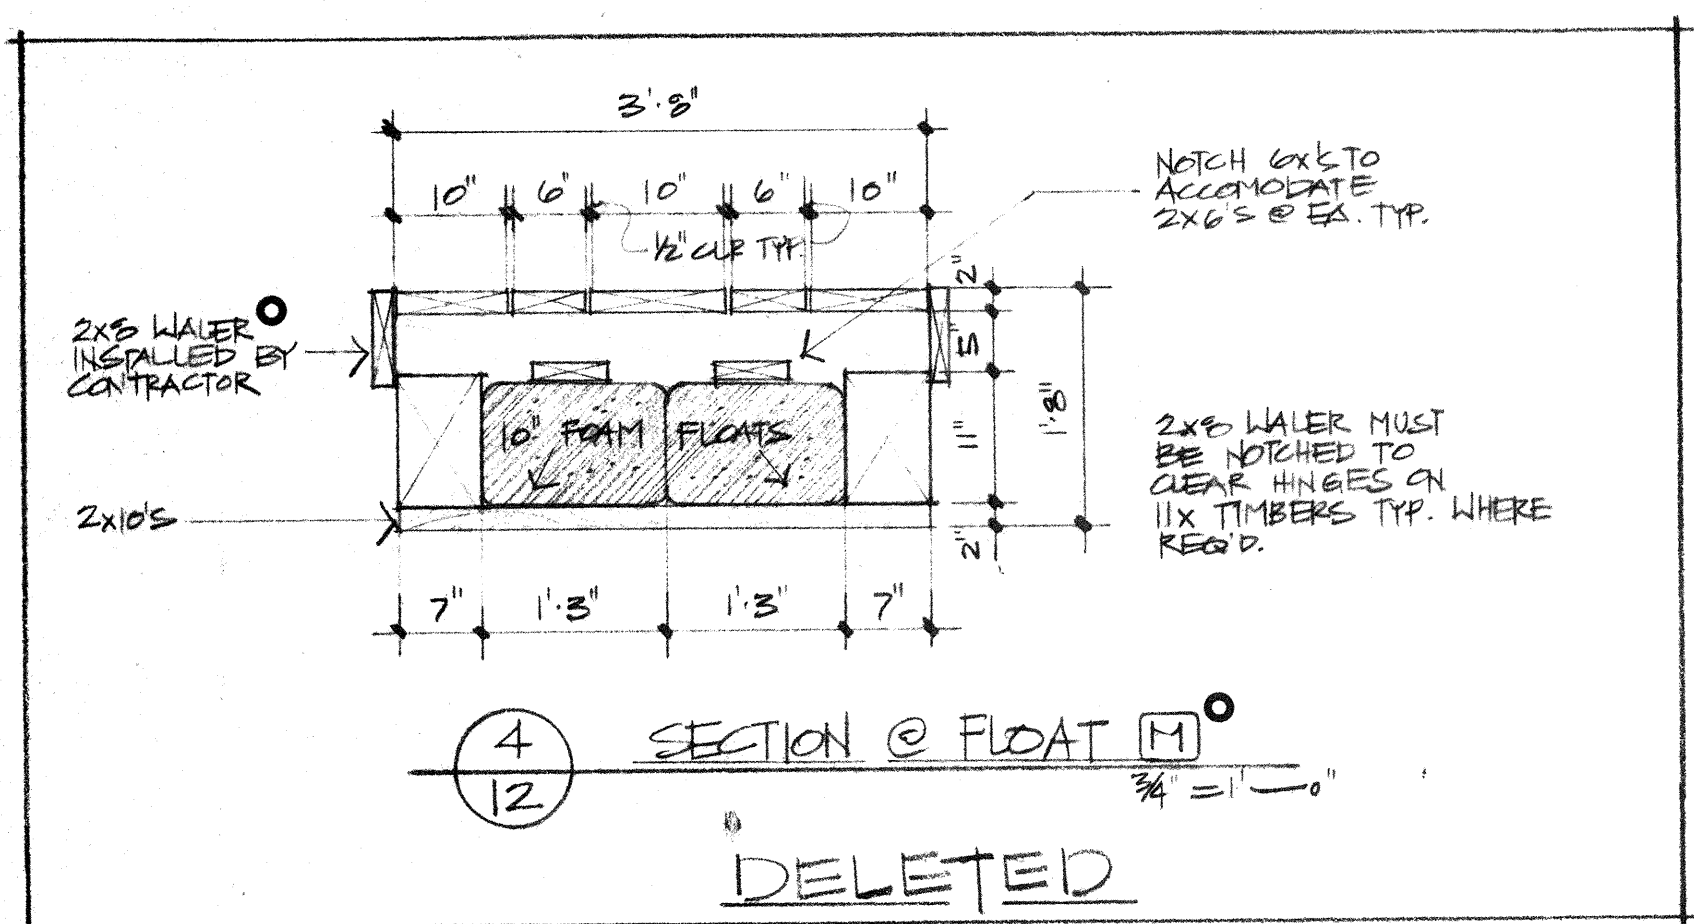


④ SECTION @ FLOAT M
 3/4" = 1' - 0"
 DELETED






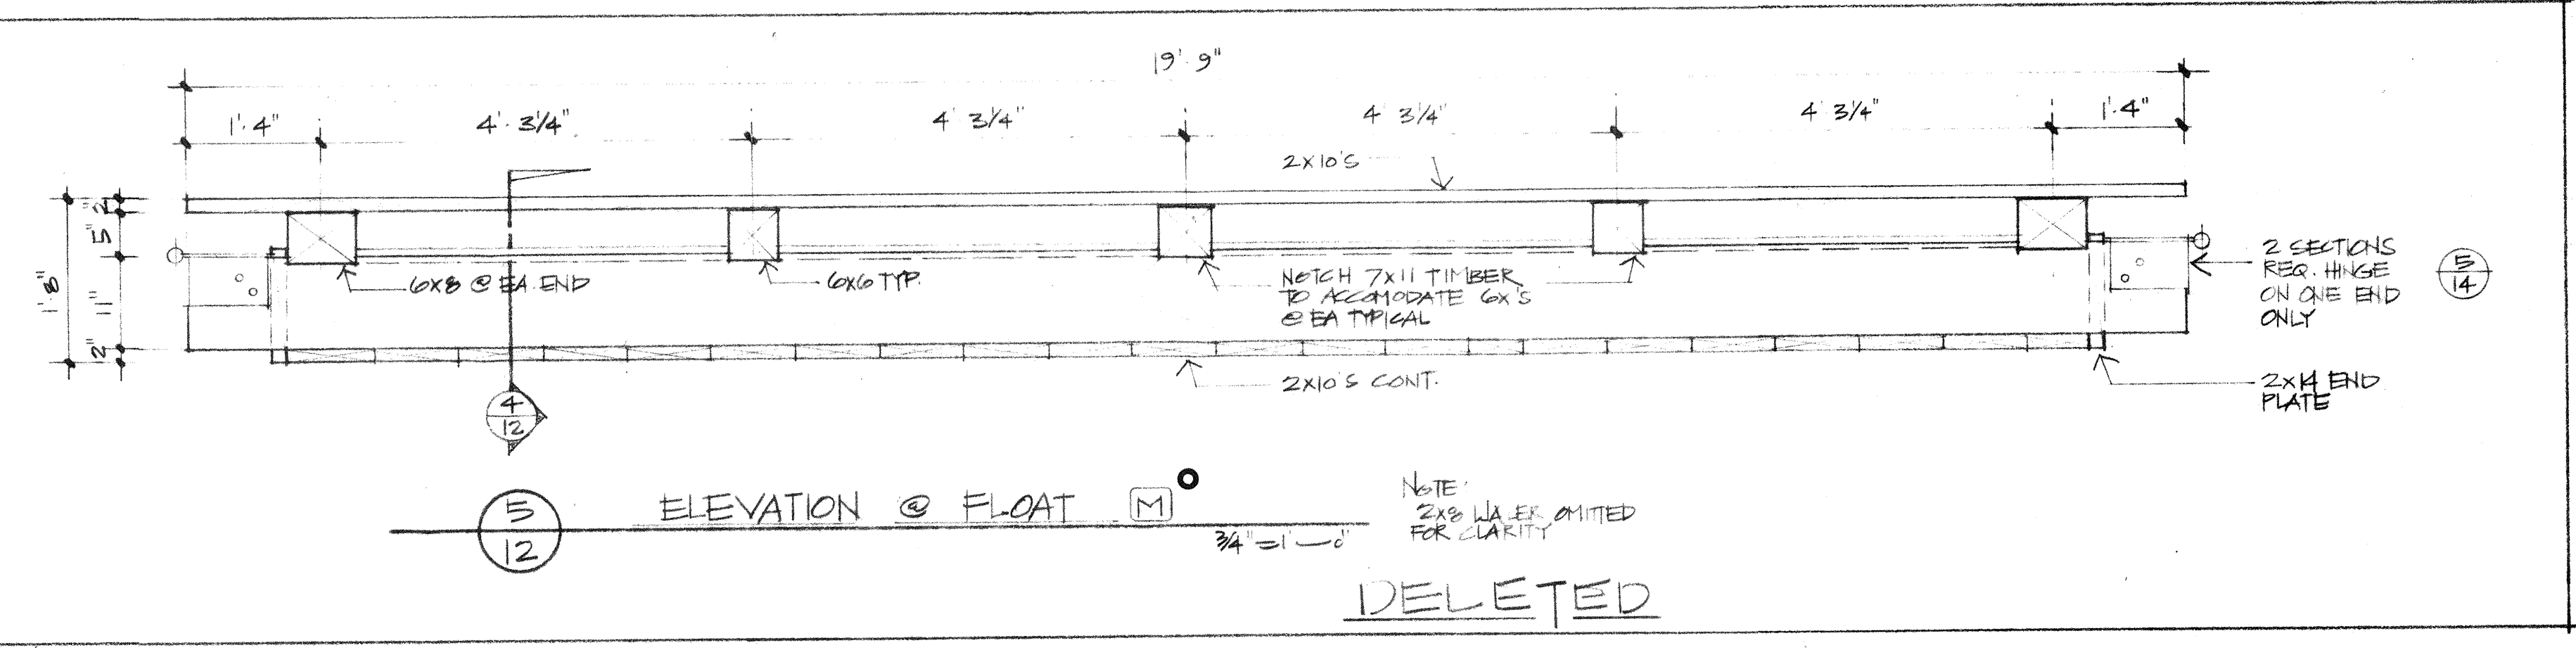


⑤ ELEVATION @ FLOAT M
 3/4" = 1' - 0"
 DELETED

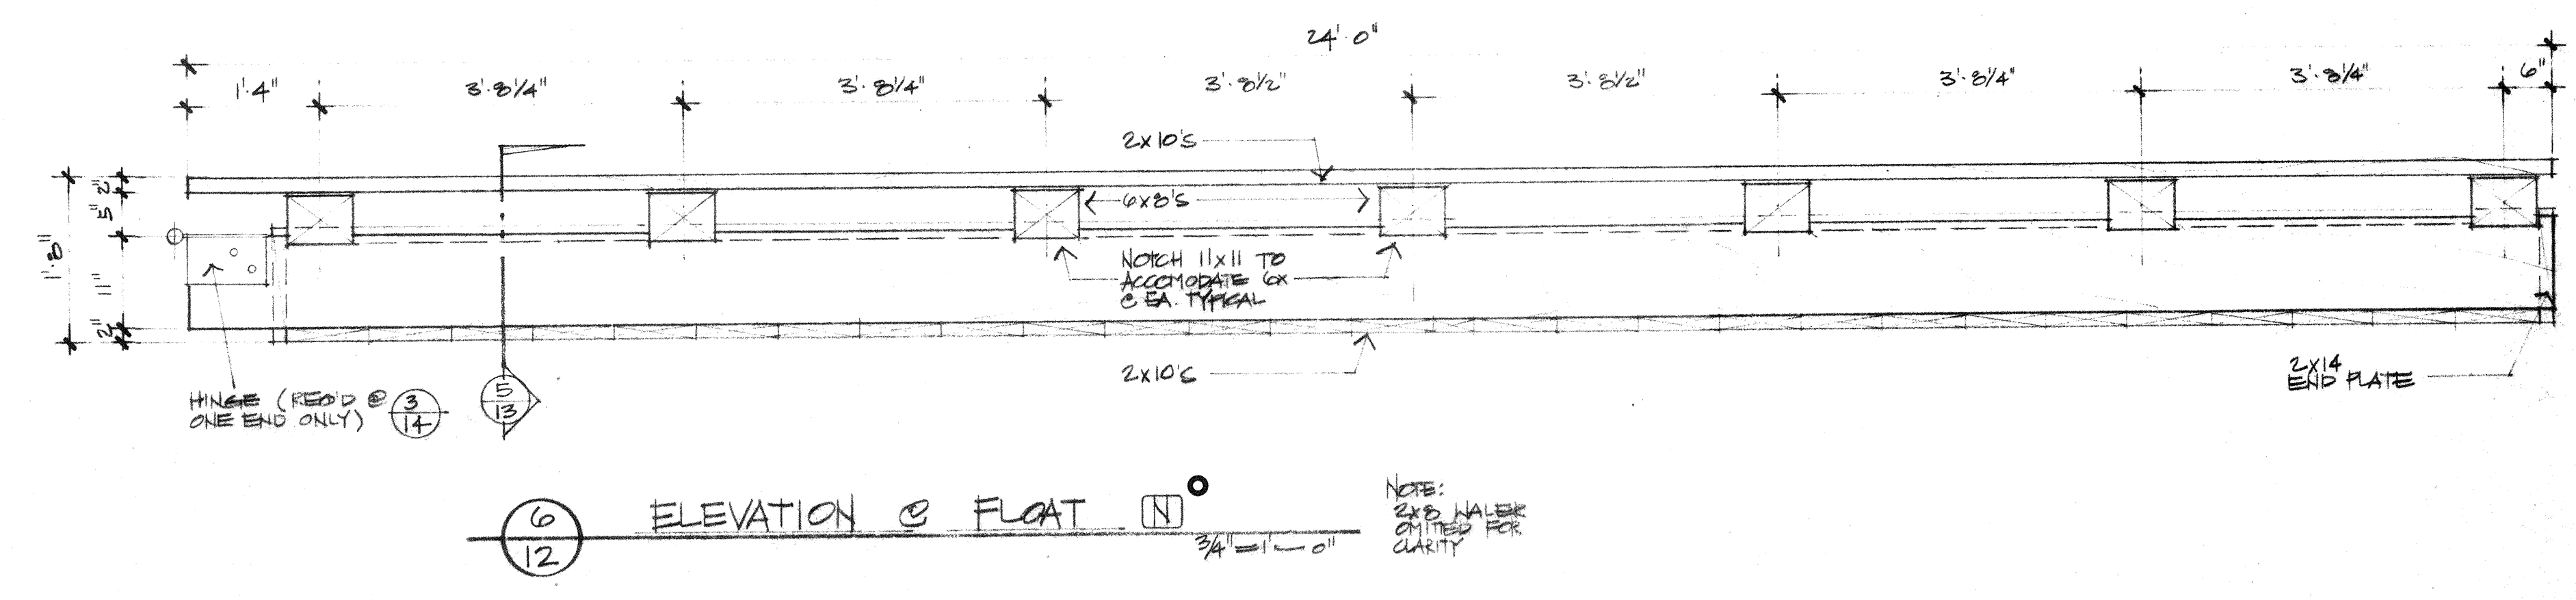

⑥ ELEVATION @ FLOAT N
 3/4" = 1' - 0"

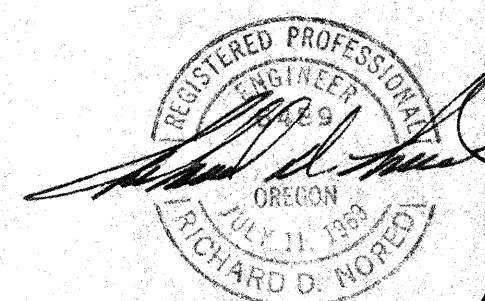

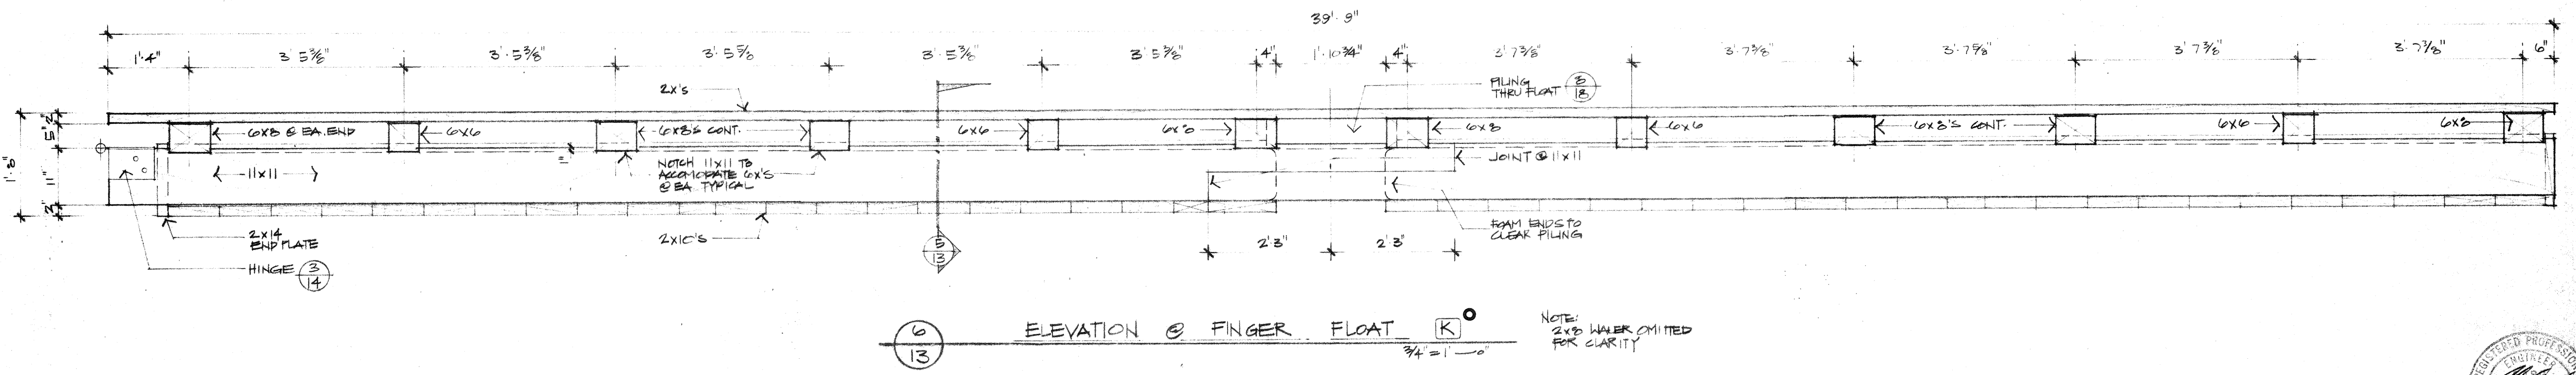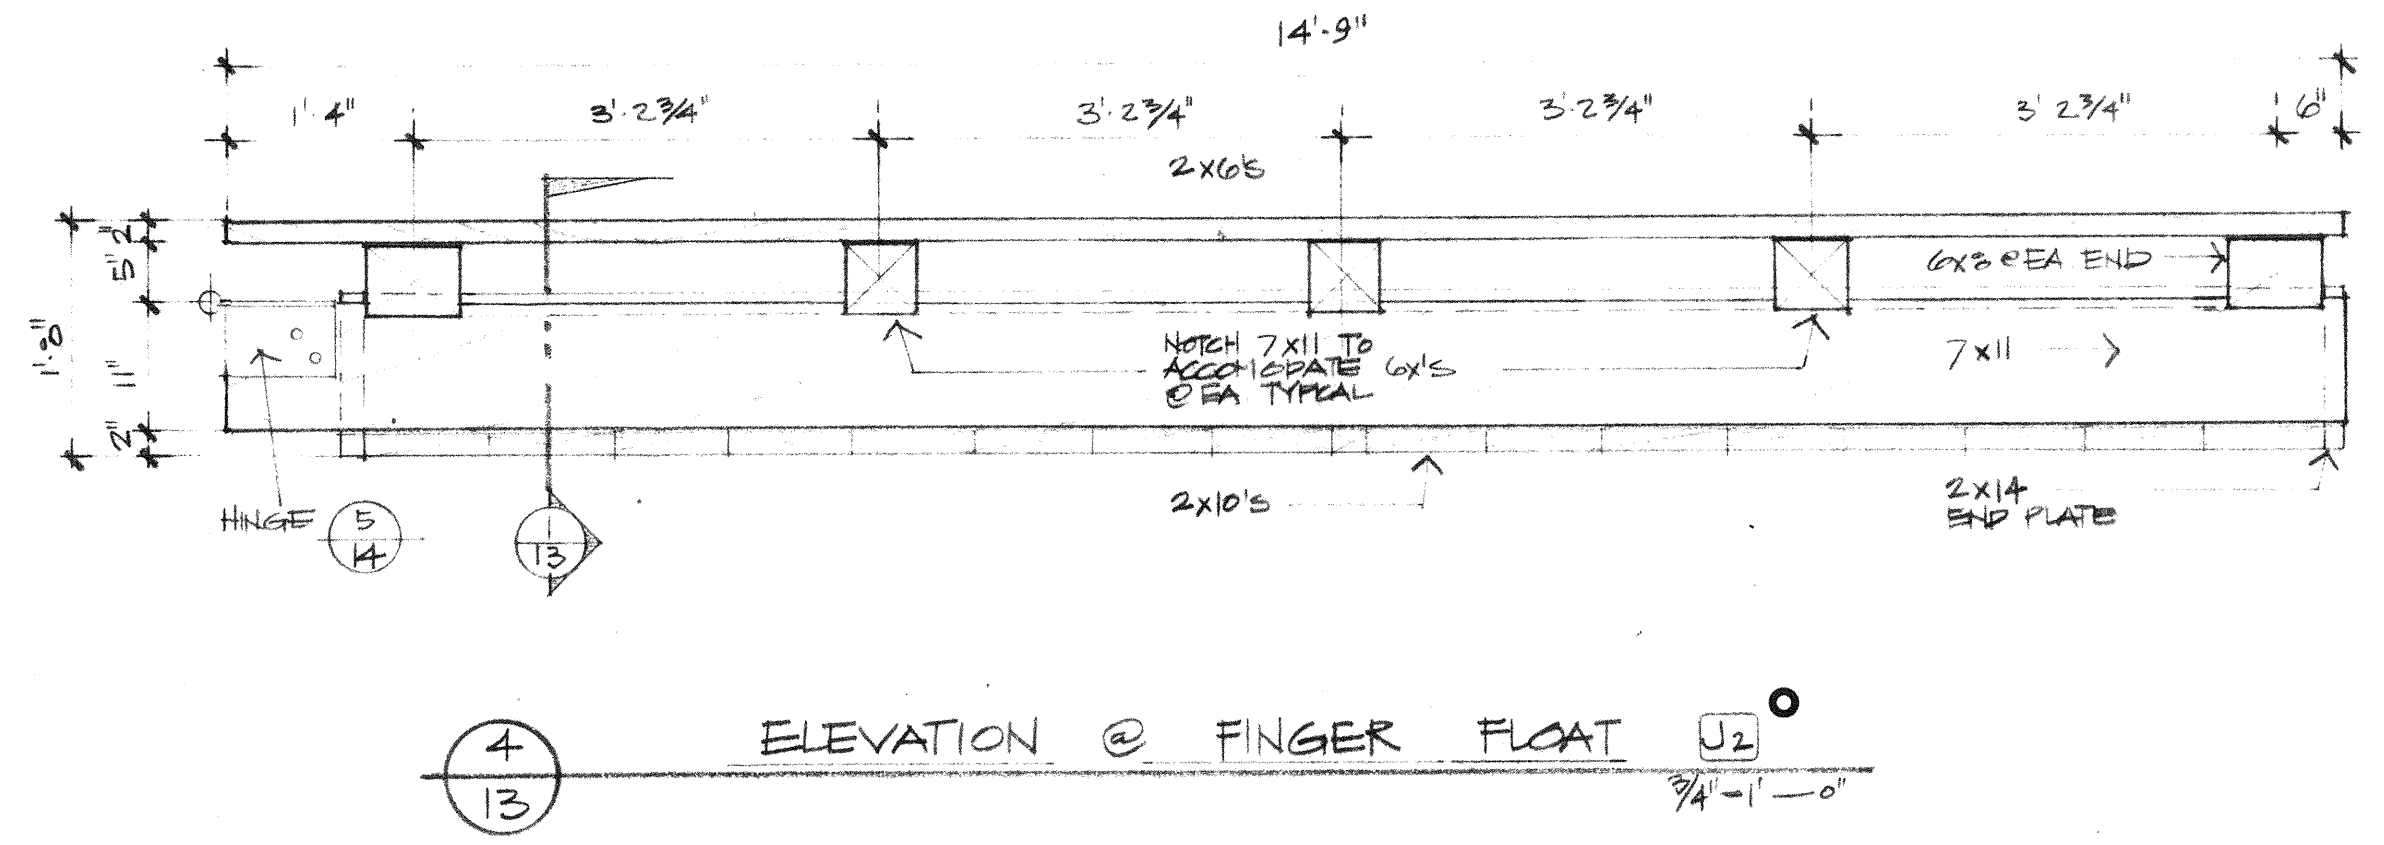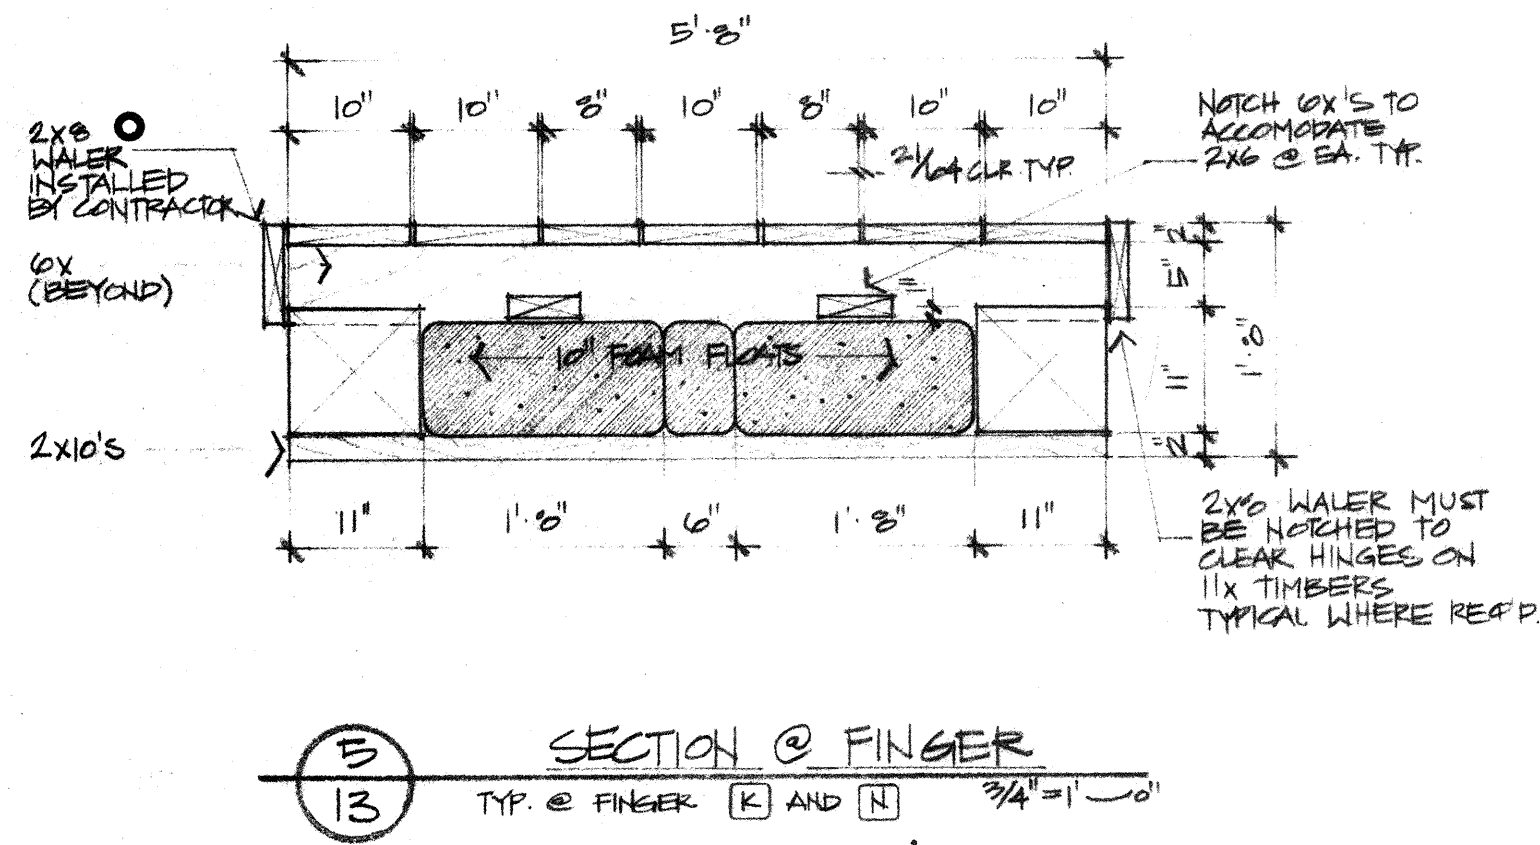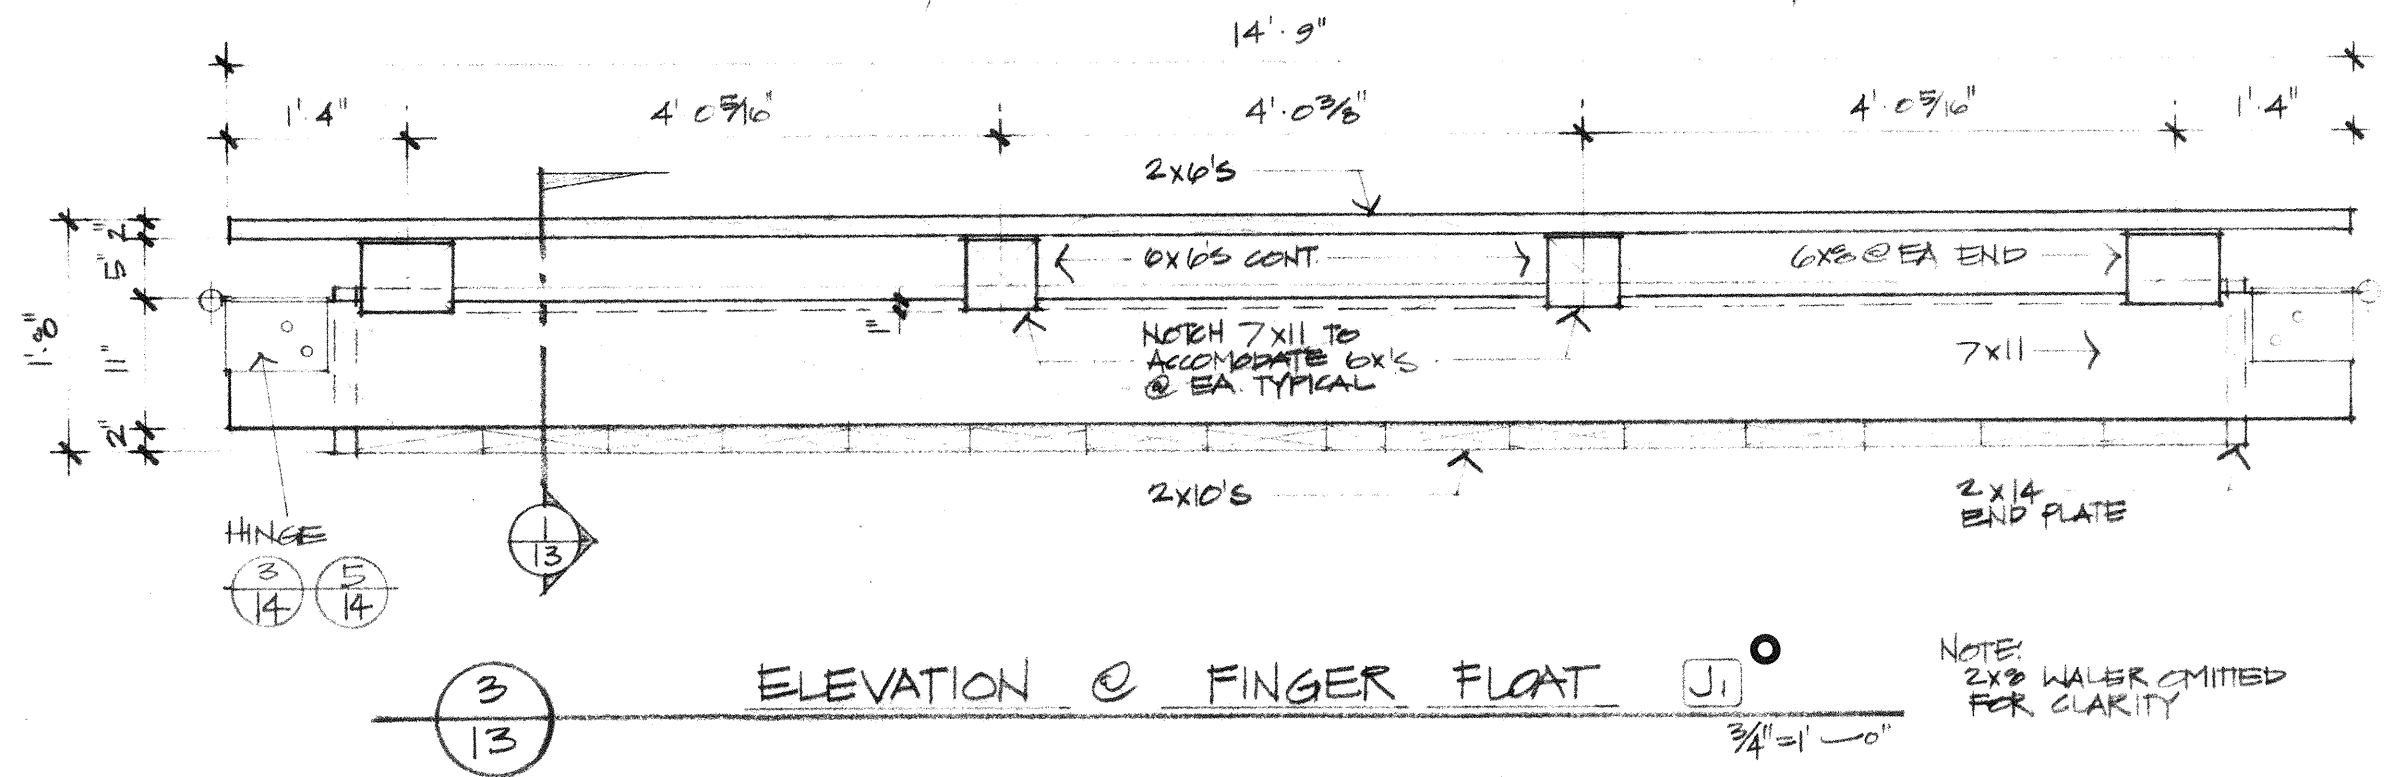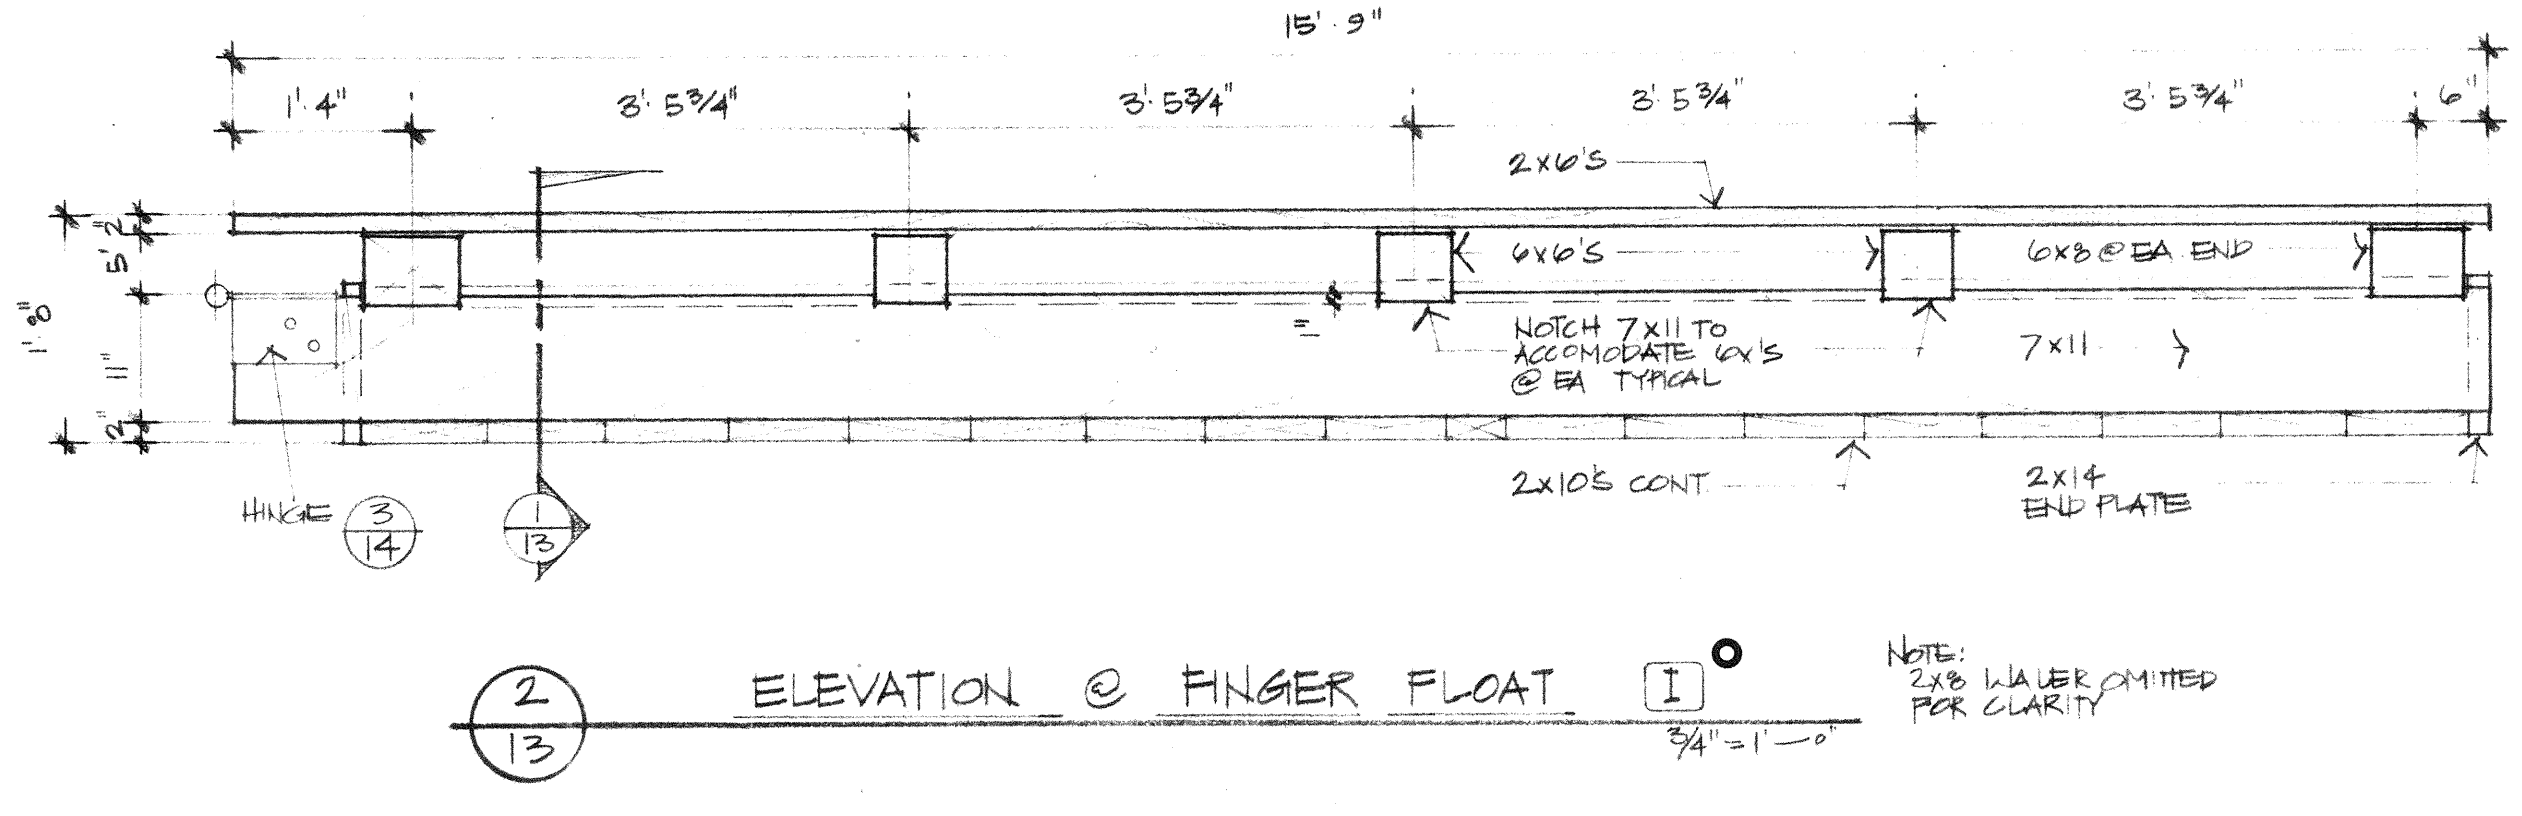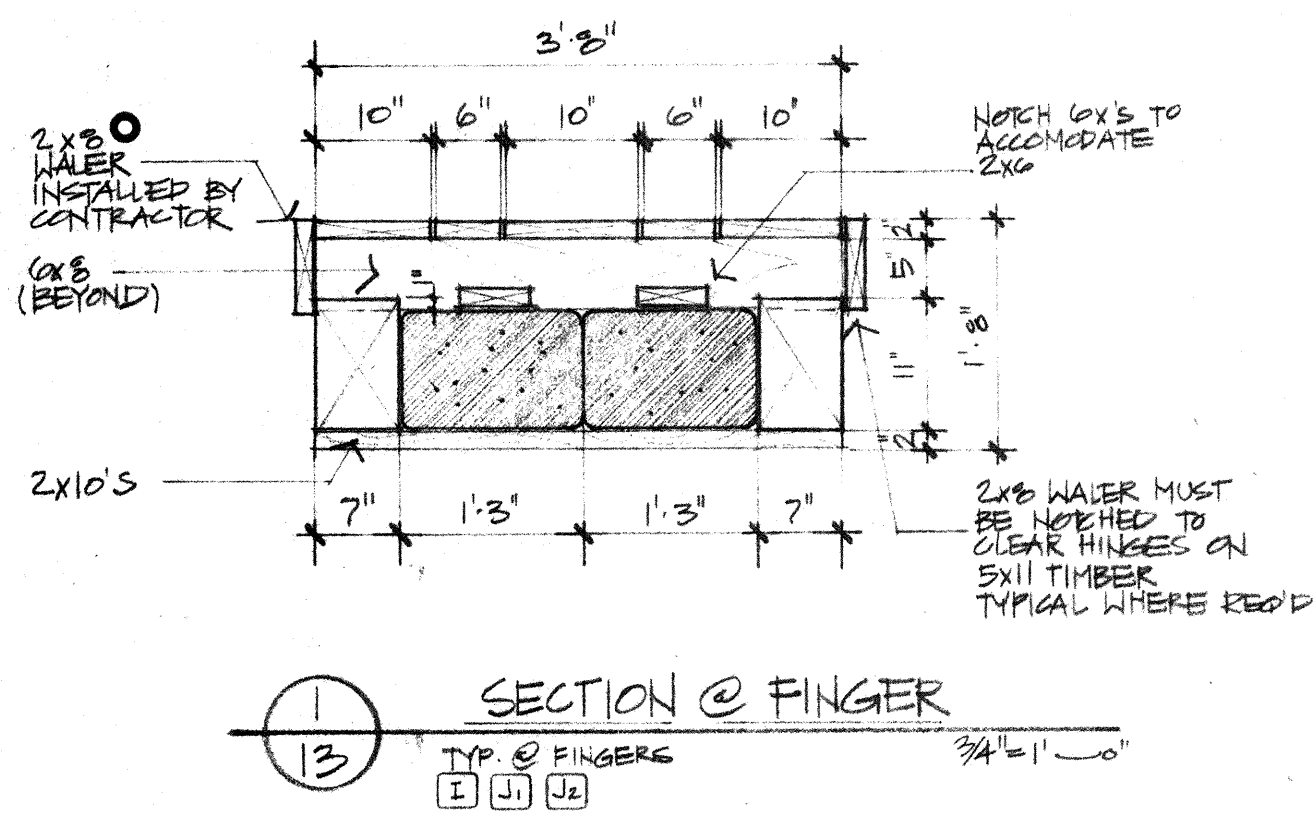

○ - PENCILES FURNISHED BY OWNER

RECORD DRAW. 1/33 R.K.
EDA PROJECT NO. 07-01-02548



HCE INC./ENGINEERS & PLANNERS
Coos Bay, Oregon / 375 Park Avenue 97420 / (503) 269-1166
Portland, Oregon / 19 N. W. 5th Ave. 97209 / (503) 222-1687
Albany, Oregon / 300 Ellsworth St. So. 97321 / (503) 926-0064


HCE
ENGINEERS

SHEET TITLE: FLOAT SECTIONS AND ELEVATIONS


PROJECT: PORT OF Bandon
COQUILLE RIVER BOAT BASIN
COOS COUNTY, OREGON

PROJECT #: 2271
DATE: JULY, 1982


SHEET NO. 13

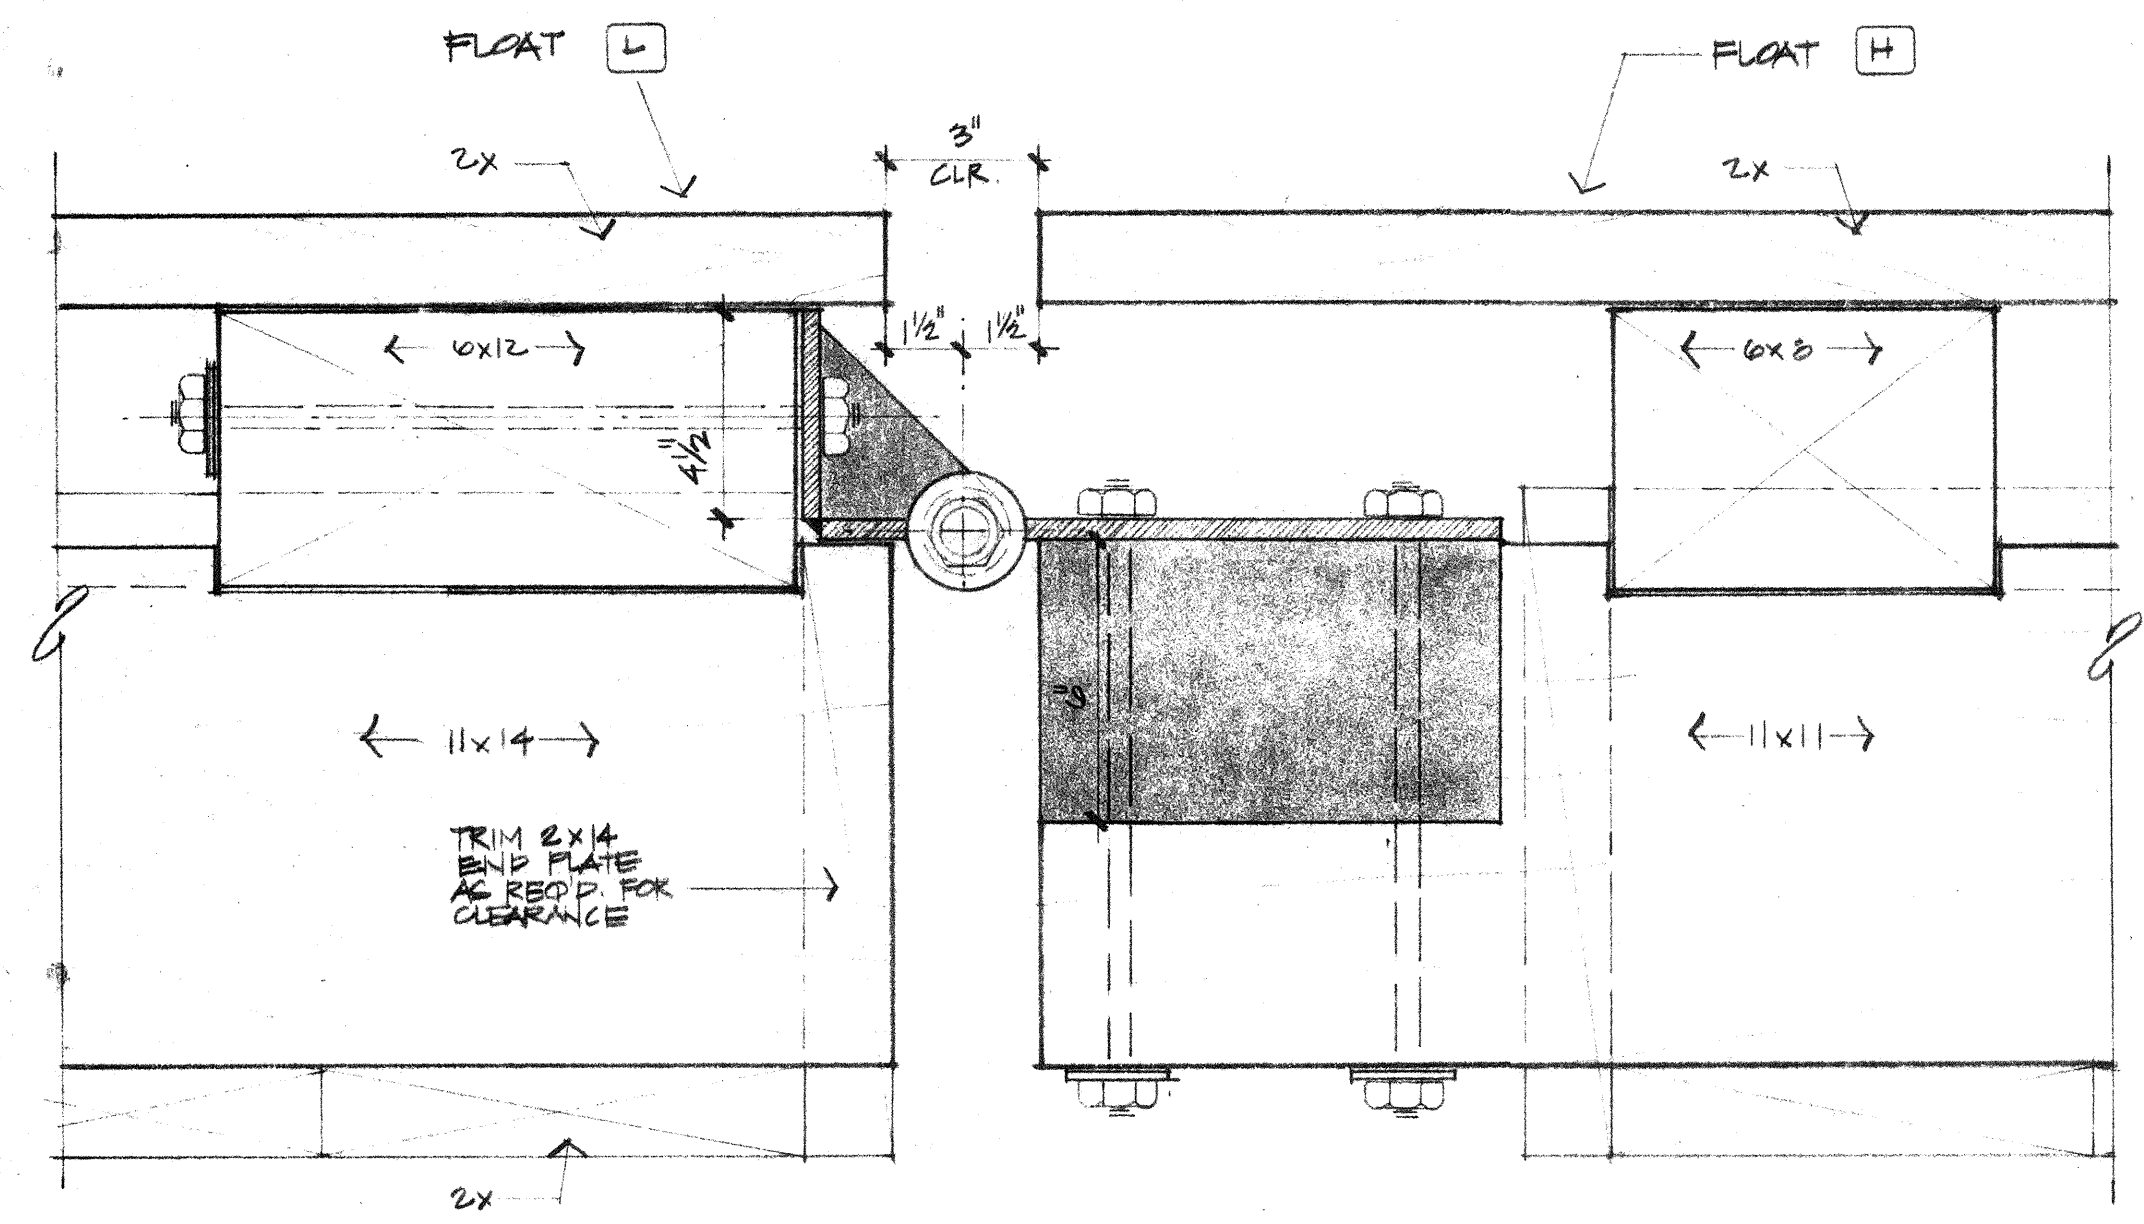


1 ELEVATION @ HINGE 1
ALTERNATE A SKETCH
3'-1'-0"

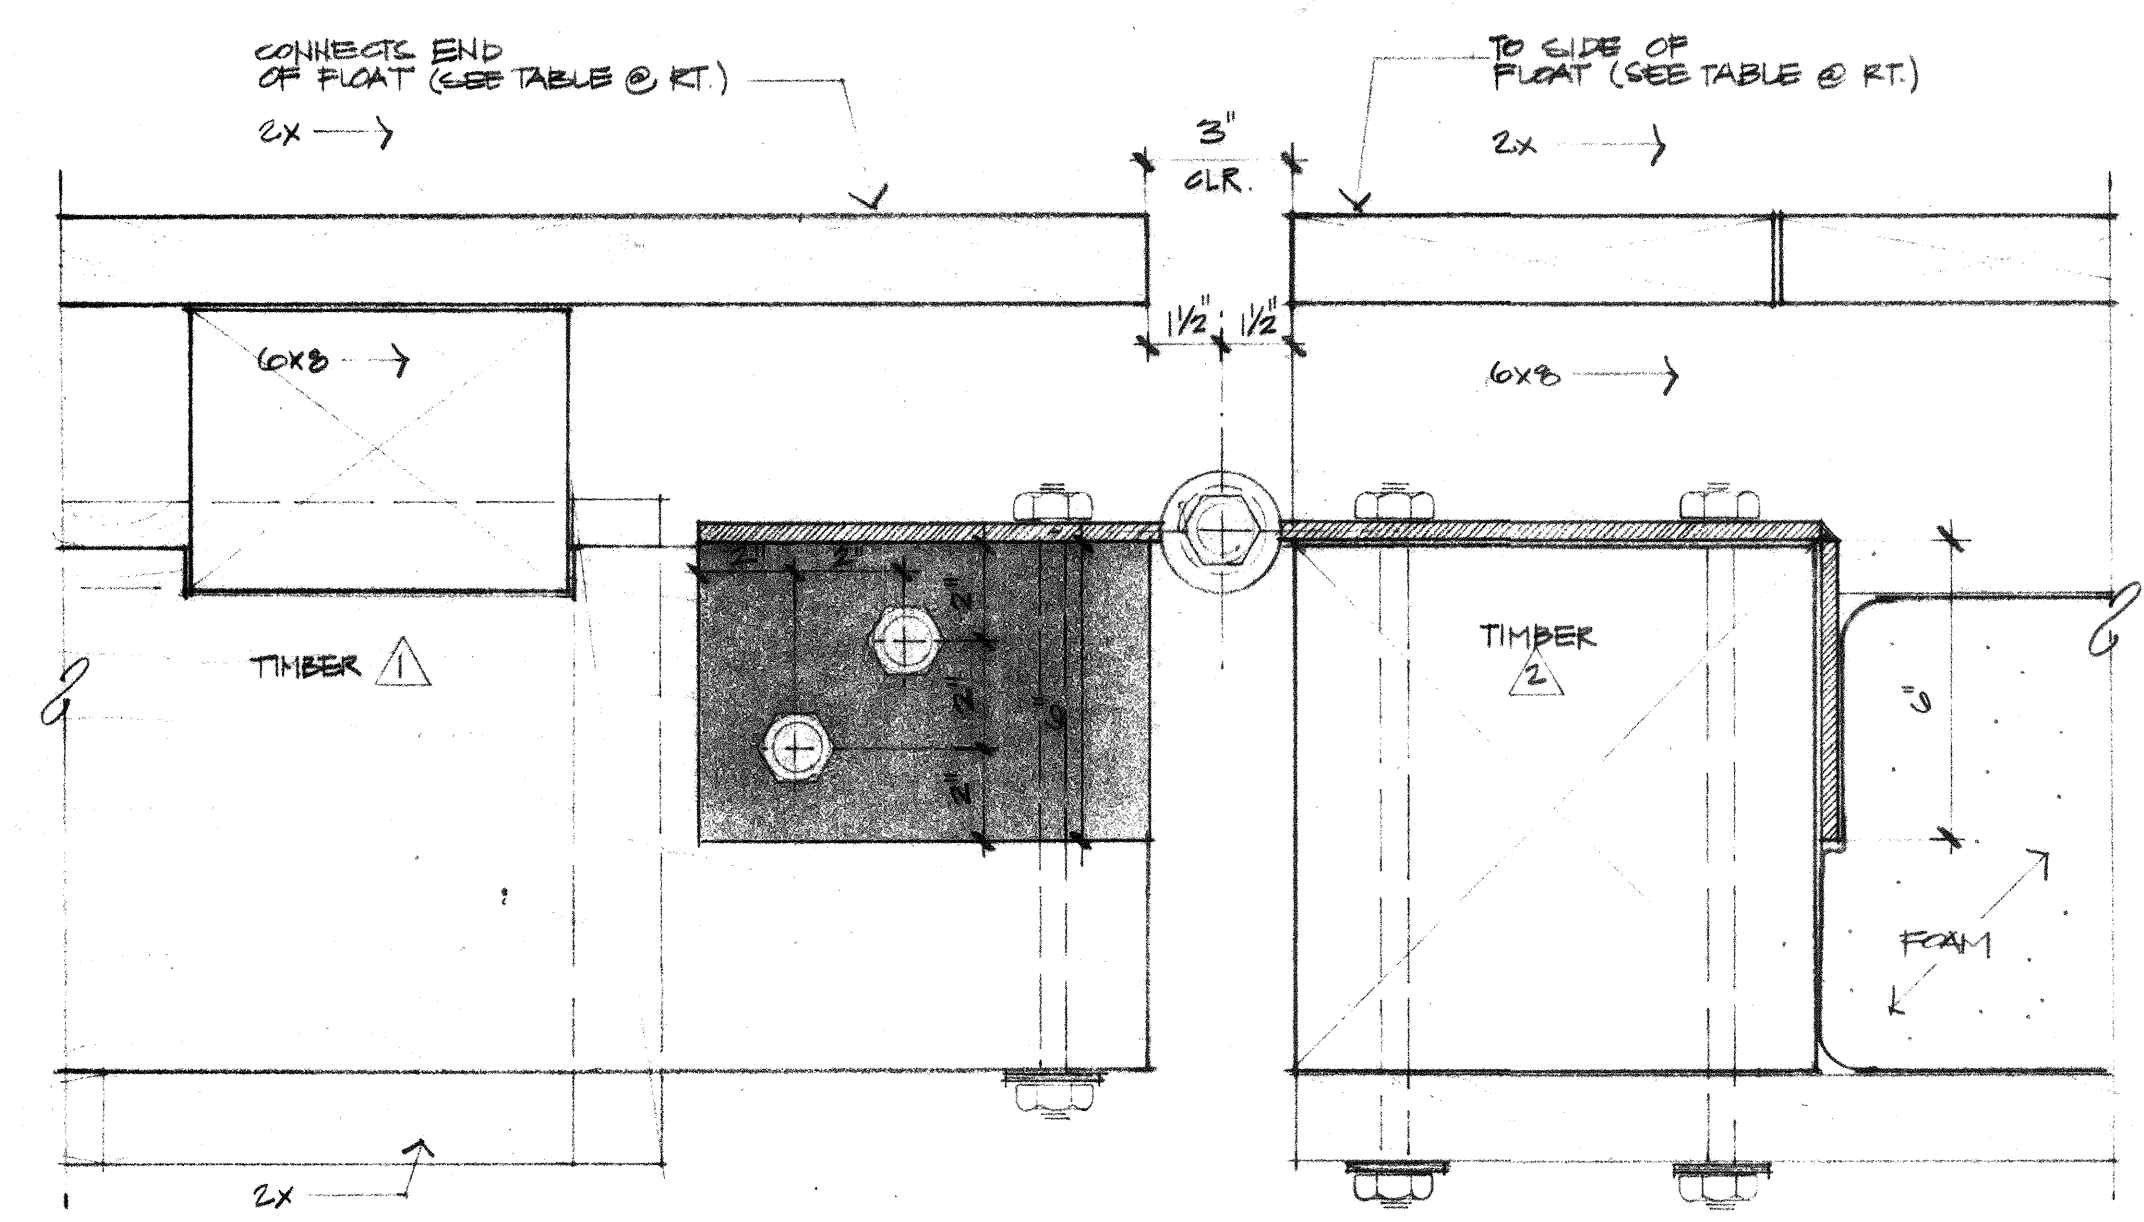

3 ELEVATION @ HINGE 3 4 5
3'-1'-0"

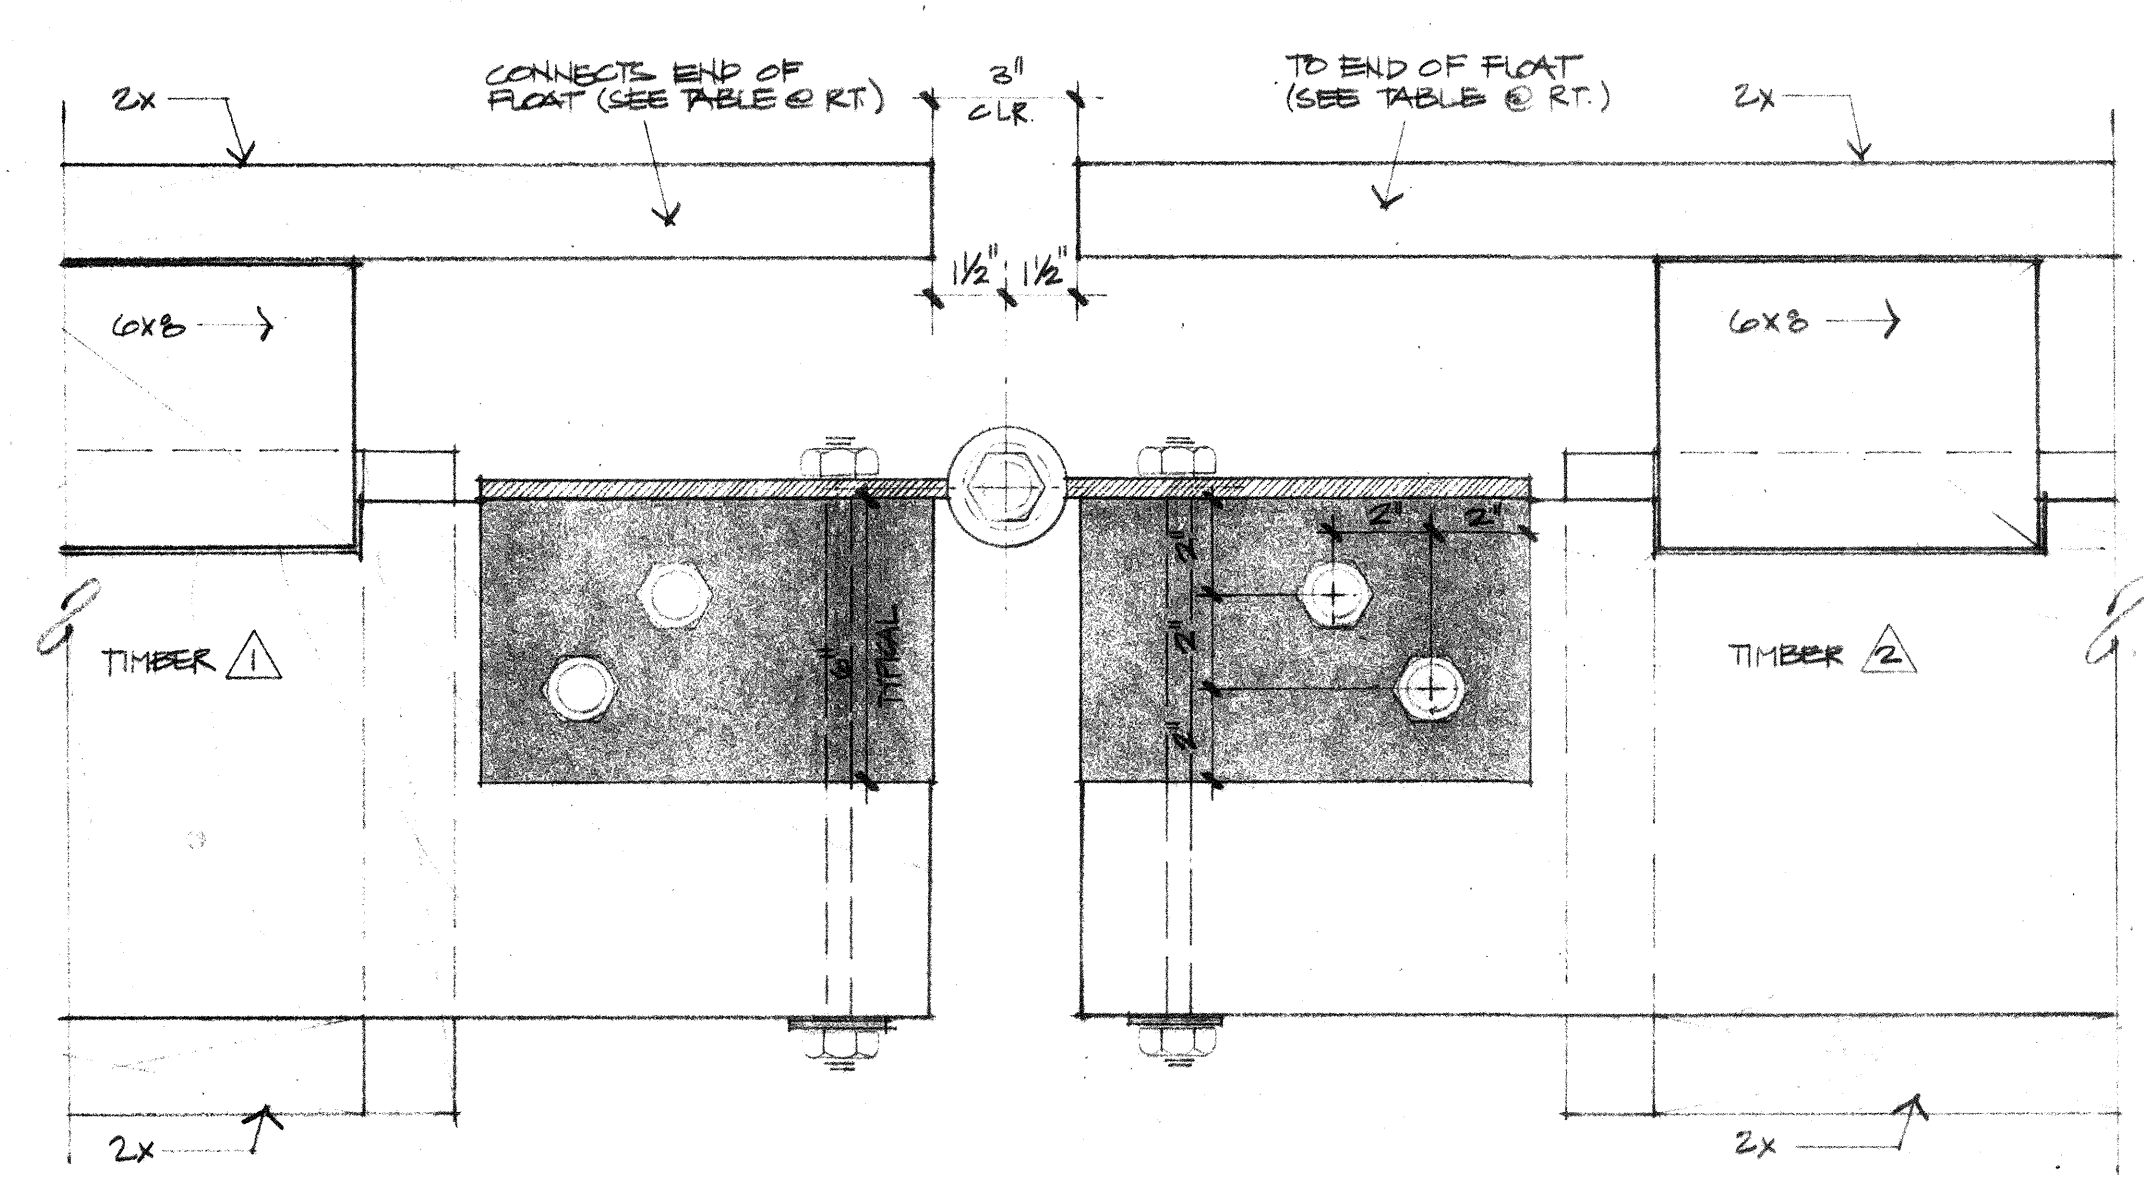

5 ELEVATION @ HINGE 6 7 8
3'-1'-0"

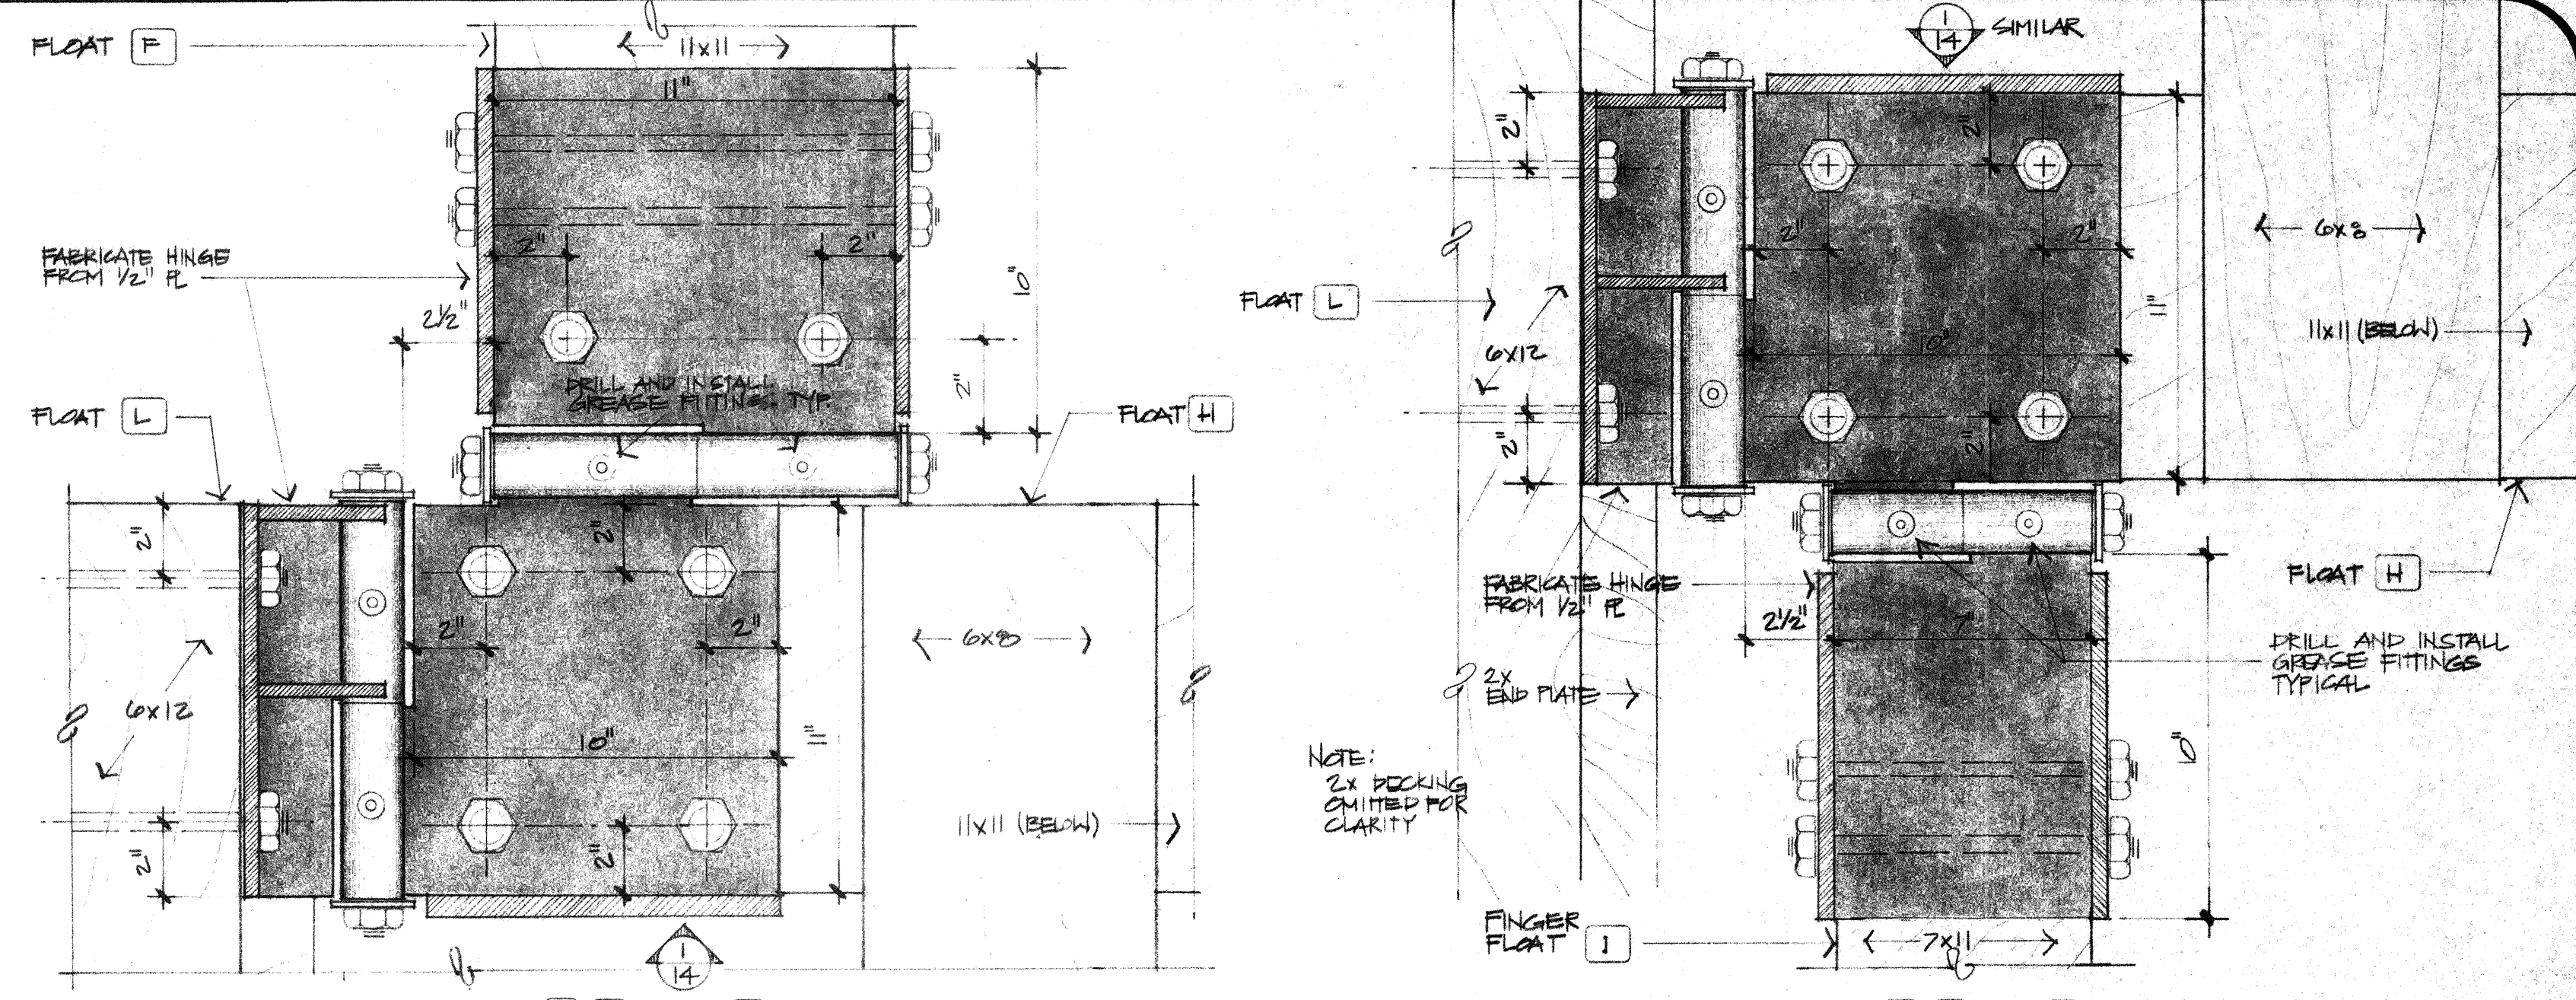

ALTERNATE A. CONNECTS FLOATS L H AND F
(1 REQ'D.)
2 PLAN @ HINGE 1
3'-1'-0"

ALTERNATE B. CONNECTS FLOATS L H AND I
(1 REQ'D.)


HINGE NO.	2	3	4	5
CONNECTS END OF FLOAT TO SIDE OF FLOAT	(I) (J)	(K) (L)	(M) (N)	(O) (P)
TIMBER	7x11	11x14	11x11	11x14
TIMBER	11x11	11x11	11x14	11x14
DIMEN.	11 1/2"	11 1/2"	14 1/2"	14 1/2"
DIMEN.	7"	14"	11"	11"

FLOAT TABLE


NOTES:
1) ALL HINGES USE 1" DIA. STEEL FOR HINGE PIVOT BOLT LENGTHS VARY. ALL THRU BOLTS FOR ANCHORING HINGE TO FLOAT ARE FROM 3/8" DIA STEEL WITH A 2" DIA WASHER TYPICAL. 2) NOTE ARE REQ'D WITH EACH PIVOT BOLT AND THRU BOLT.
2) ALL HINGES TO BE FABRICATED BY OWNER.
3) ALL FLOATS (A) THRU (N) TO BE CONSTRUCTED BY OWNER AND INSTALLED BY CONTRACTOR.

HINGE NO.	6	7	8
CONNECTS END OF FLOAT TO END OF FLOAT	(D) (E) (F)	(G) (H) (I)	(J) (K) (L)
TIMBER	11x11	7x11	11x14
TIMBER	11x11	7x11	11x14
DIMEN.	11"	7"	14"

FLOAT TABLE

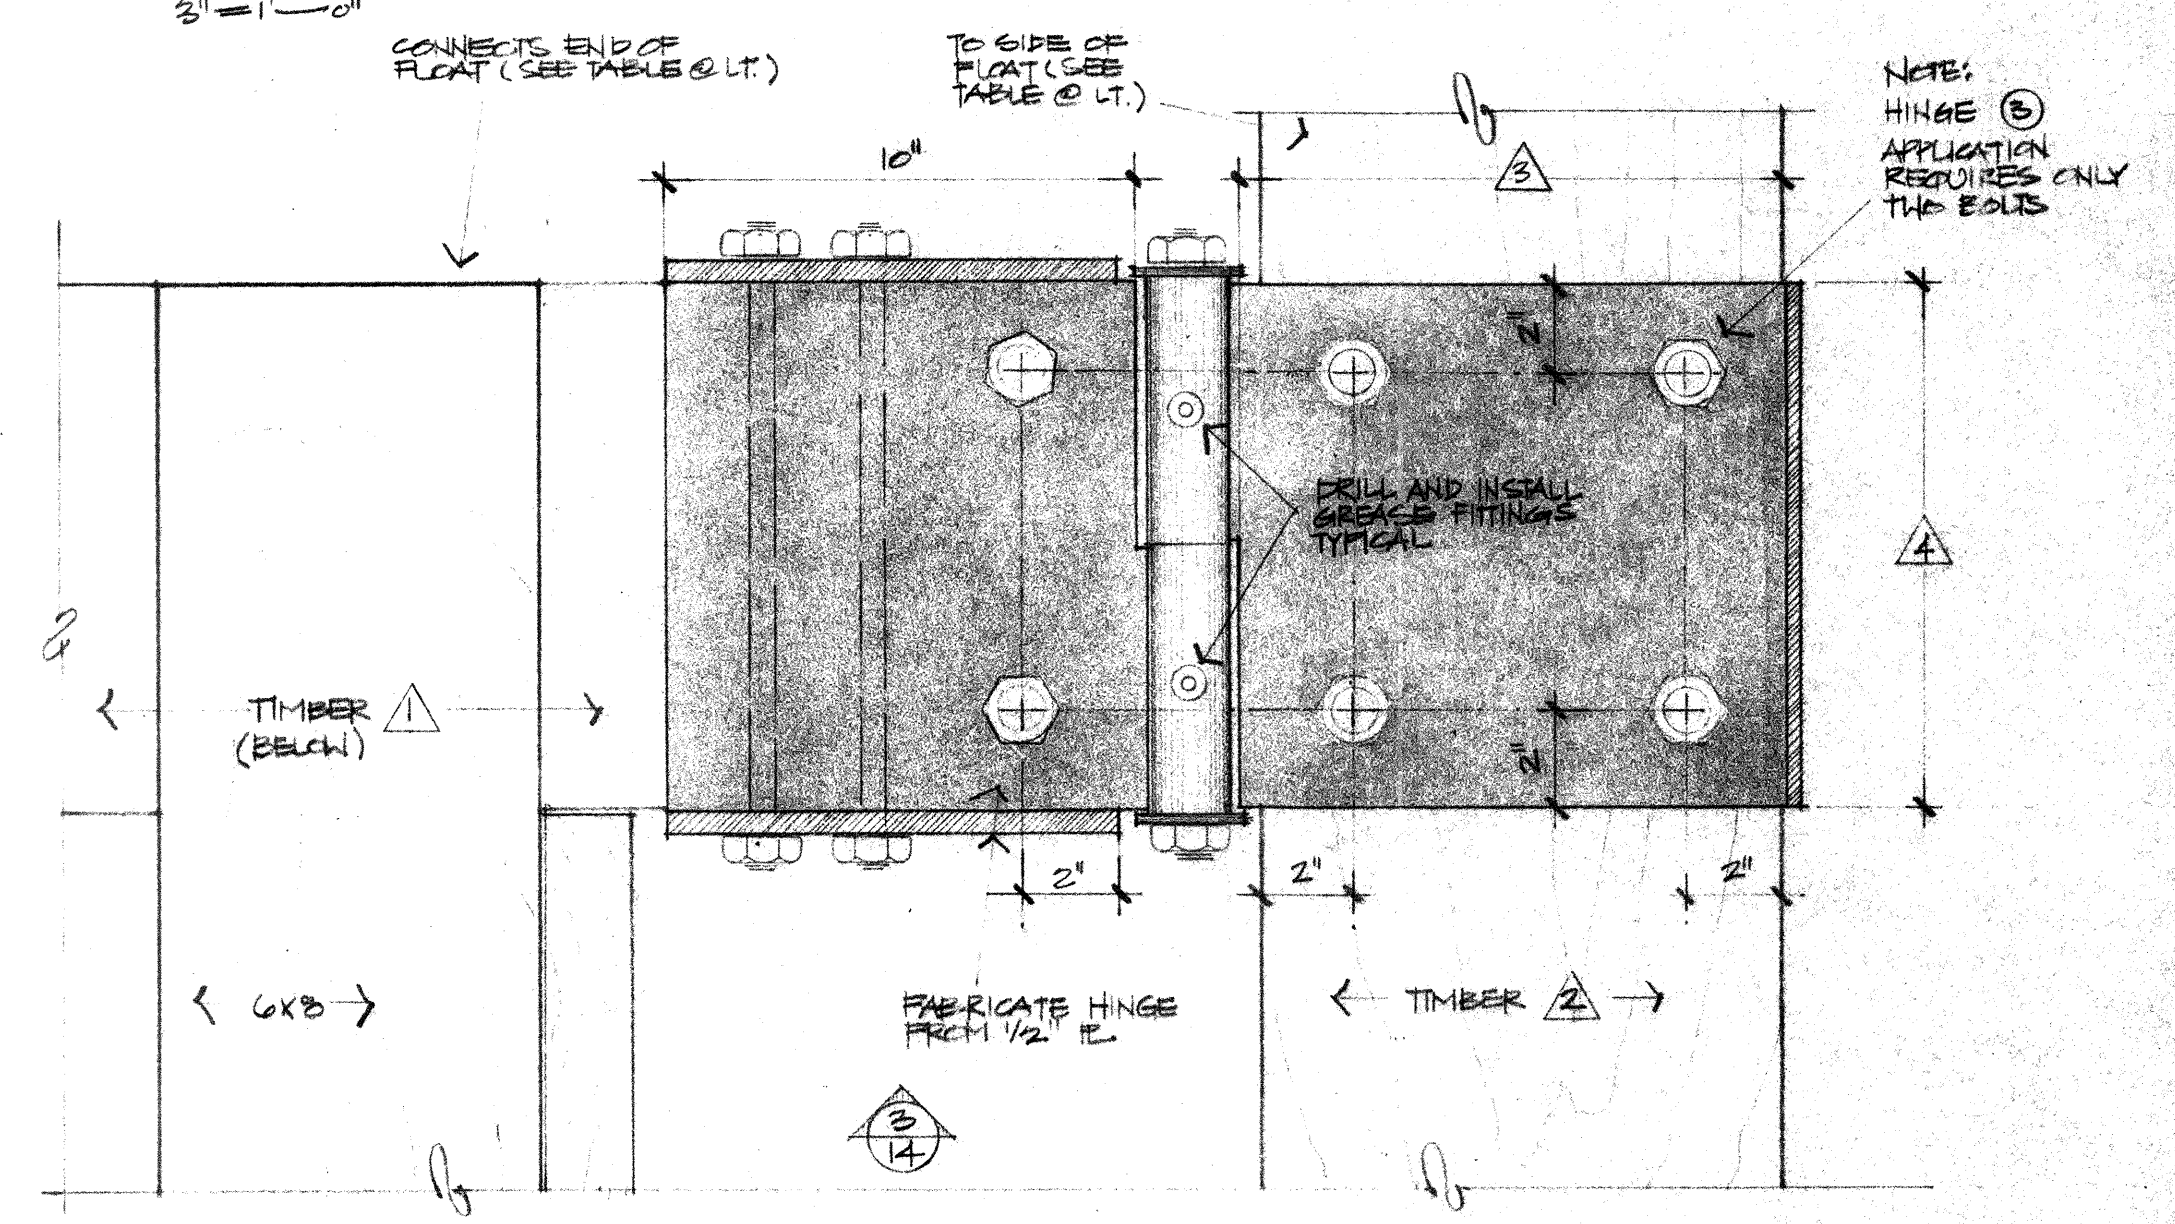


4 PLAN @ HINGE 3 4 5
3'-1'-0"

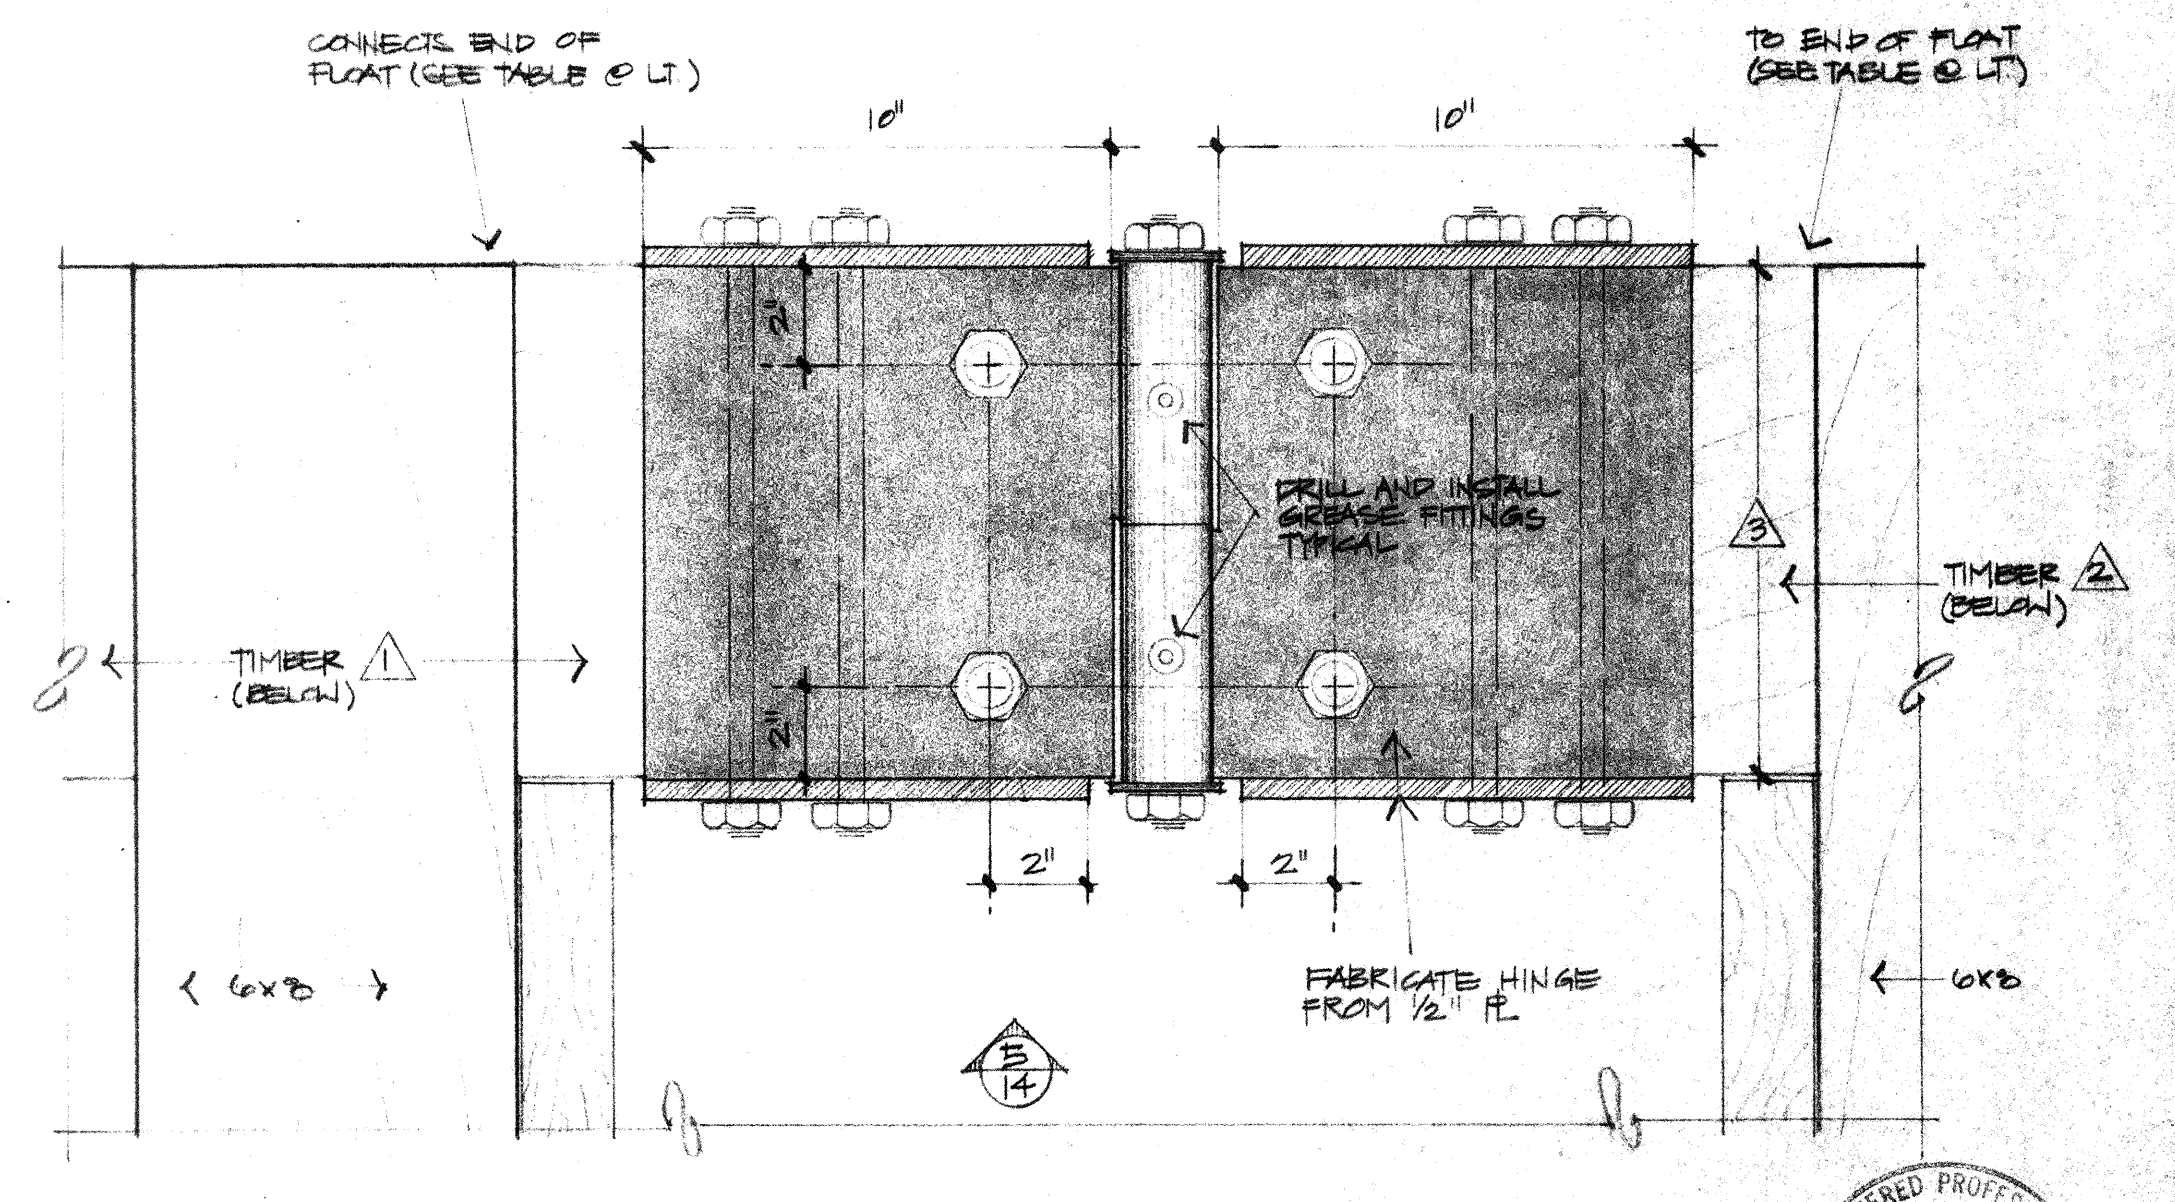


6 PLAN @ HINGE 6 7 8
3'-1'-0"

NOTES: HINGE 6 SHOWN. REFER TO TABLE @ LEFT FOR ALTERNATES. 2x PECK OMITTED FOR CLARITY. RECORD DRAWING 1/25/22.


0 - PARTS FURNISHED BY OWNER

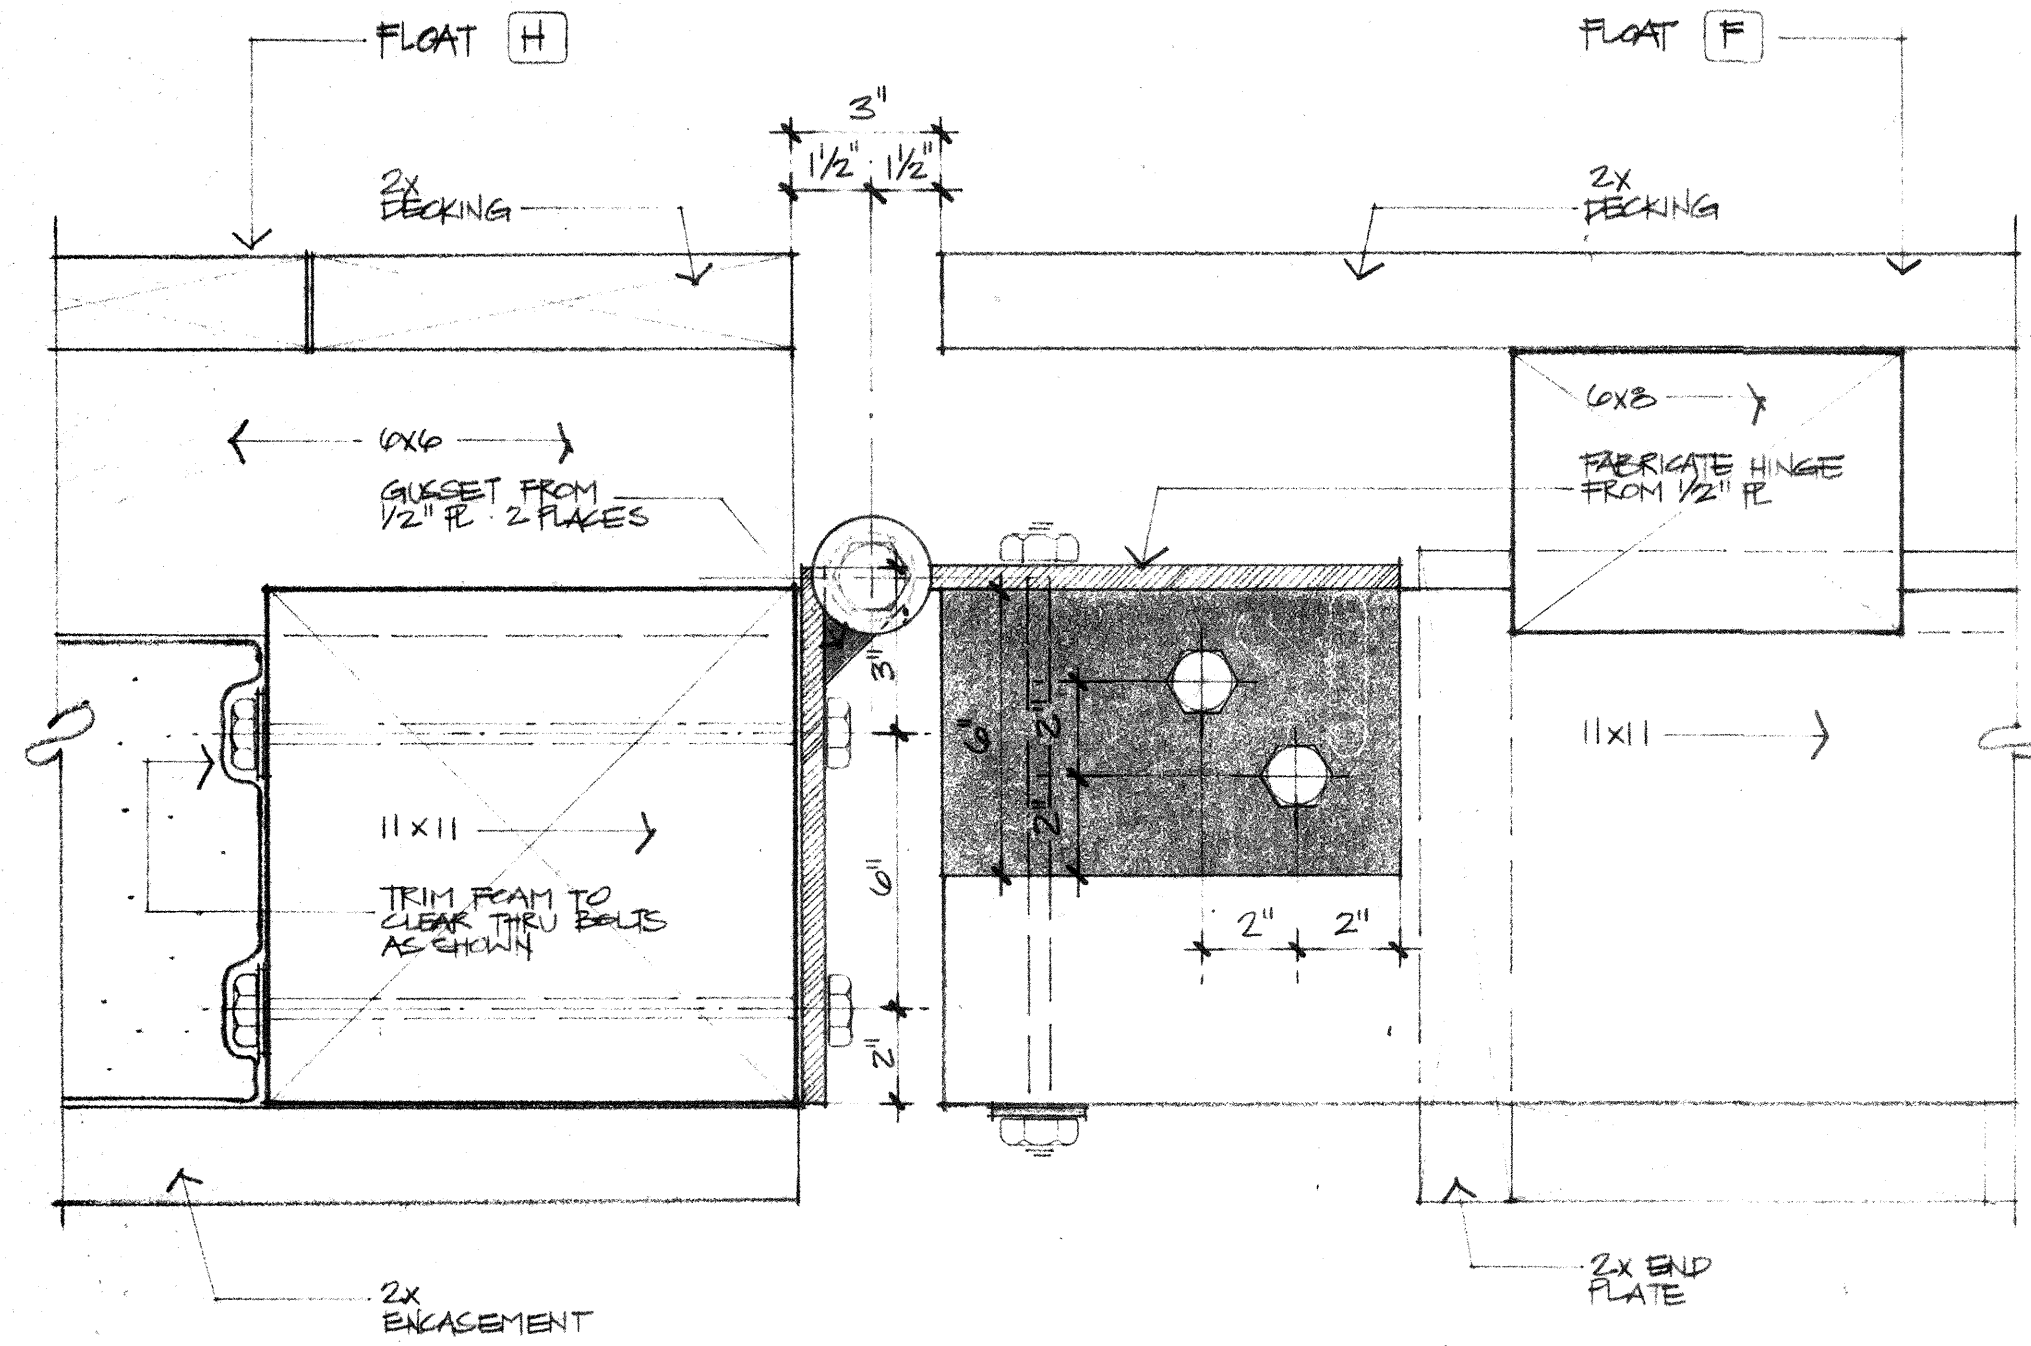


1 ELEVATION @ HINGE 9
NOTE: THIS APPLICATION REQRD. 1 PLACE ONLY.
3/4" = 1'-0"

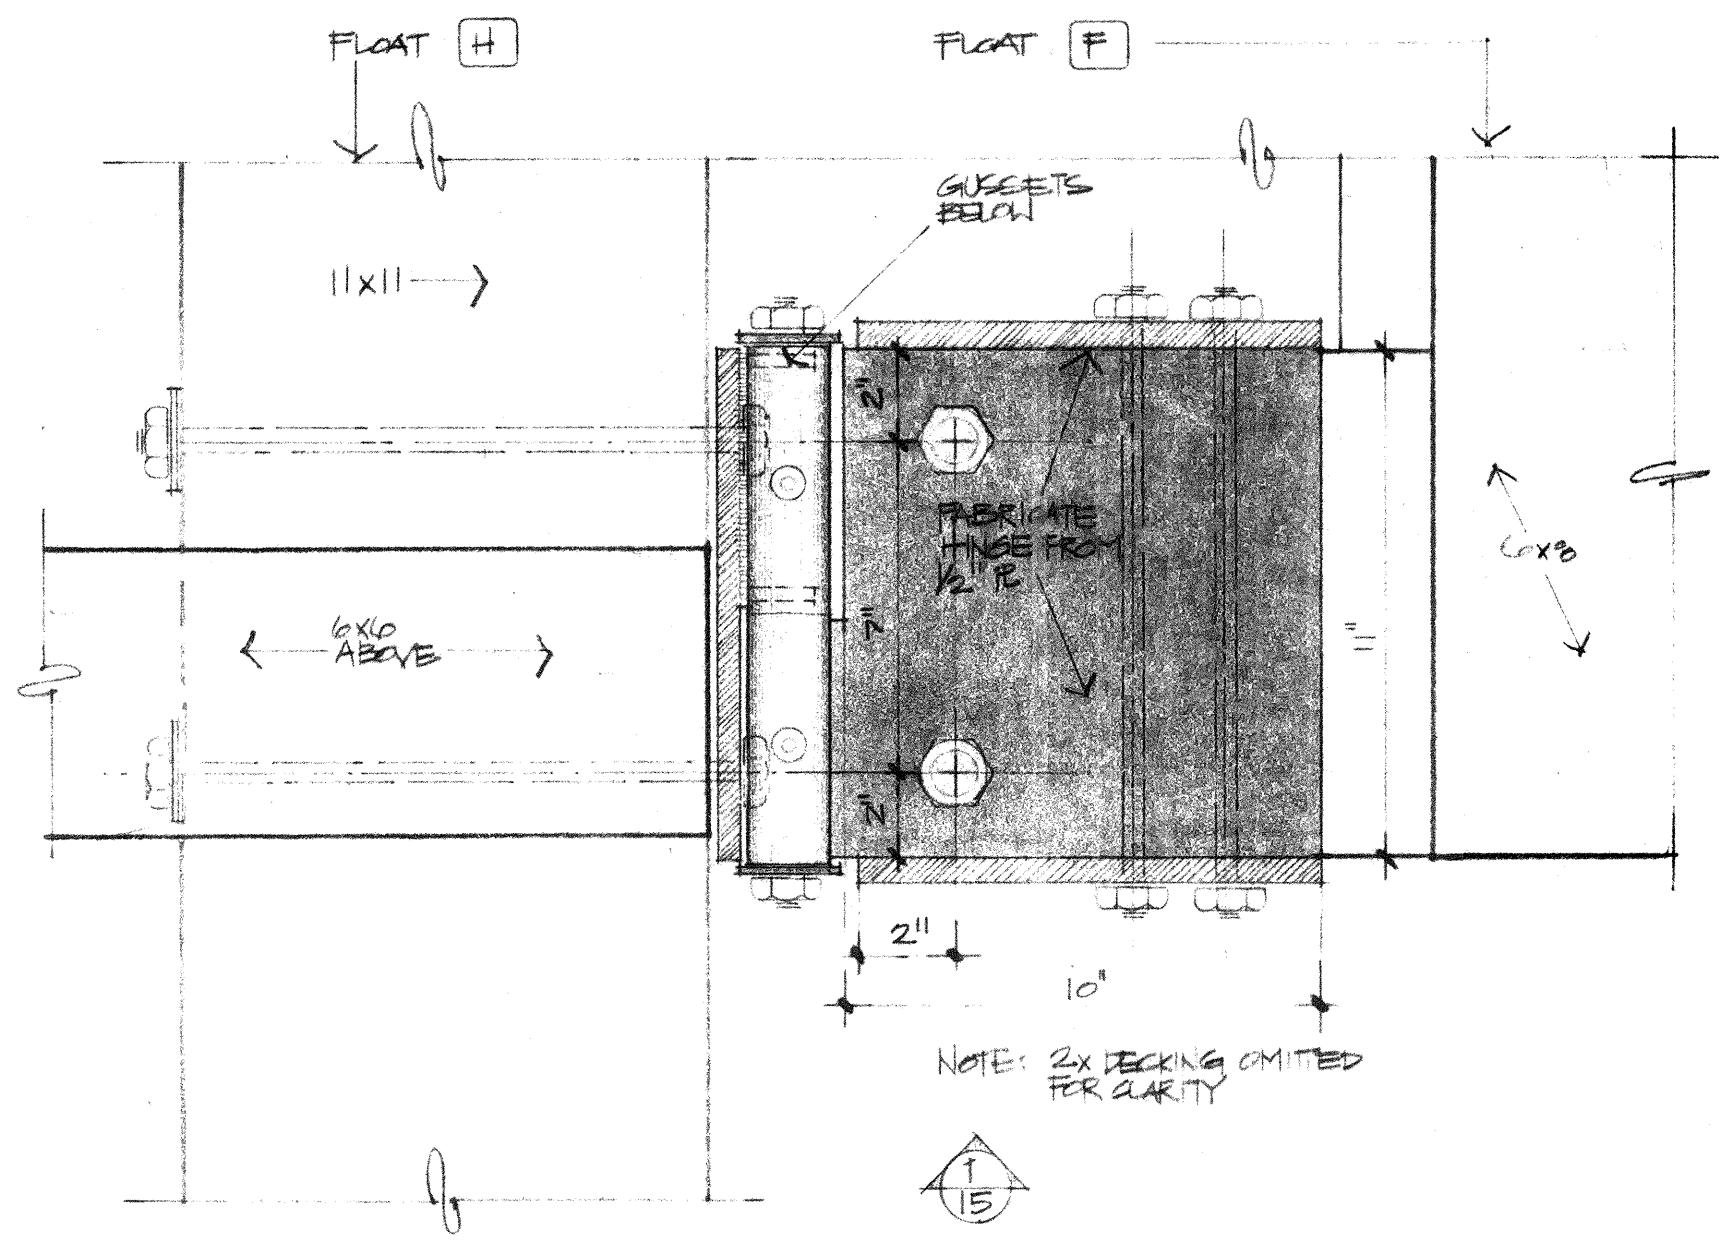


2 PLAN @ HINGE 9
NOTE: 2x PECKING OMITTED FOR CLARITY.
3/4" = 1'-0"

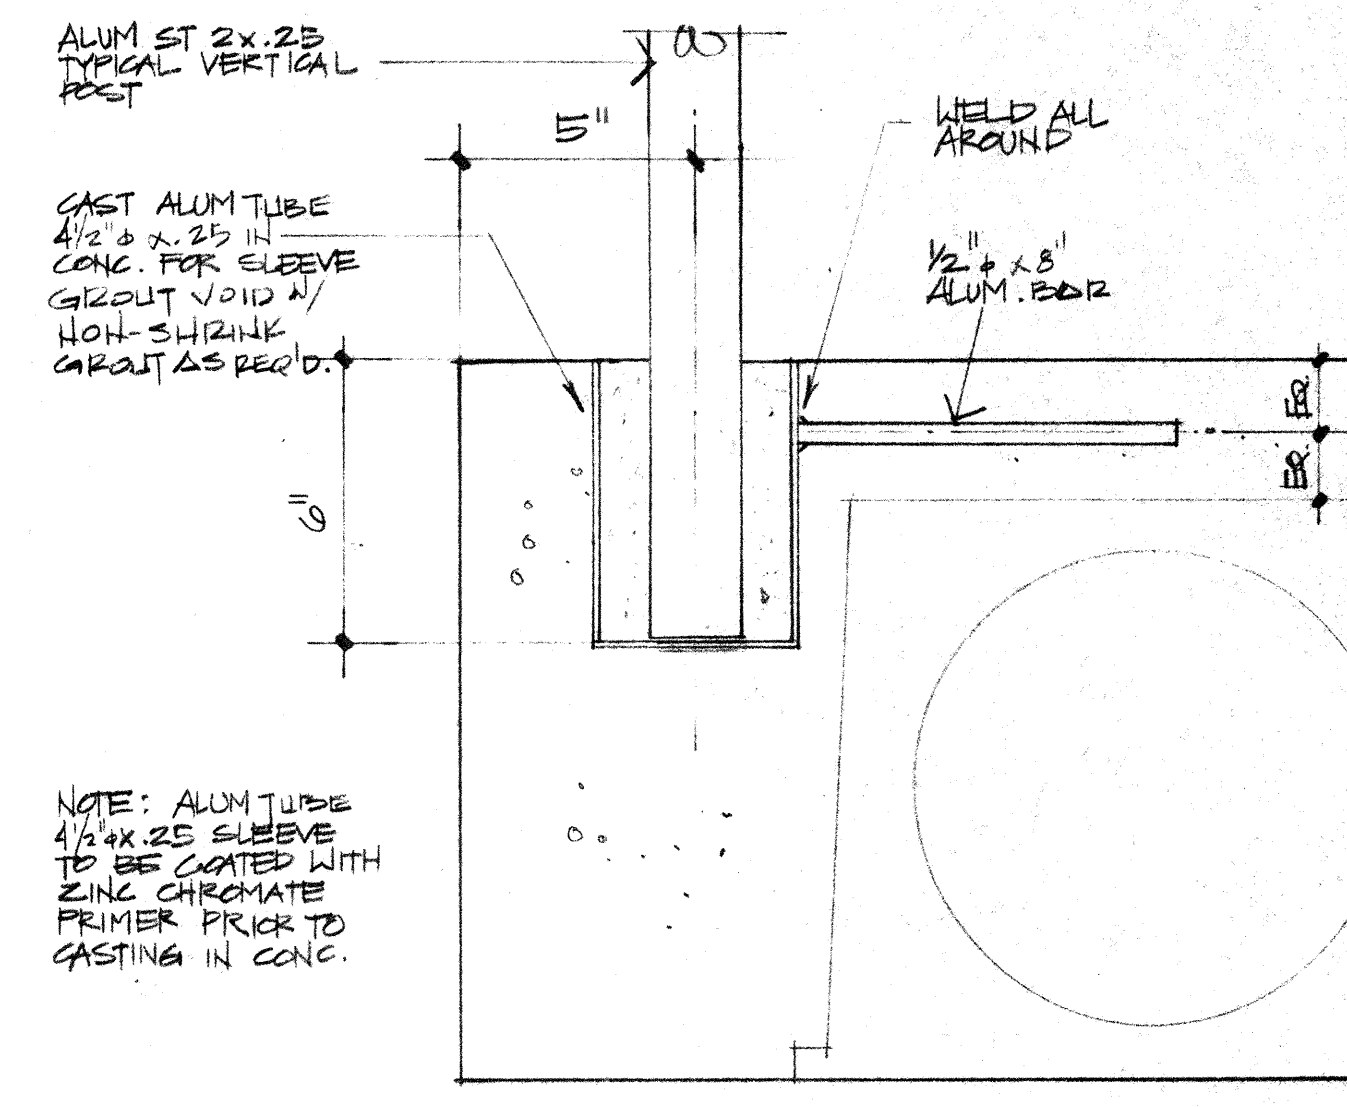

3 HANDRAIL ANCHOR
3/4" = 1'-0"

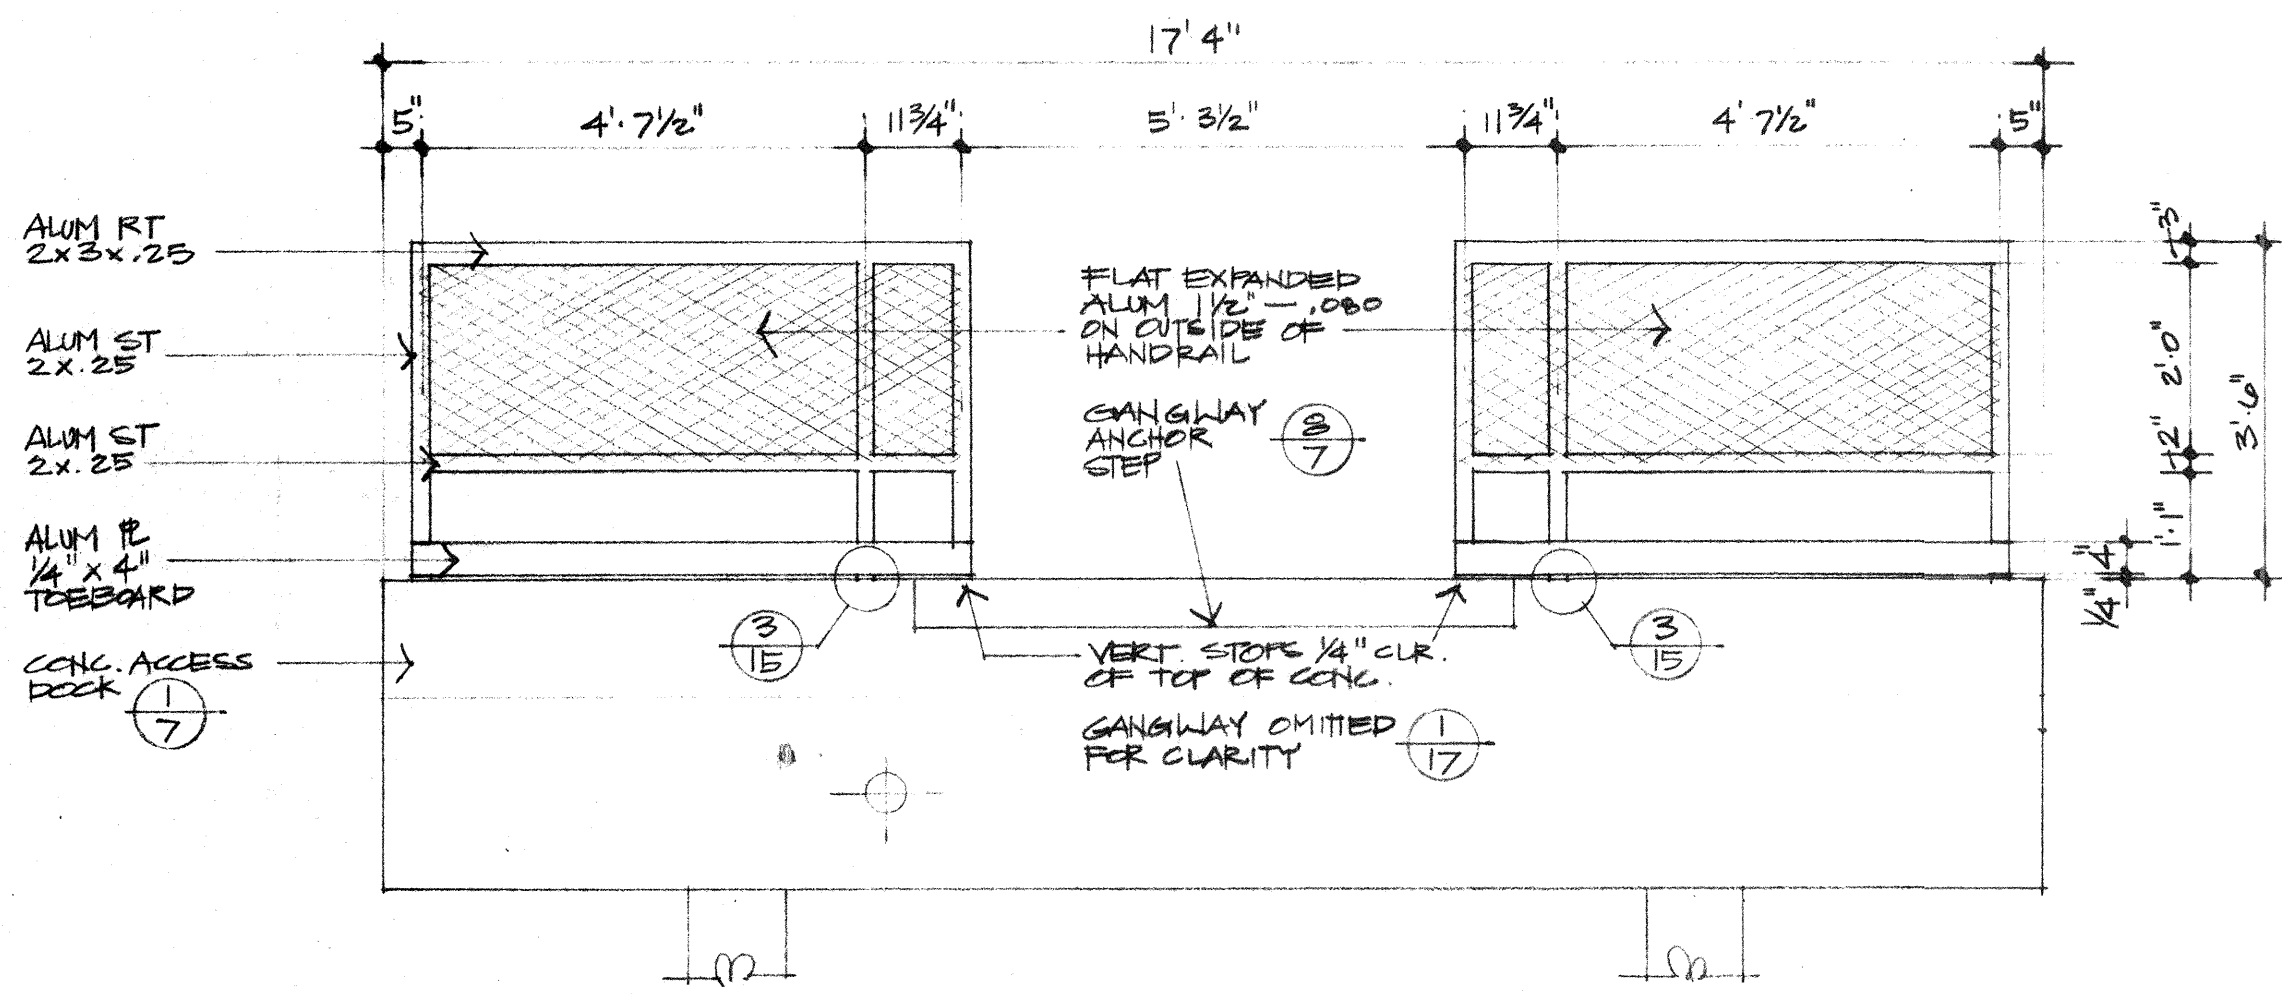


4 HANDRAIL ELEVATION @ ACCESS DOCK
1/2" = 1'-0"

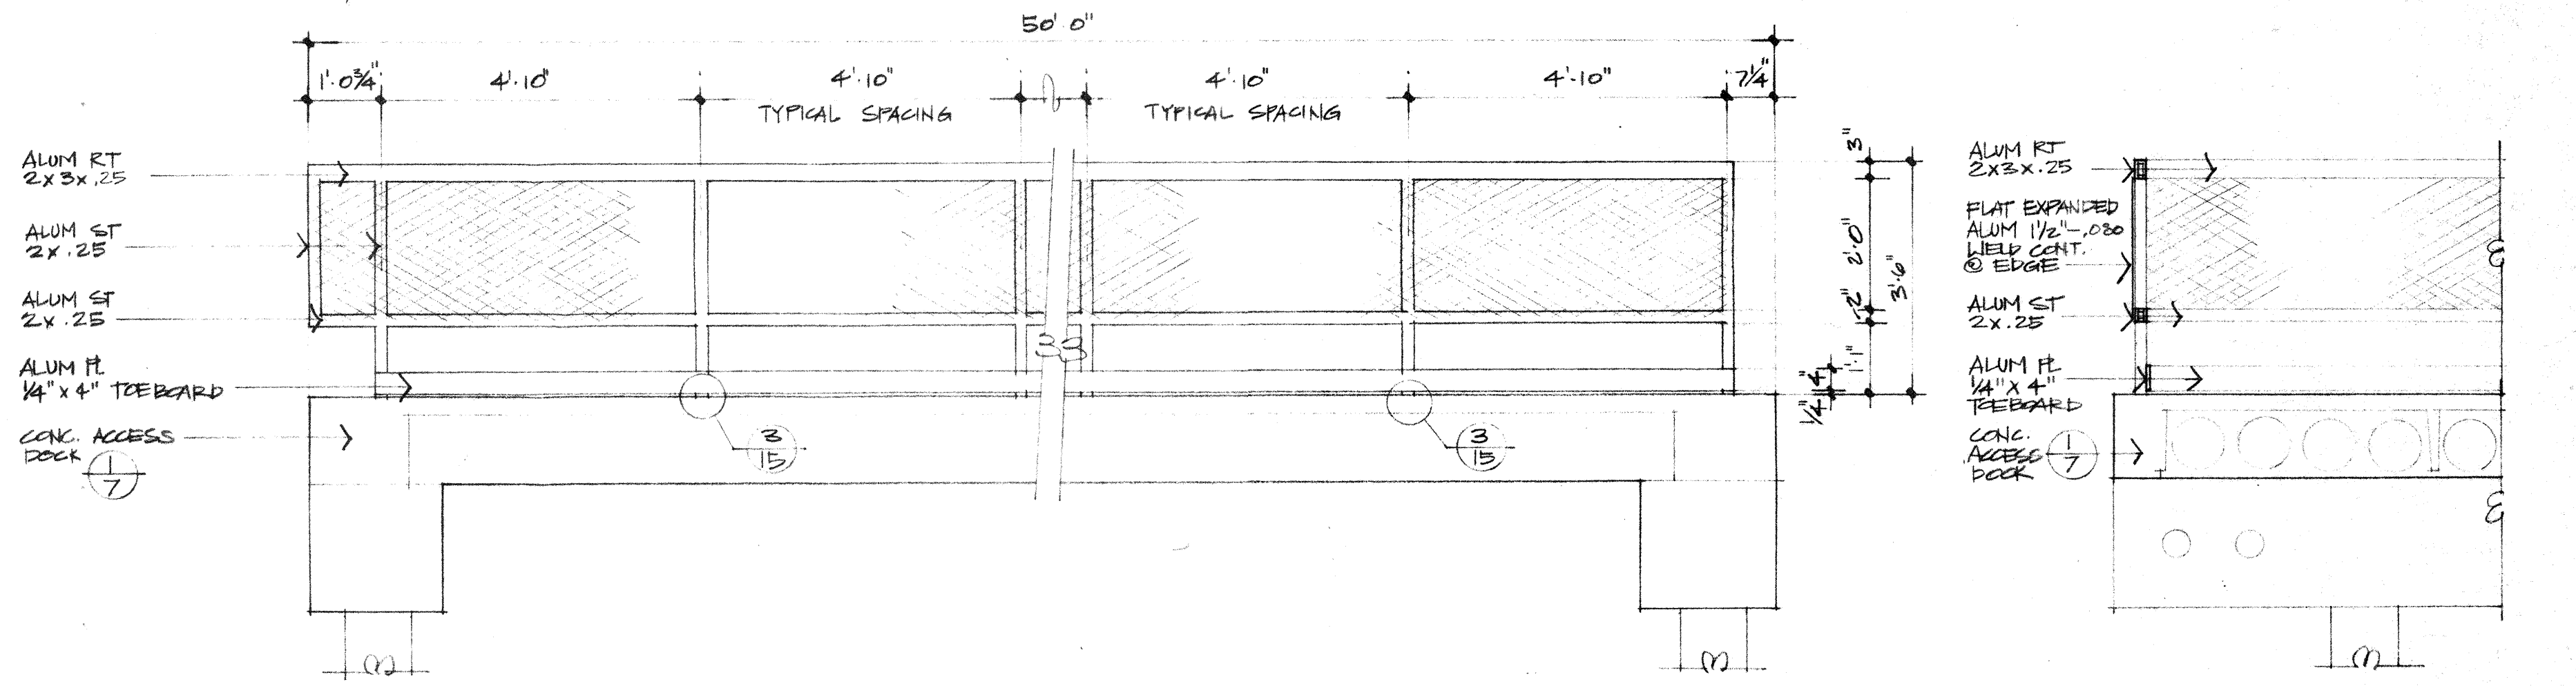


5 HANDRAIL ELEVATION @ ACCESS DOCK
1/2" = 1'-0"

6 SECTION
1/2" = 1'-0"

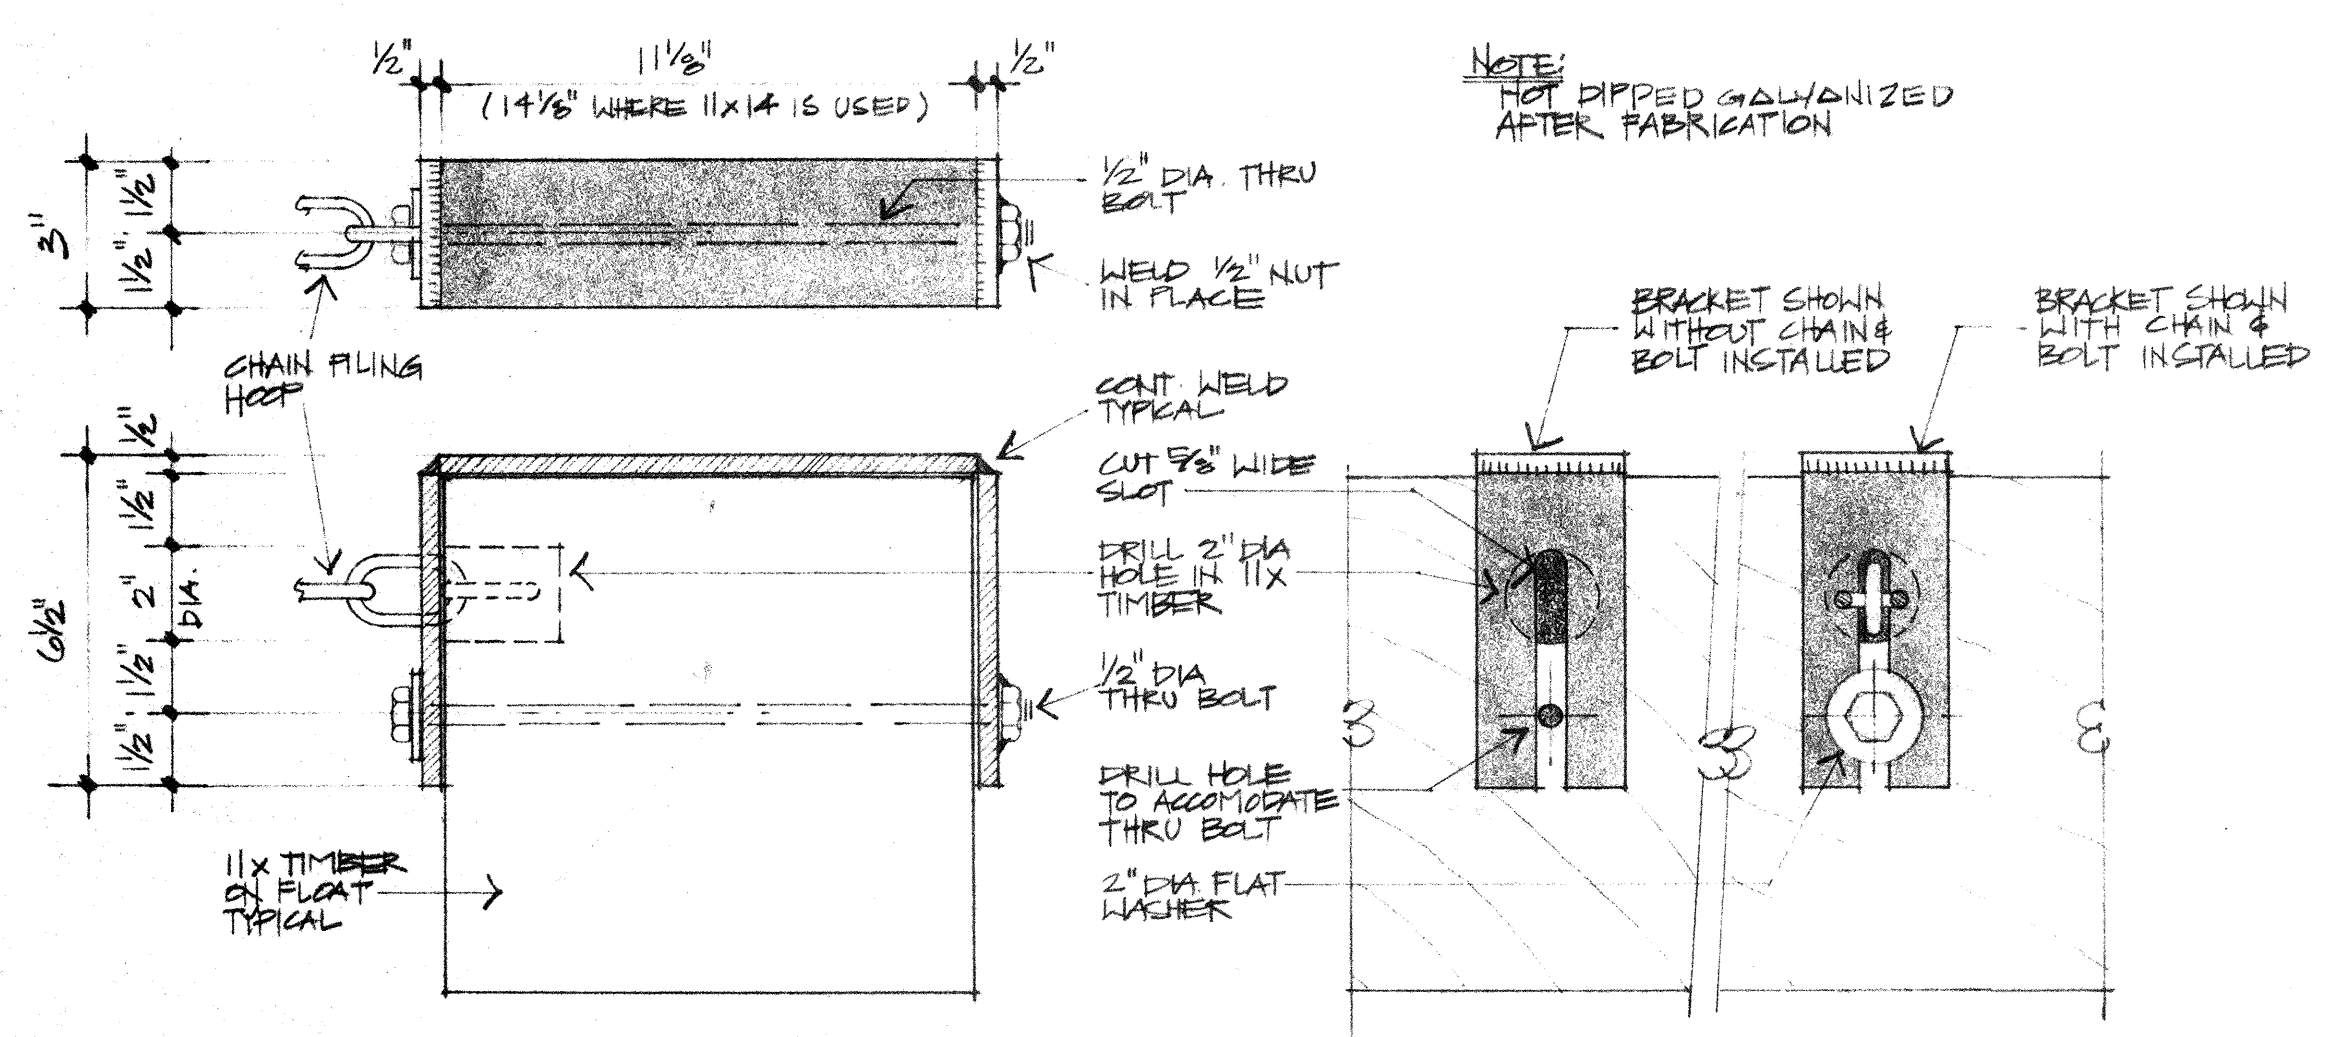


- INSTALLATION PROCEDURE:
- 1) PLACE END OF CHAIN IN 2" DIA HOLE DRILLED IN 11x14 TIMBER.
 - 2) SLIP BRACKET IN PLACE AS SHOWN. ALIGN SECOND CHAIN LINK IN 5/8" SLOT AS BRACKET SLIDES IN PLACE.
 - 3) INSTALL THRU BOLT WITH WASHER THRU BRACKET AND 11x14 TIMBER. TIGHTEN BOLT.

7 CHAIN ANCHOR BRACKET
3/4" = 1'-0"

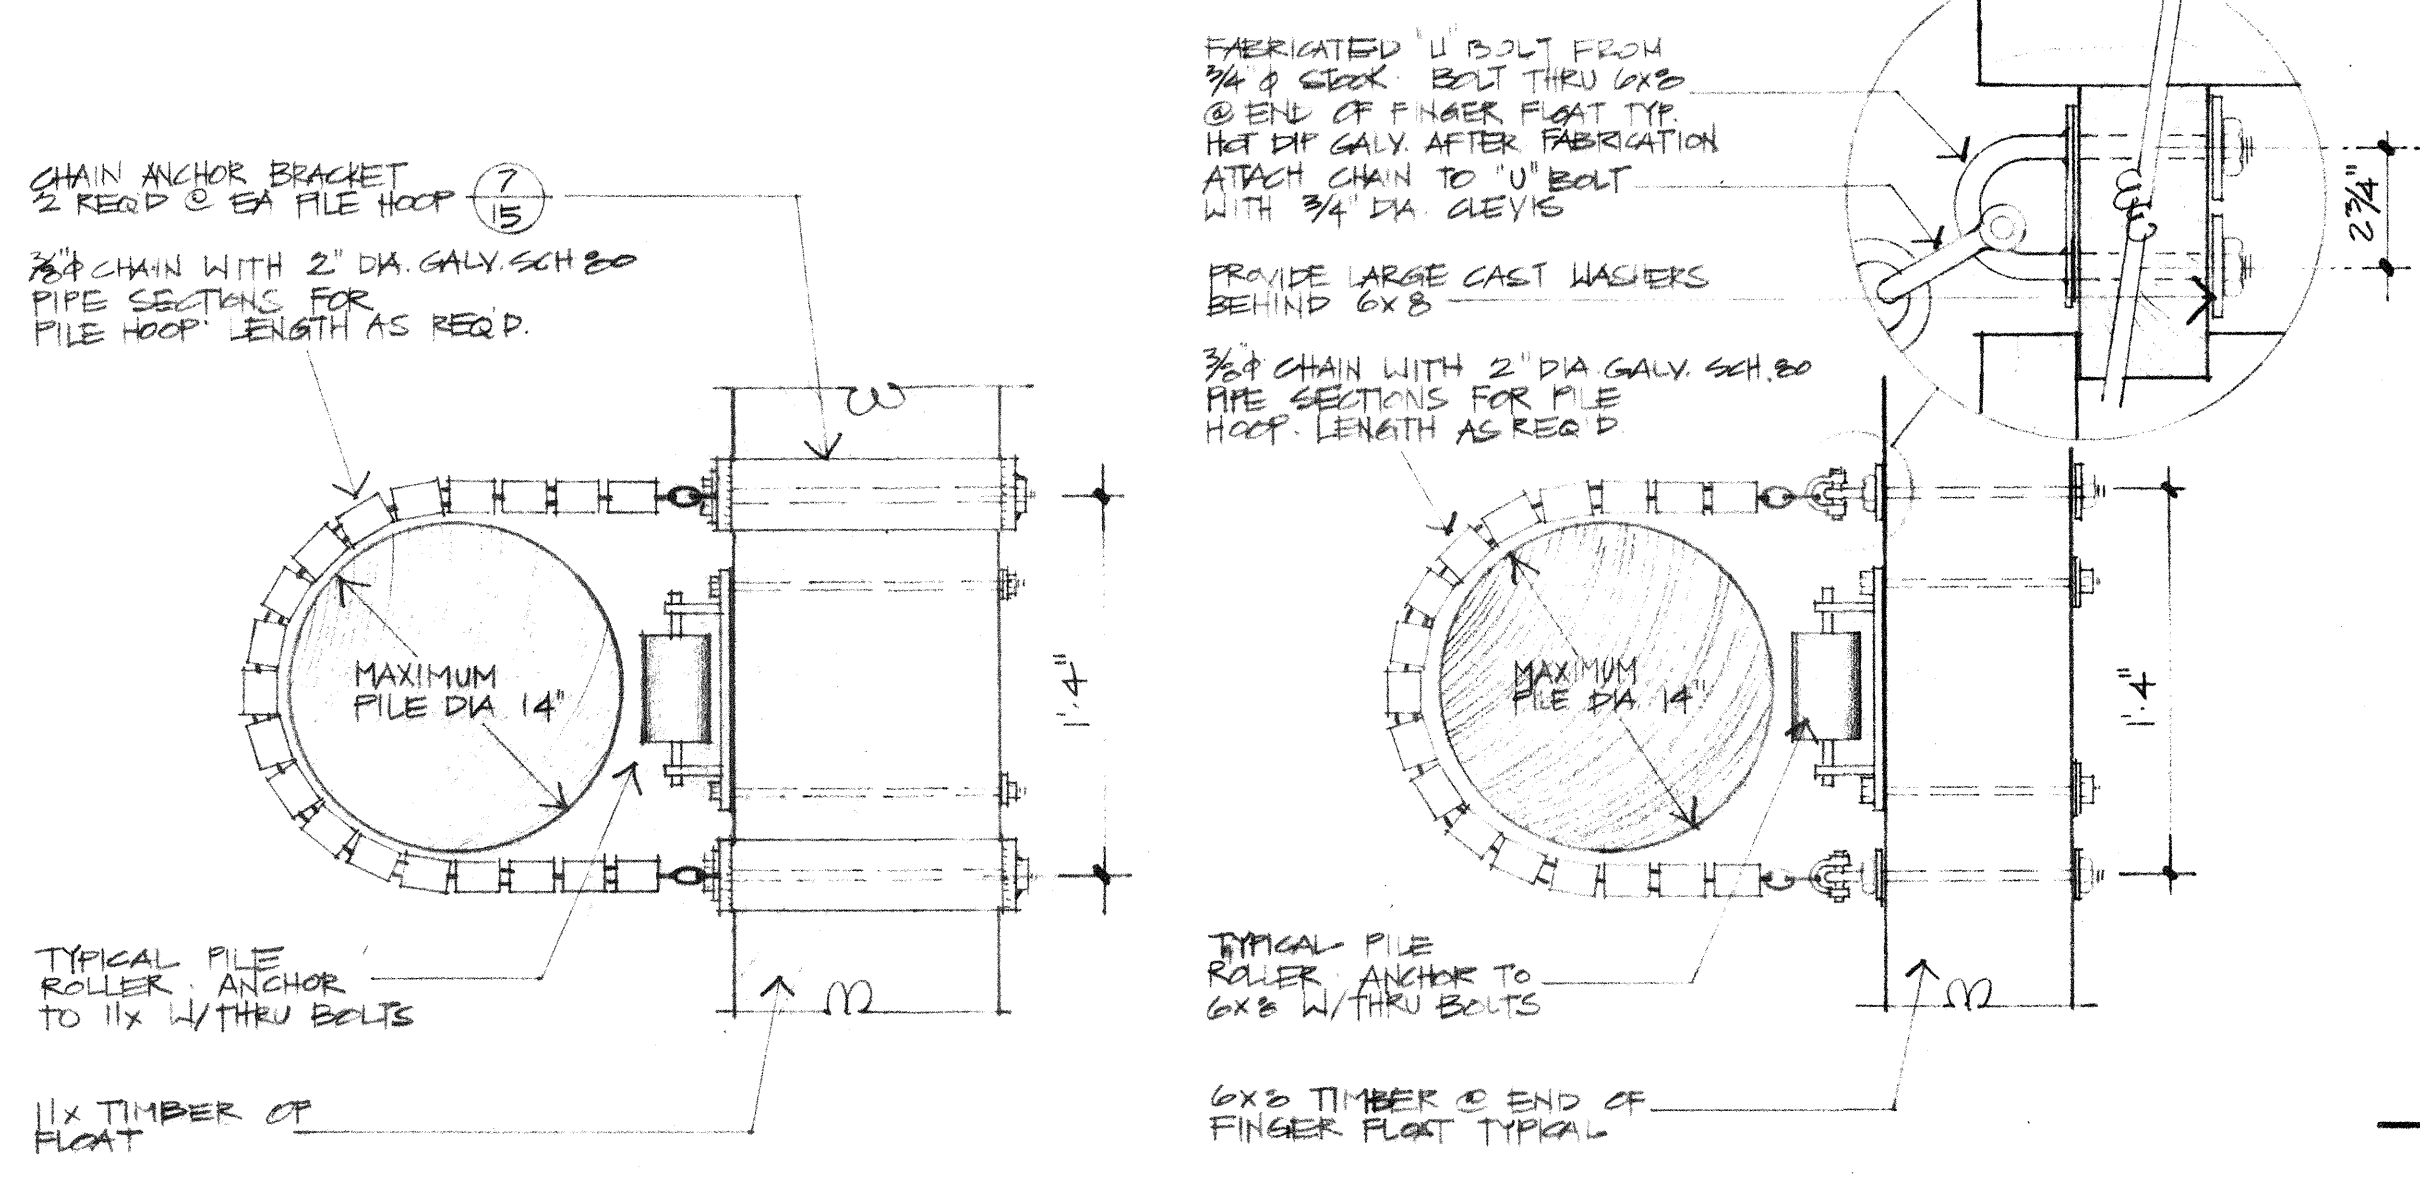


8 TYPICAL PILING HOOP
1/2" = 1'-0"


9 PILE HOOP @ FINGER FLOAT
1/2" = 1'-0"

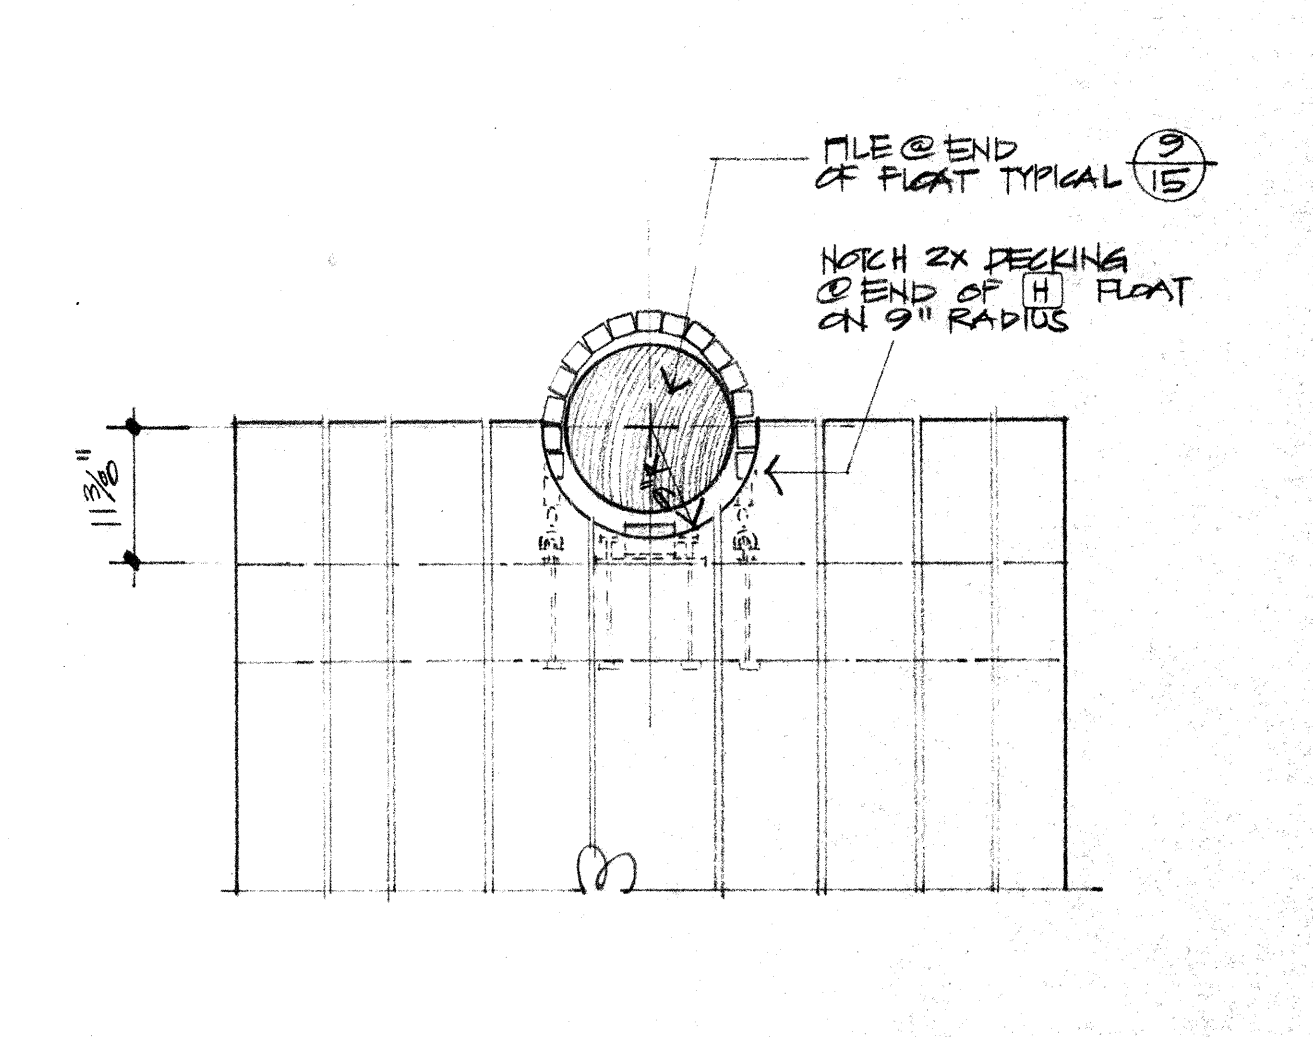


10 PILE HOOP @ END OF FLOAT H
(1 APPLICATION ONLY)
3/4" = 1'-0"

RECORDED DRAWG. 1/32 R.K.

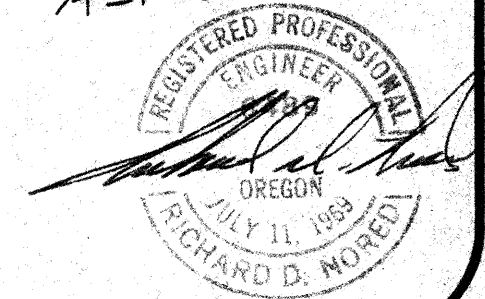


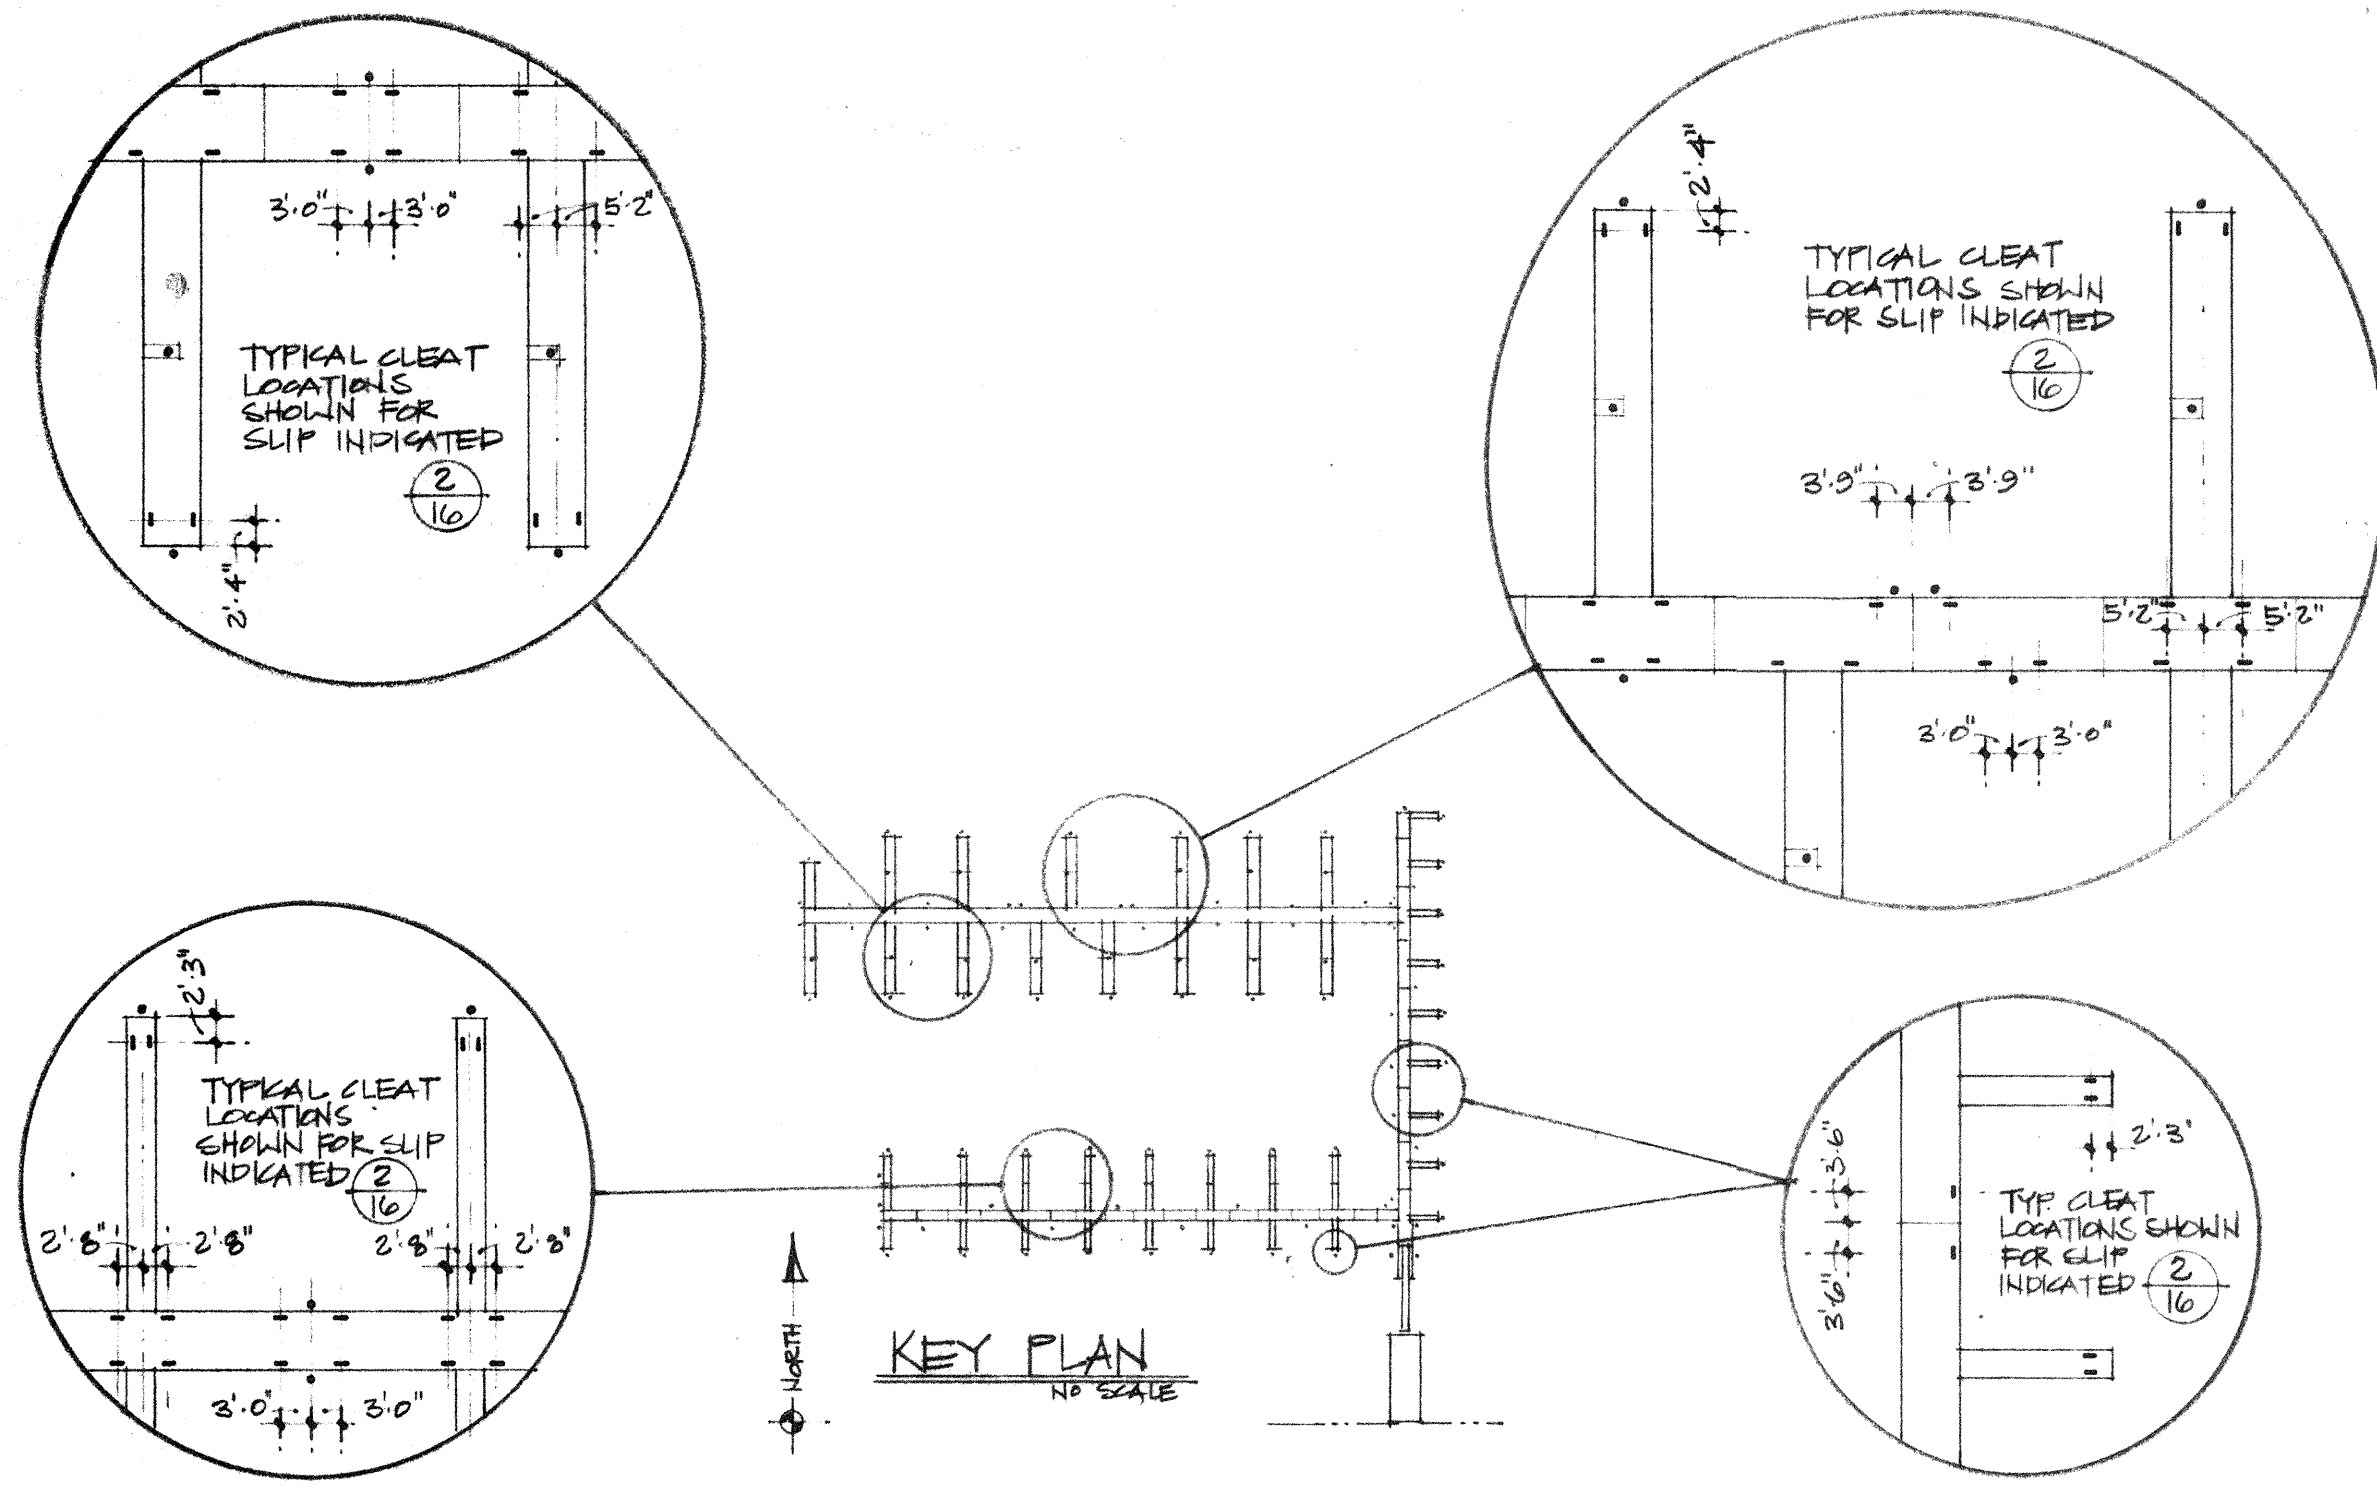


1/16 CLEAT LOCATIONS
DETAILS @ 1" = 20"

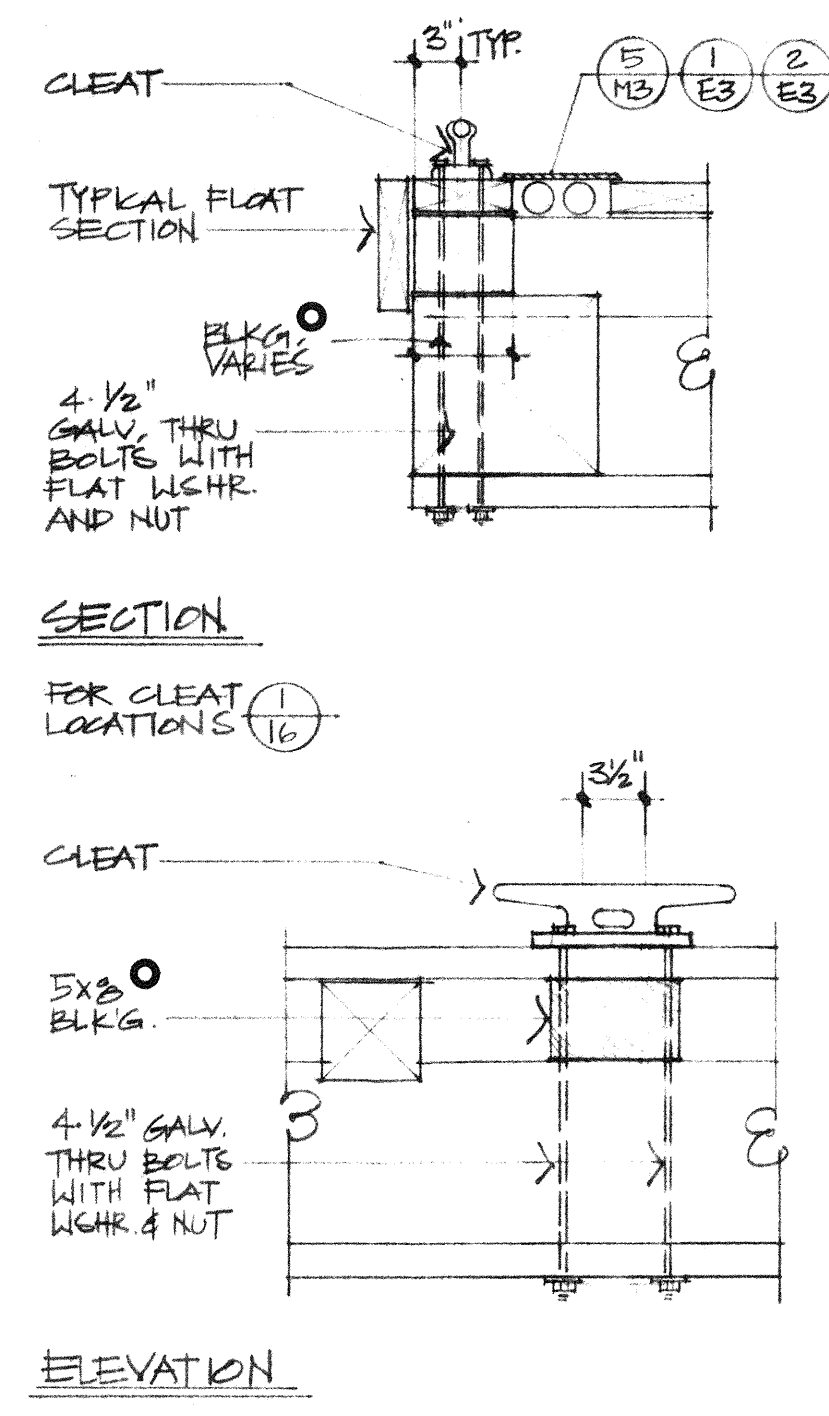

2/16 TYPICAL CLEAT
1" = 1'-0"

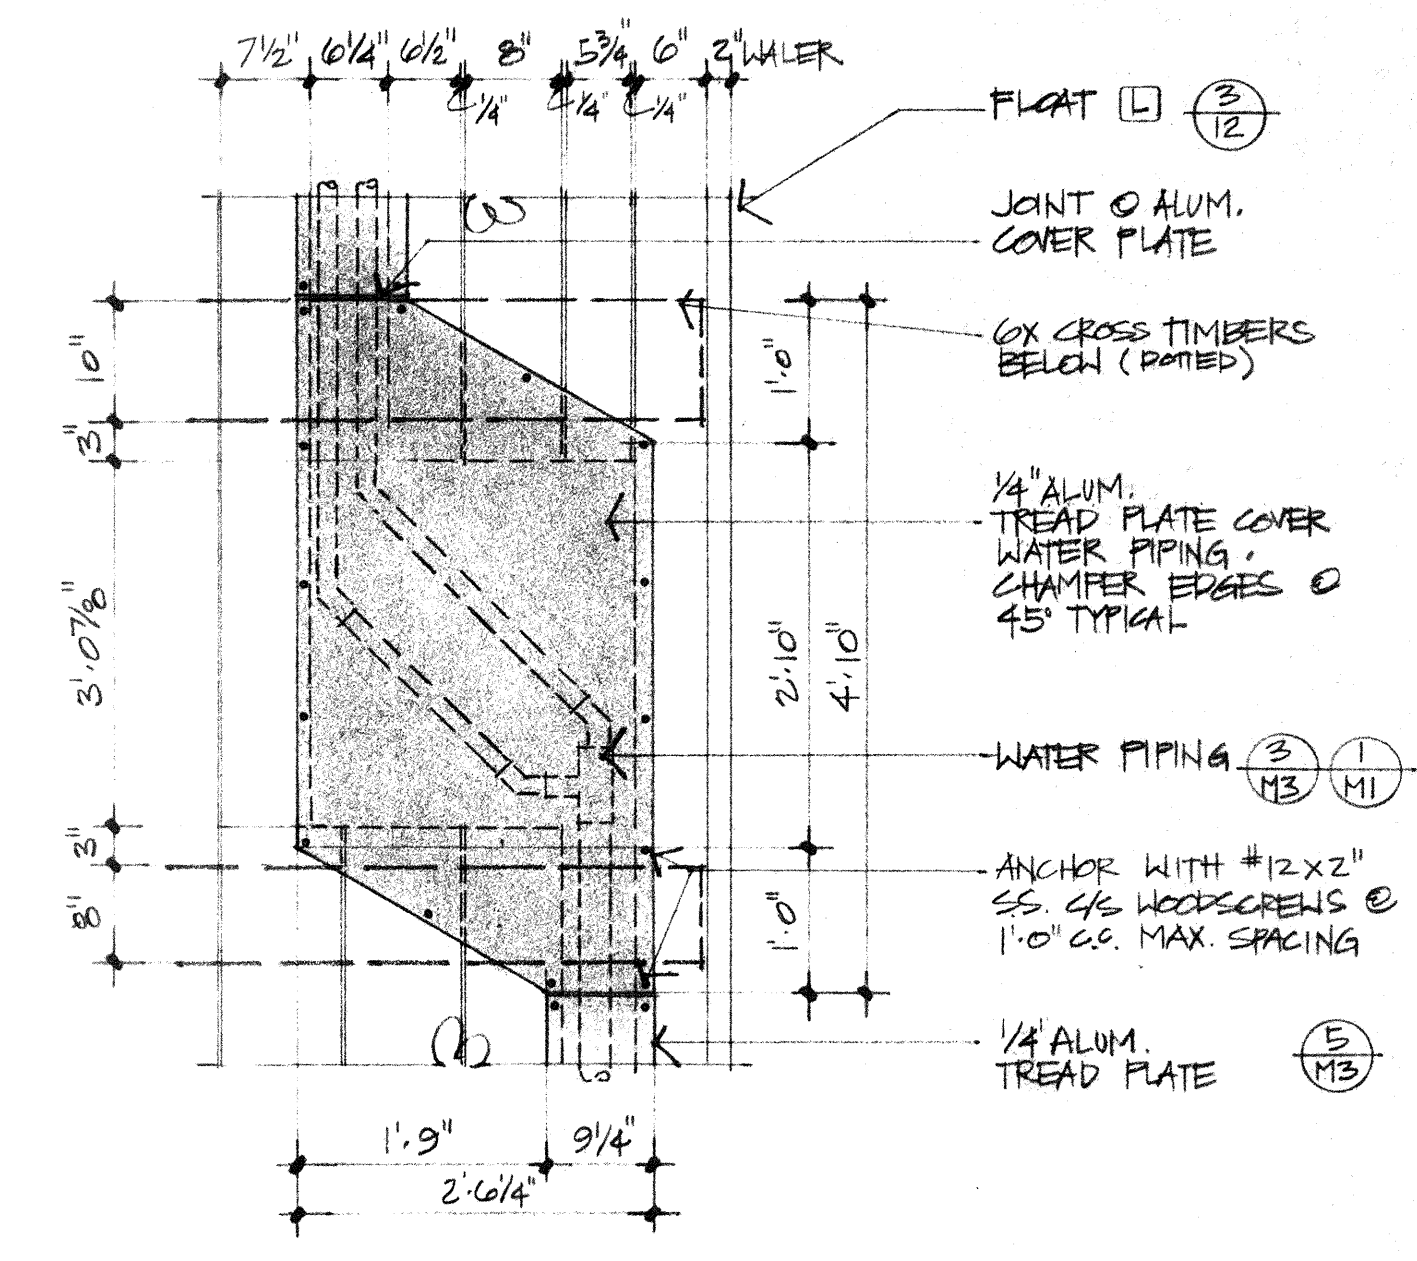


3/16 WATERLINE COVER PLATE
3/4" = 1'-0"

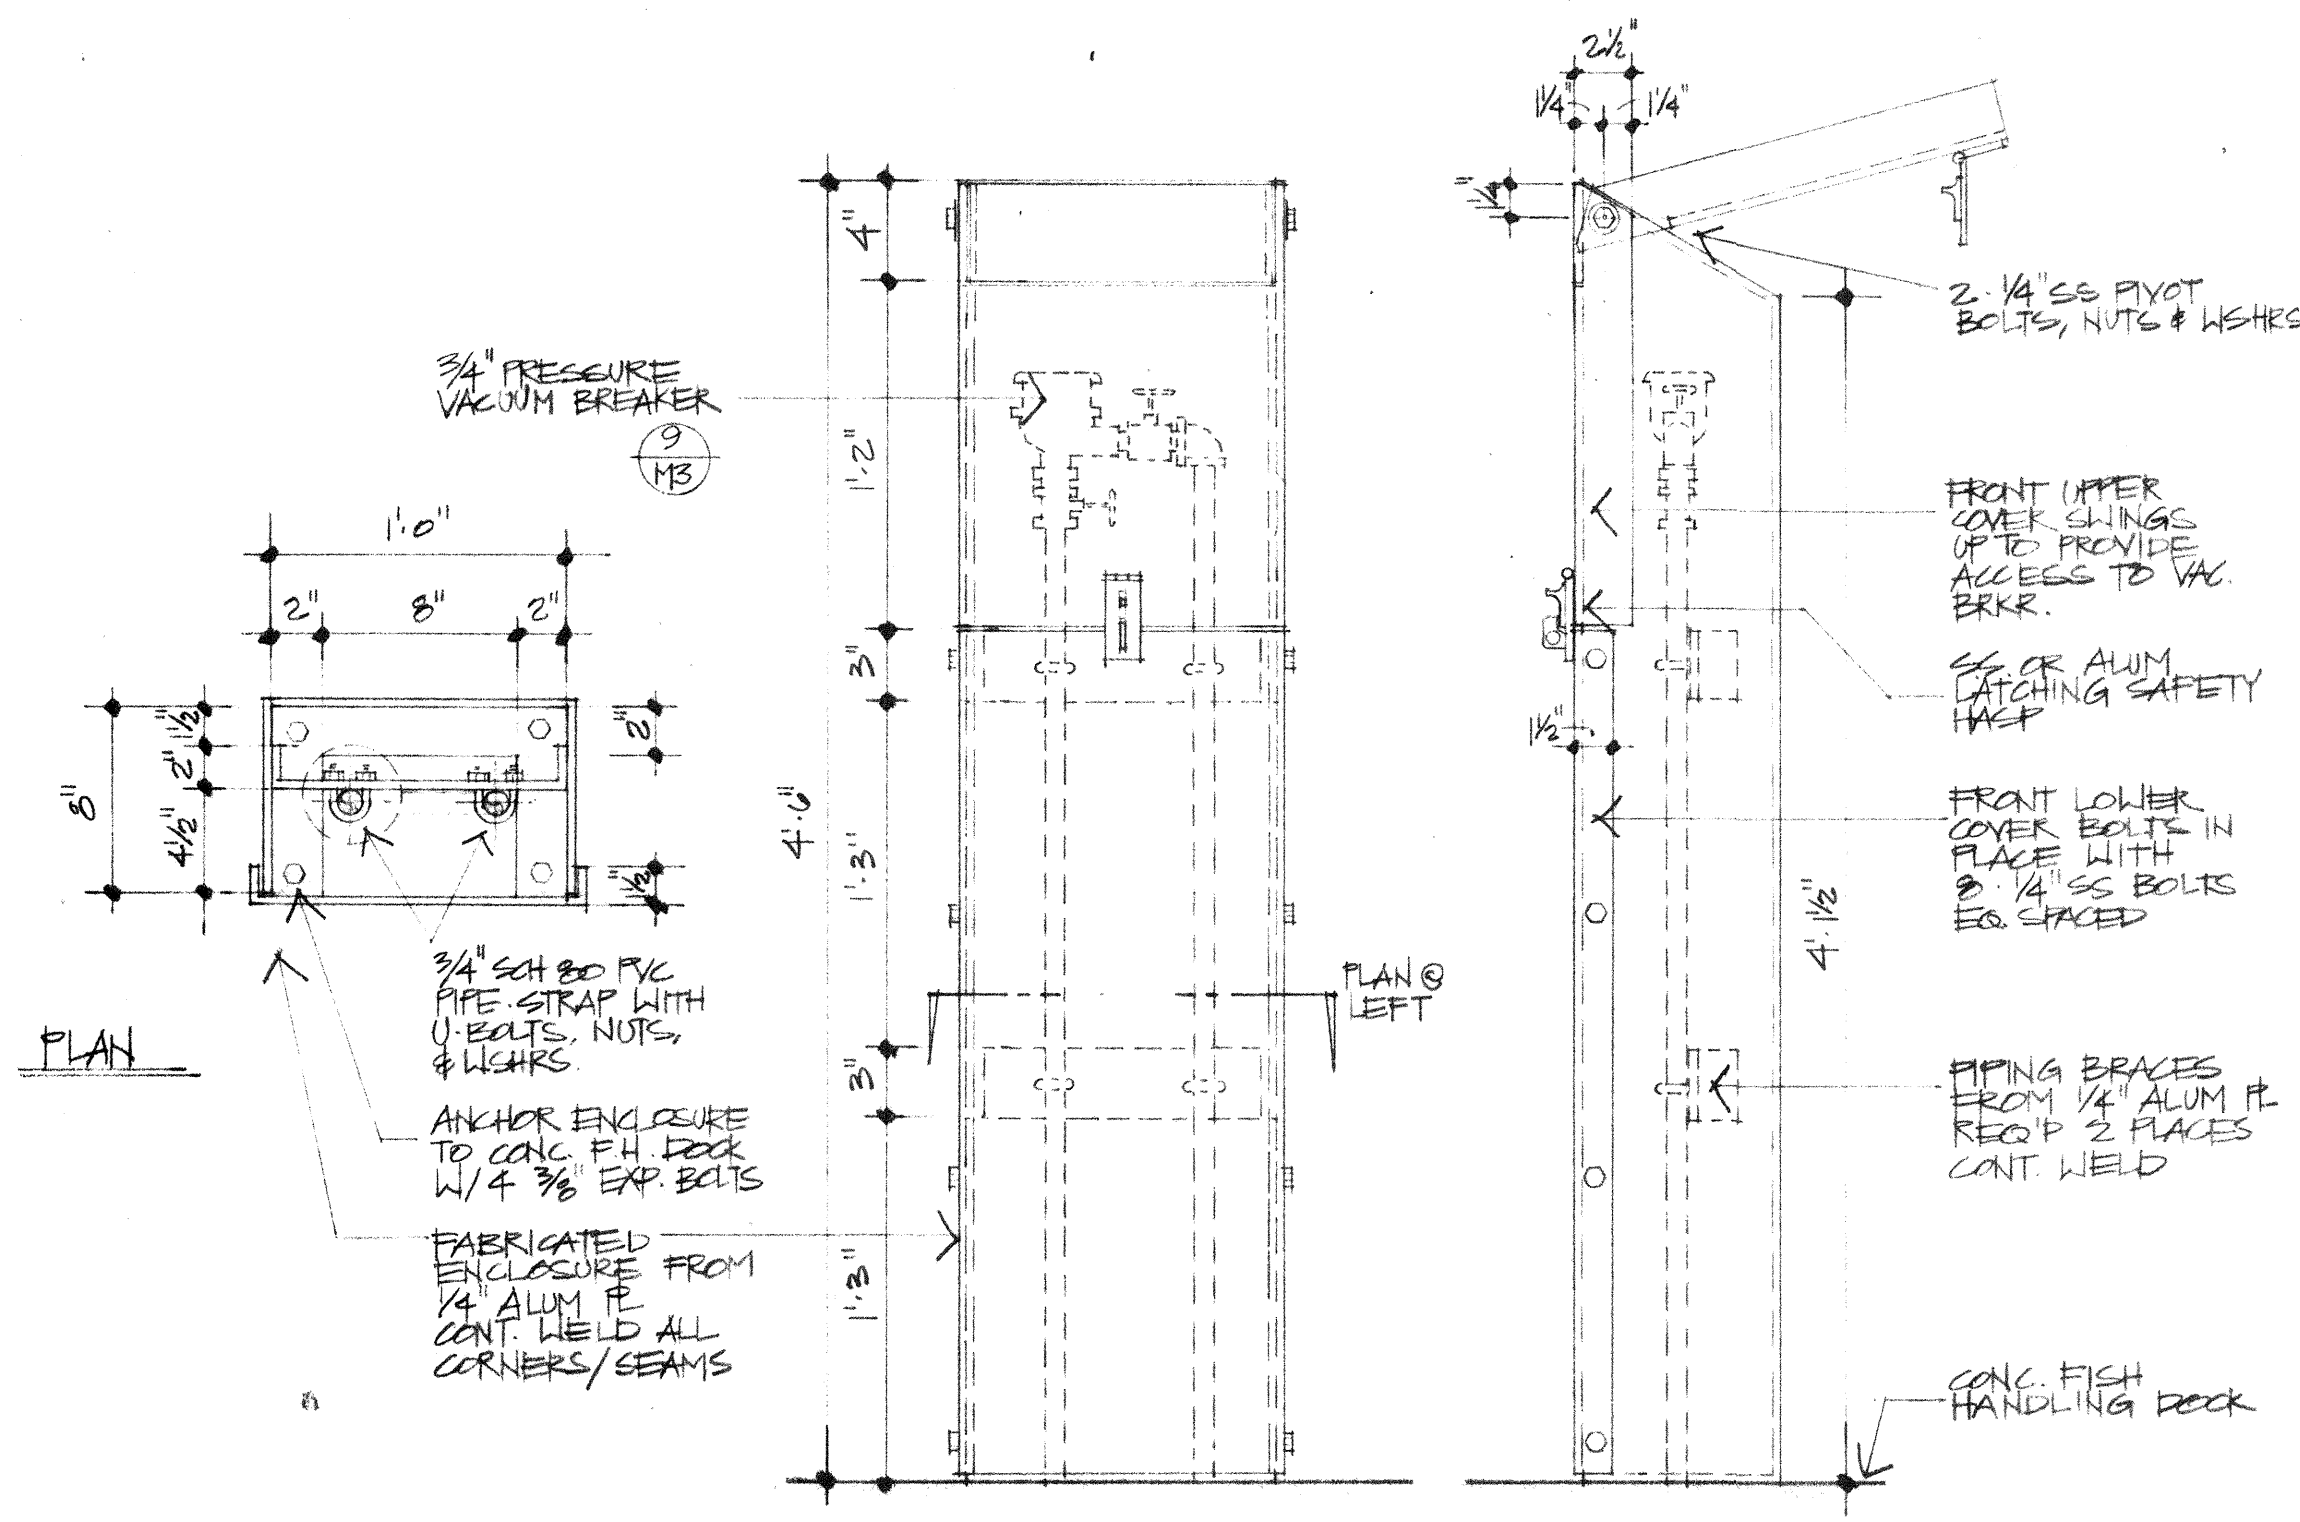

4/16 VACUUM BREAKER ENCLOSURE
2 REQ'D. 1/2" = 1'-0"

0 - DENOTES FURNISHED BY OWNER

RECORD DRAWING 1/83 R.K.
REVISED 8-10-82 RLB

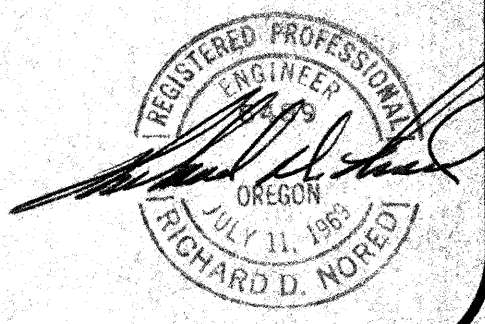

HCE INC./ENGINEERS & PLANNERS
Coos Bay, Oregon / 375 Park Avenue 97420 / (503) 269-1166
Corvallis, Oregon / 19 W. 5th Ave. 97331 / (503) 222-0687
Astoria, Oregon / 300 Elsworth St. So. 97101 / (503) 928-0064








SHEET TITLE
DETAILS

PROJECT #
2271
DATE
JULY, 1982

PROJECT PART OF BANDON
CORVILLE RIVER BOAT BASIN
COOS COUNTY, OREGON

SHEET NO.
OF
16

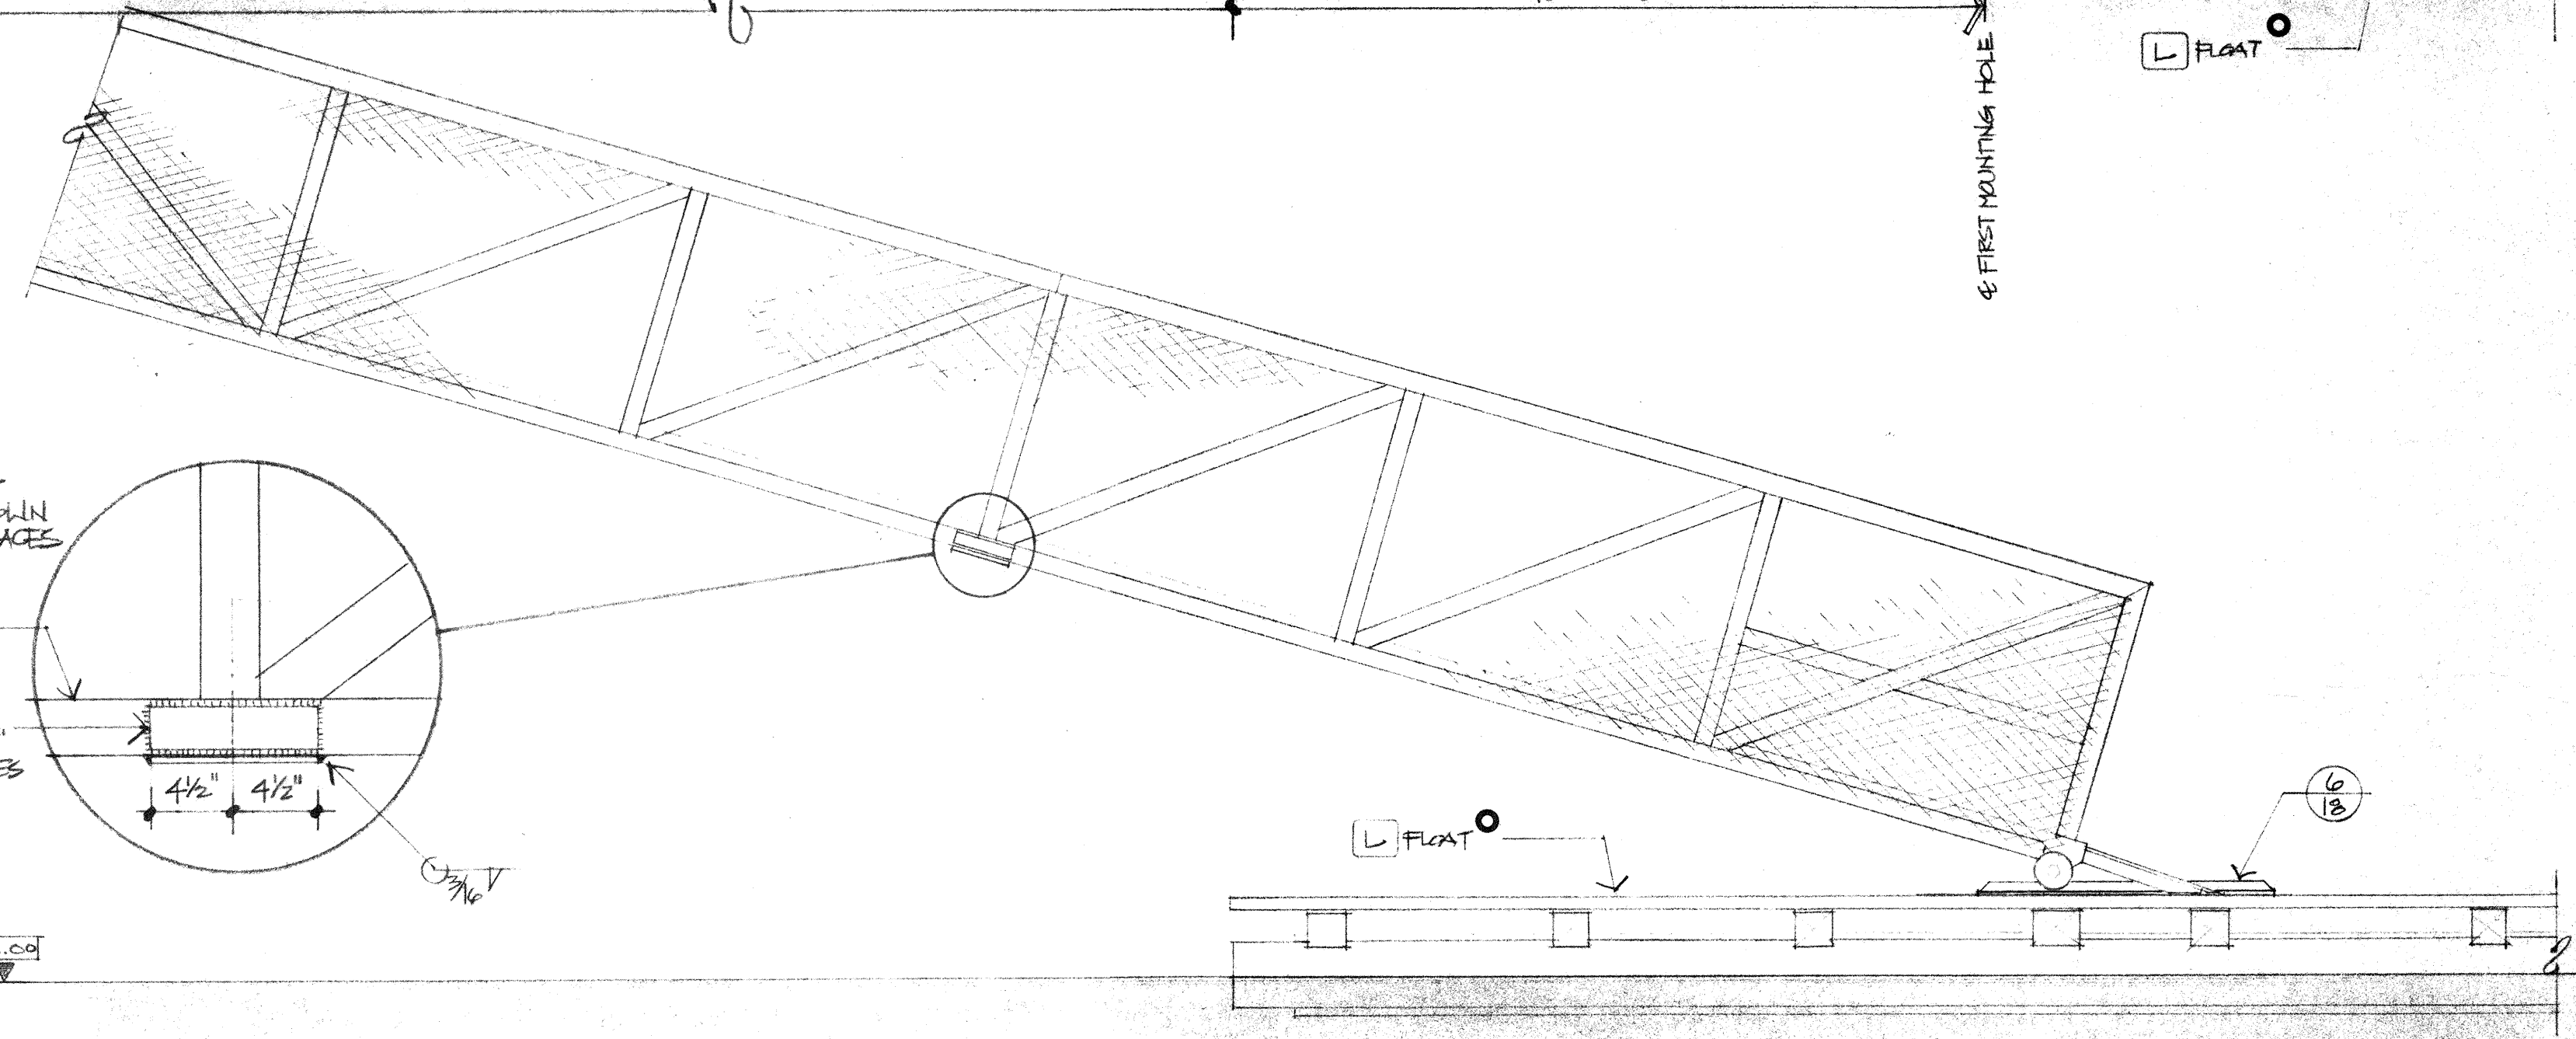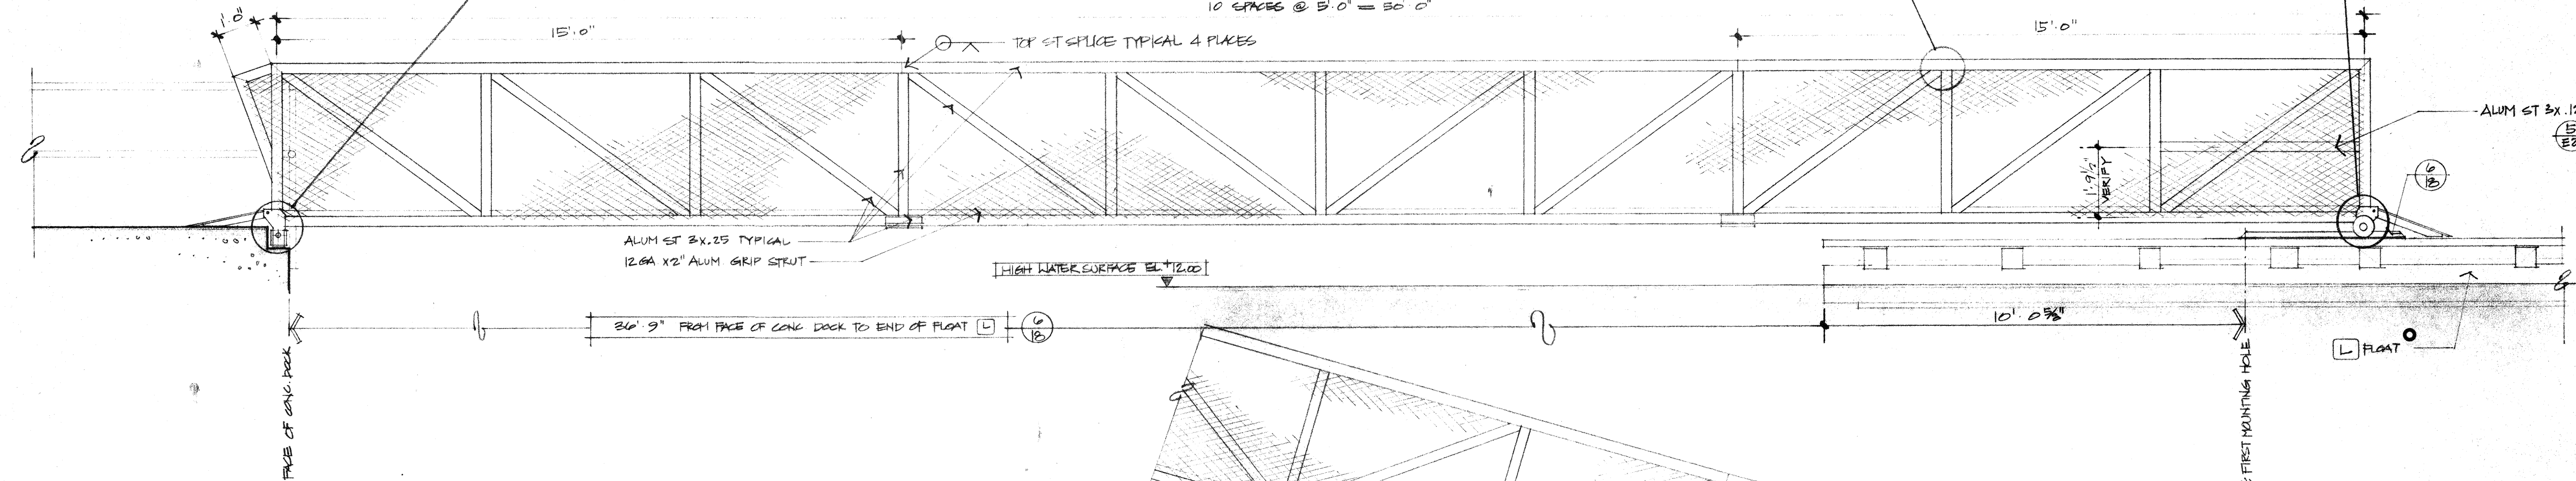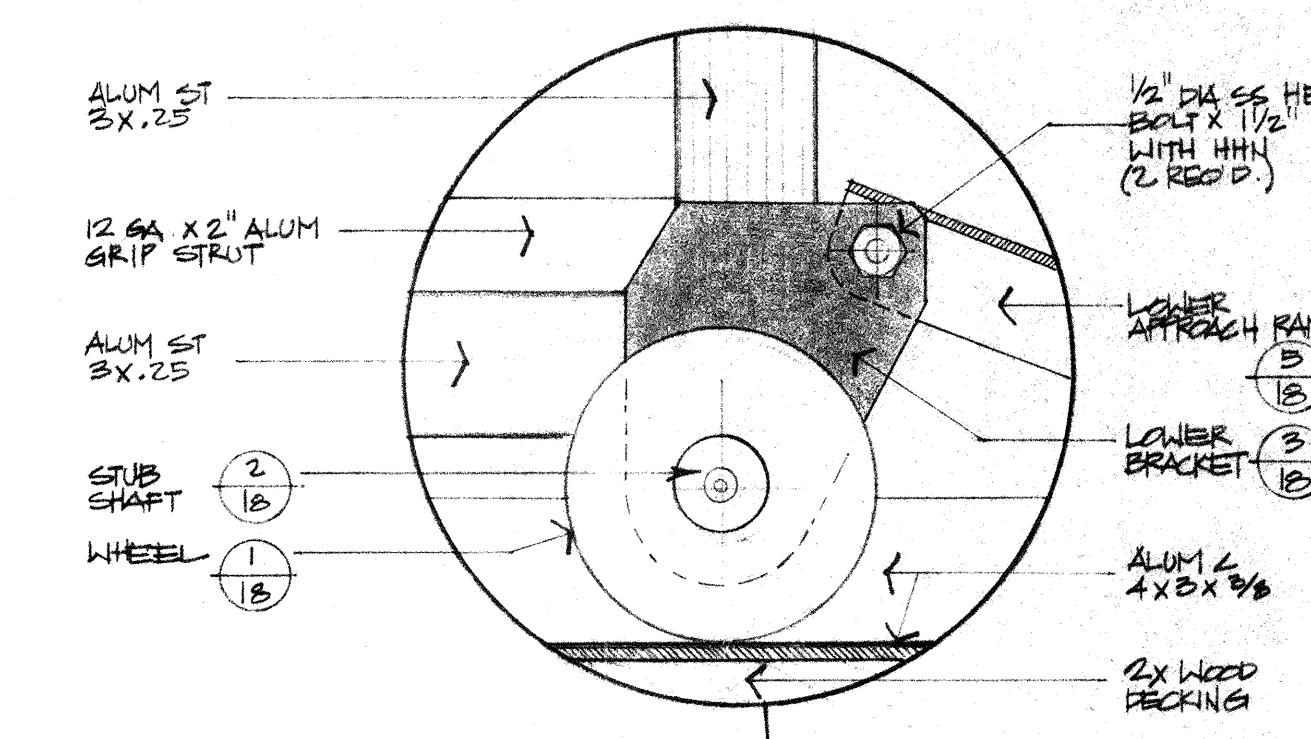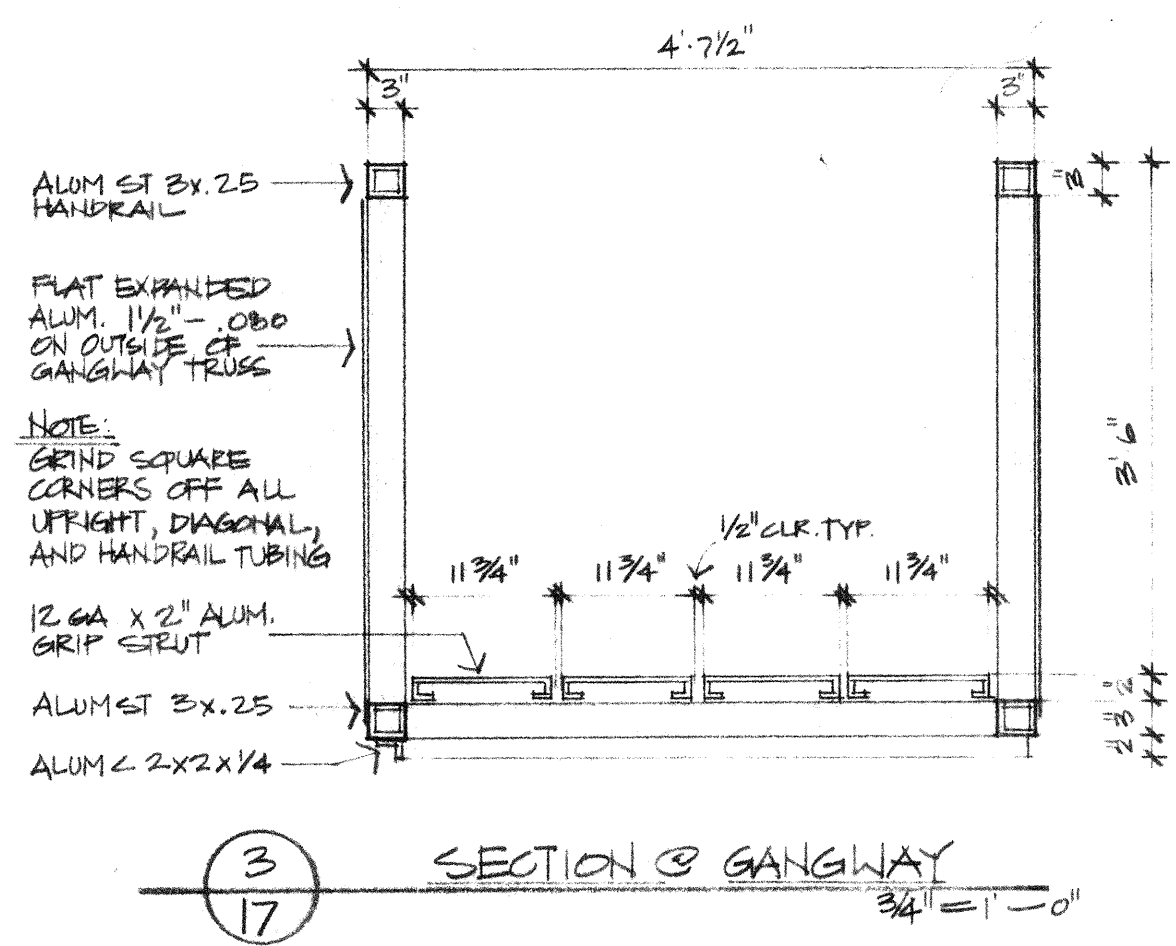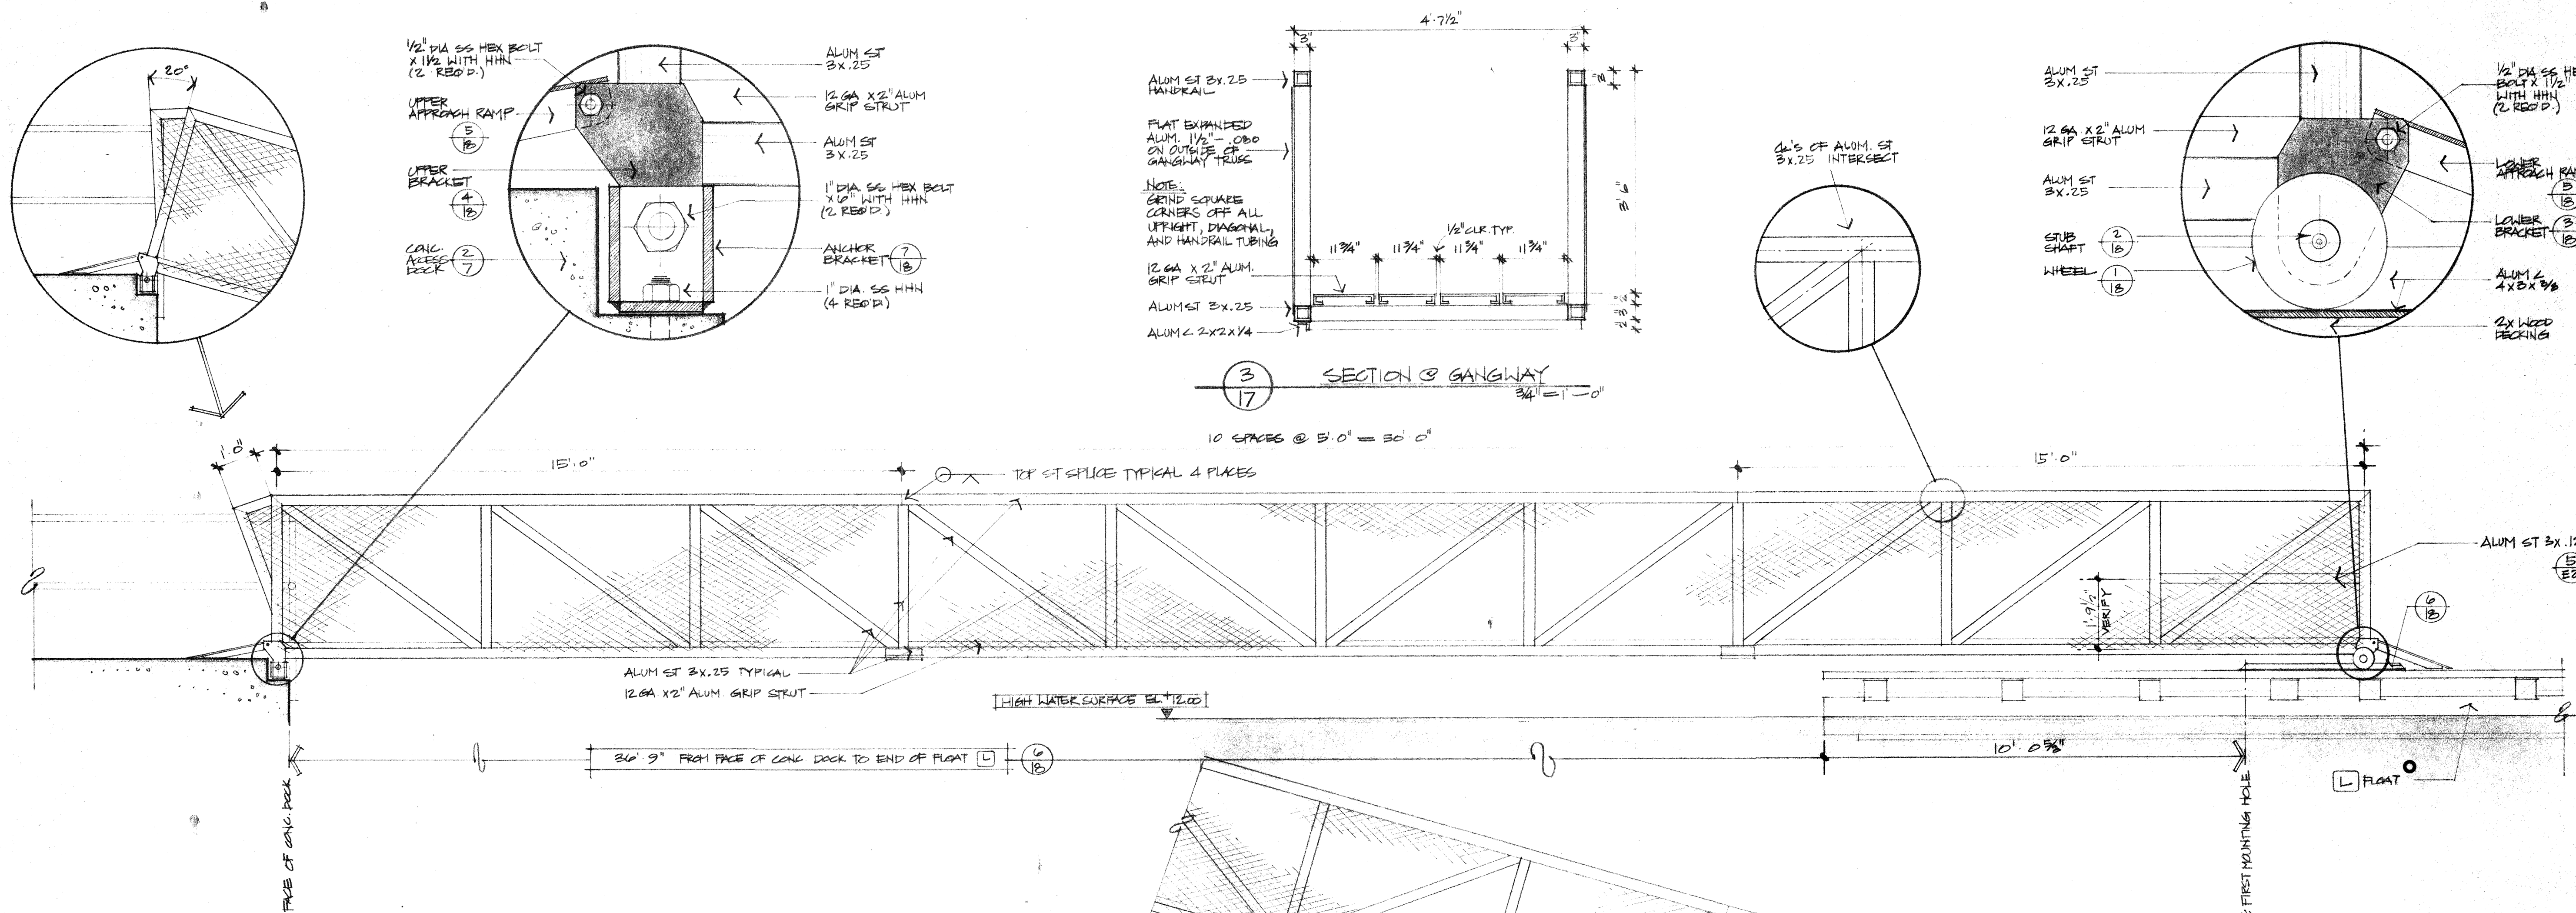

17 GANGWAY ELEVATION 1/2" = 1'-0"

17 GANGWAY REFLECTED PLAN 1/2" = 1'-0"

0 - DETAILS FURNISHED BY OWNER

RECORD DRAWG. 1/35/12 K

EDA PROJECT NO. 07-01-02549


HCE INC./ENGINEERS & PLANNERS
 Coos Bay, Oregon / 375 Park Avenue 97420 / (503) 269-1166
 Corvallis, Oregon / 19 W. 5th Ave. 97331 / (503) 325-0067
 Albany, Oregon / 300 Ellsworth St. So. 97101 / (503) 926-0064




SHEET TITLE
 PROJECT PORT OF Bandon
 COQUILLE RIVER BOAT BASIN
 COOS COUNTY, OREGON
 GANGWAY PLAN,
 ELEVATION AND DETAILS


PROJECT #
 2071
 DATE
 JULY, 1992

SHEET NO.
 17

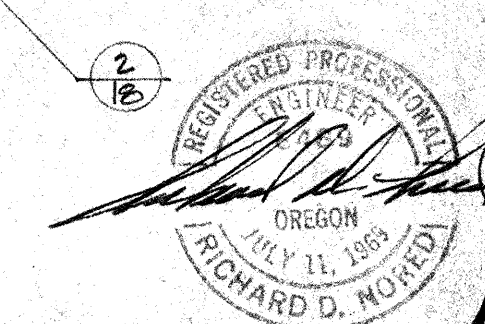


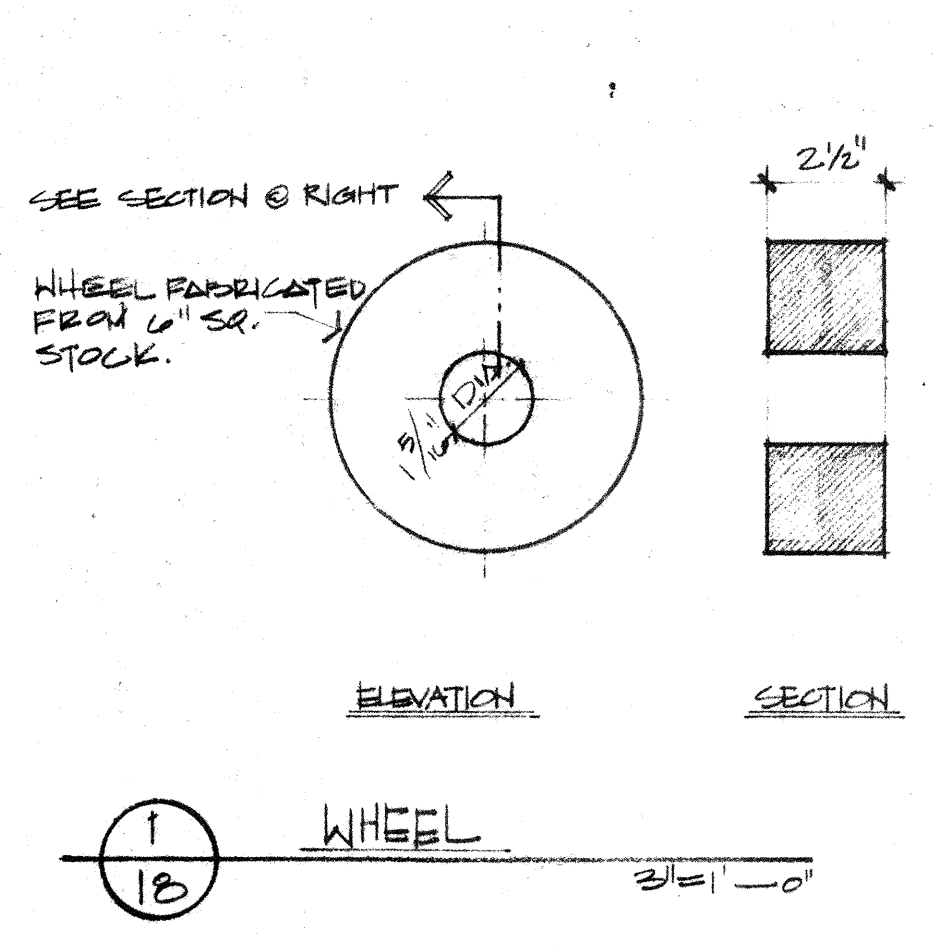


1 WHEEL

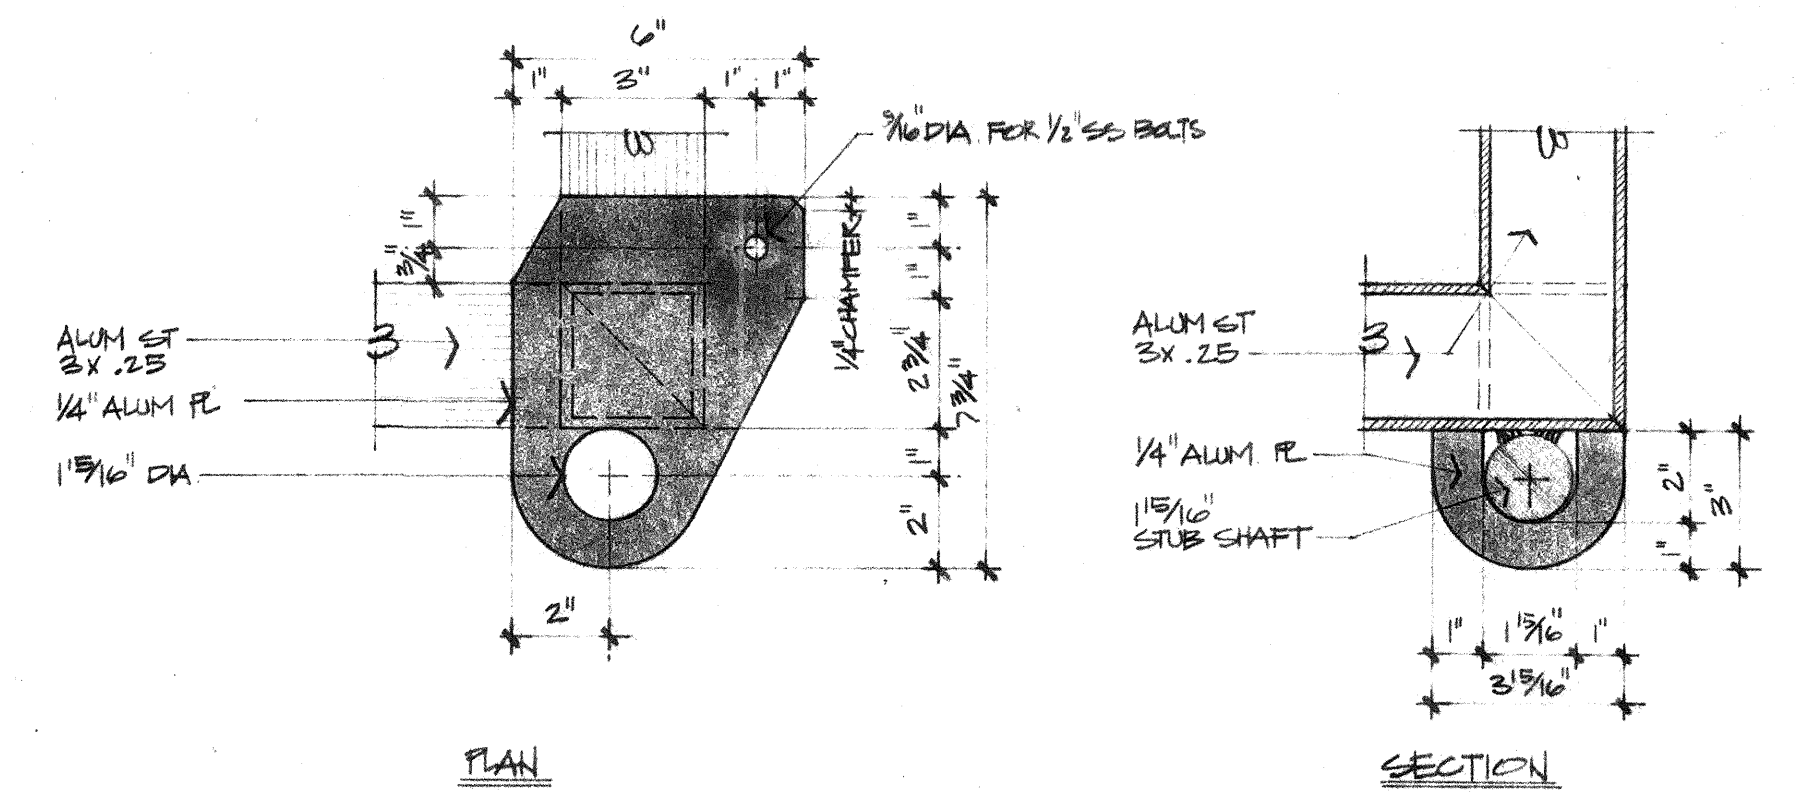

3 LOWER BRACKET DETAIL

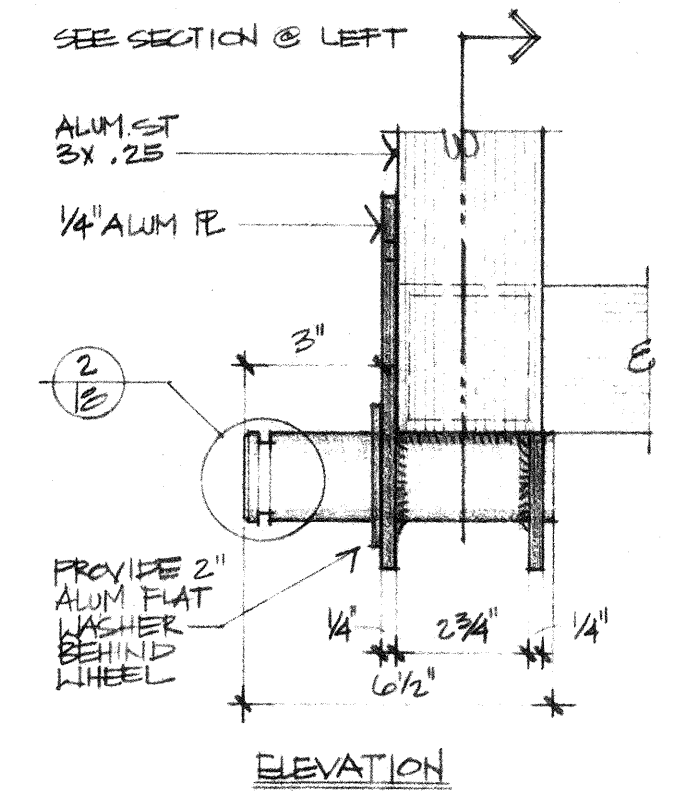


ELEVATION

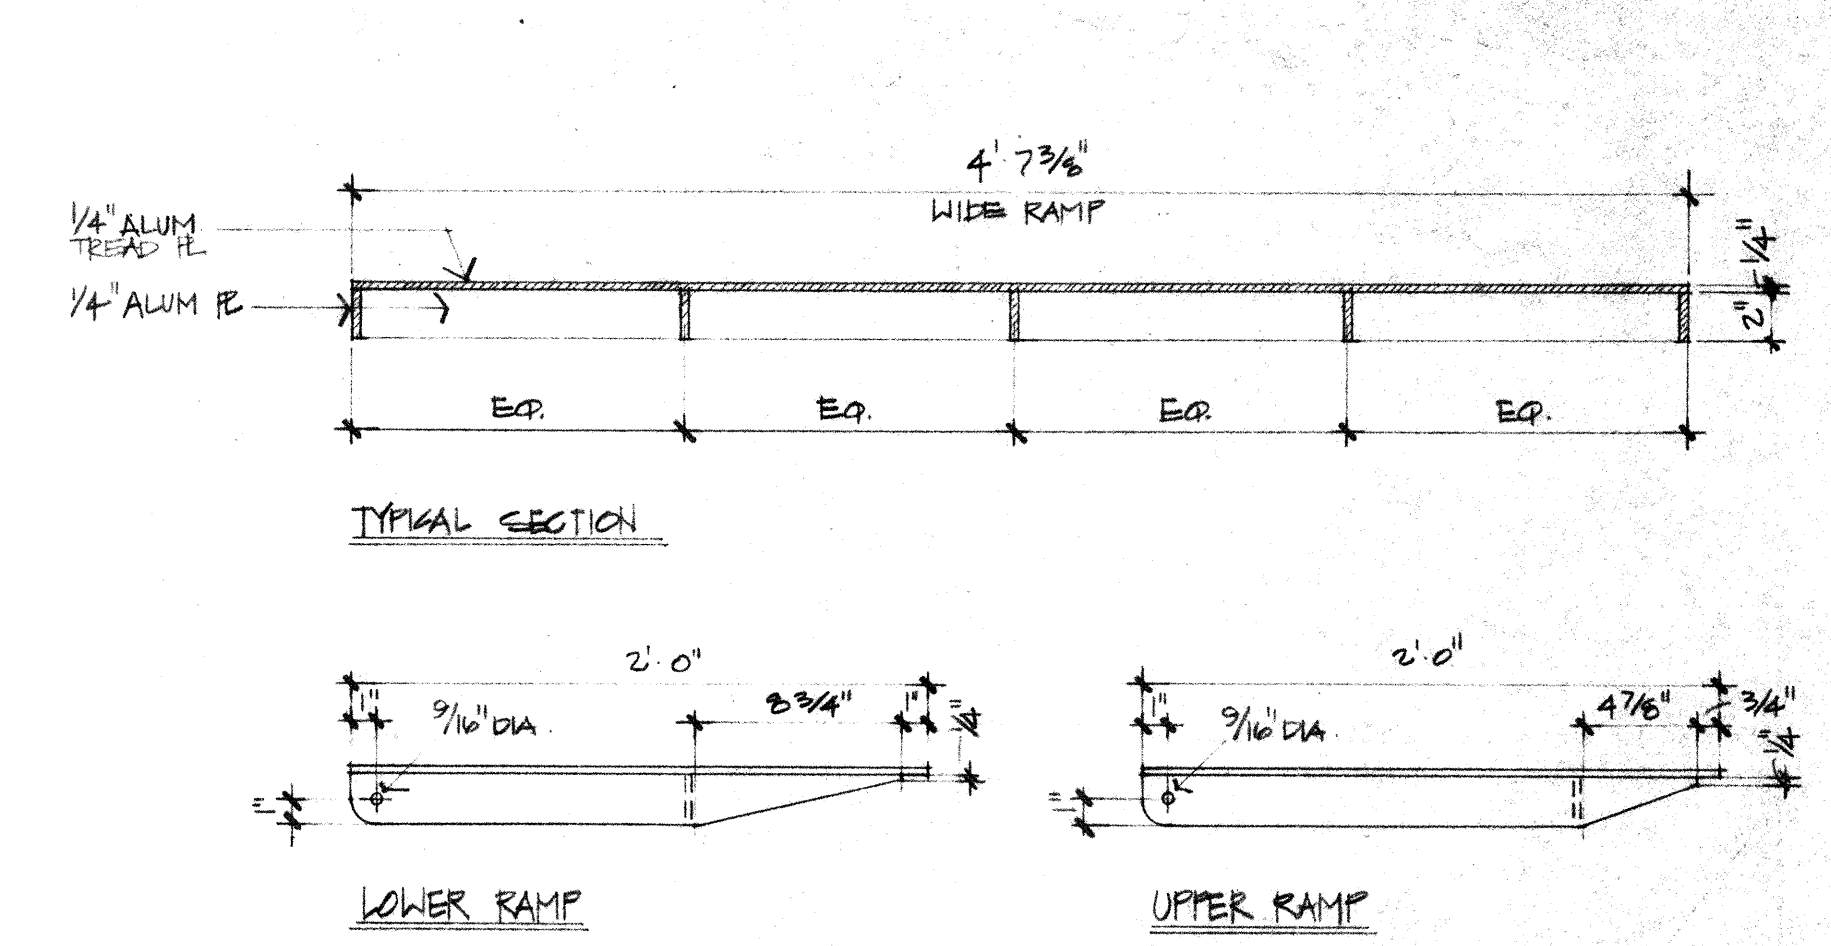


LOWER RAMP UPPER RAMP


5 APPROACH RAMP

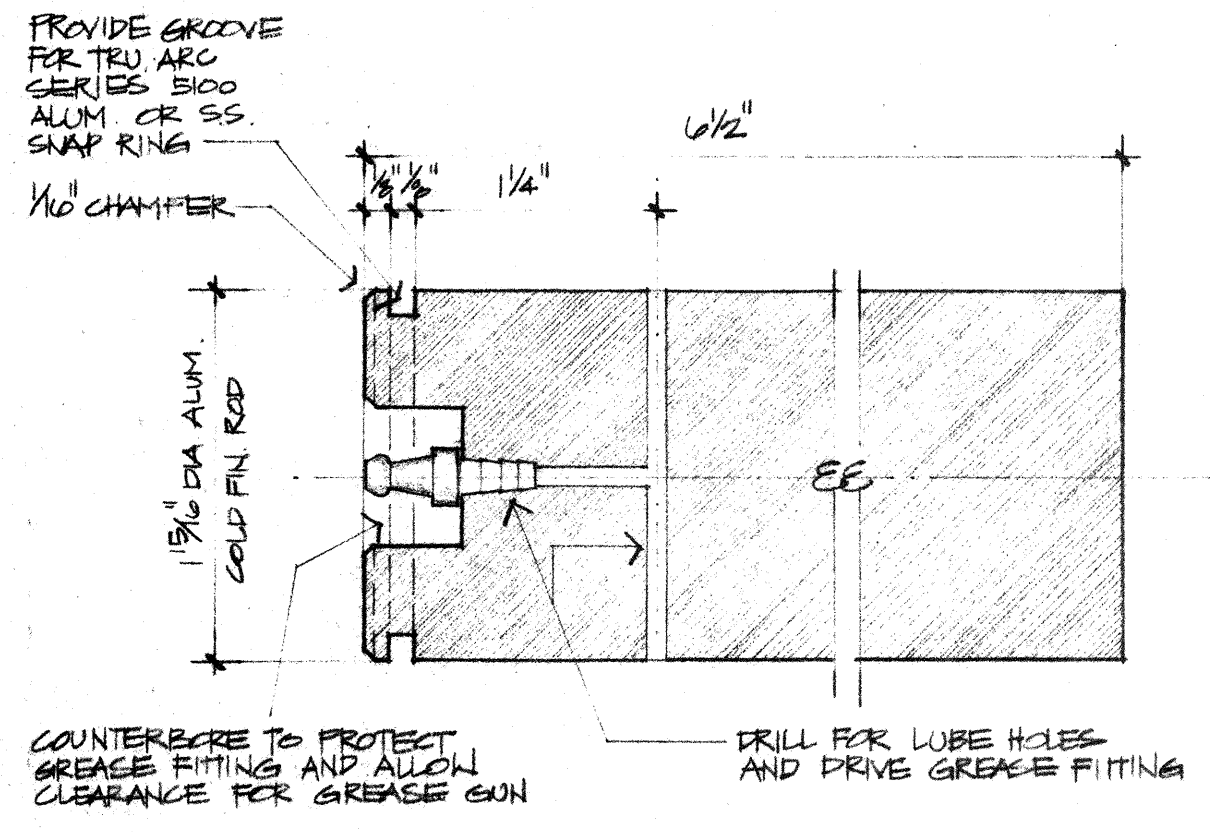


2 SECTION @ STUB SHAFT

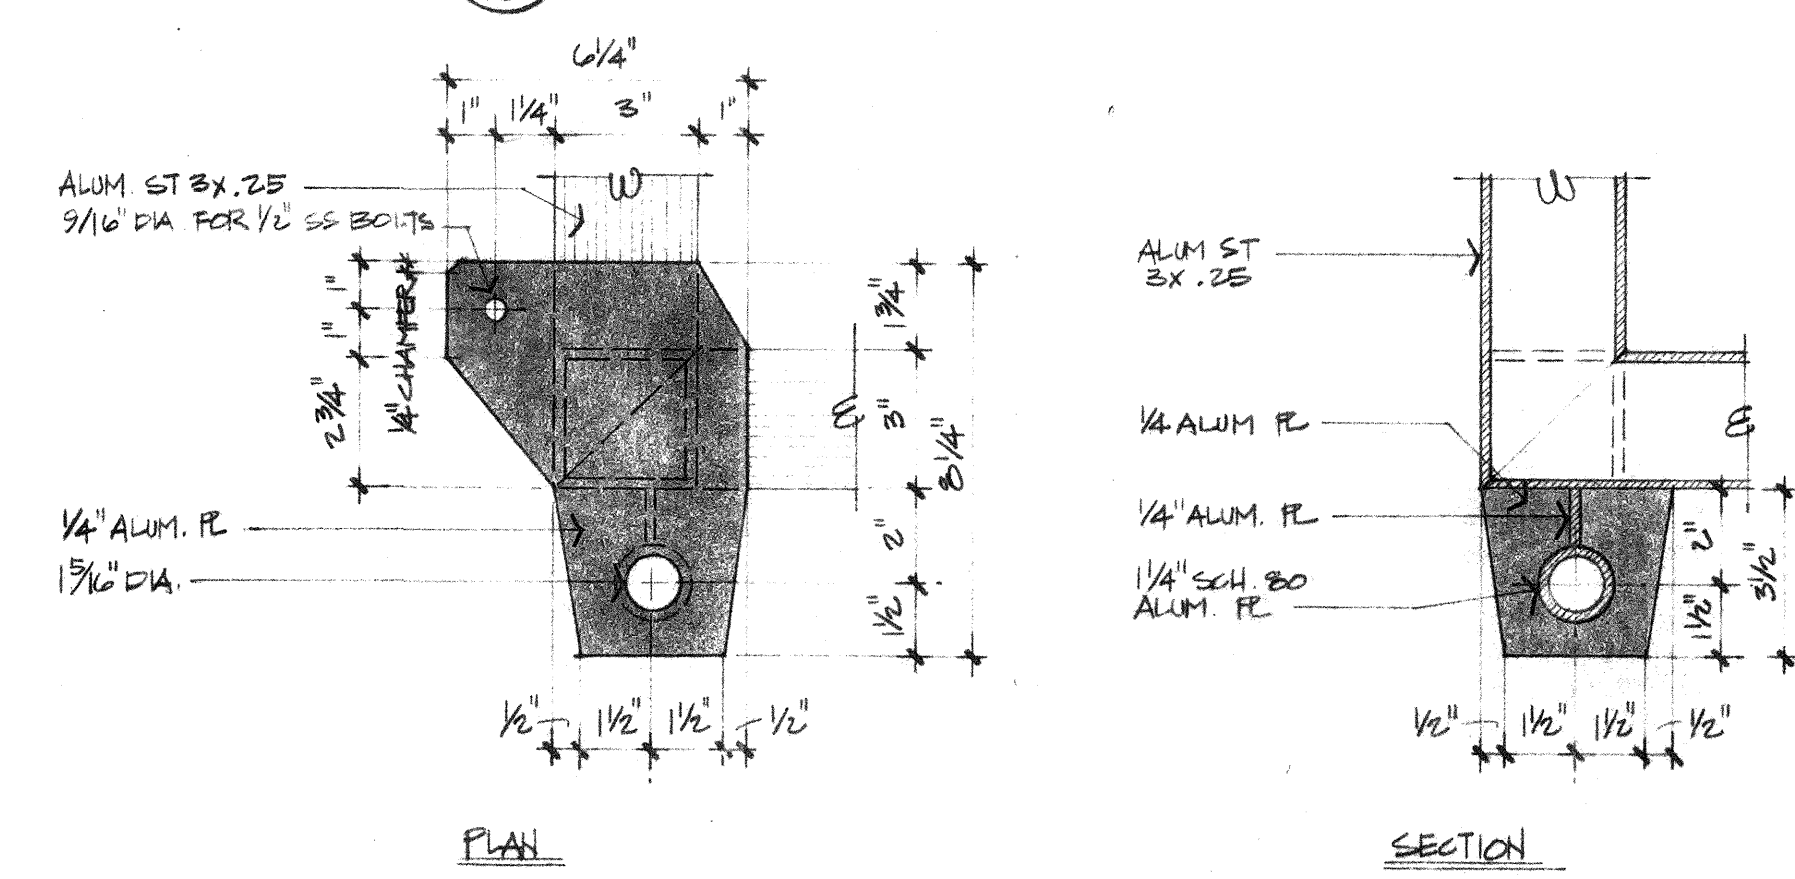


4 UPPER BRACKET DETAIL

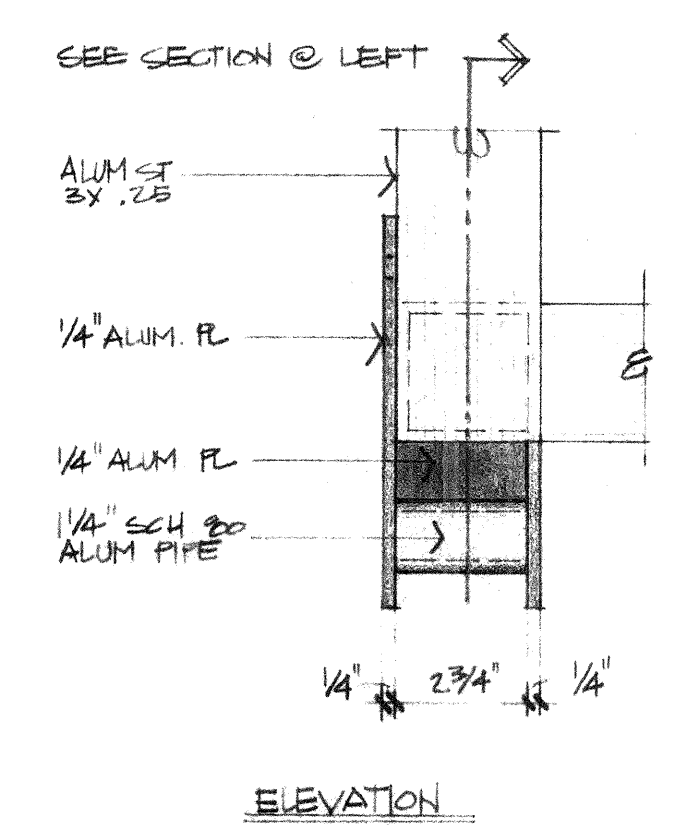


ELEVATION

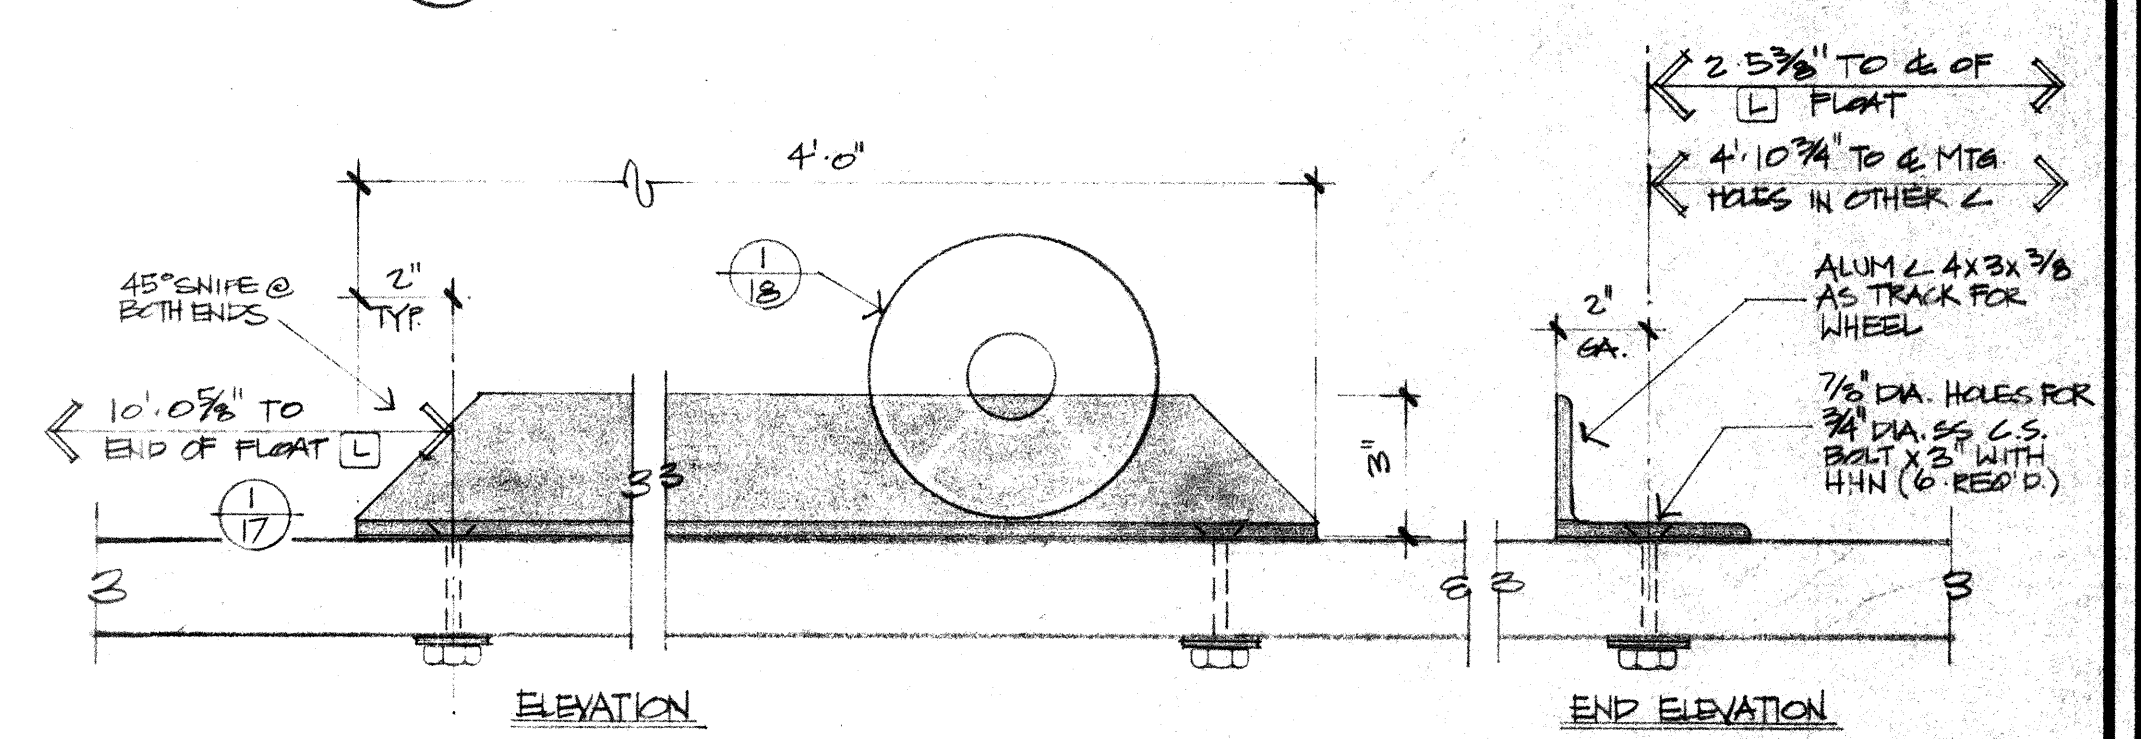


6 WHEEL TRACK

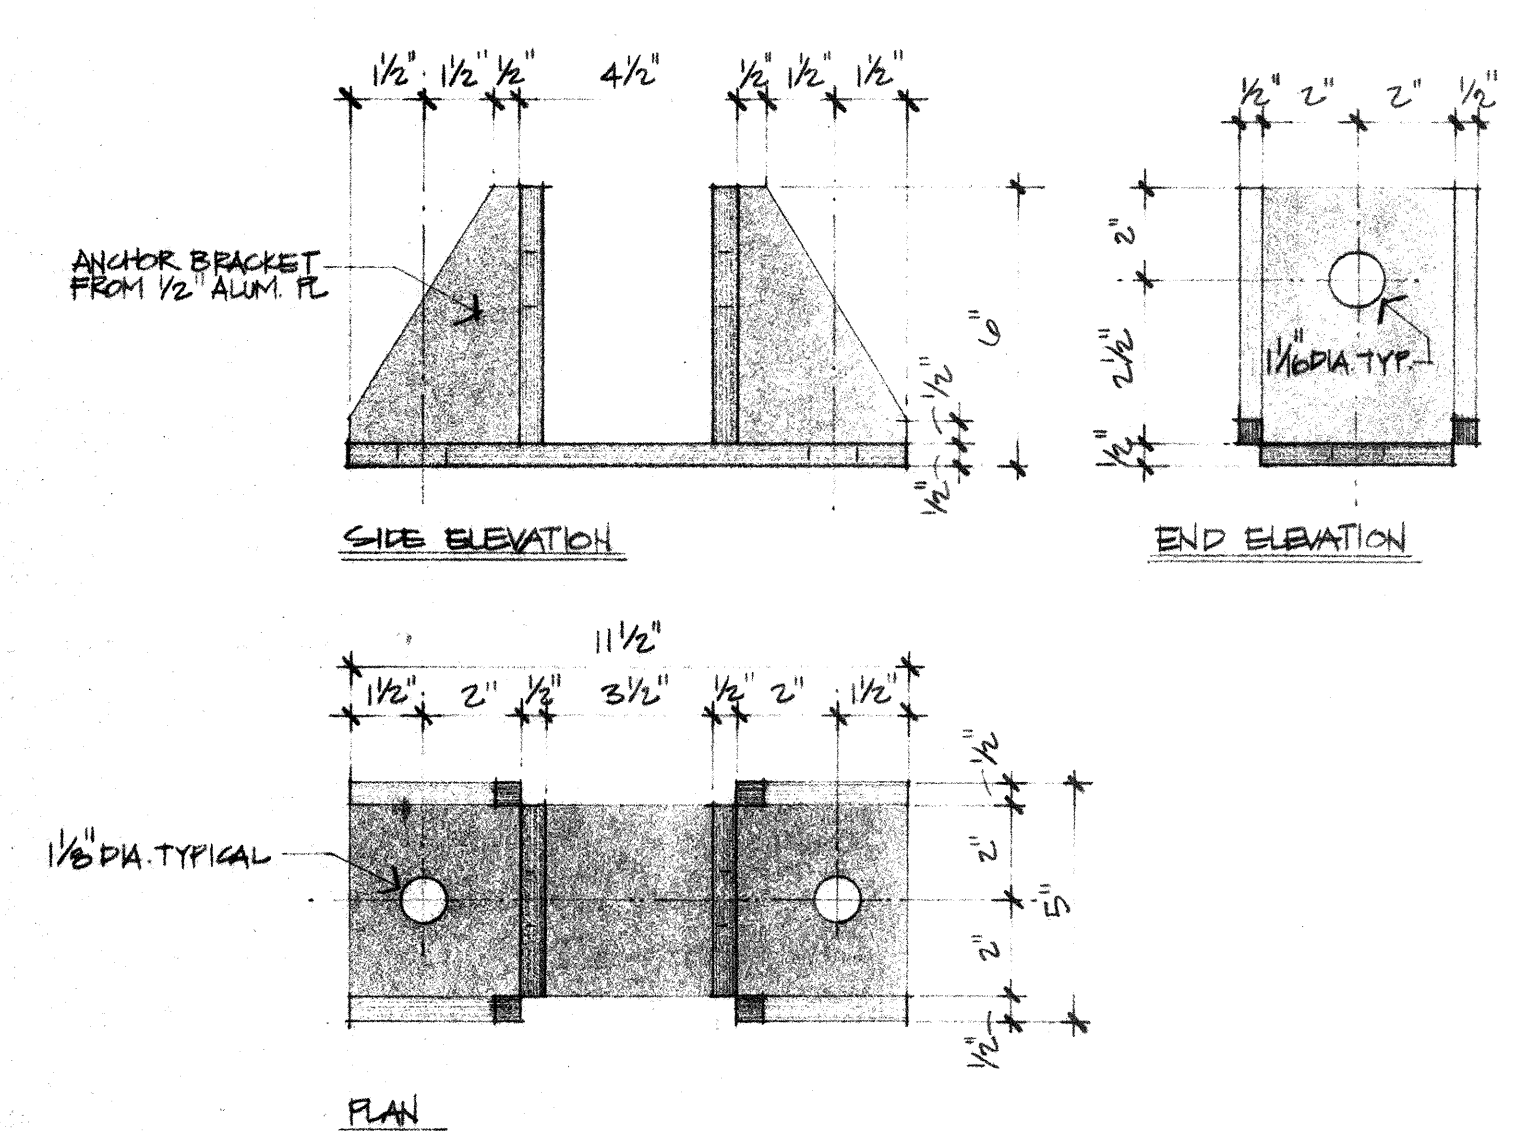

7 ANCHOR BRACKET

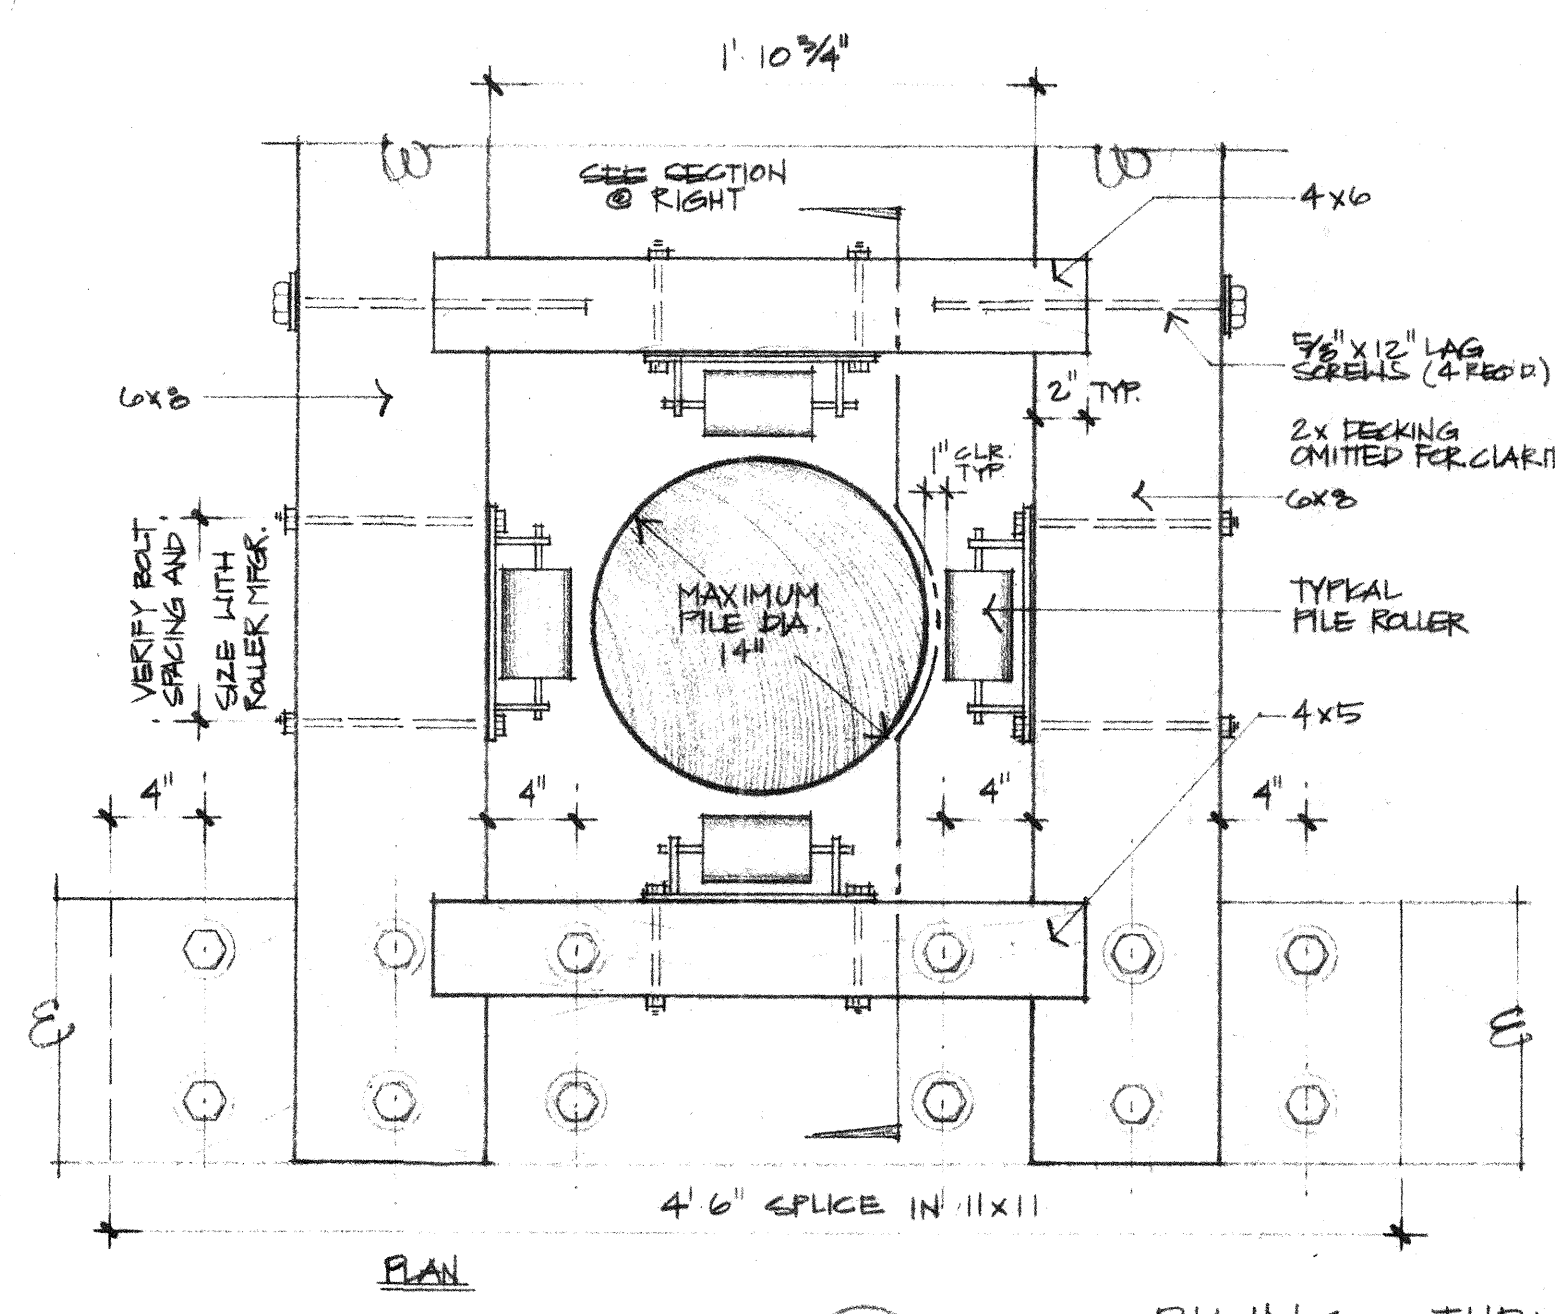

8 PILING THRU FLOAT

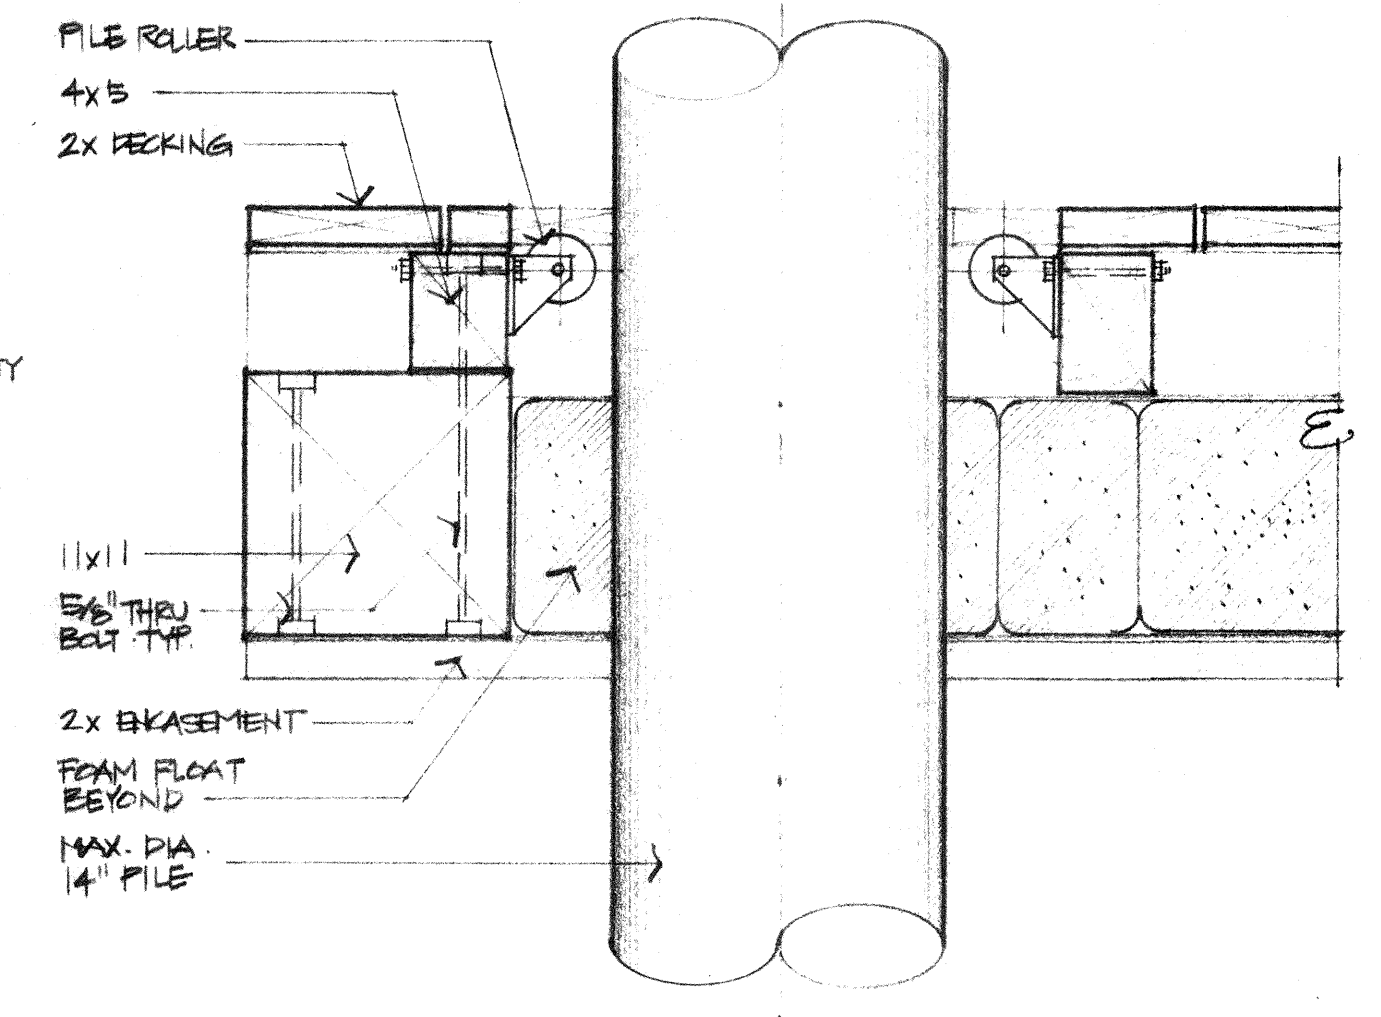

SECTION

HCE INC./ENGINEERS & PLANNERS
 375 Park Avenue 97220 / (503) 265-1188
 Coos Bay, Oregon 19 N. W. 5th Ave. 97208 / (503) 522-0887
 Albany, Oregon / 300 Ellsworth St. Se. 97321 / (503) 926-0864




GANGWAY DETAILS

SHEET TITLE

PROJECT PORT OF BAYDON
 LOGOLLE RIVER BOAT BASIN
 COOS COUNTY, OREGON


PROJECT # 2071
 DATE JULY, 1982

SHEET NO. 18

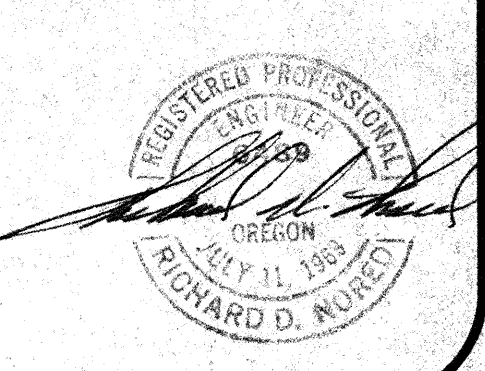


RECORD DRWG. 1/33 R.K.

EDA PROJECT NO. 07-01-02549

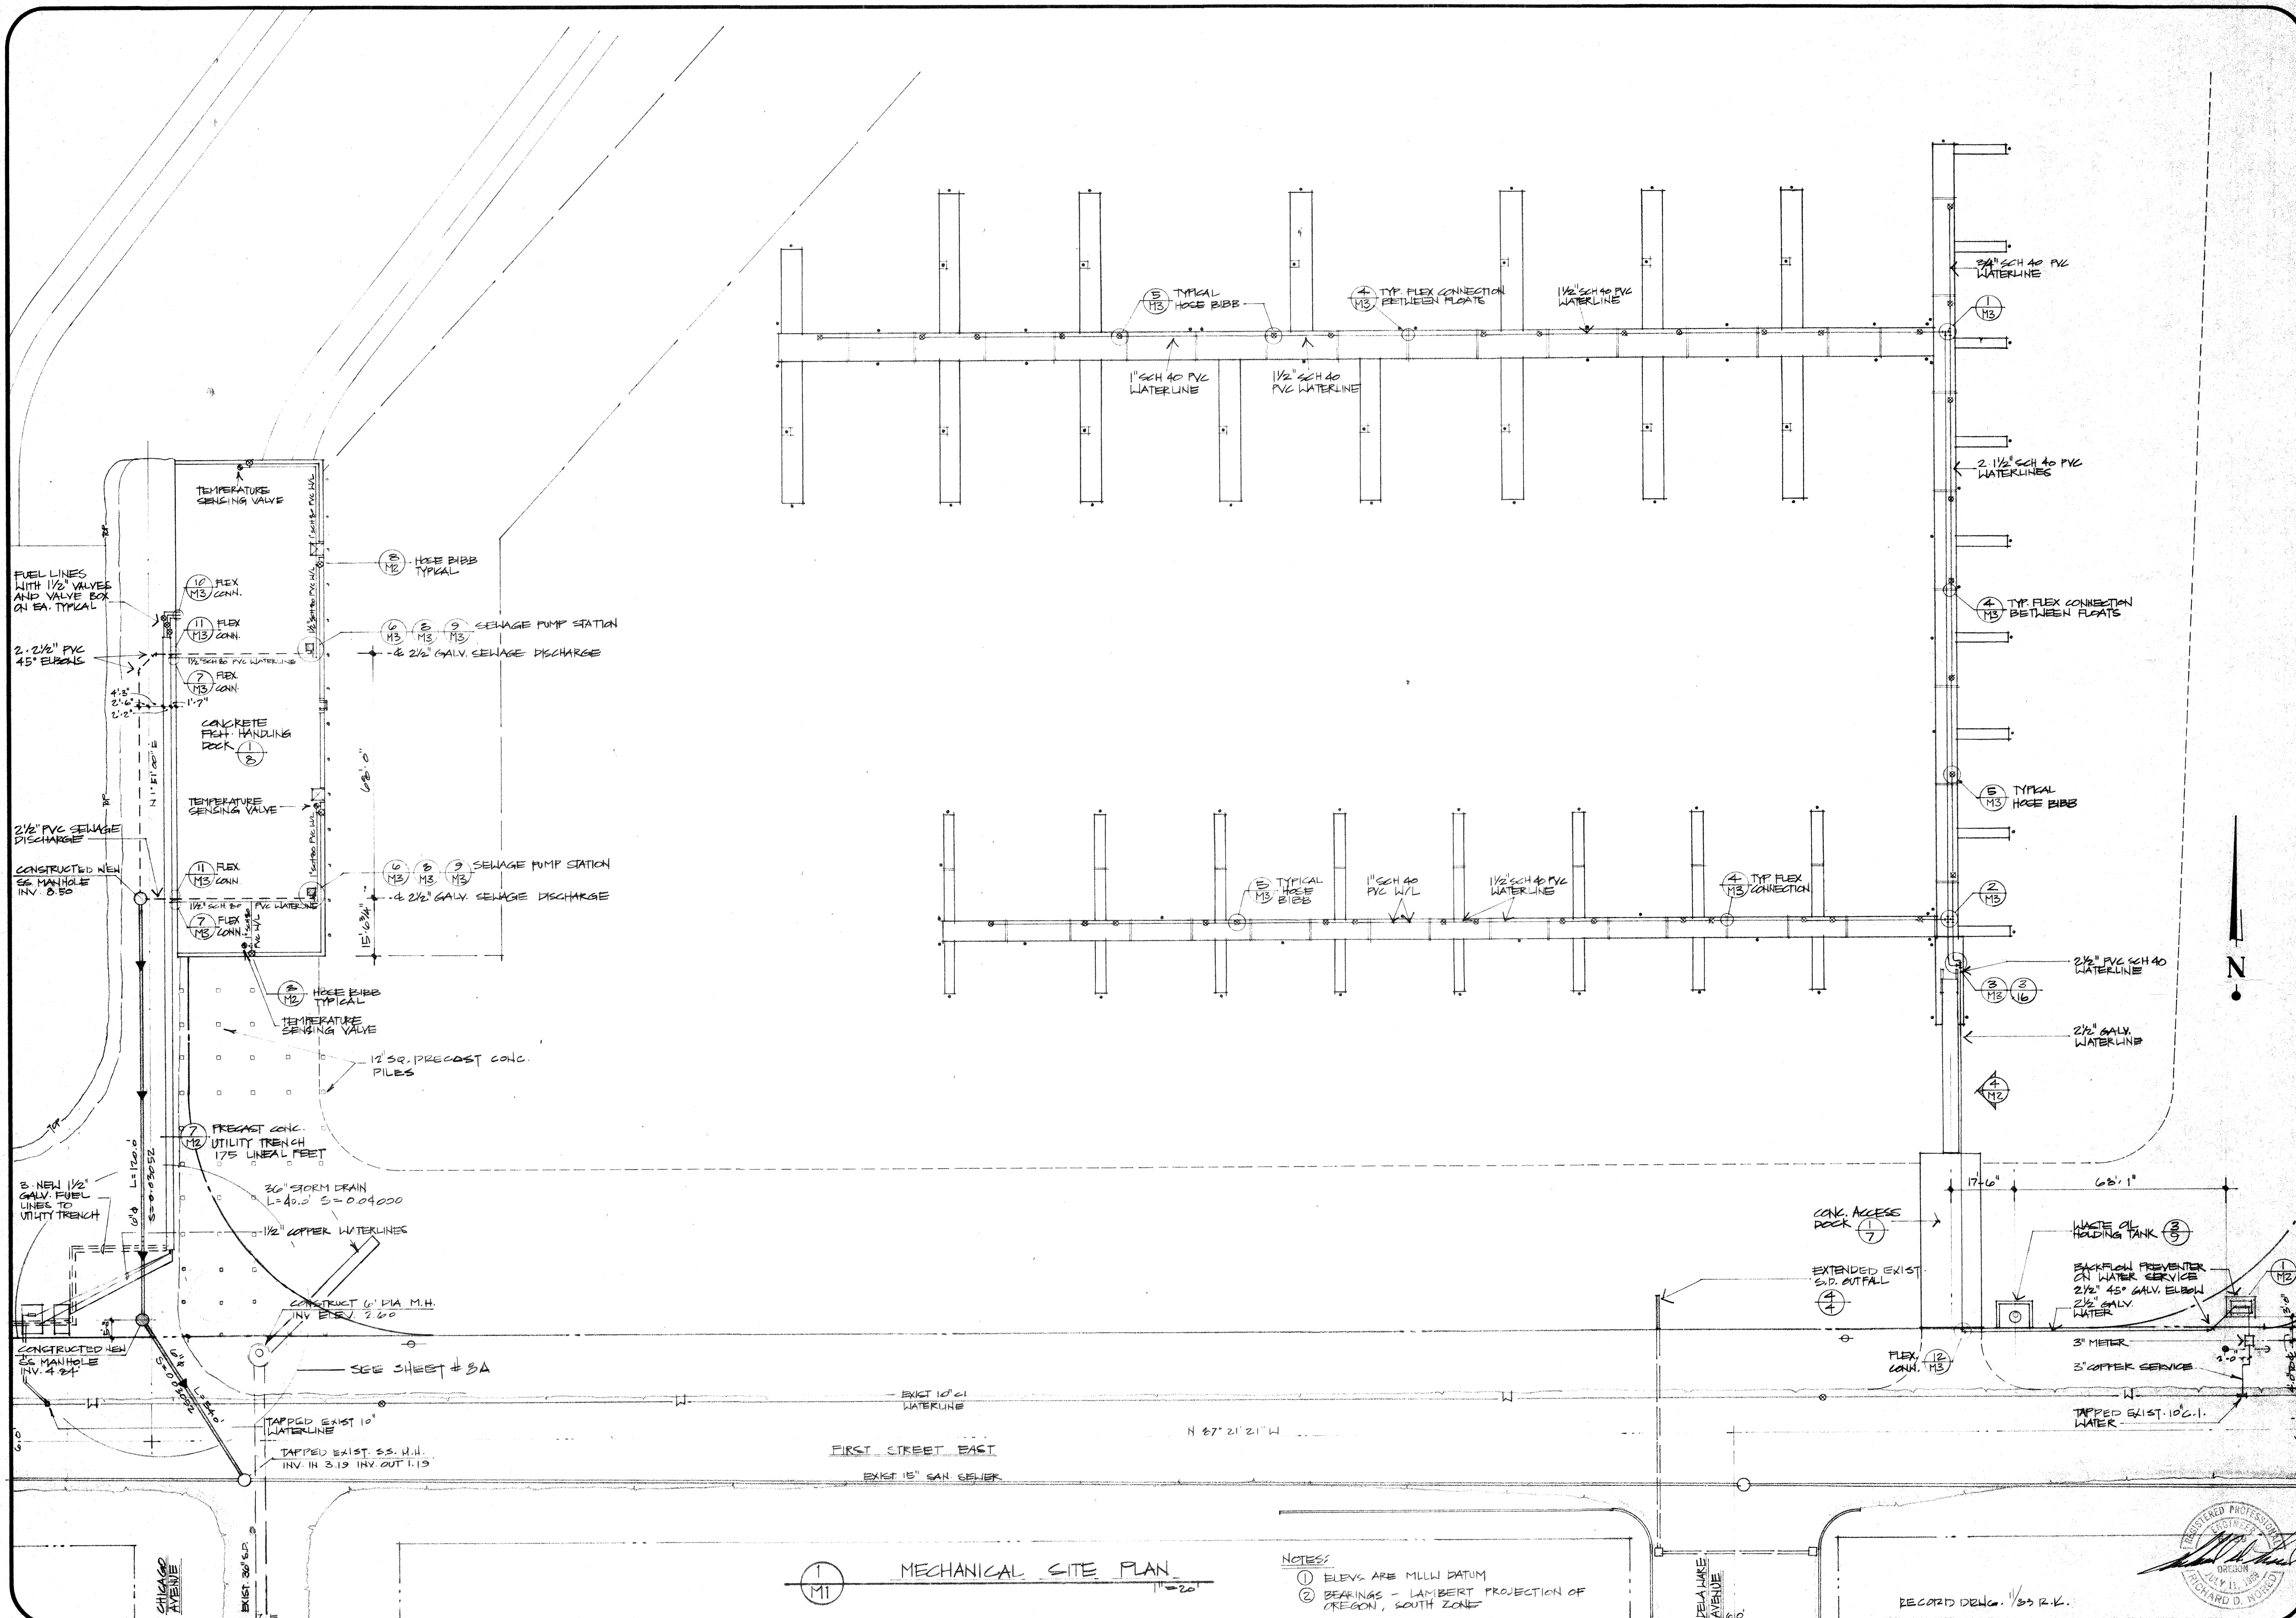

MECHANICAL SITE PLAN

- NOTES:
- ① ELEV. ARE MLLW DATUM
 - ② BEARINGS - LAMBERT PROJECTION OF OREGON, SOUTH ZONE

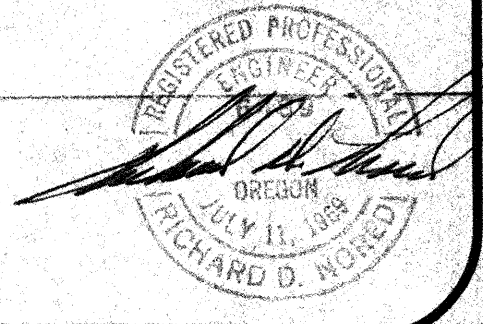

PROJECT PORT OF BANDON
CORVALLIS RIVER BOAT BASIN
CLATSOP COUNTY

SHEET NO. **M1**

PROJECT # 2071
DATE JULY, 1992










SHEET TITLE
MECHANICAL SITE PLAN

HCE INC./ENGINEERS & PLANNERS
Coos Bay, Oregon / 375 Park Avenue 97420 / (503) 269-1166
Portland, Oregon / 19 N. W. 5th Ave. 97209 / (503) 222-1687
Albany, Oregon / 300 Ellsworth St. So. 97321 / (503) 926-0084

HCE
INC.

REGISTERED PROFESSIONAL ENGINEER
STATE OF OREGON
JULY 11, 1998
RICHARD D. NOTLEY

RECORD DENG. 1/83 R.V.

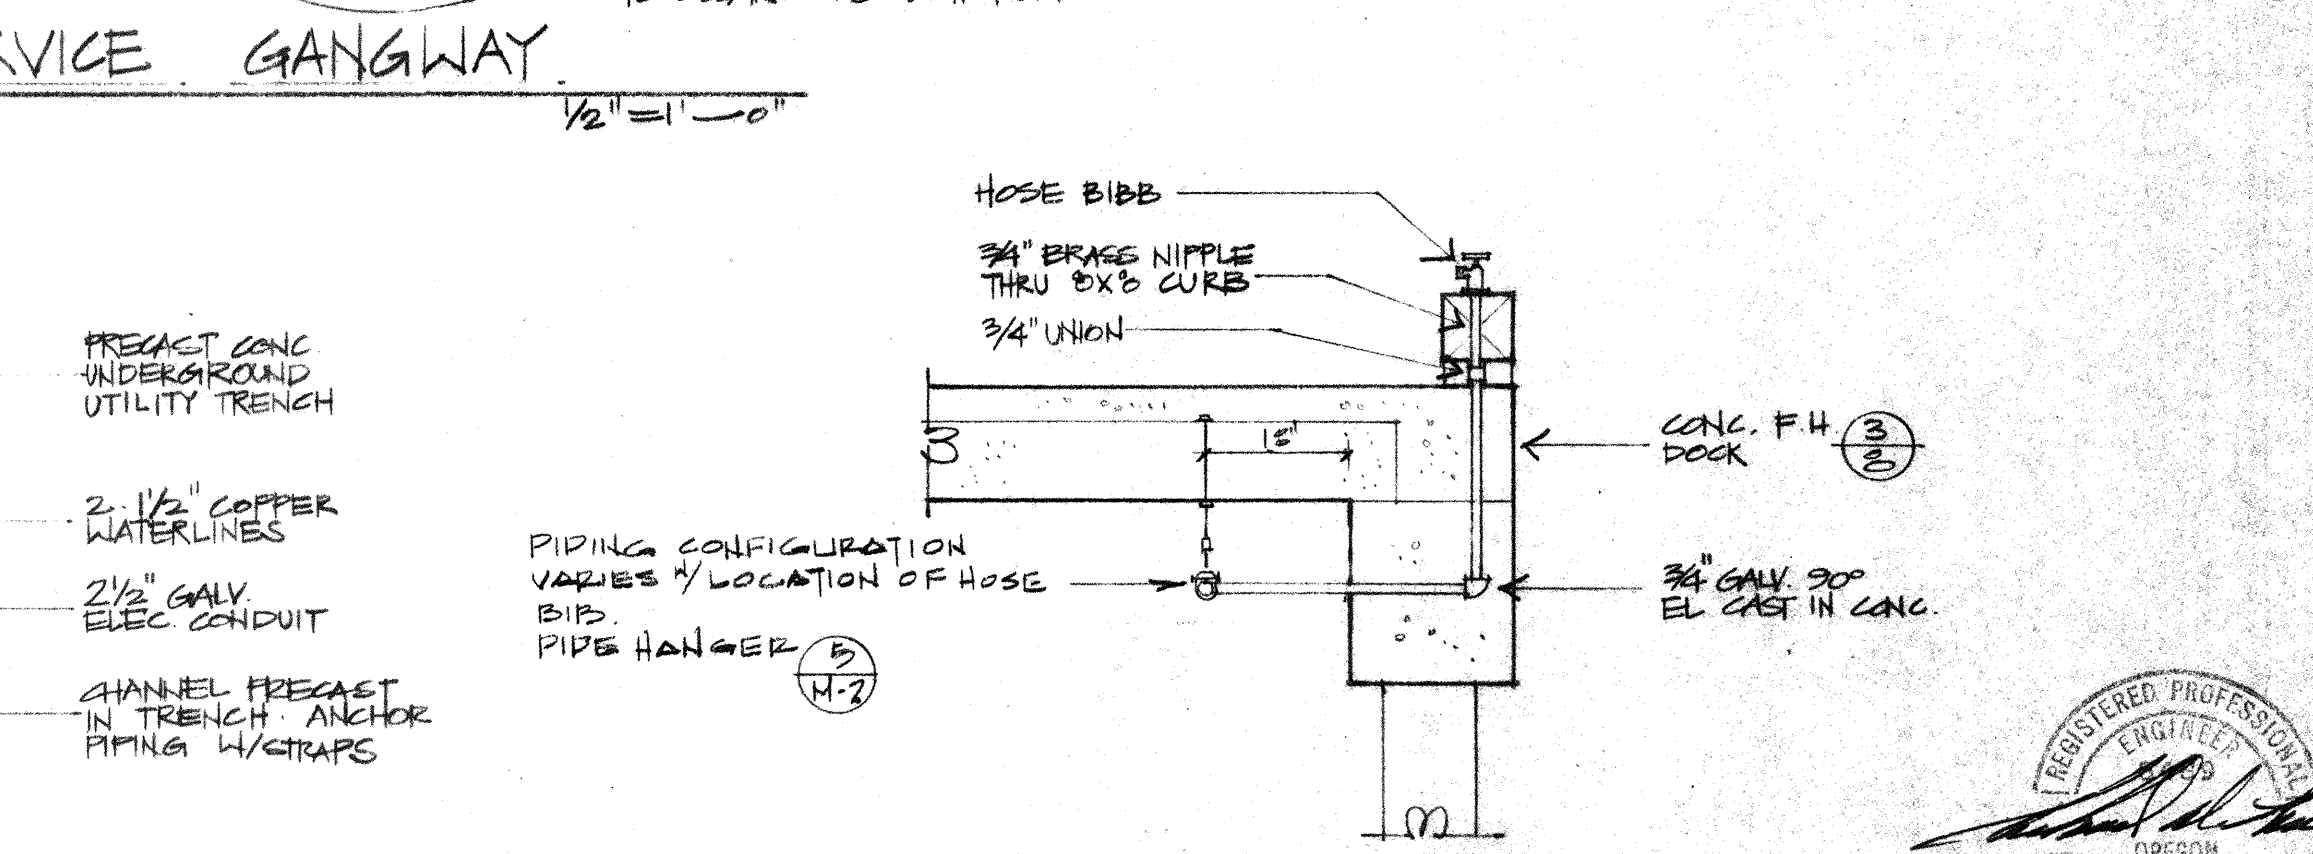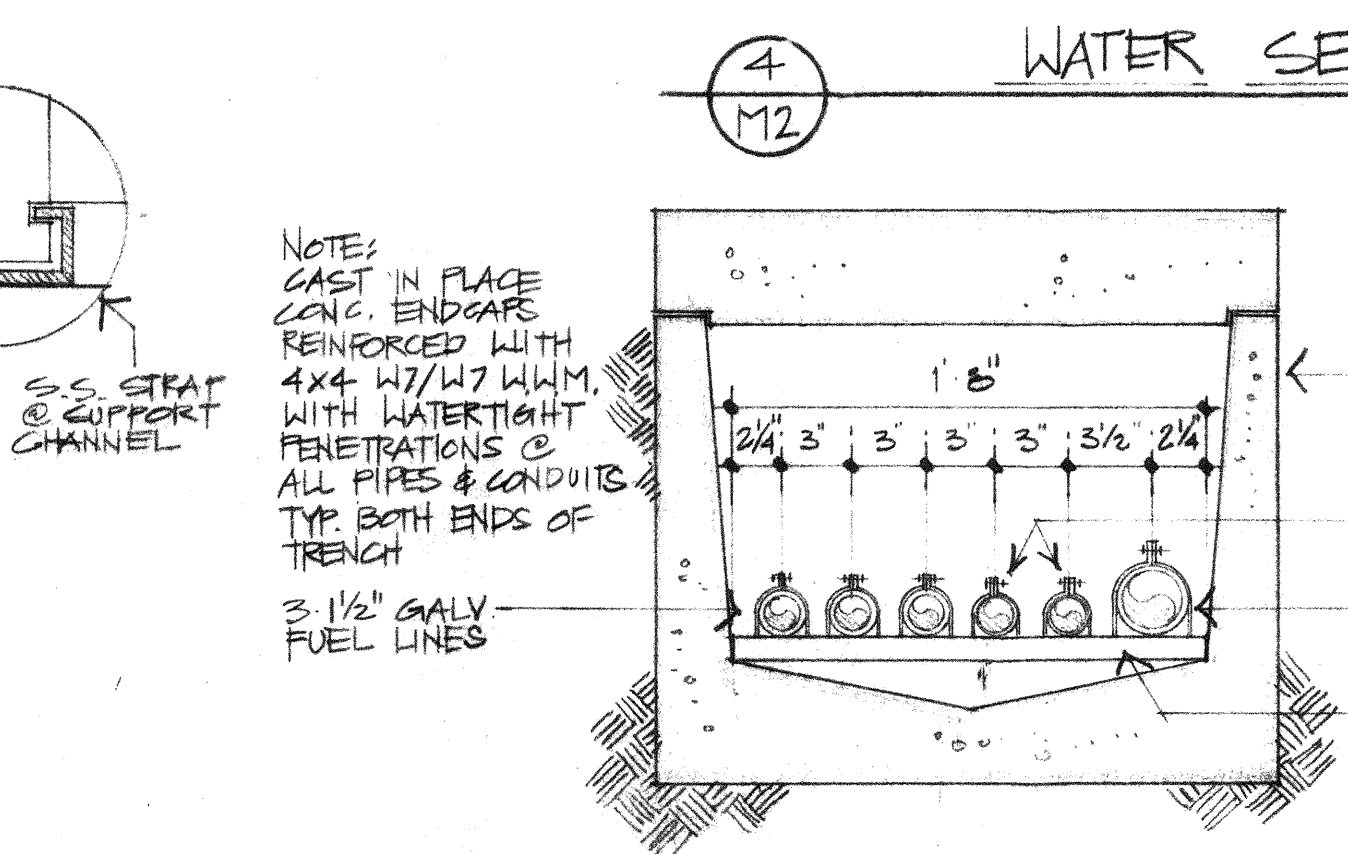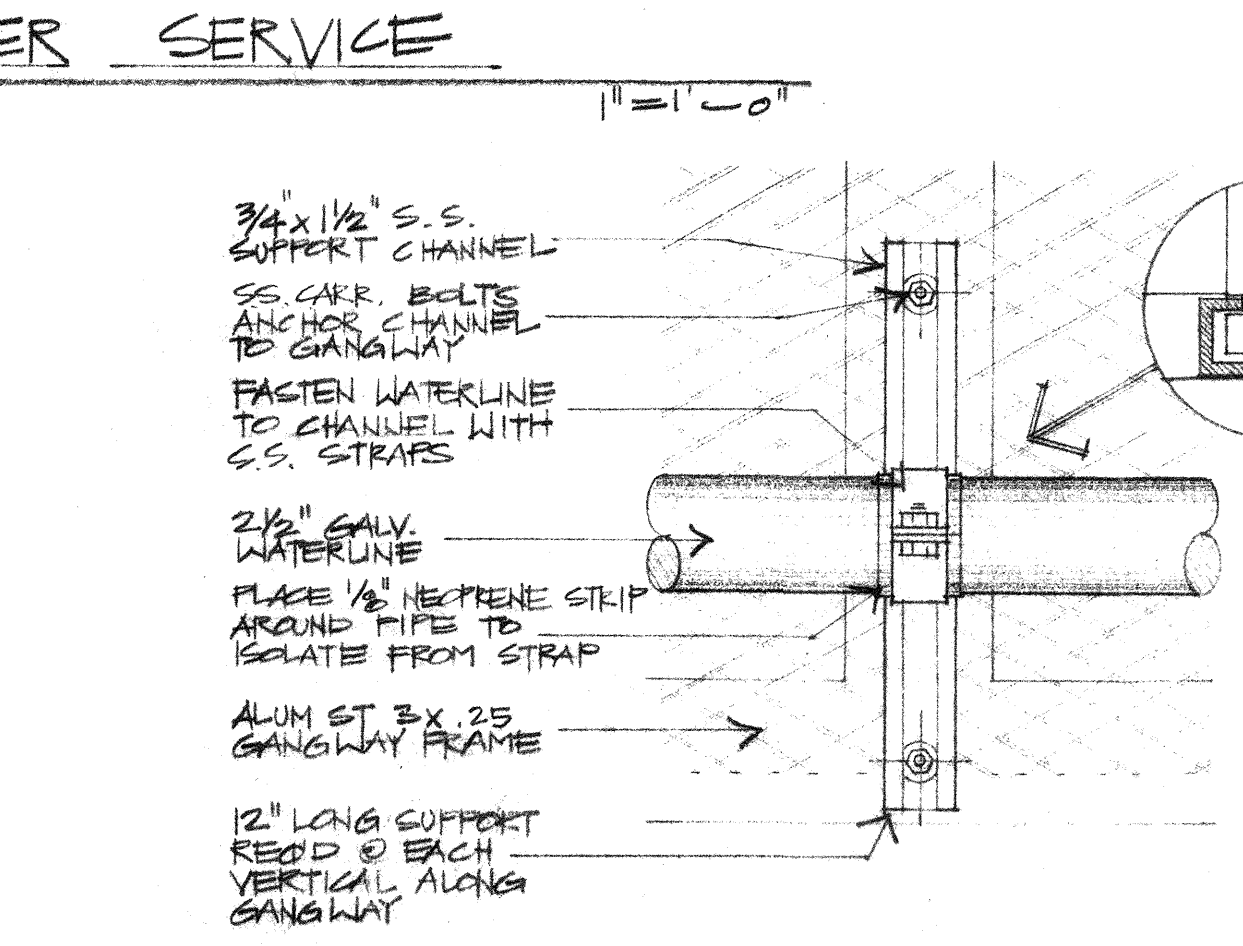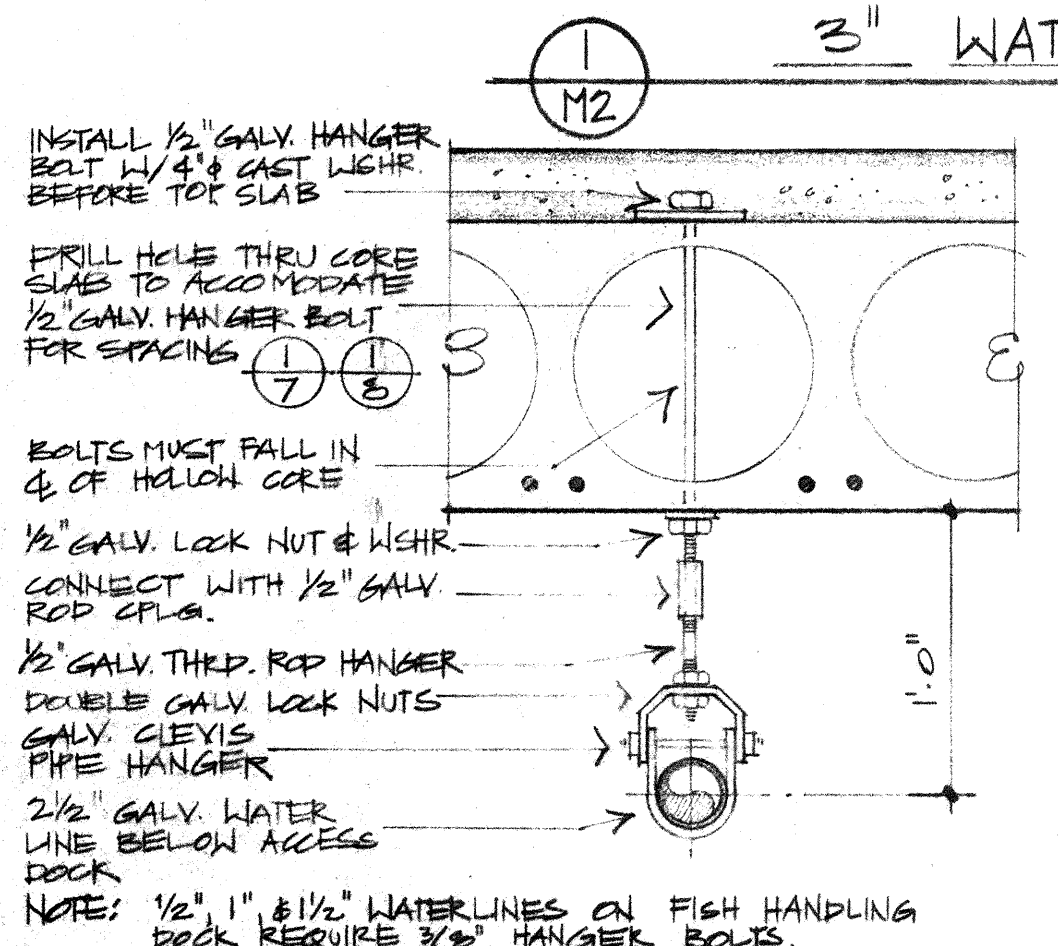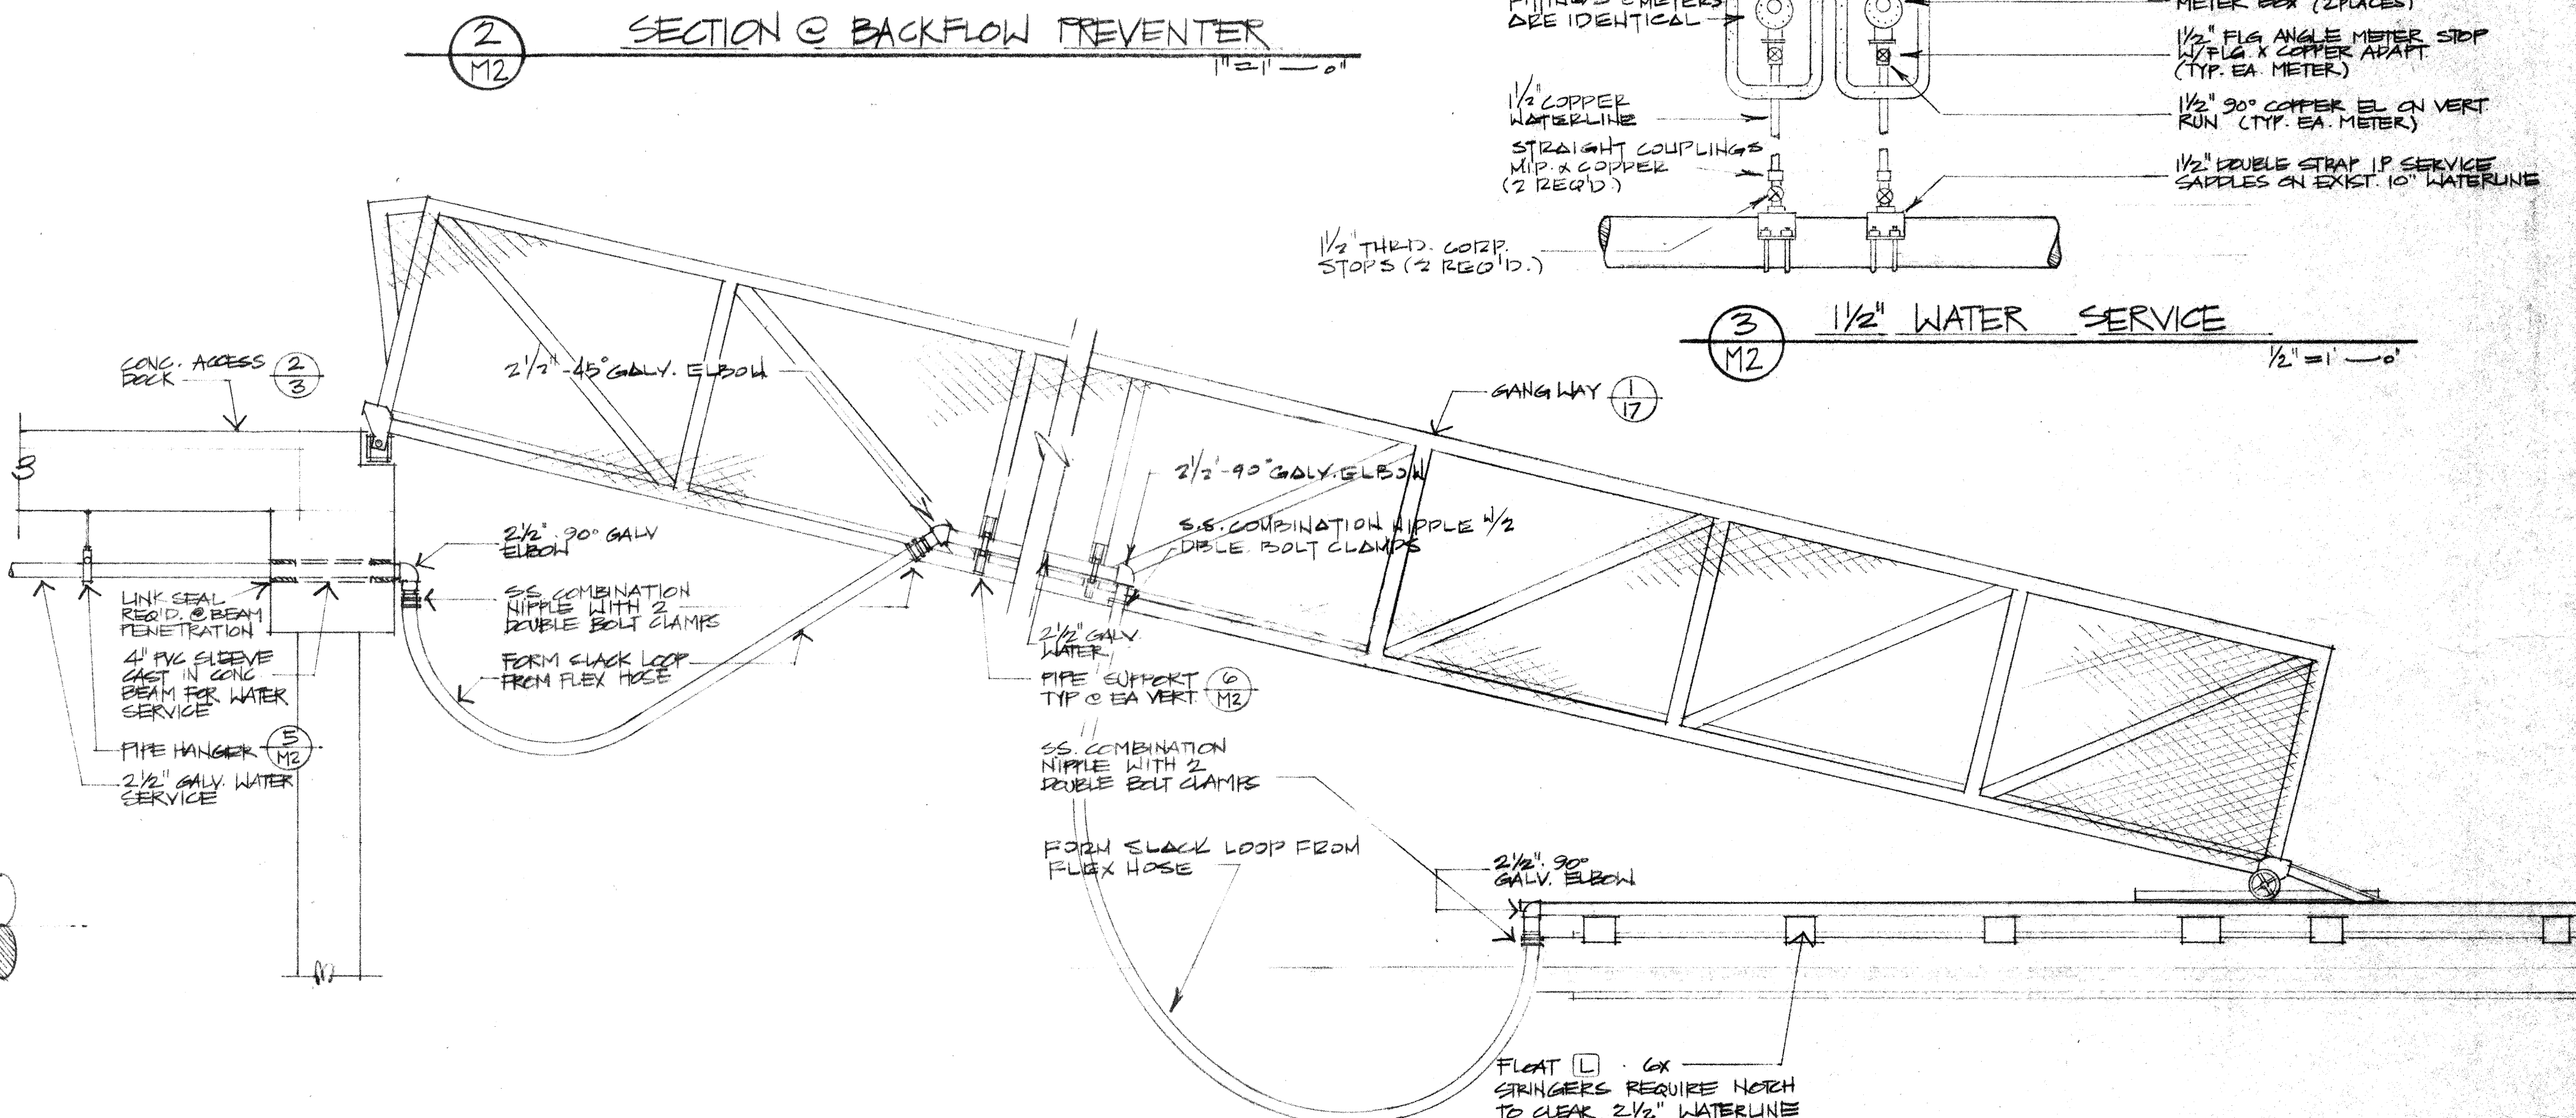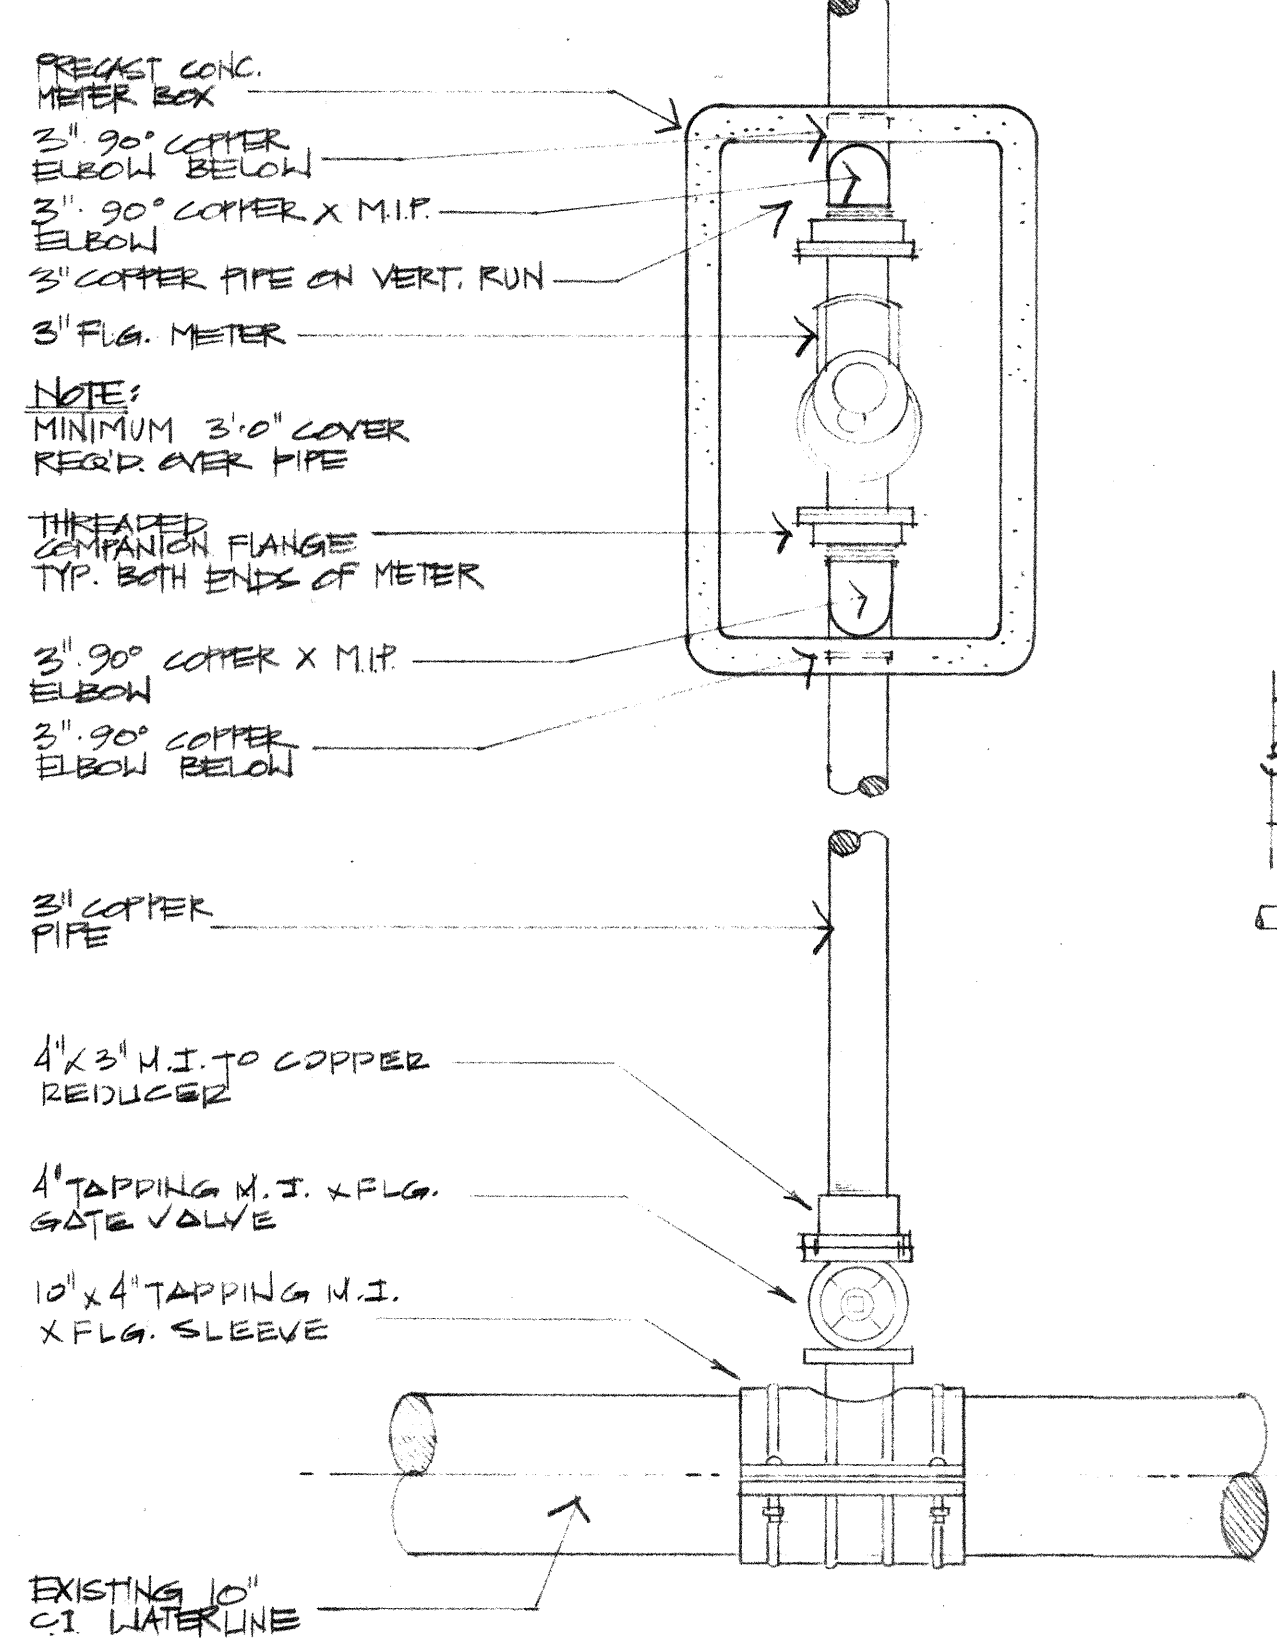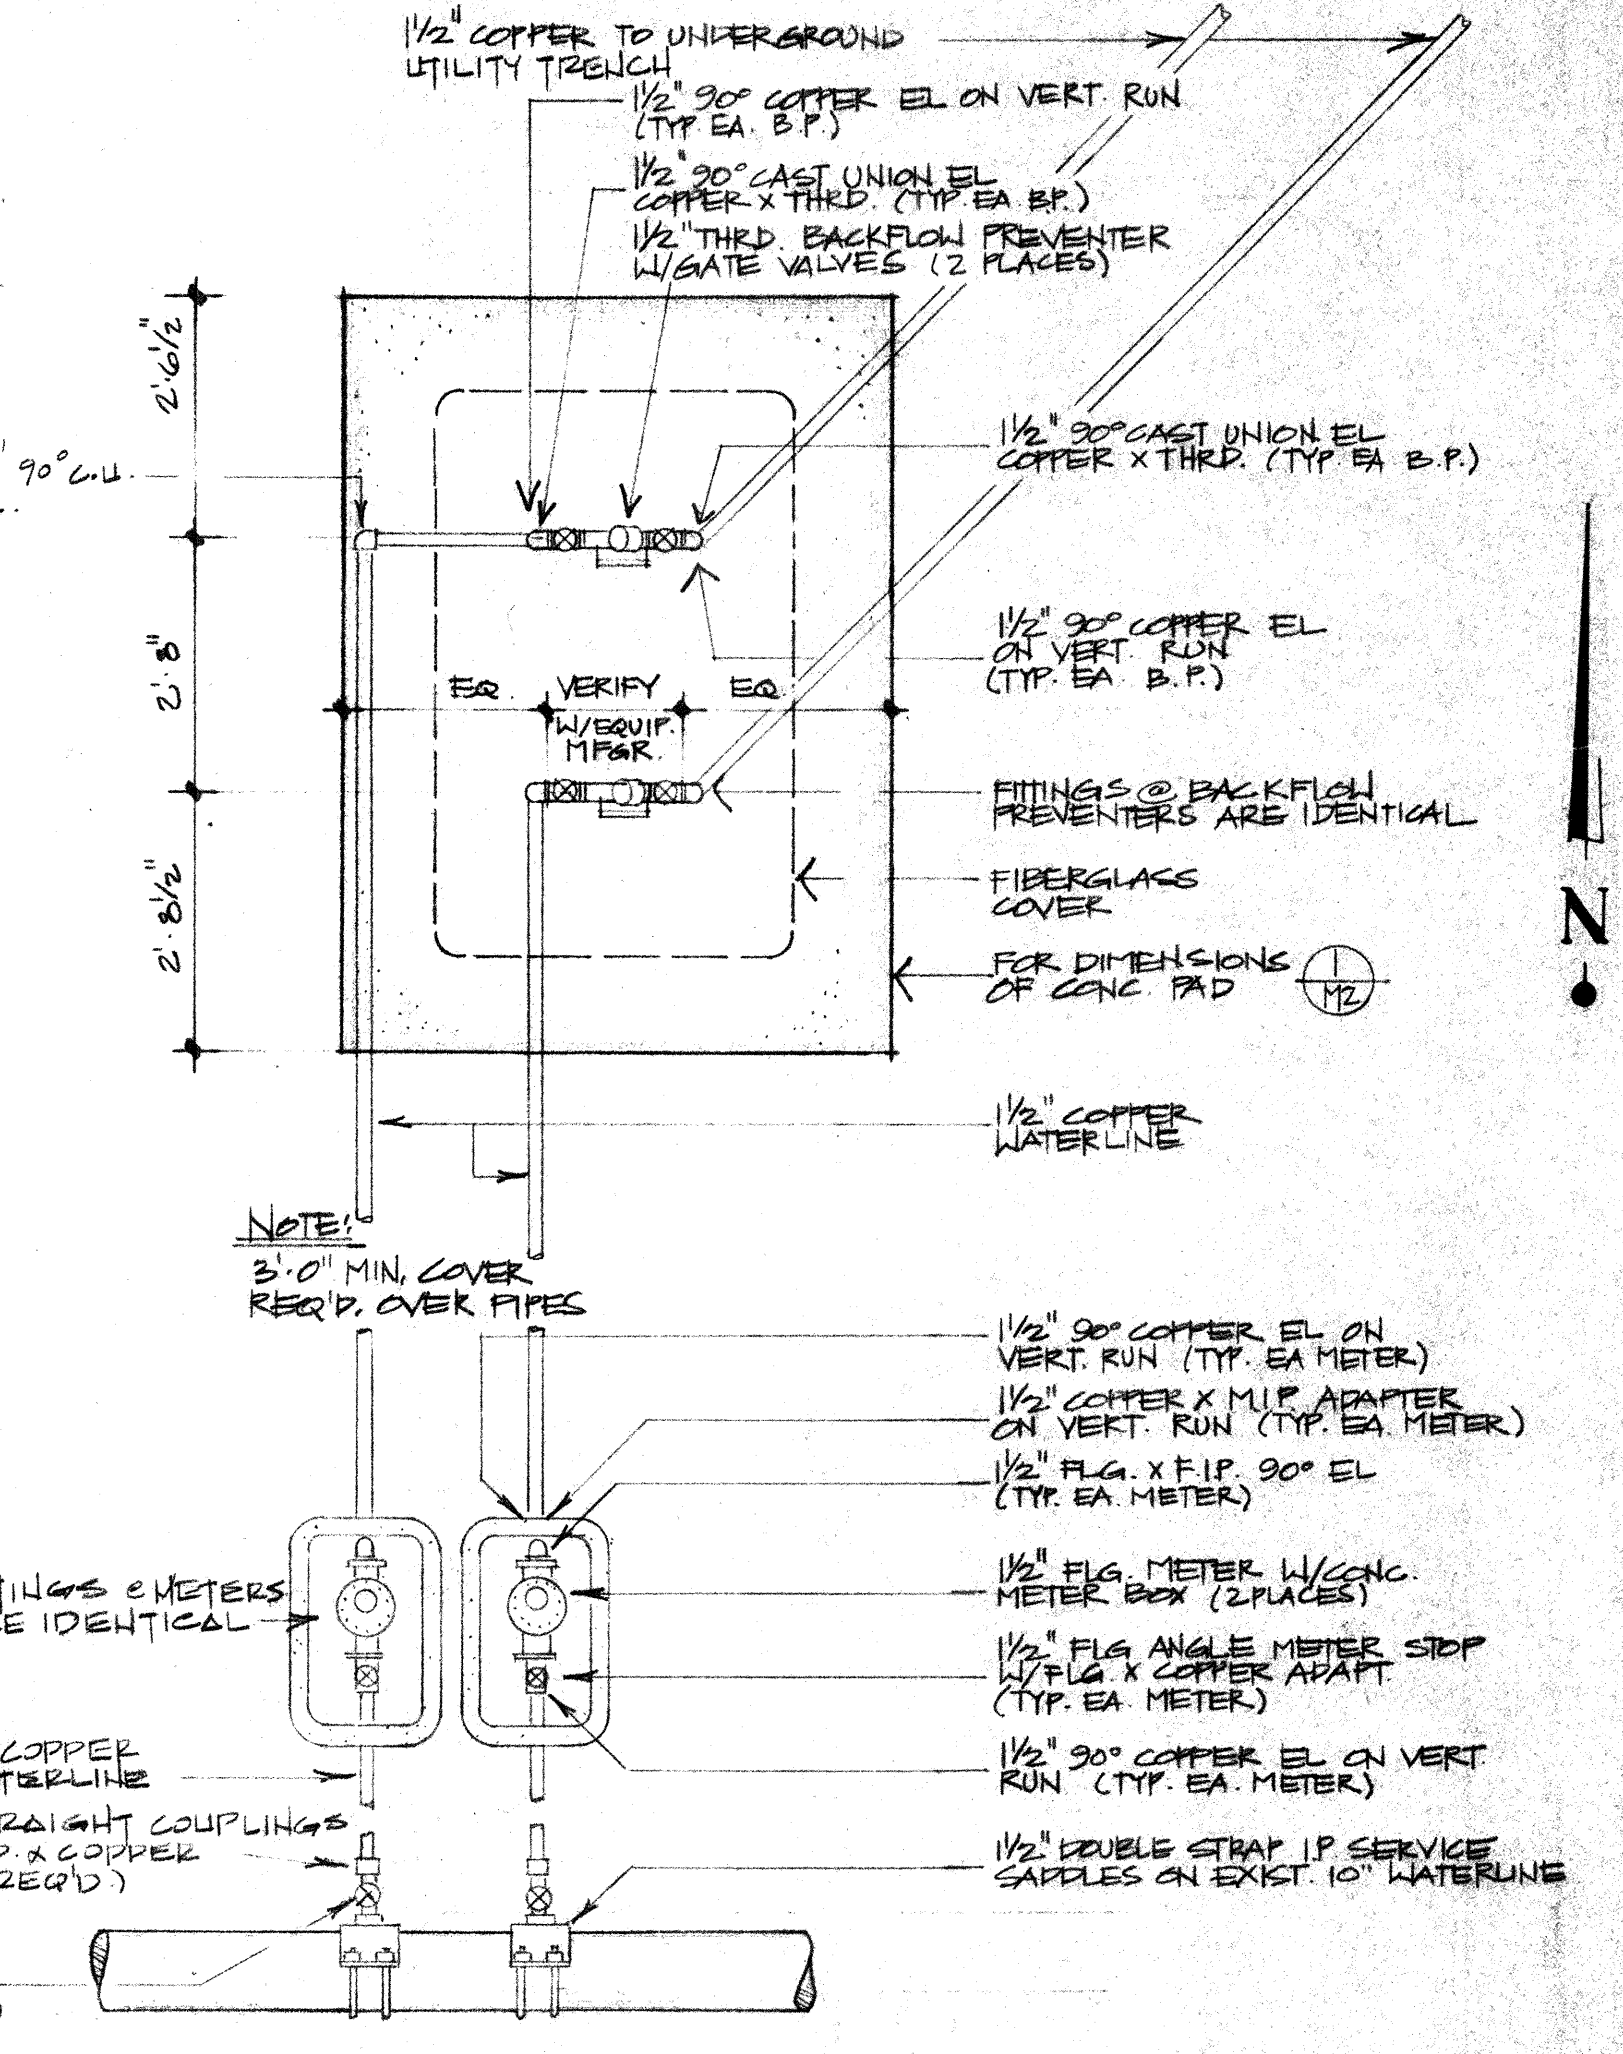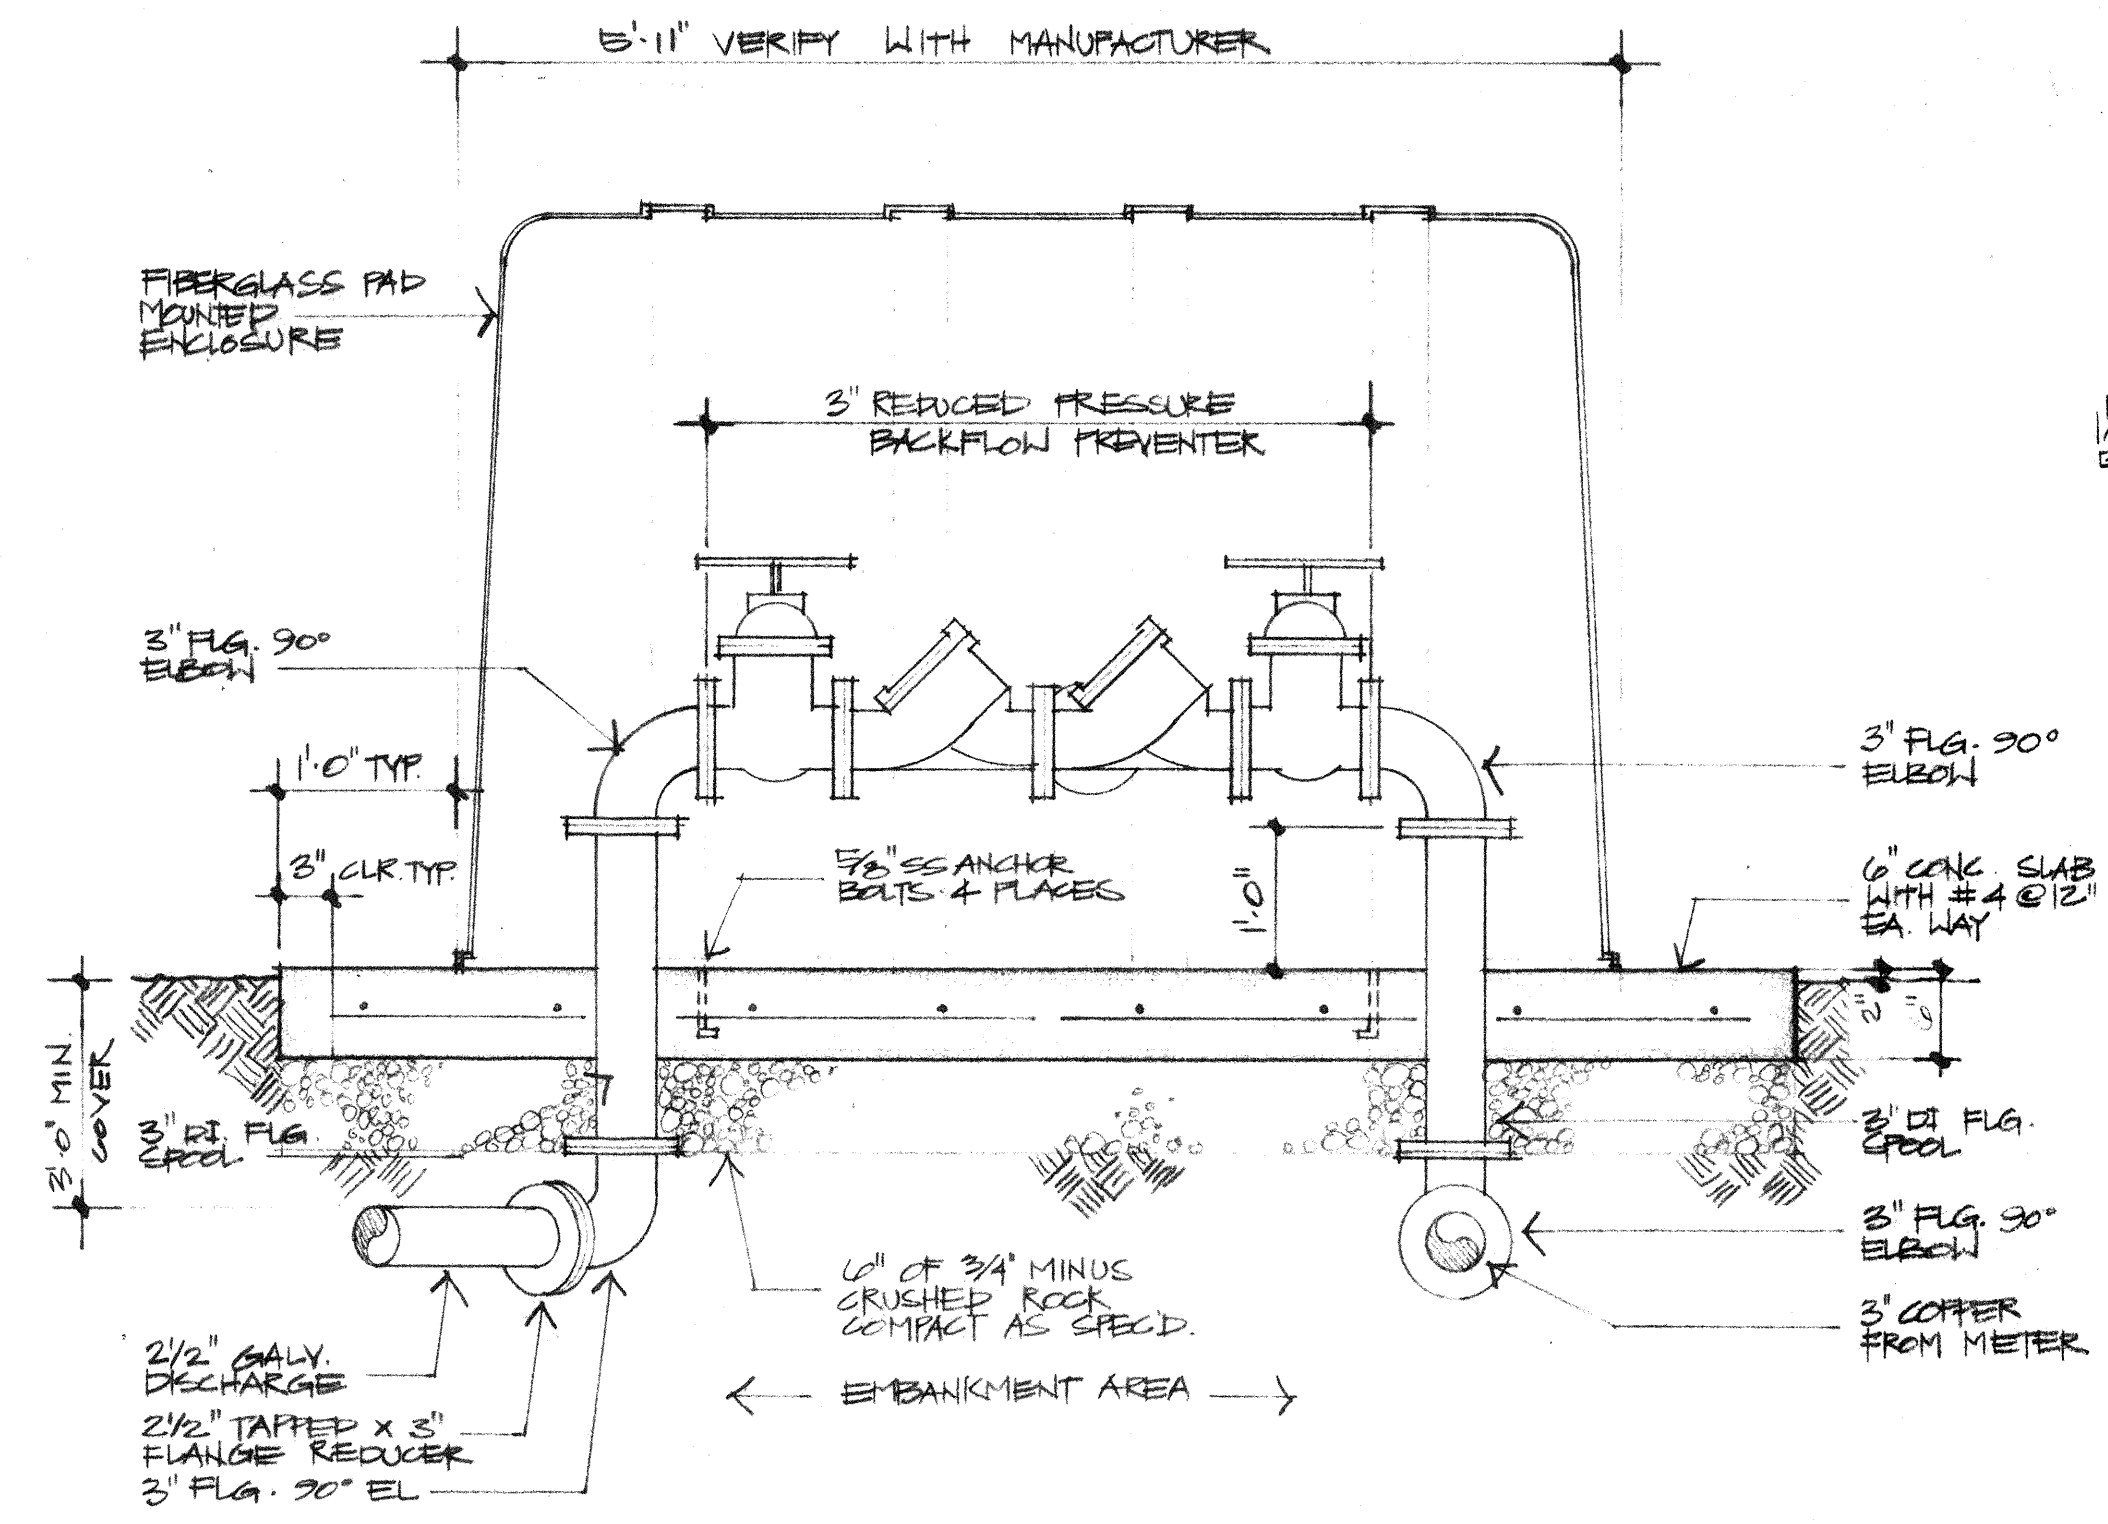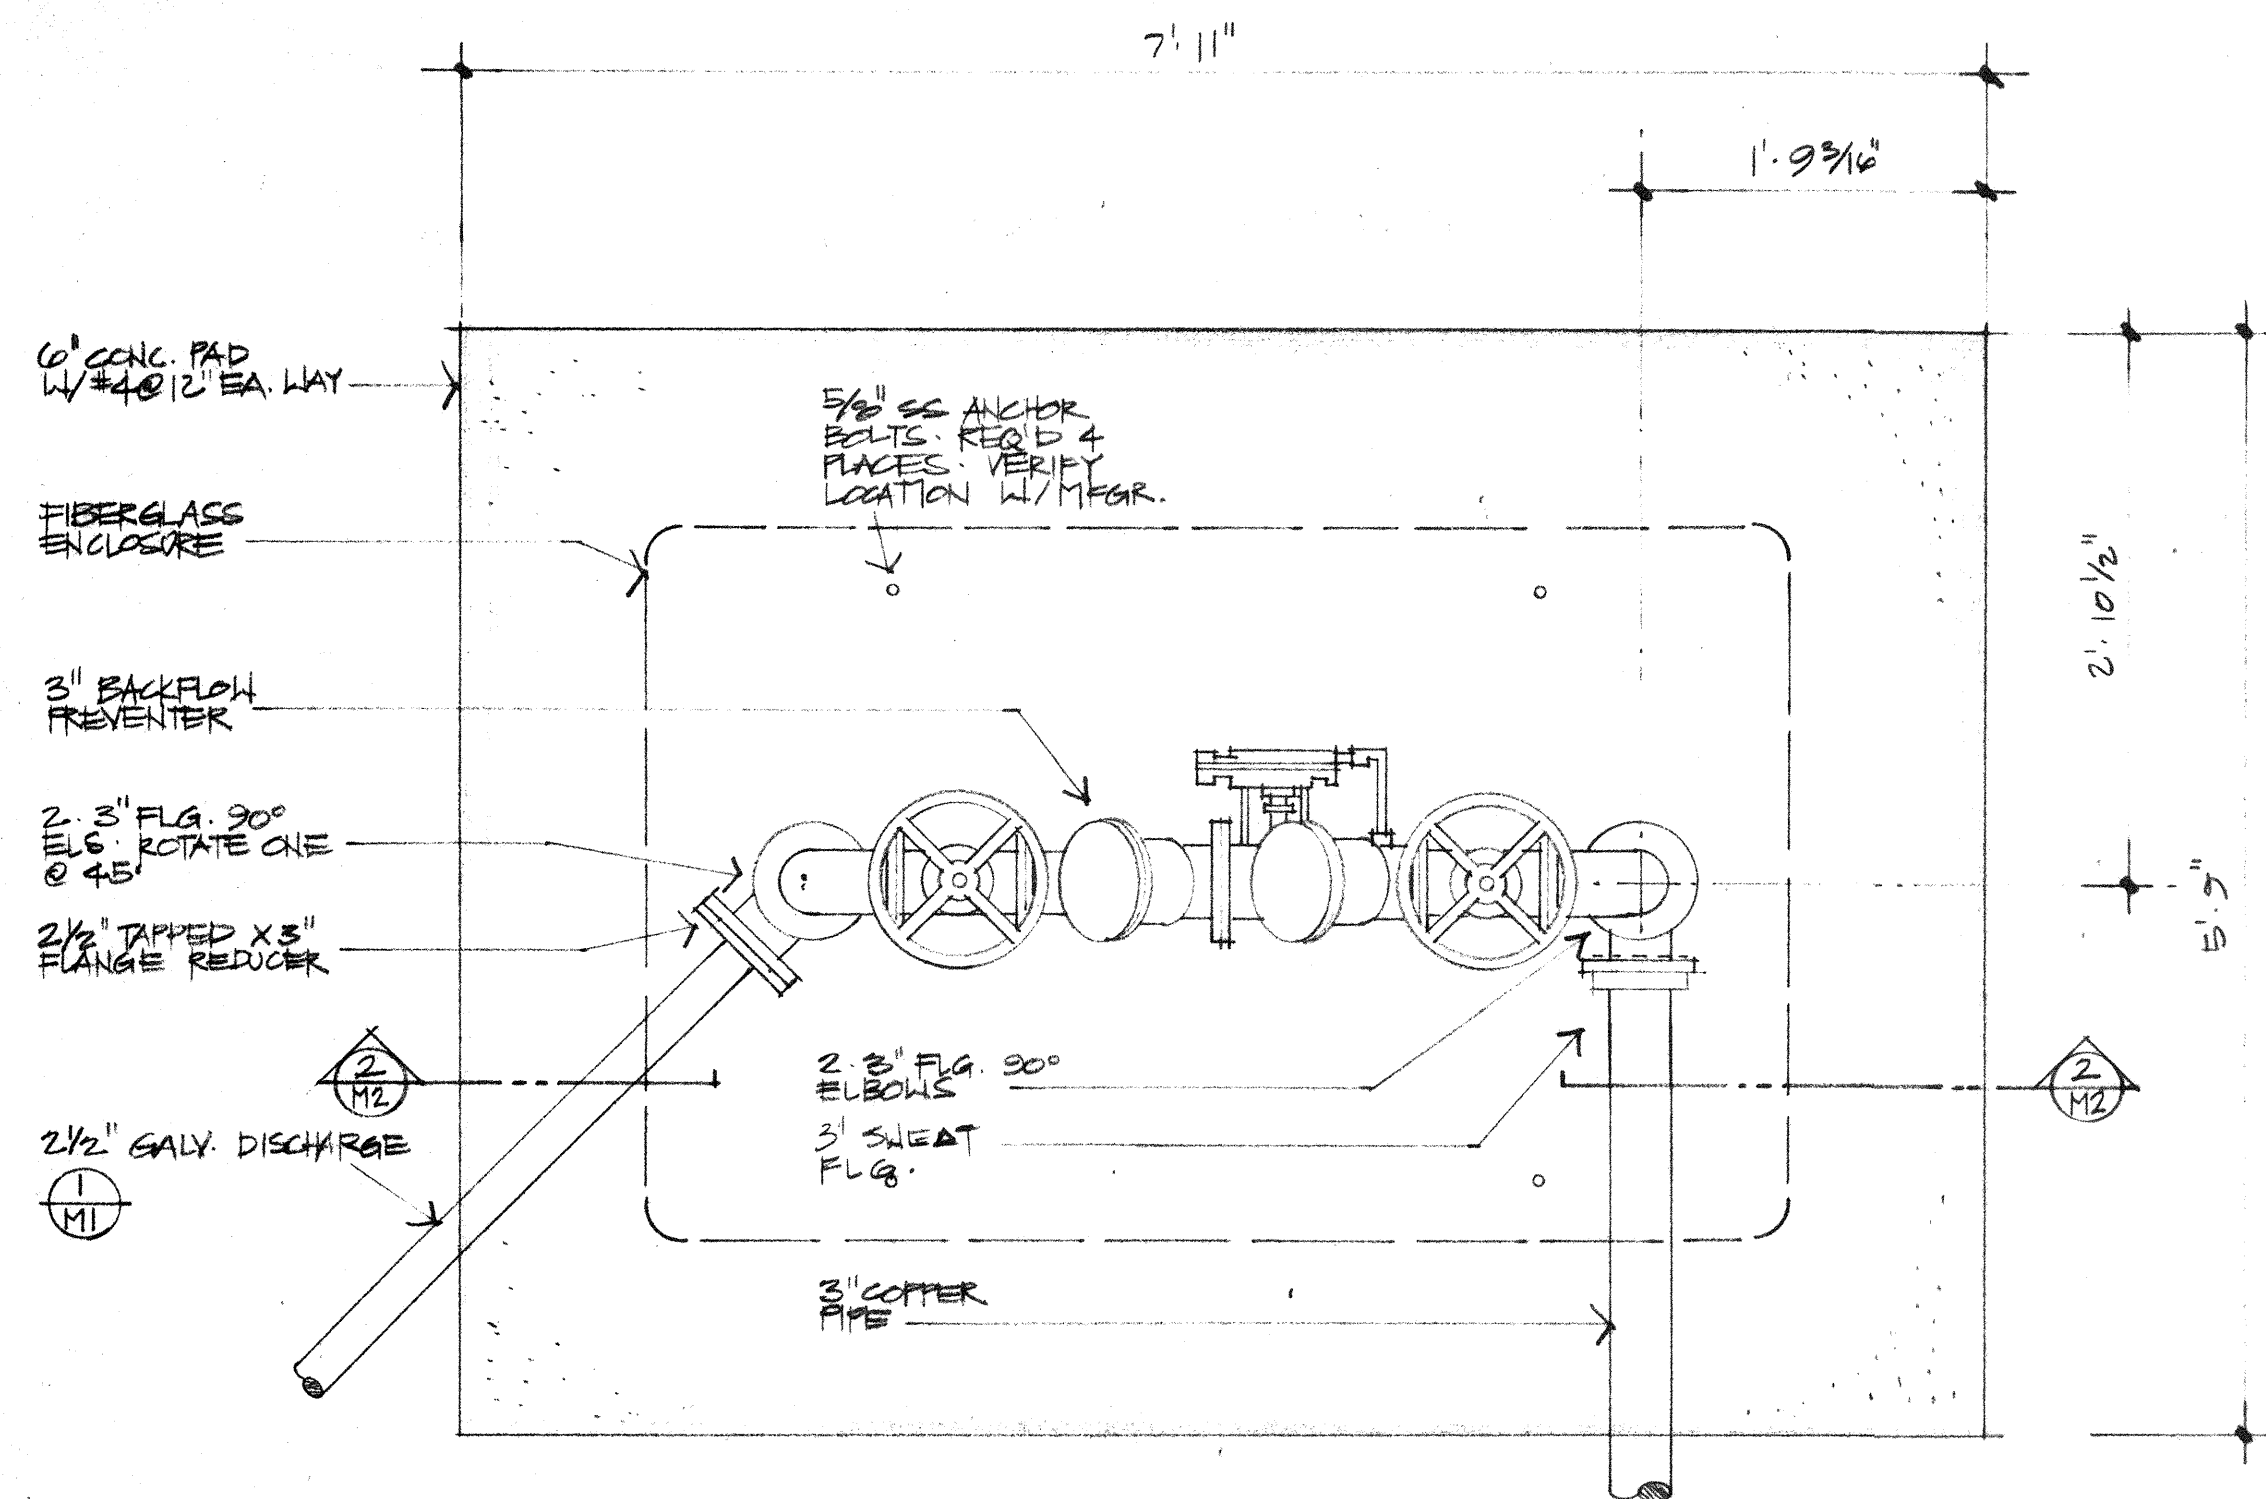

1 3" WATER SERVICE

2 SECTION @ BACKFLOW PREVENTER

3 1/2" WATER SERVICE

4 WATER SERVICE GANGWAY


5 PIPE HANGER

6 PIPE SUPPORT

7 UTILITY TRENCH

8 HOSE BIBB ON F.H. DOCK

HCE INC./ENGINEERS & PLANNERS
 Coos Bay, Oregon / 375 Park Avenue 97420 / (503) 289-1166
 Portland, Oregon / 19 N. W. 6th Ave. 97209 / (503) 222-1687
 Albany, Oregon / 300 Elsworth St. So. 97321 / (503) 926-0064

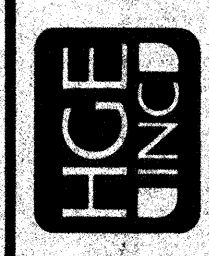


WATERLINE

SHEET TITLE


PROJECT: PORT OF Bandon
 COQUILLE RIVER BOAT BASIN
 COOS COUNTY, OREGON

PROJECT # 2071
 DATE JULY, 1962


SHEET NO. M2

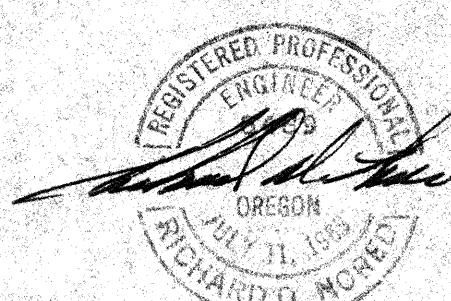


NOTE: 3/4" FLEX HOSE UTILIZED S.S. NIPPLES, MALE THRD. X SERP. SHANK.

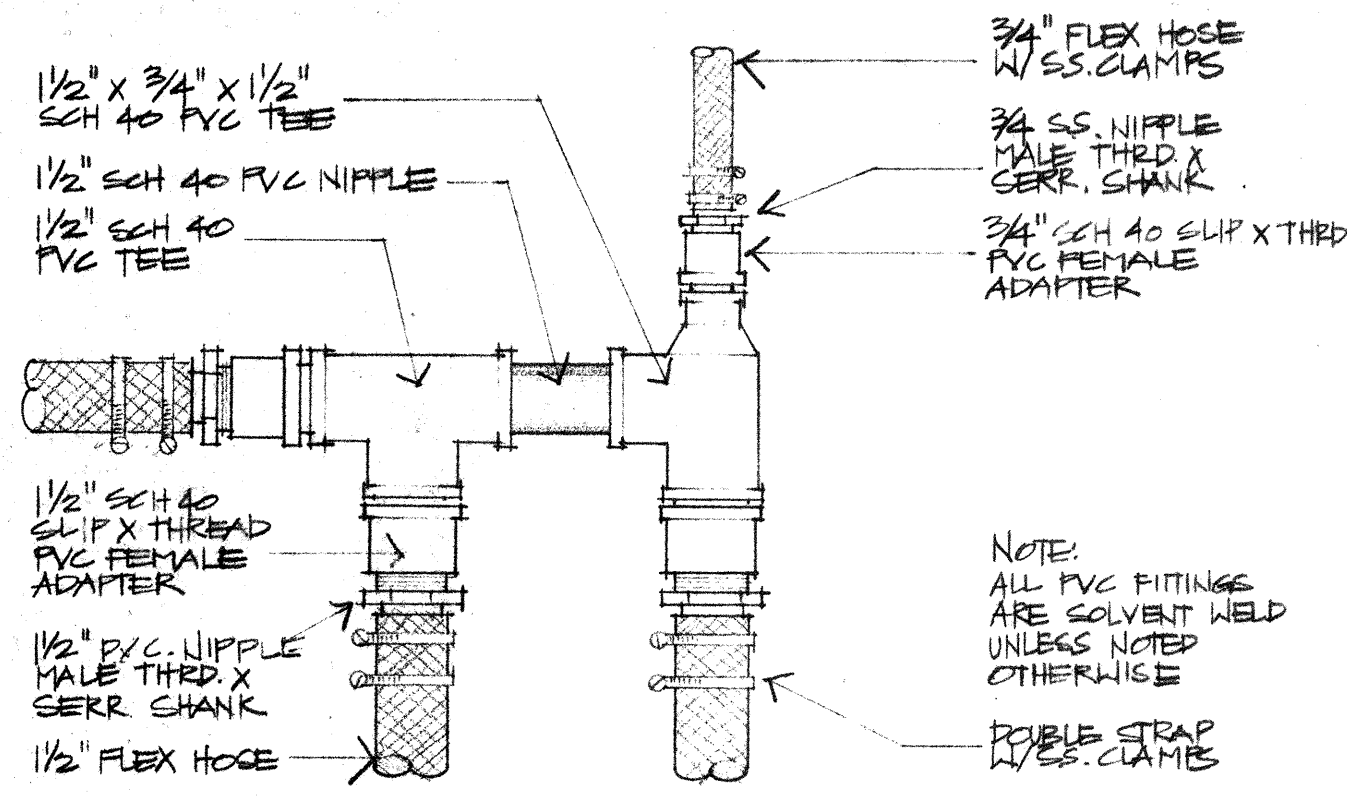


1 WATERLINE PIPING
NO SCALE

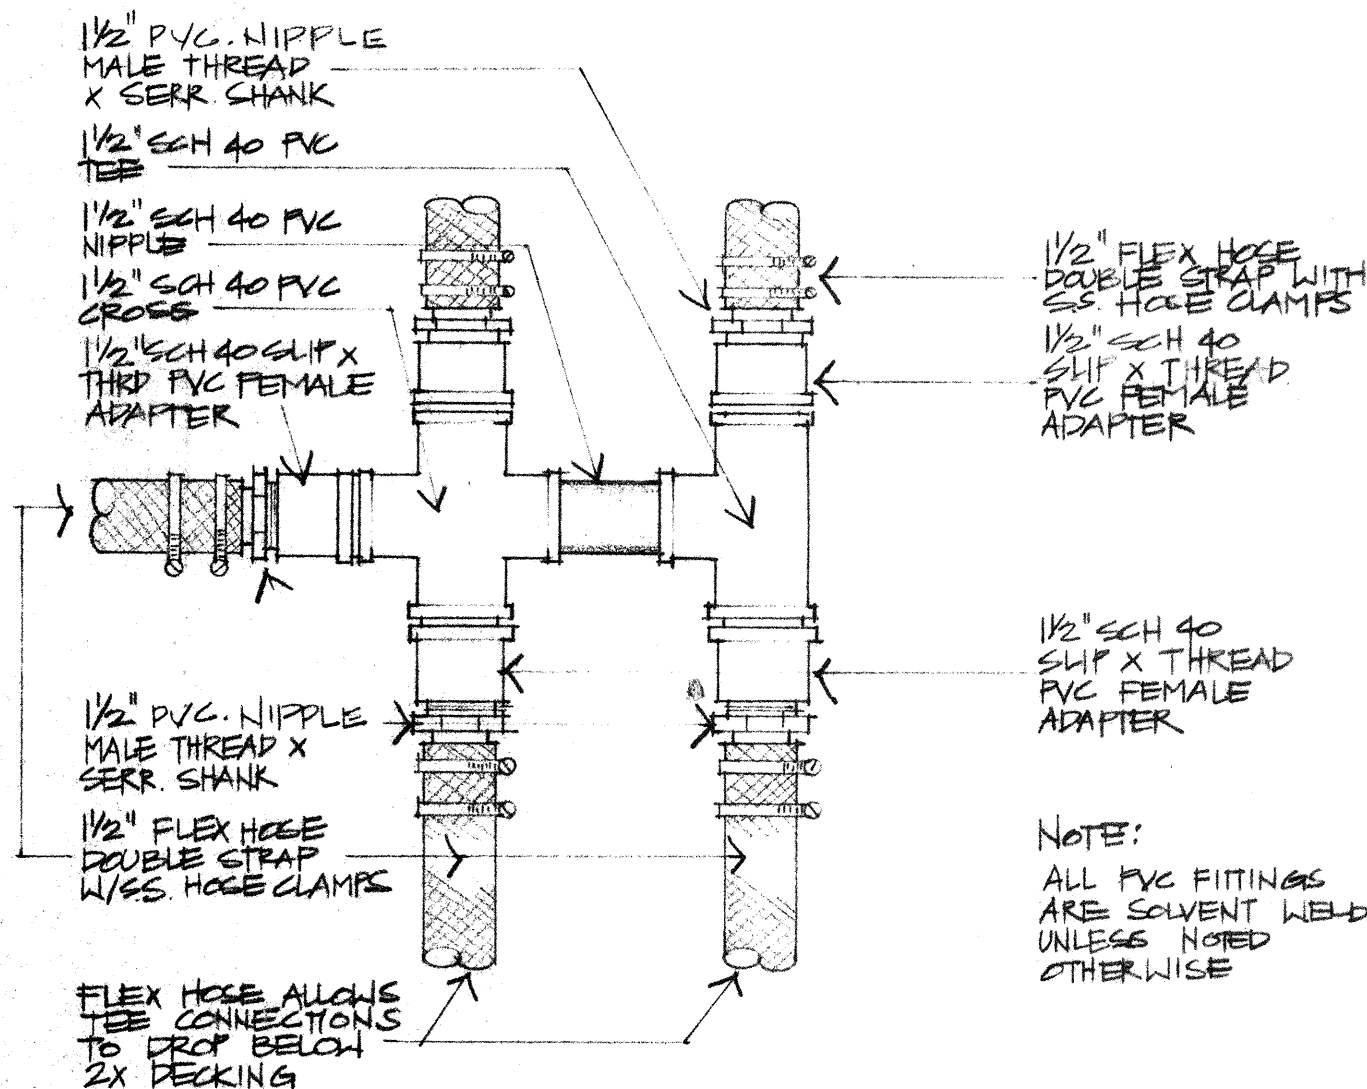


2 WATERLINE PIPING
NO SCALE

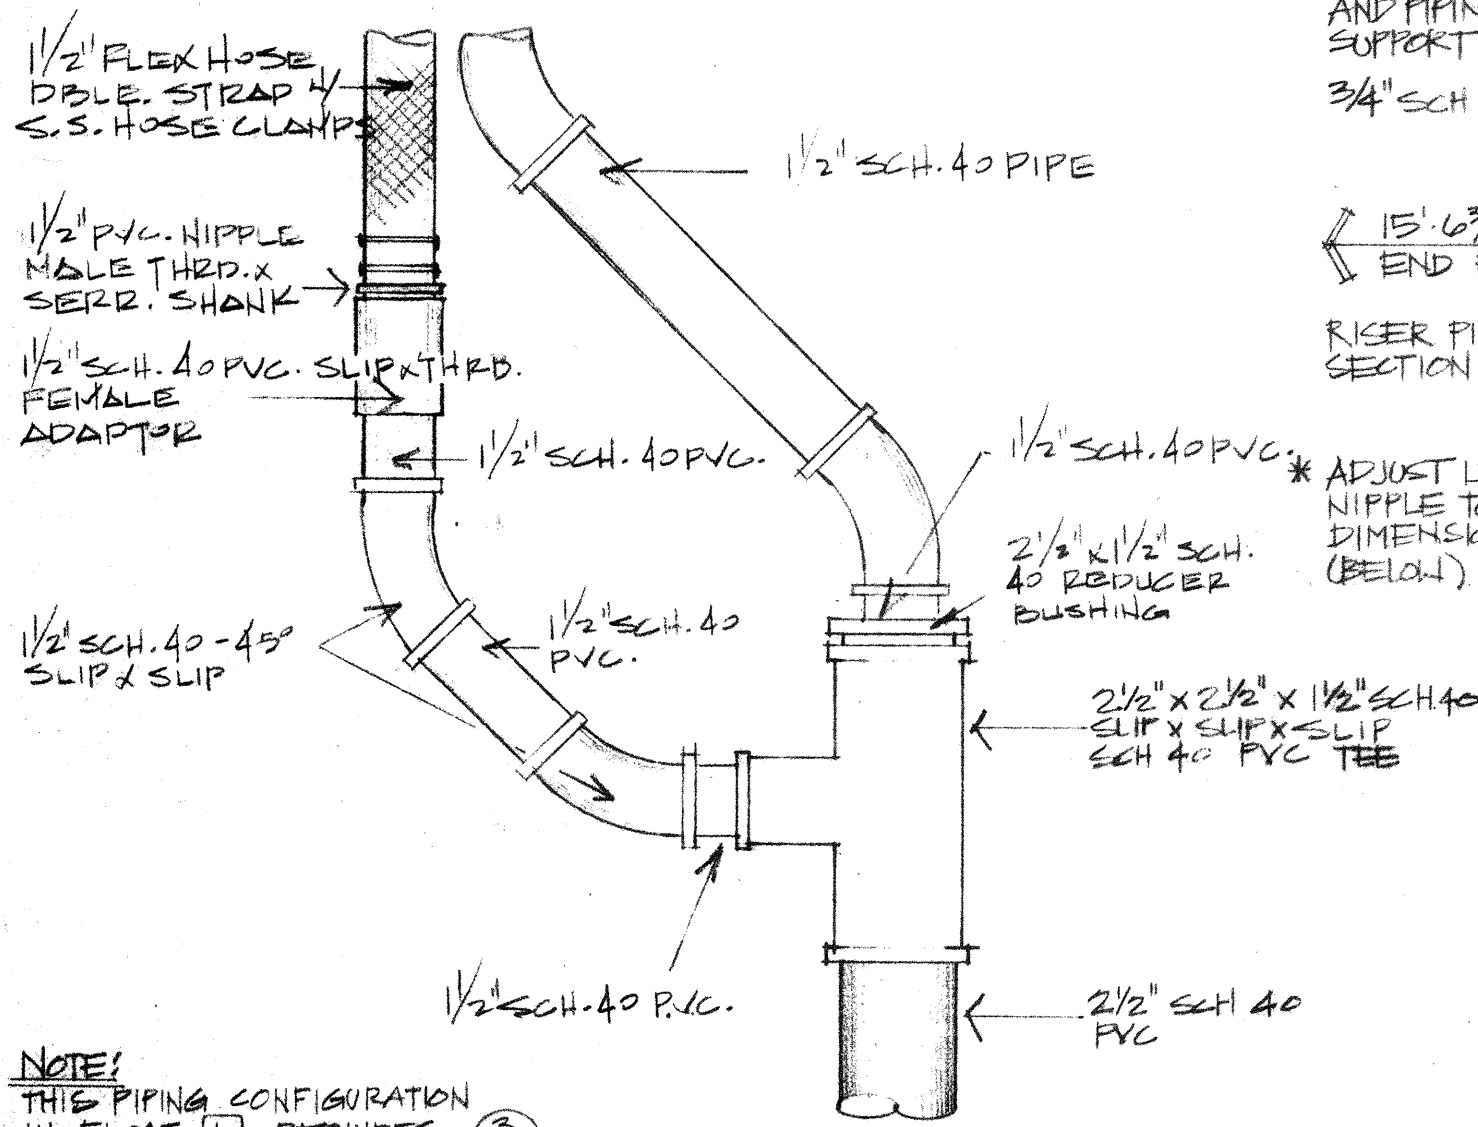


3 WATERLINE PIPING
NO SCALE

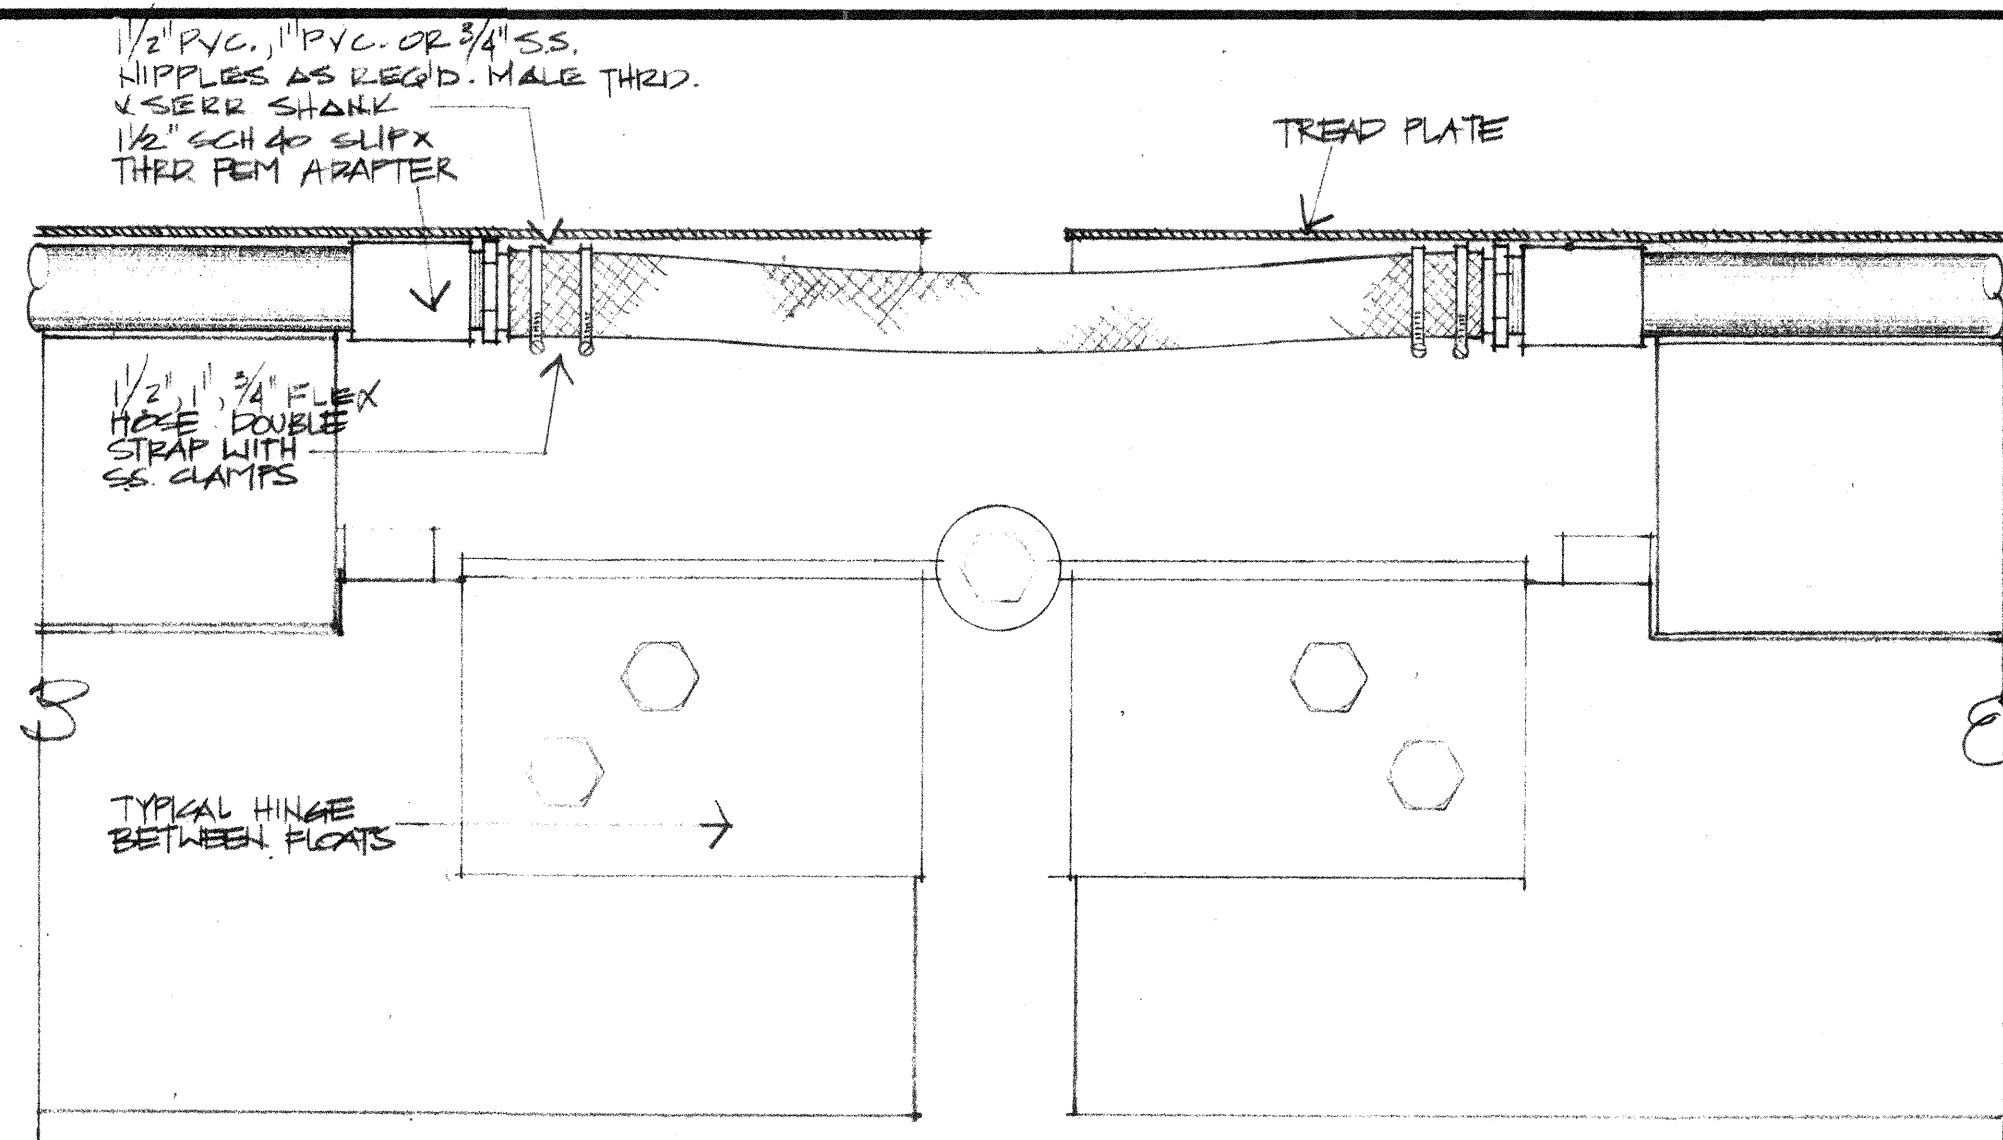


4 FLEX CONNECTION BETWEEN FLOATS
NO SCALE

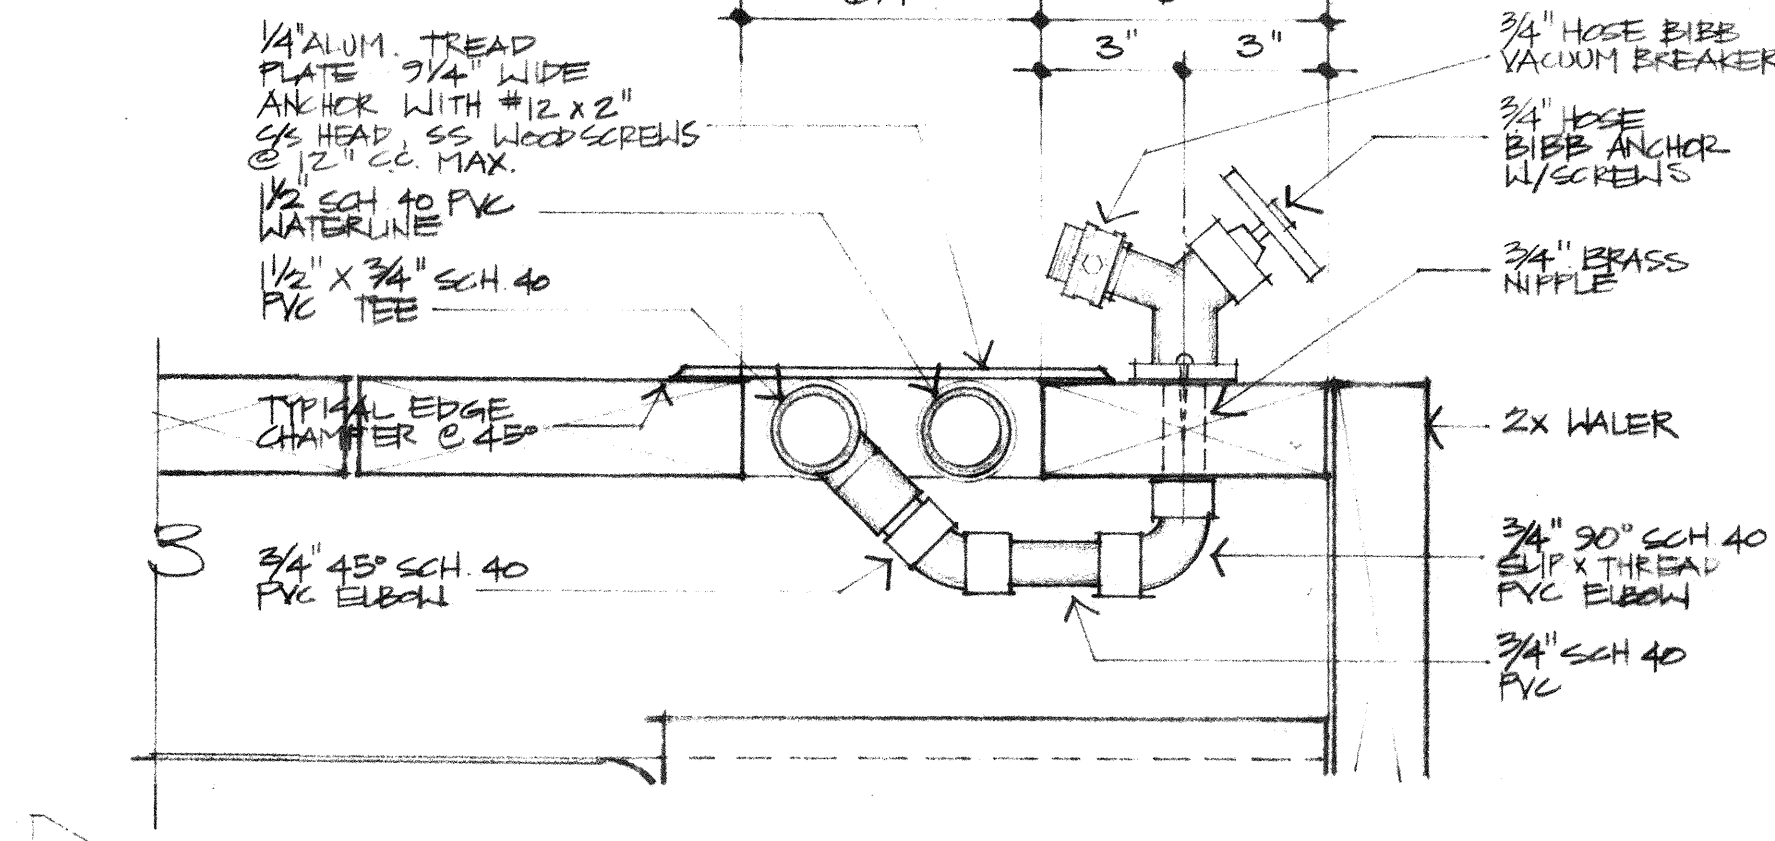


5 TYPICAL HOSE BIBB
NO SCALE

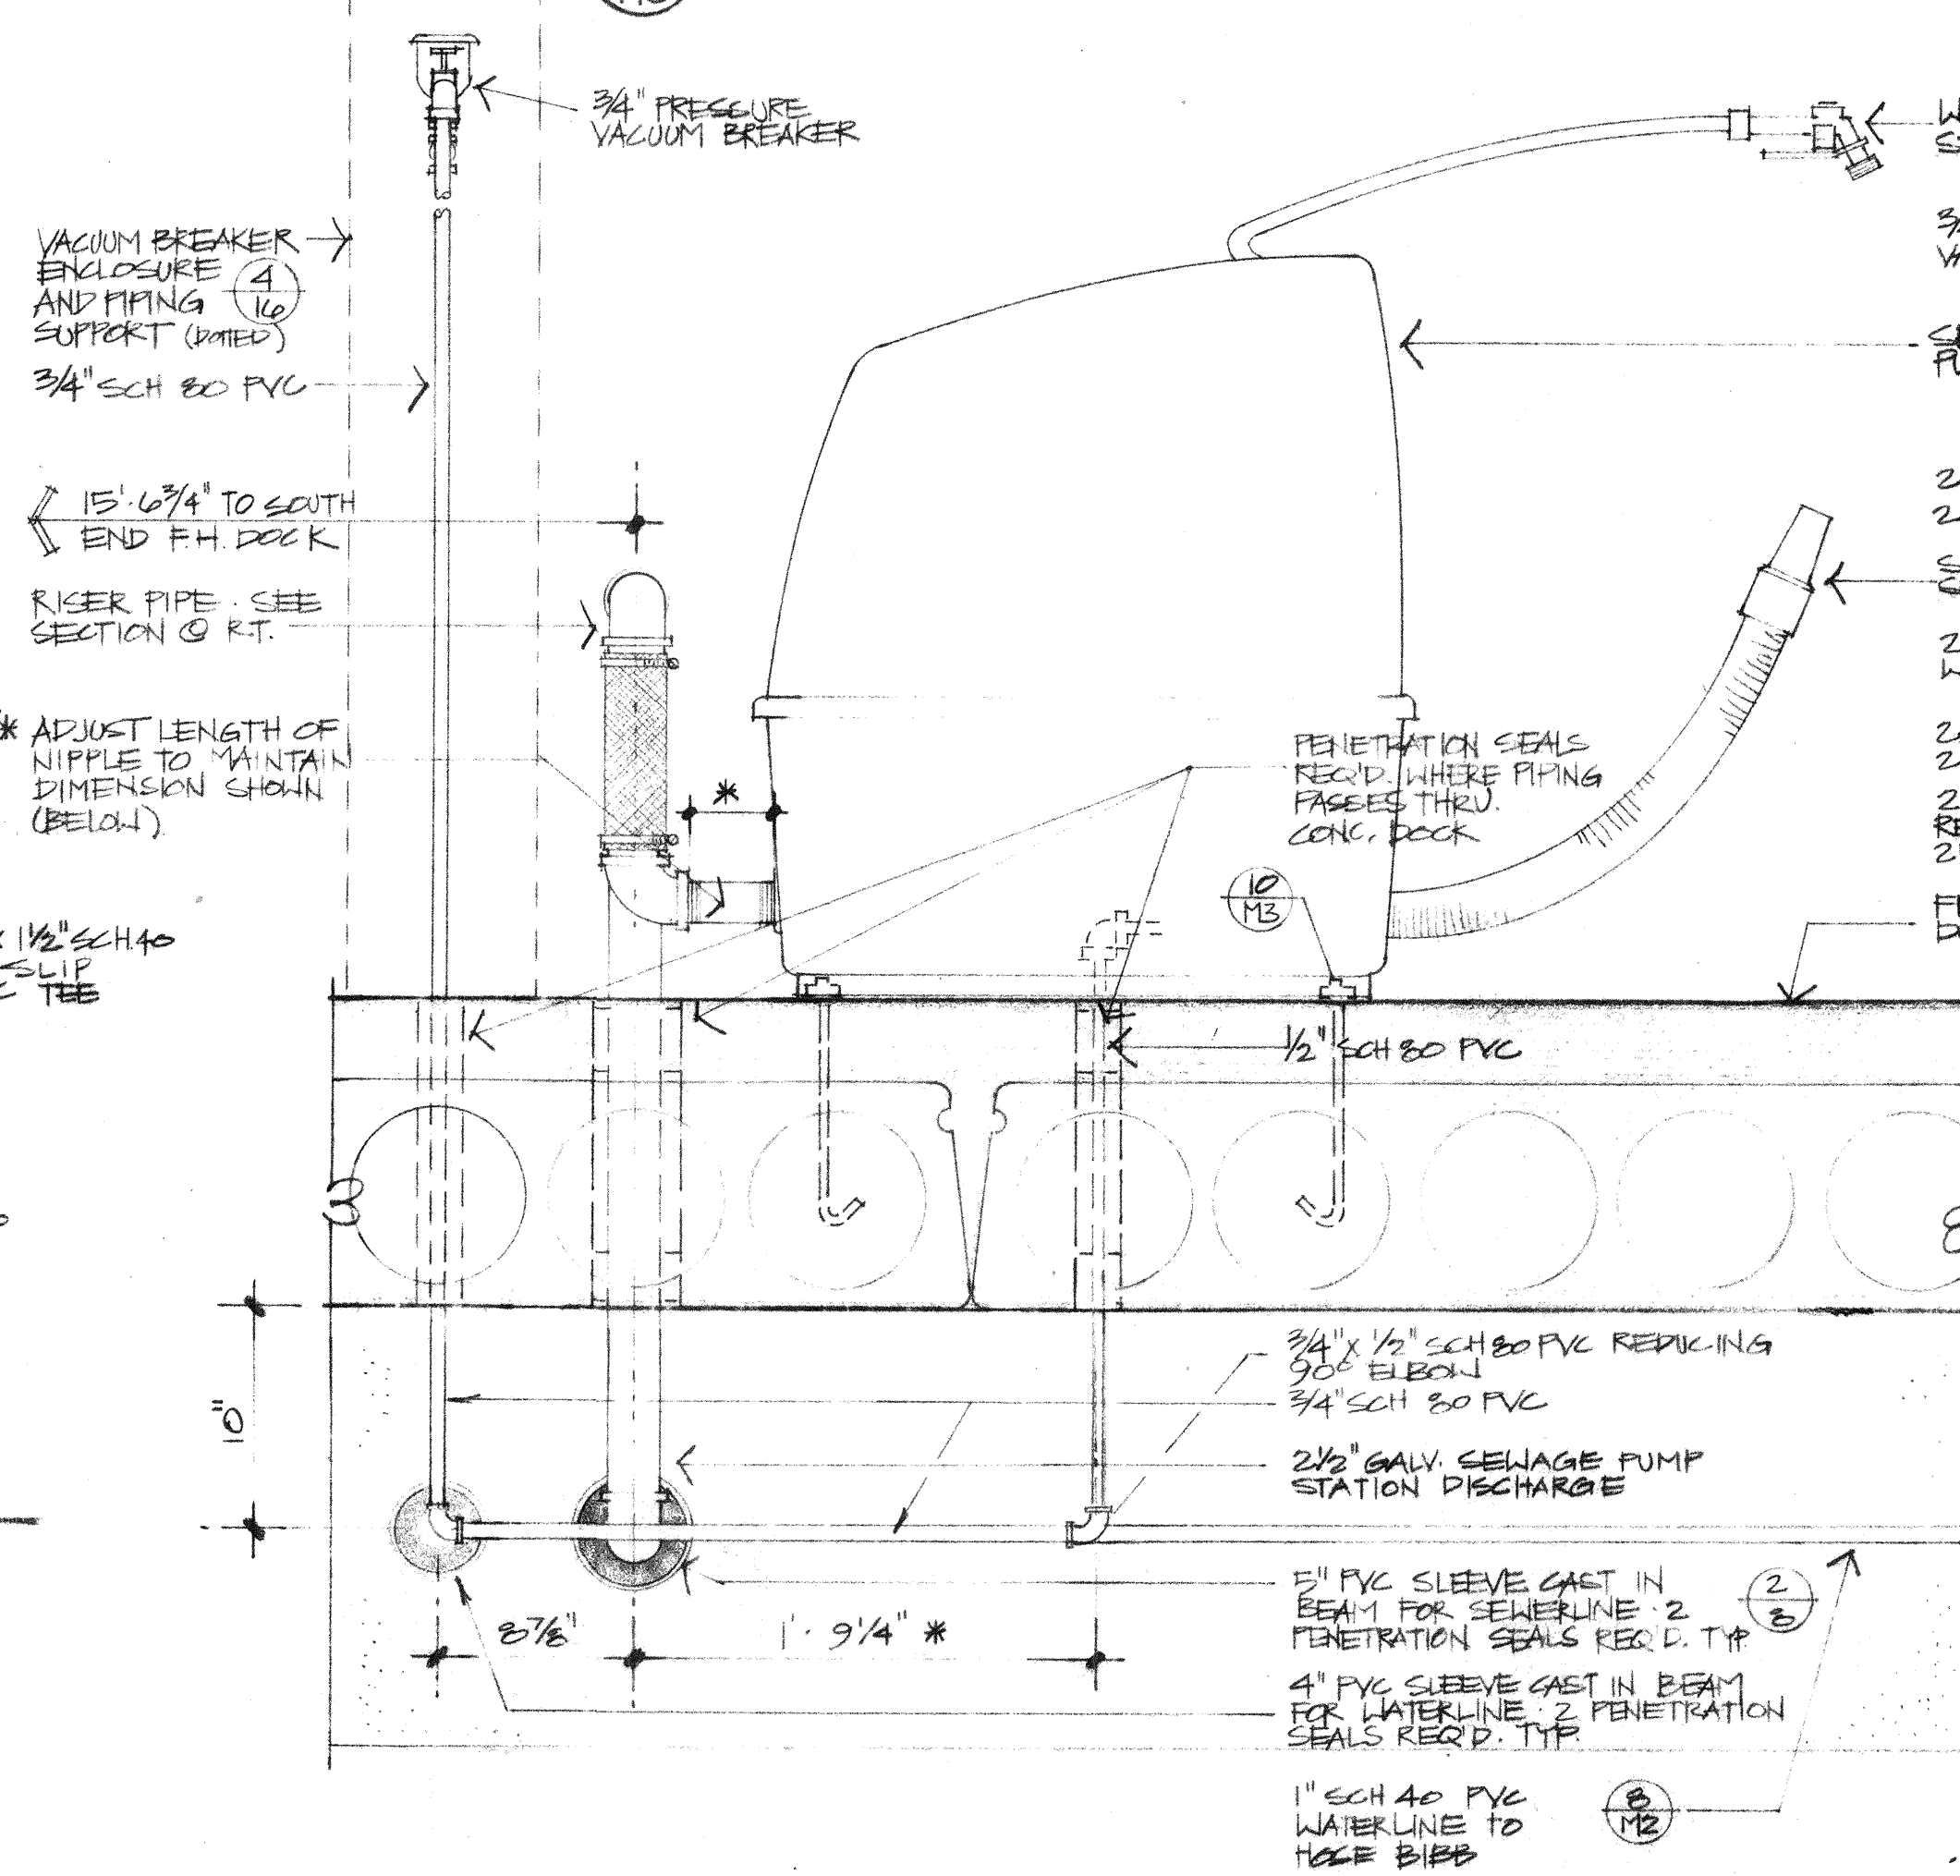


6 SECTION @ SEWAGE PUMP STATION
1/2\"/>

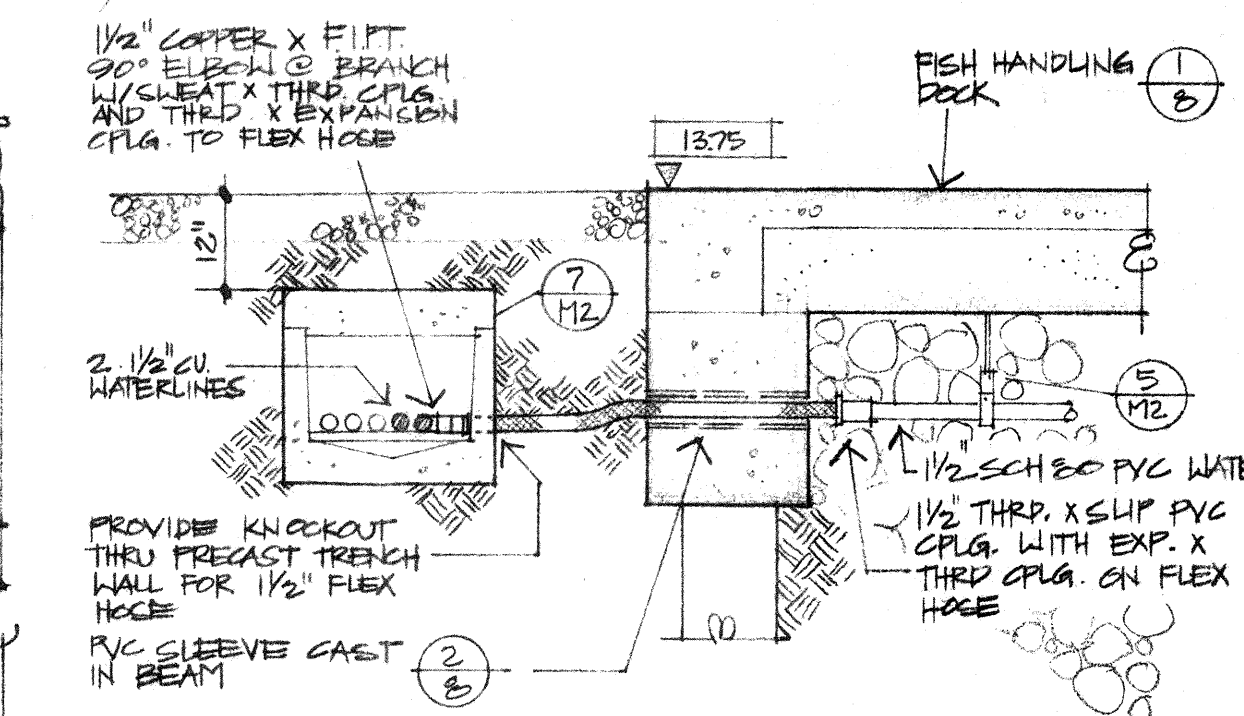


7 WATERLINE FLEX CONNECTION
NO SCALE

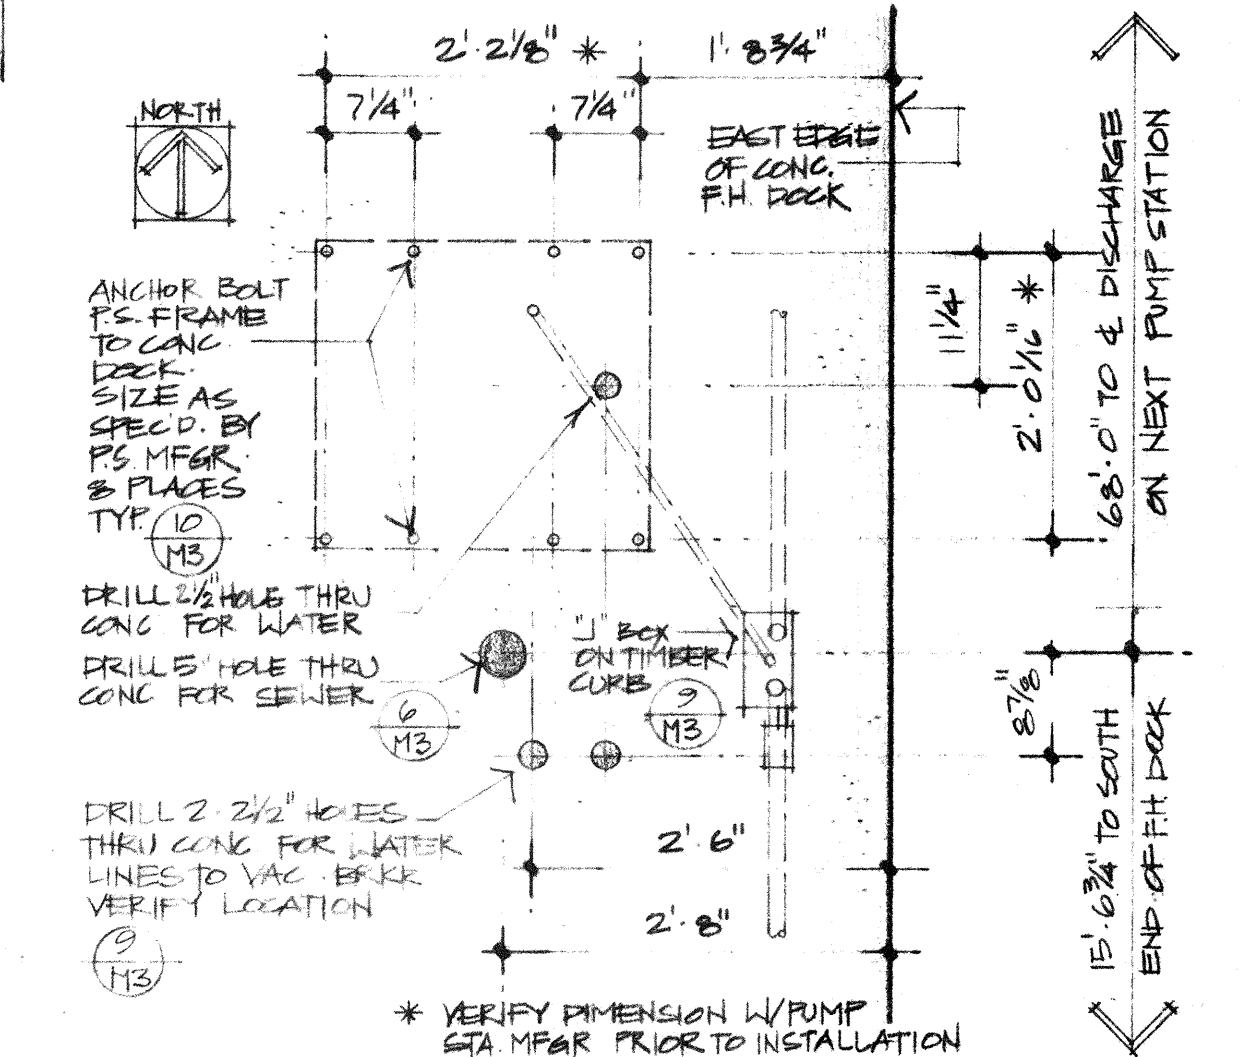


8 PUMP STATION MOUNTING PLAN
NO SCALE

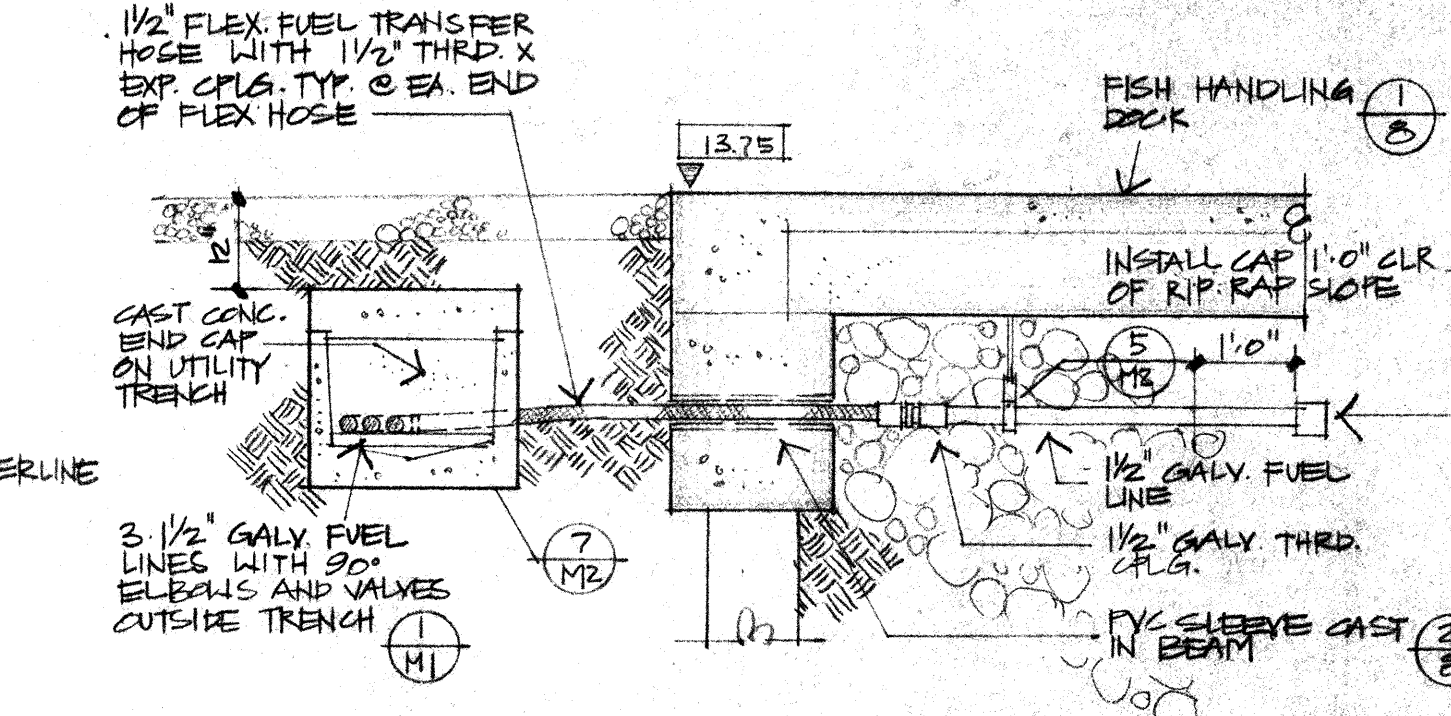


9 FUEL LINE FLEX CONNECTION
NO SCALE

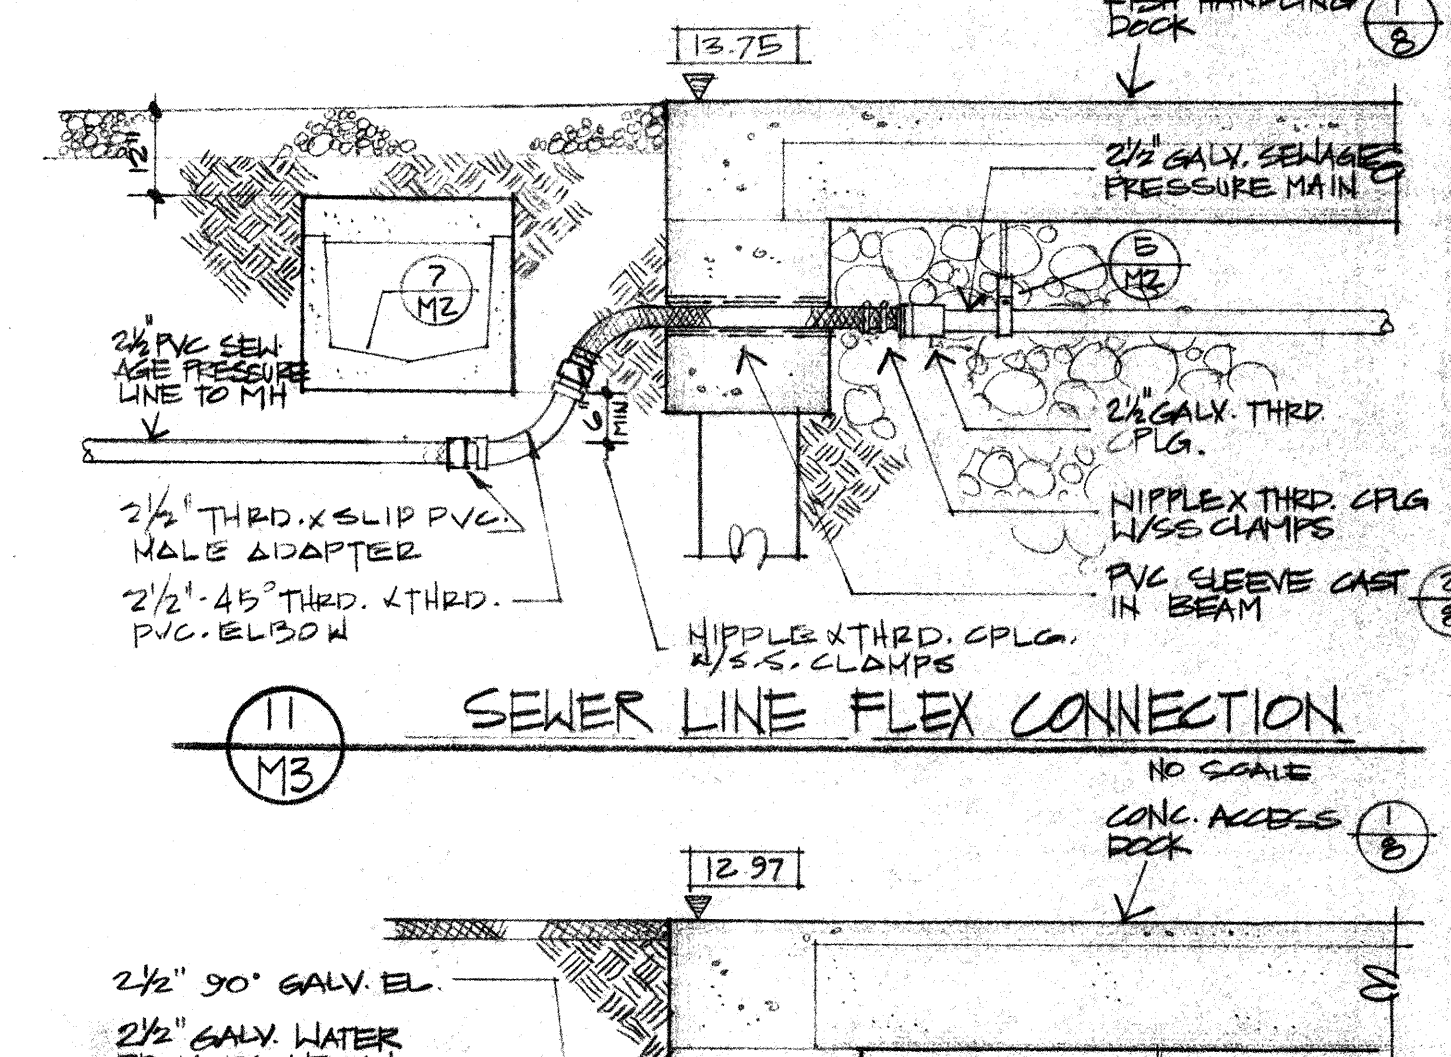


10 SEWER LINE FLEX CONNECTION
NO SCALE

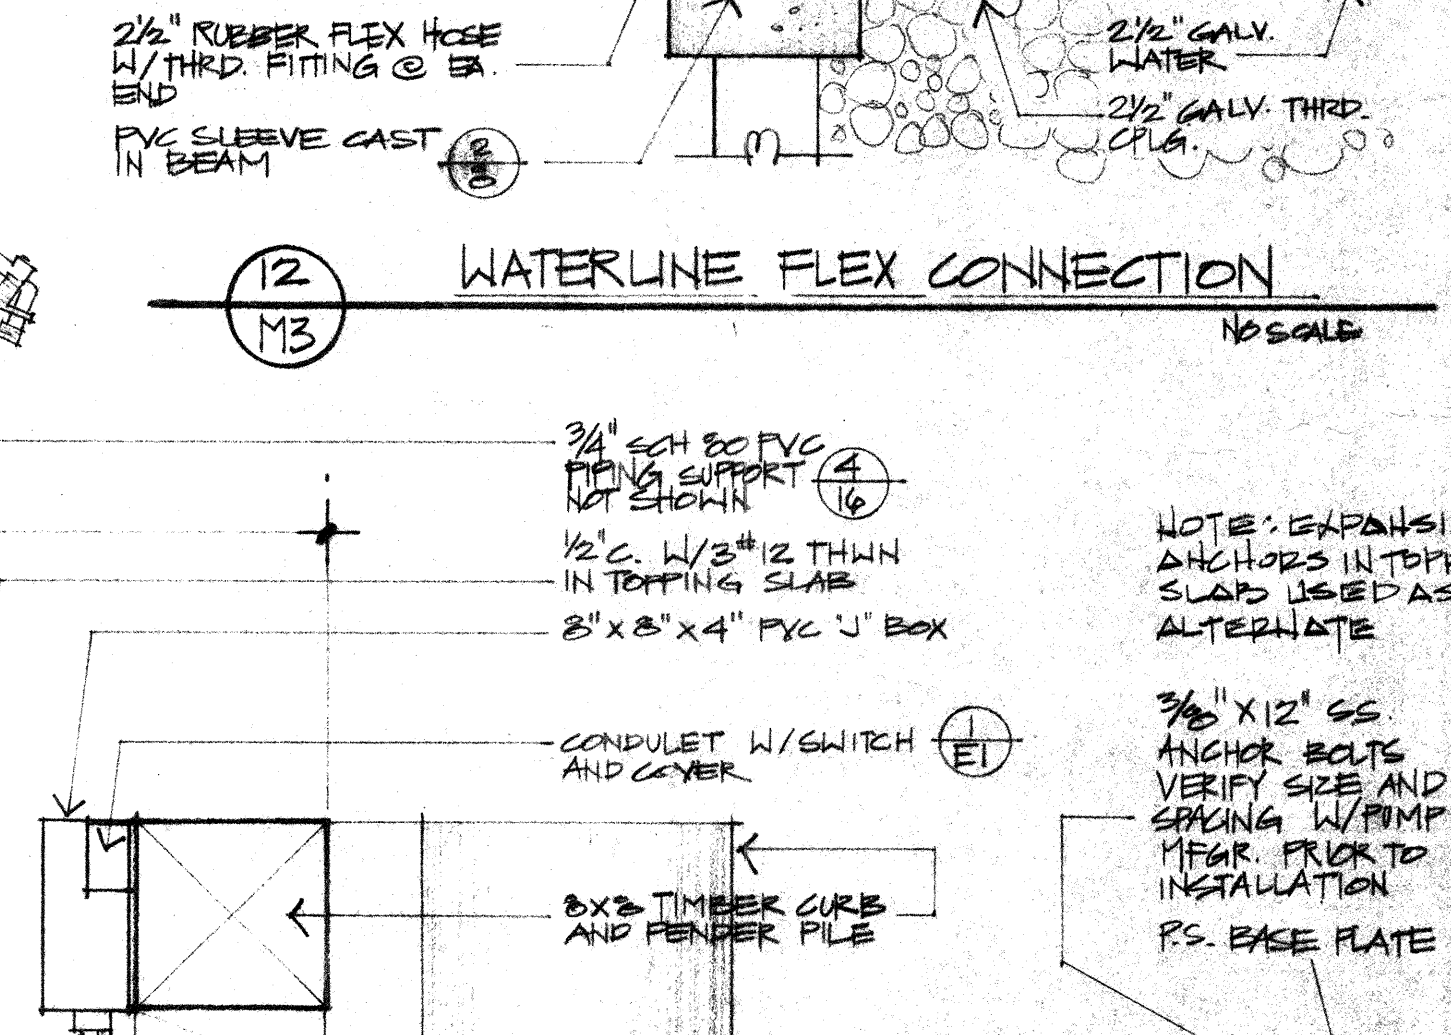

11 WATERLINE FLEX CONNECTION
NO SCALE

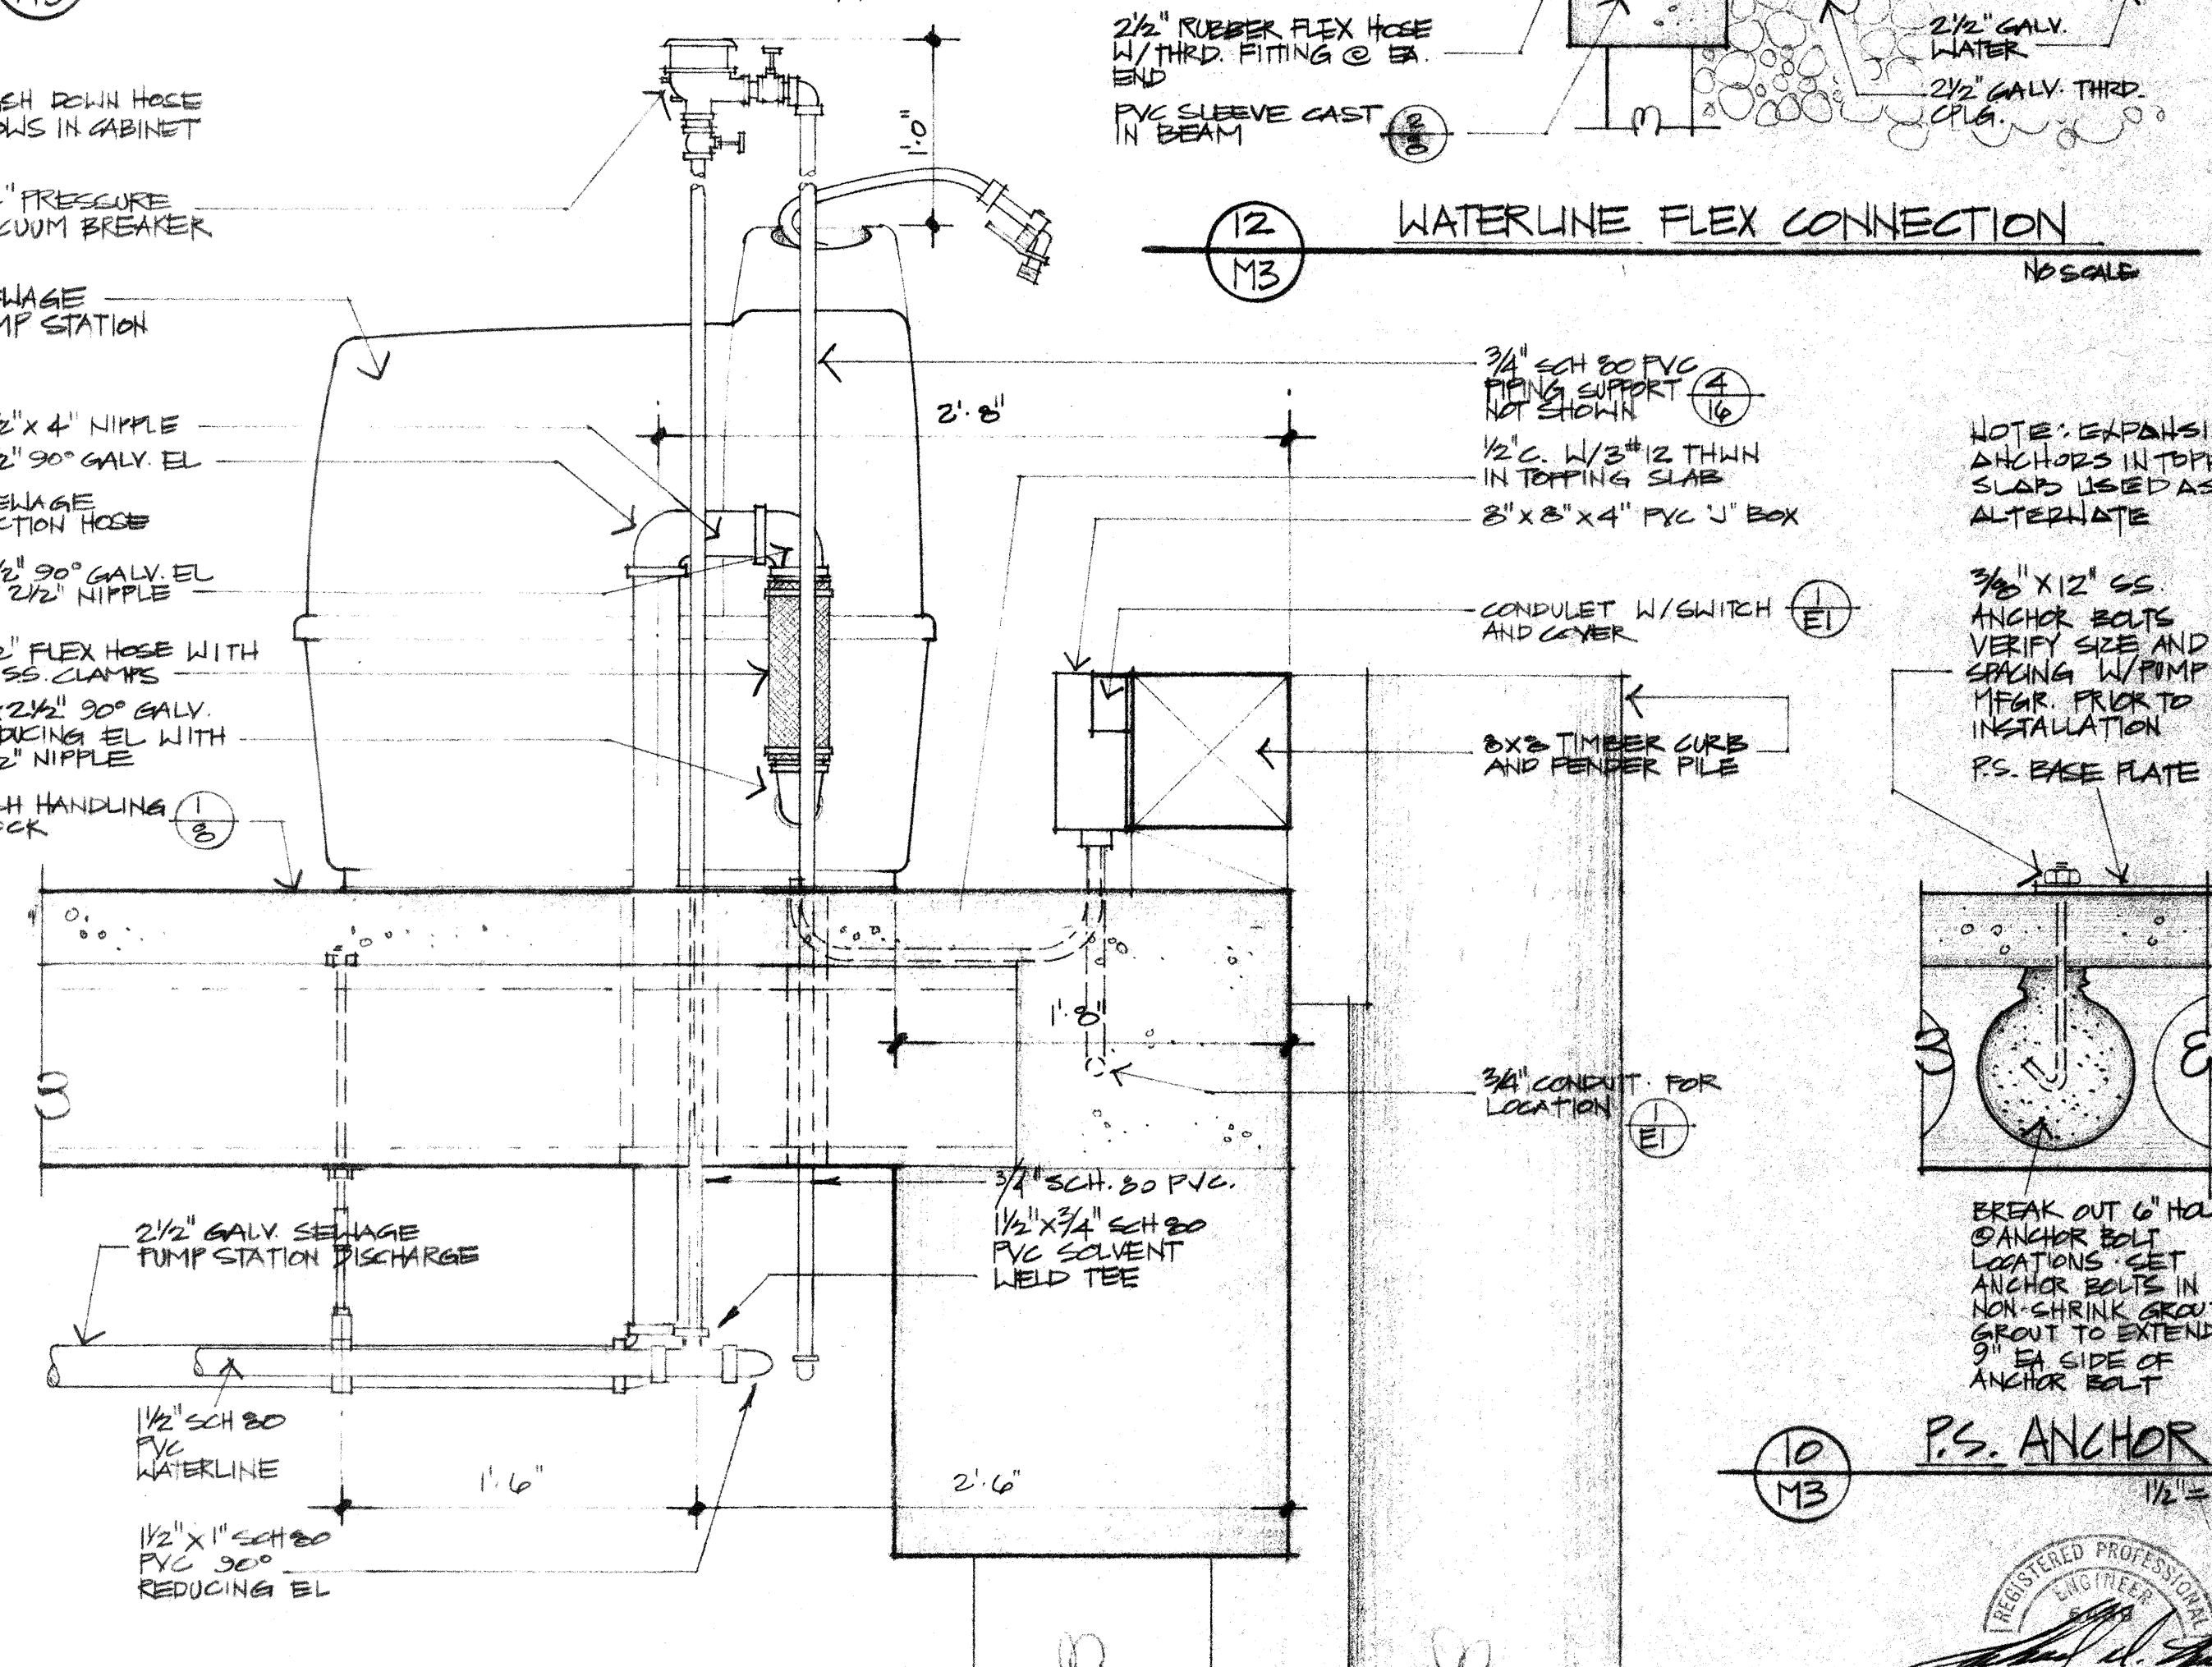

12 SECTION @ SEWAGE PUMP STATION
1/2\"/>

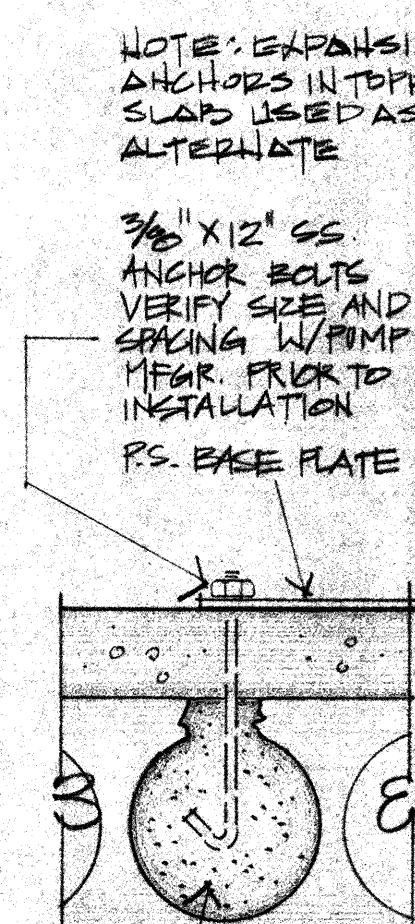

13 P.S. ANCHOR
1/2\"/>

NOTE: THIS PIPING CONFIGURATION IN FLOAT (1) REQUIRES SPECIAL ALUM PL COVER (10)

NOTE: EXPANSION ANCHORS IN TOPPING SLAB USED AS ALTERNATE


NOTE: BREAK OUT 6\"/>

NOTE: 3/8\"/>

NOTE: 1/2\"/>

NOTE: 1/2\"/>

NOTE: 1/2\"/>

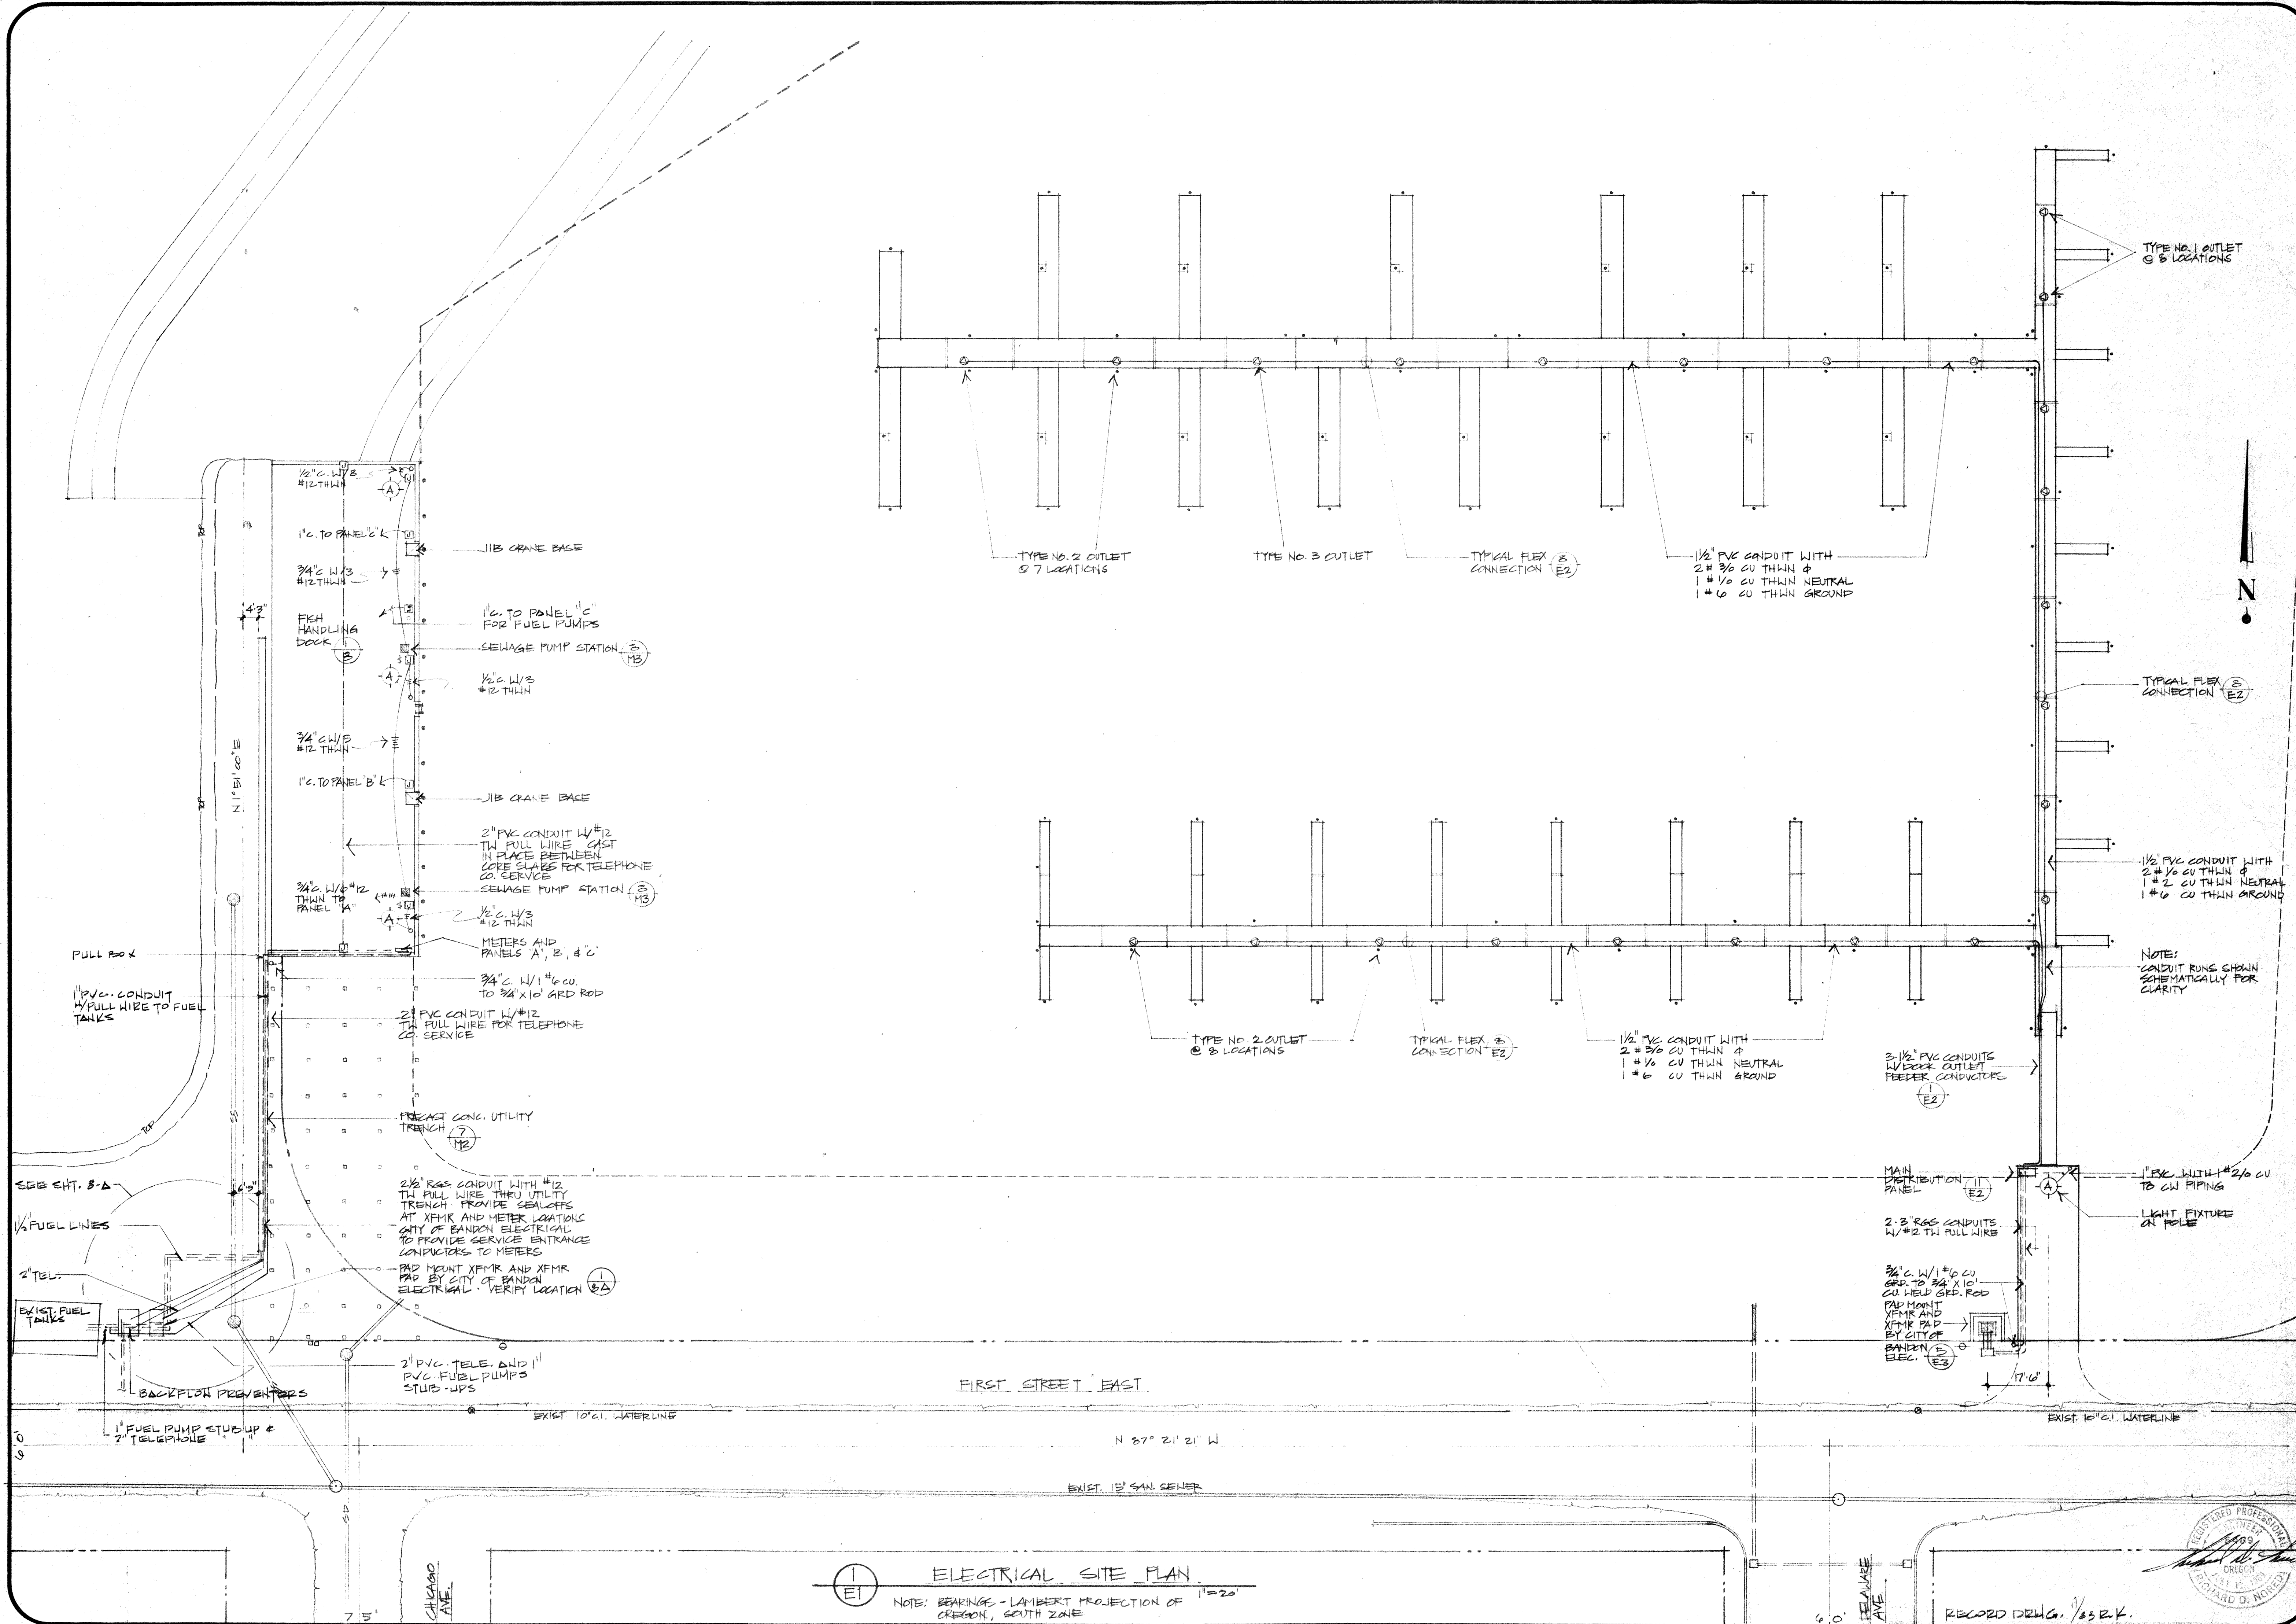

E1 ELECTRICAL SITE PLAN
 NOTE: BEARINGS - LAMBERT PROJECTION OF OREGON, SOUTH ZONE

HCE INC./ENGINEERS & PLANNERS
 Coos Bay, Oregon / 375 Park Avenue 97420 / (503) 69-1166
 Portland, Oregon / 19 N. W. 5th Ave. 97209 / (503) 222-1687
 Albany, Oregon / 300 Elsworth St. So. 97321 / (503) 926-0064


















SHEET TITLE
ELECTRICAL SITE PLAN

PROJECT PART OF BANDON
CORVALLIS RIVER BOAT BASIN
 COOS COUNTY OREGON

PROJECT # 2471
 DATE July, 1962

SHEET NO
E1

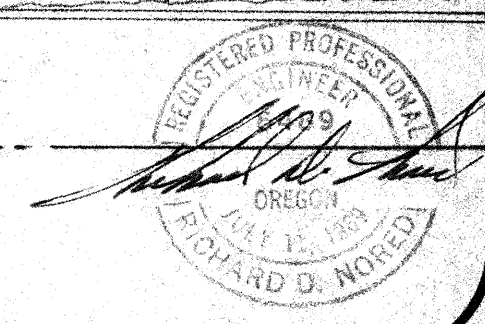

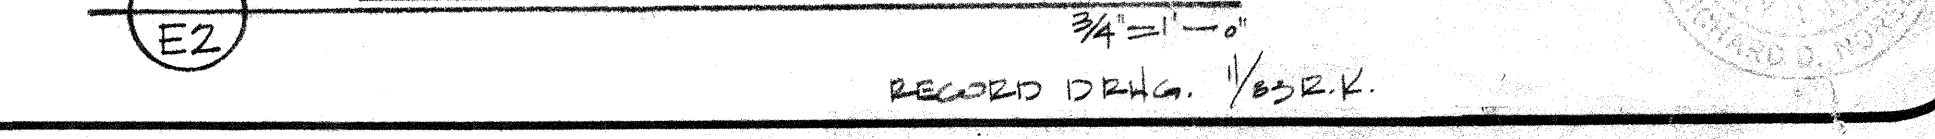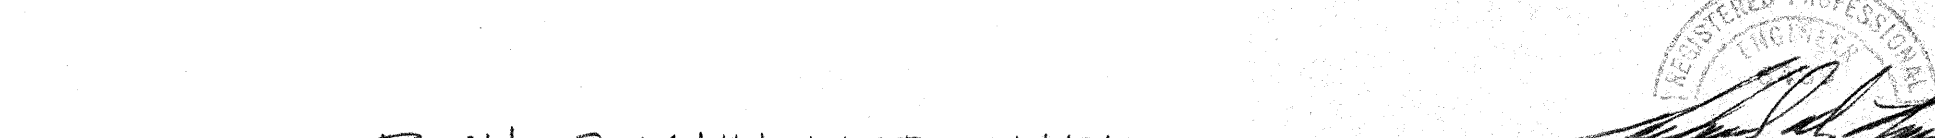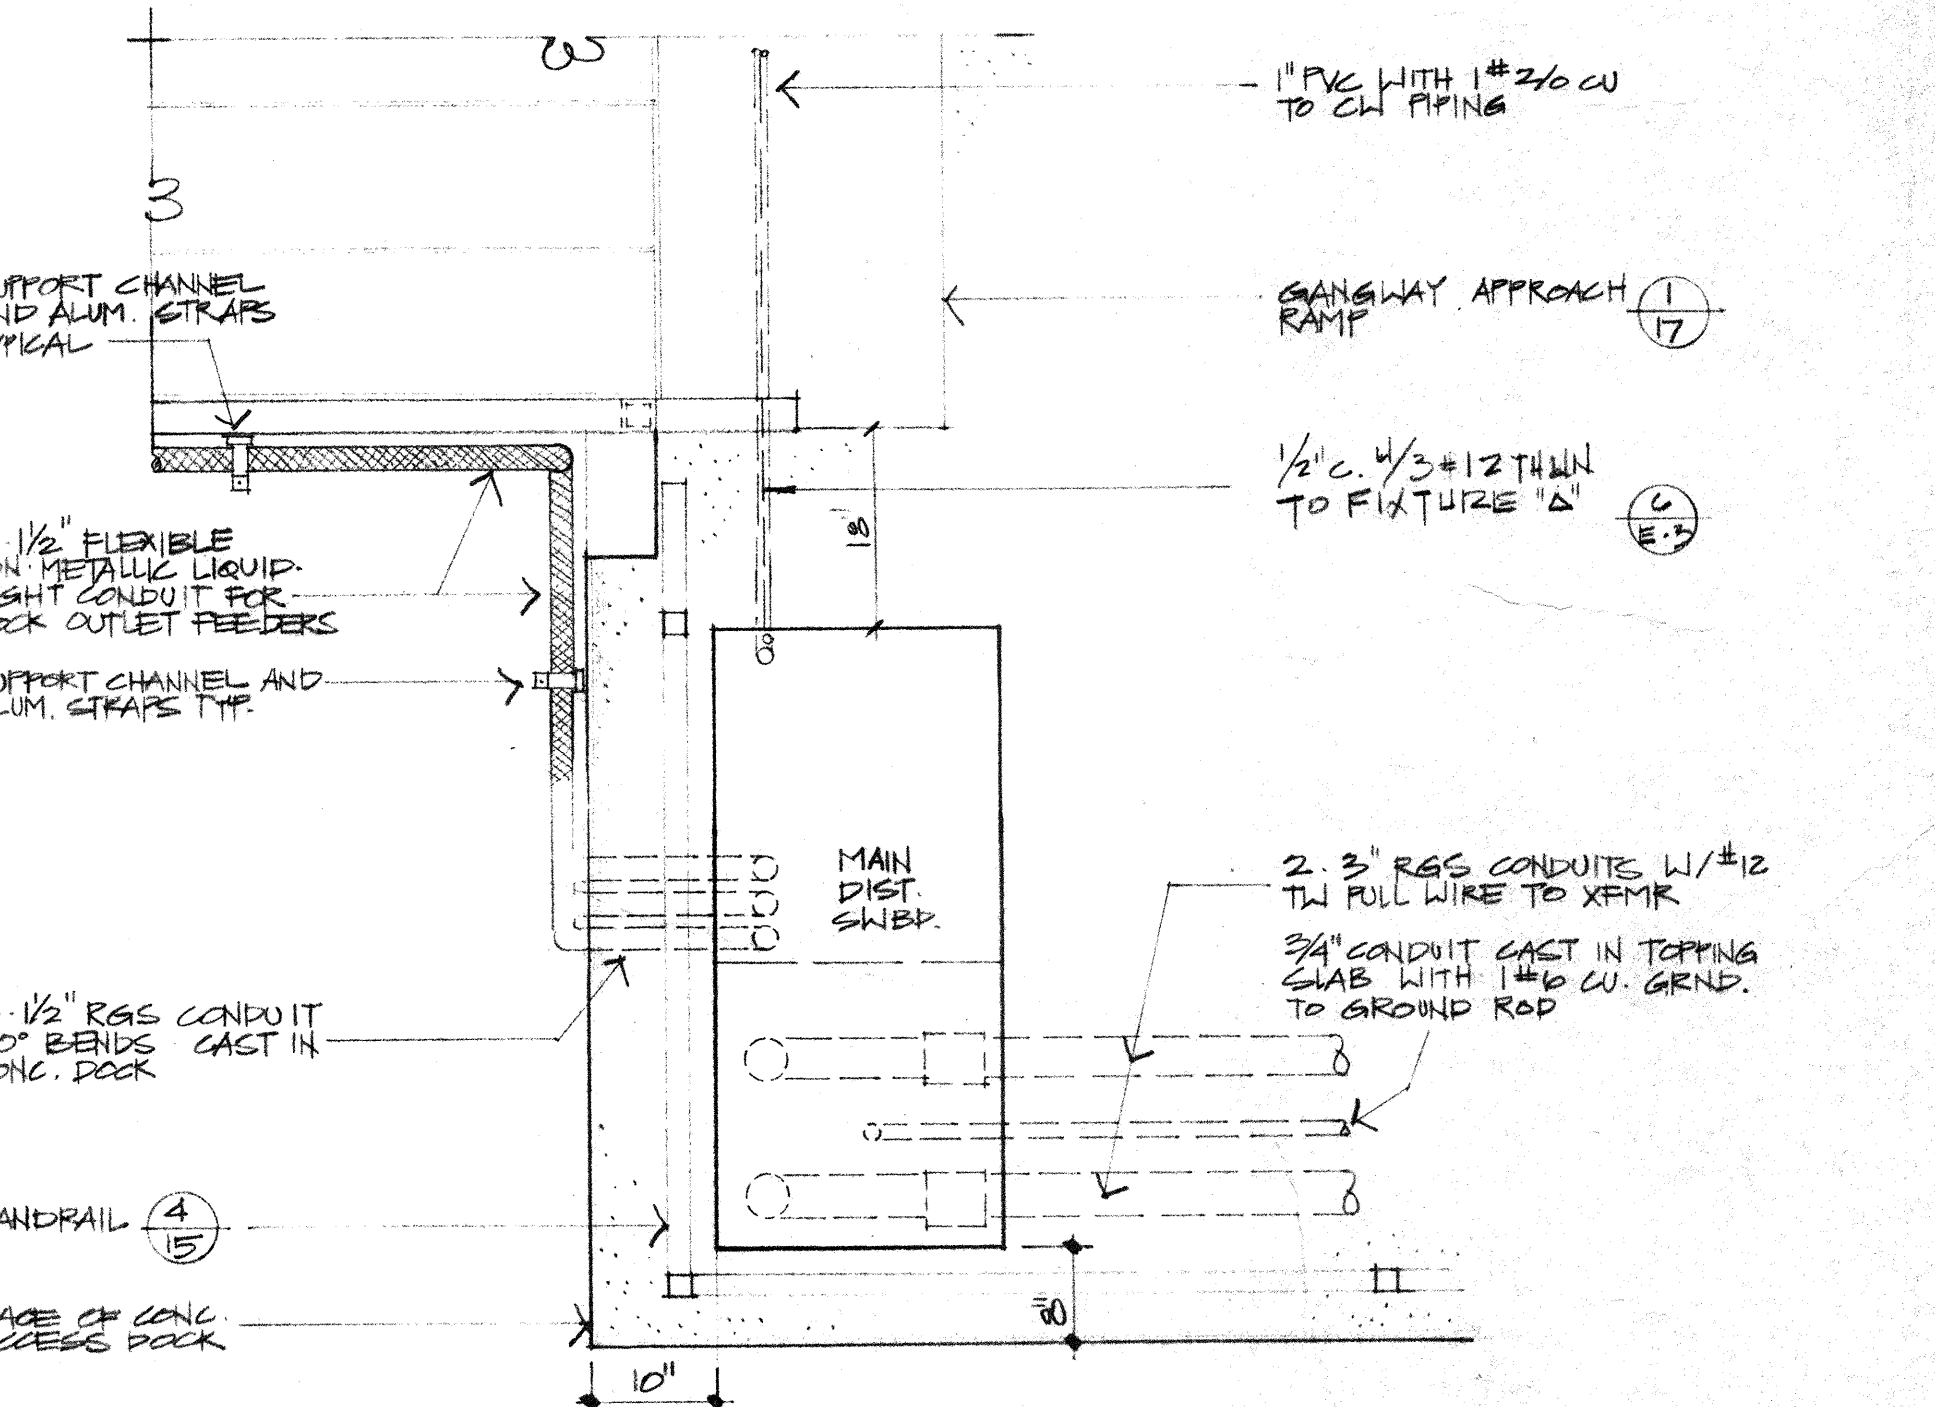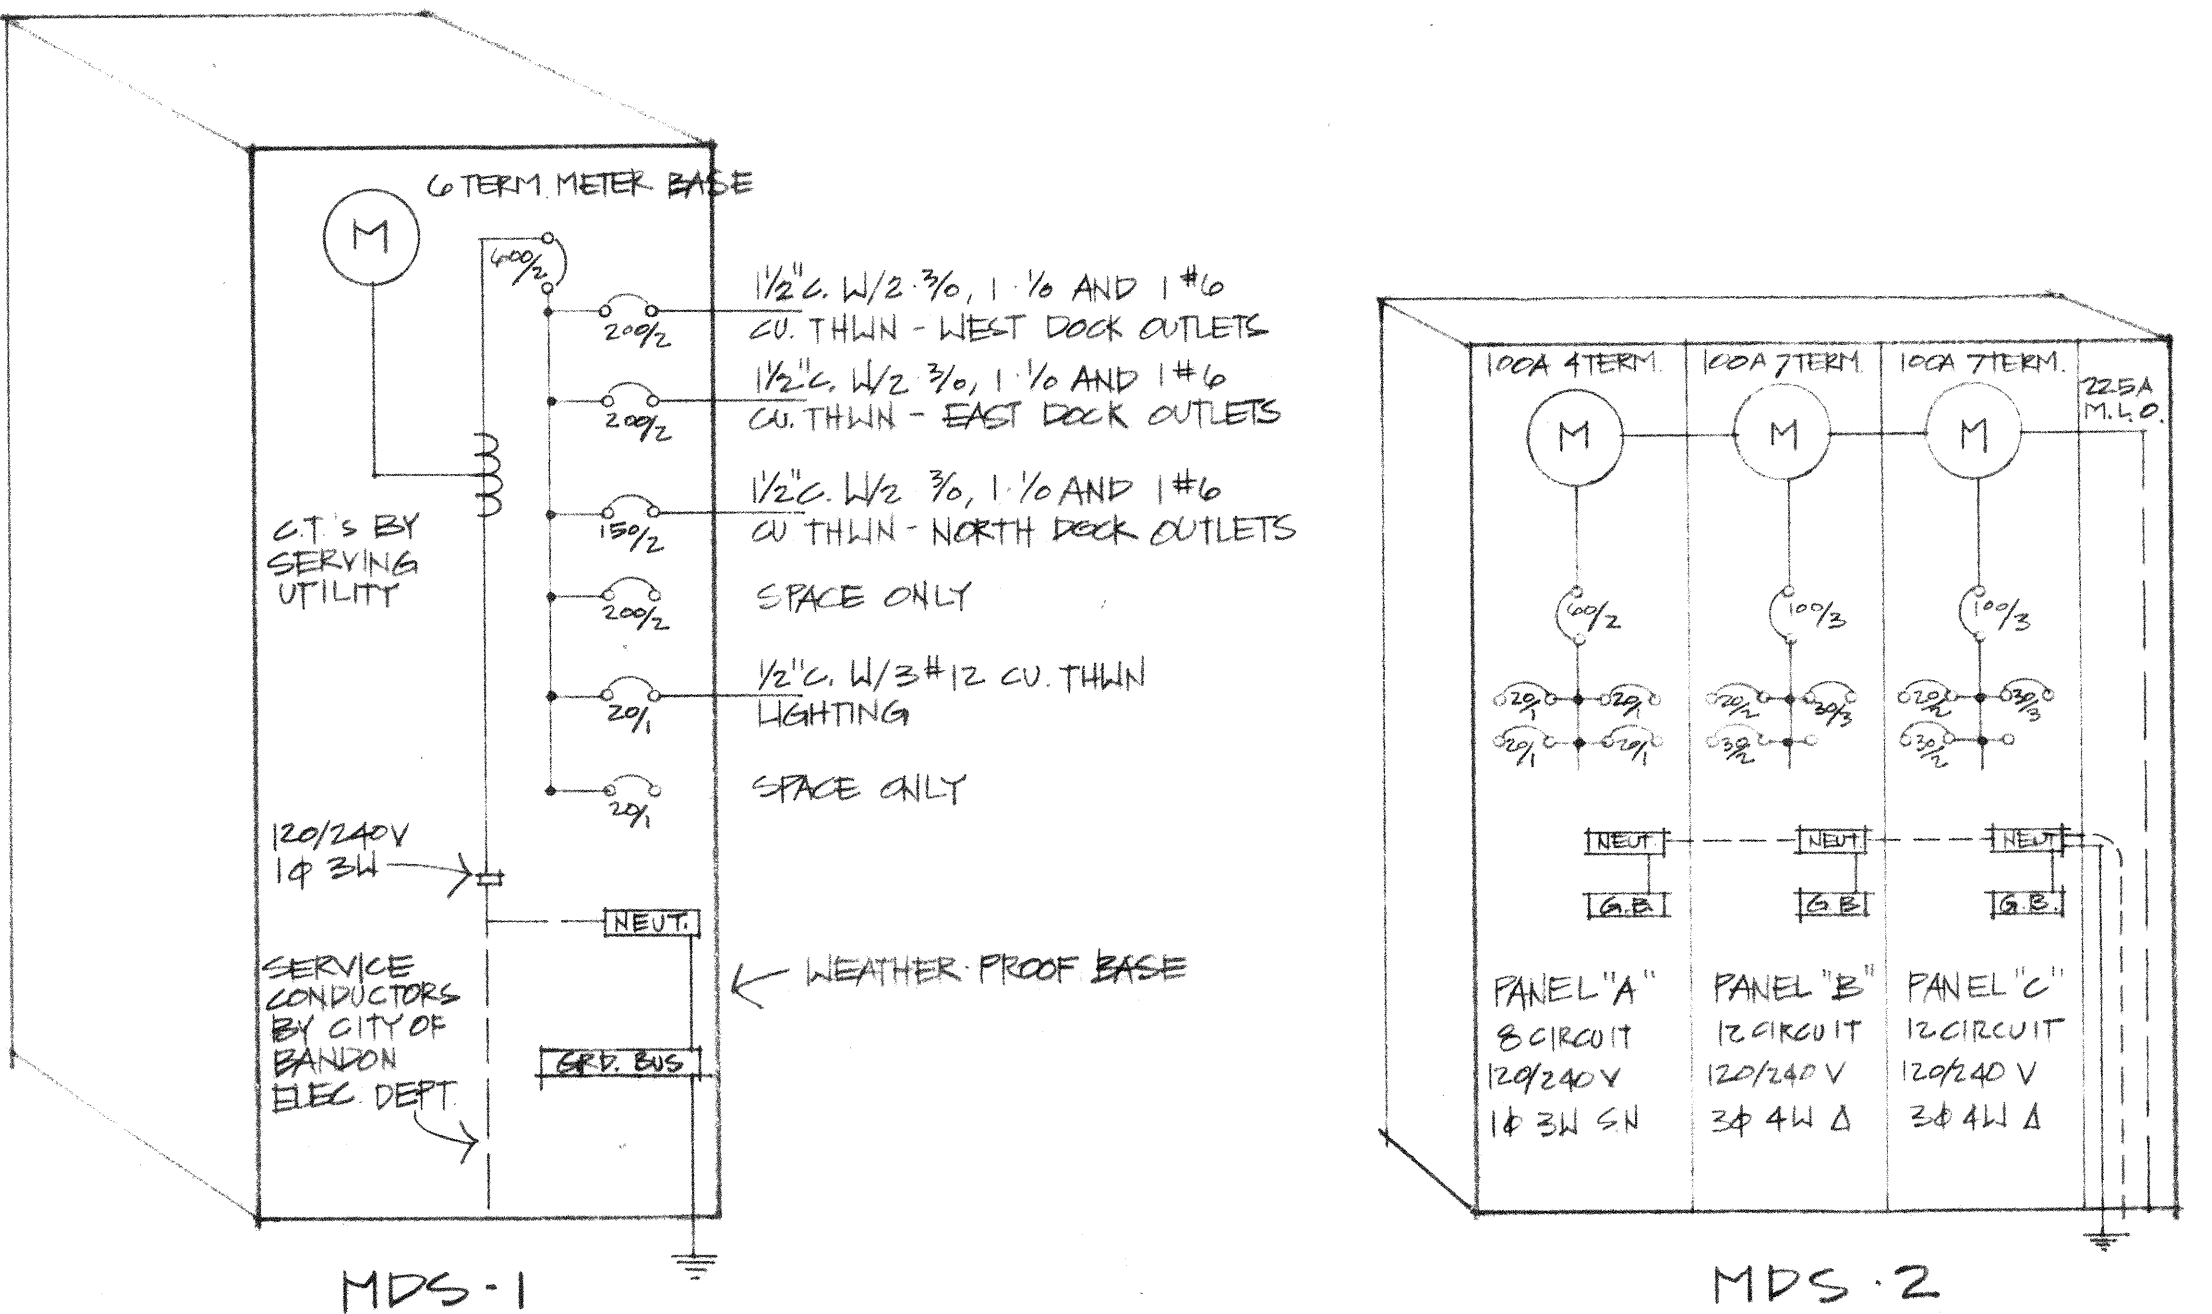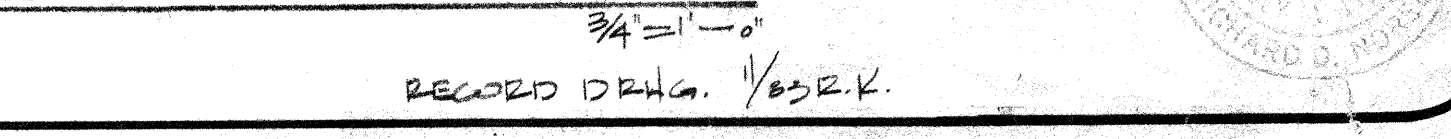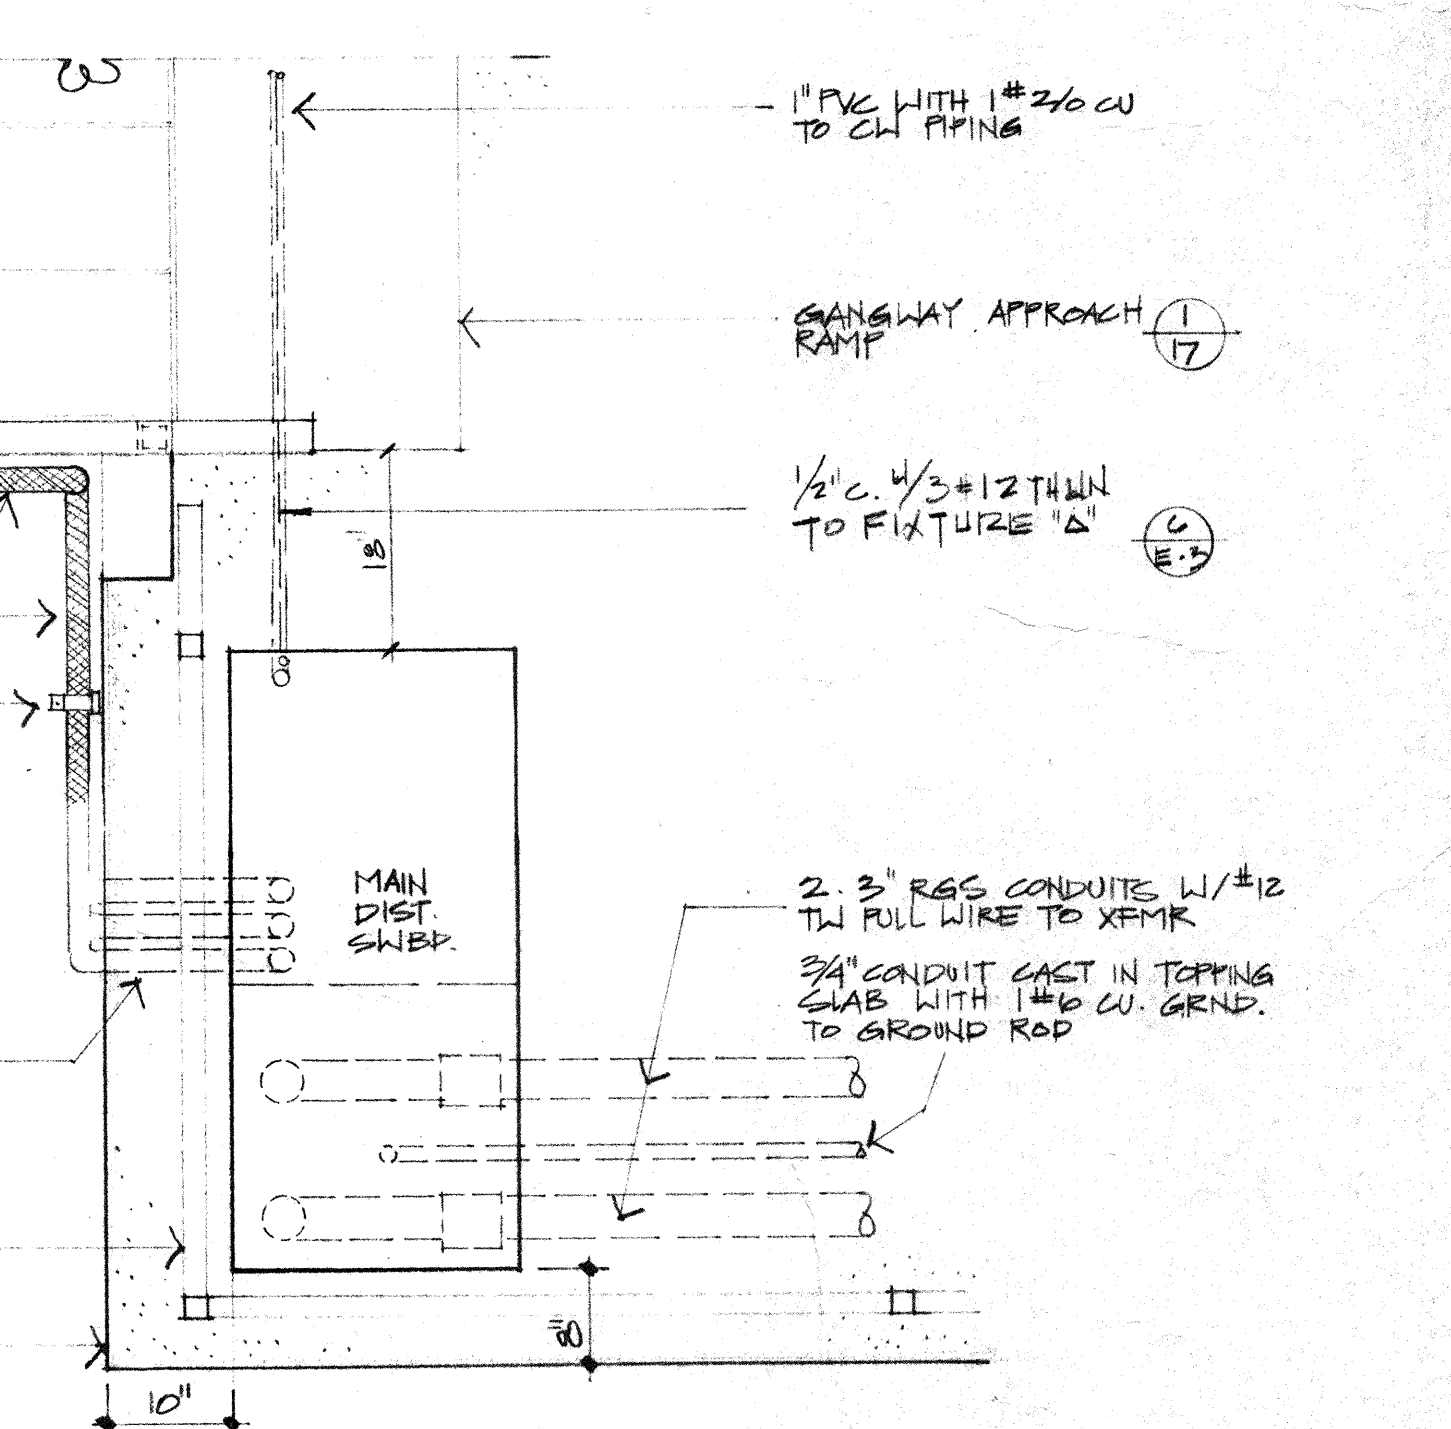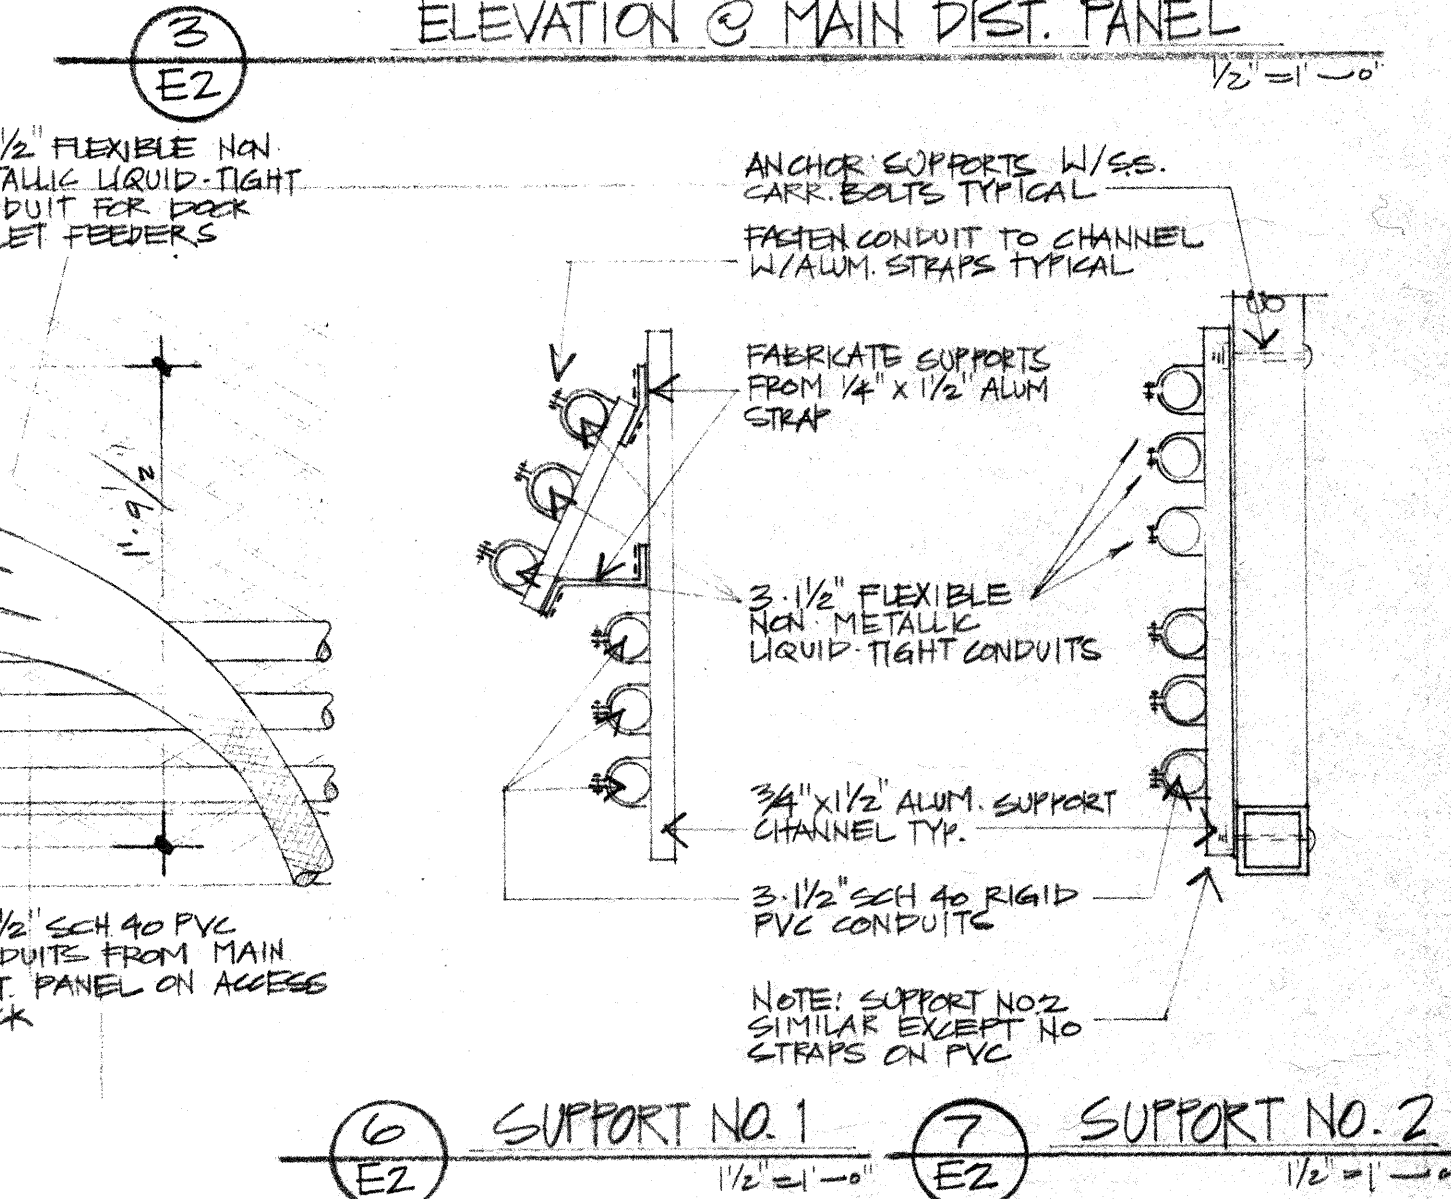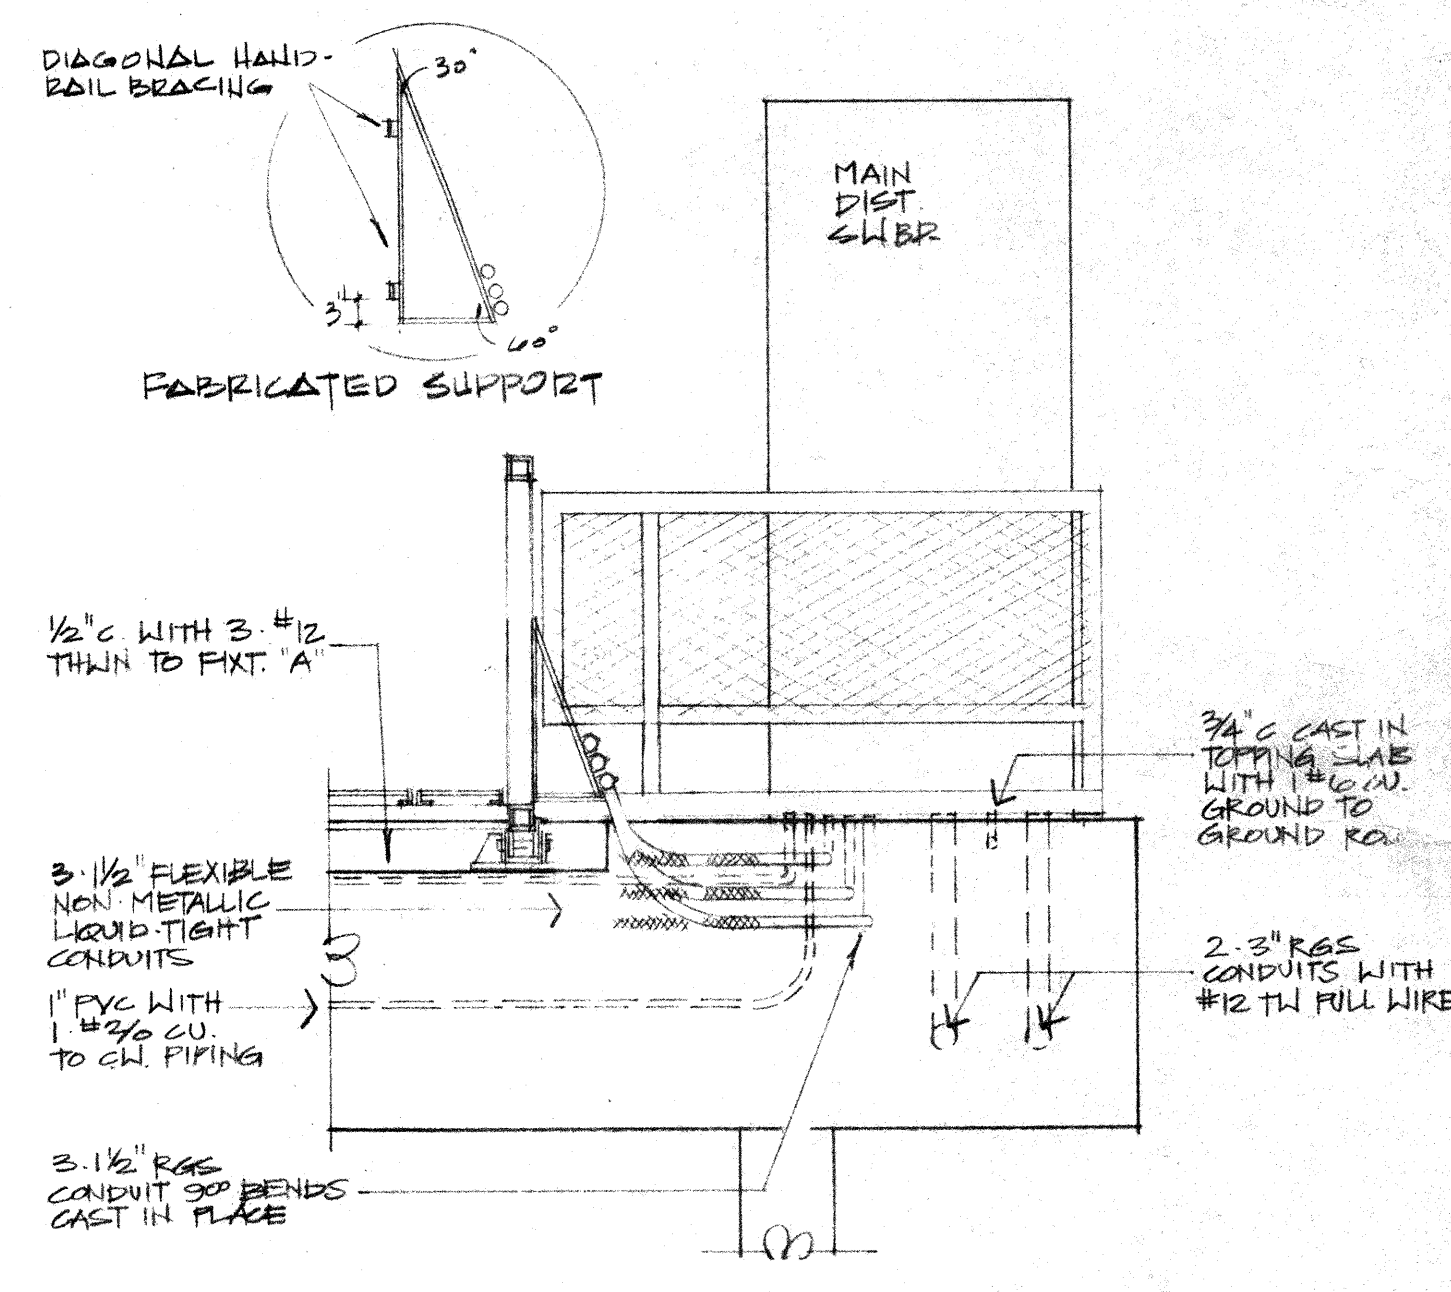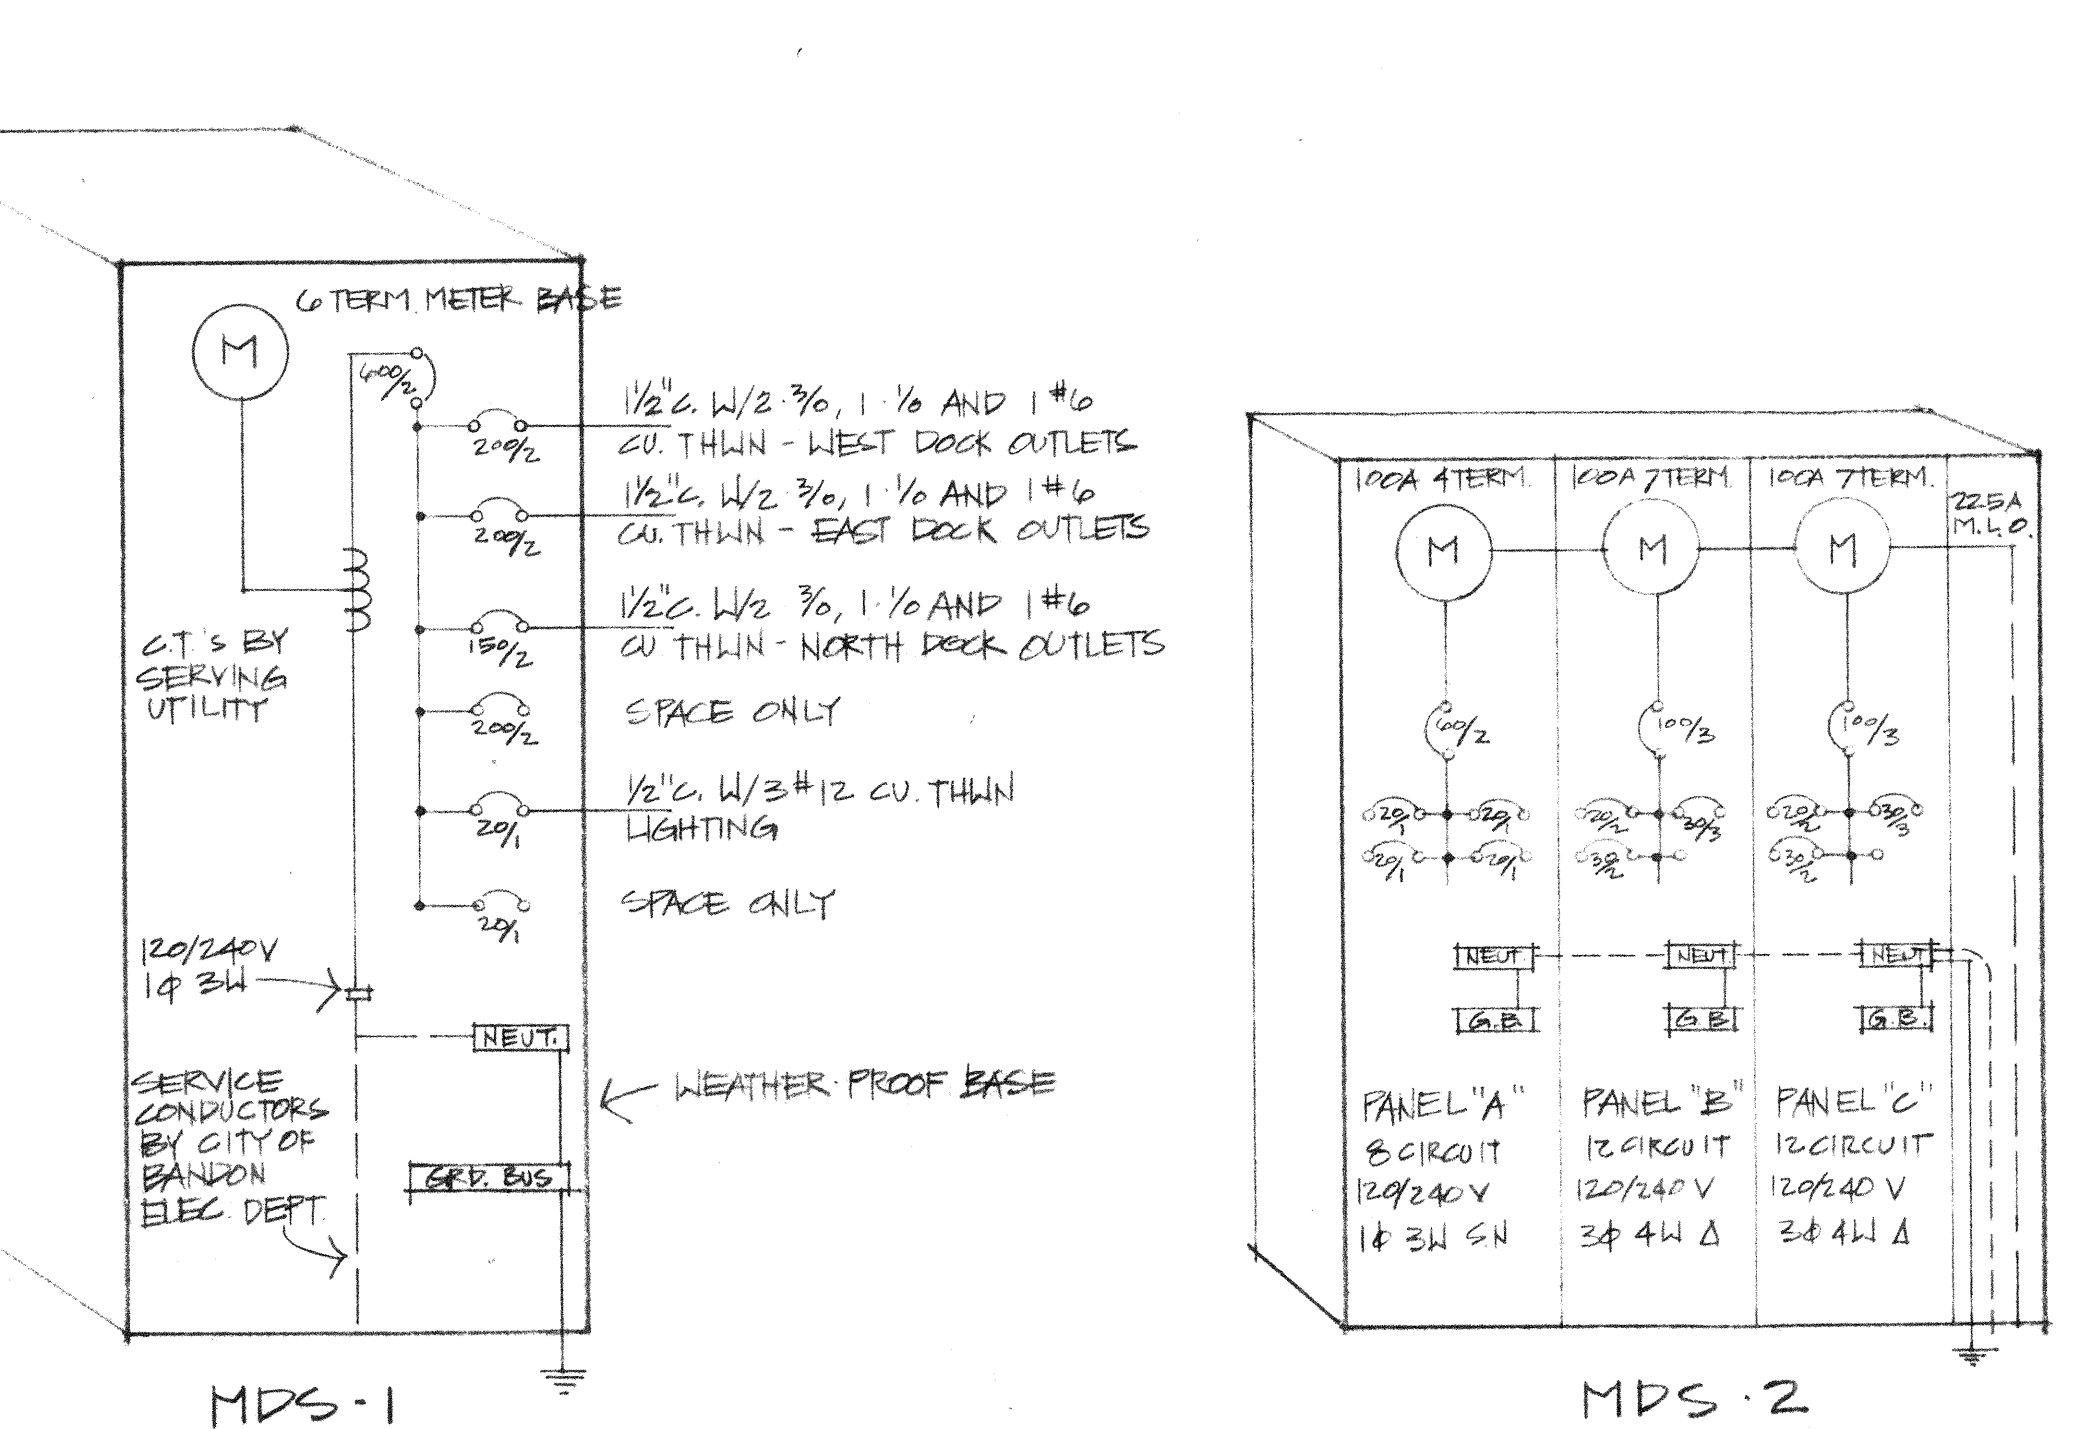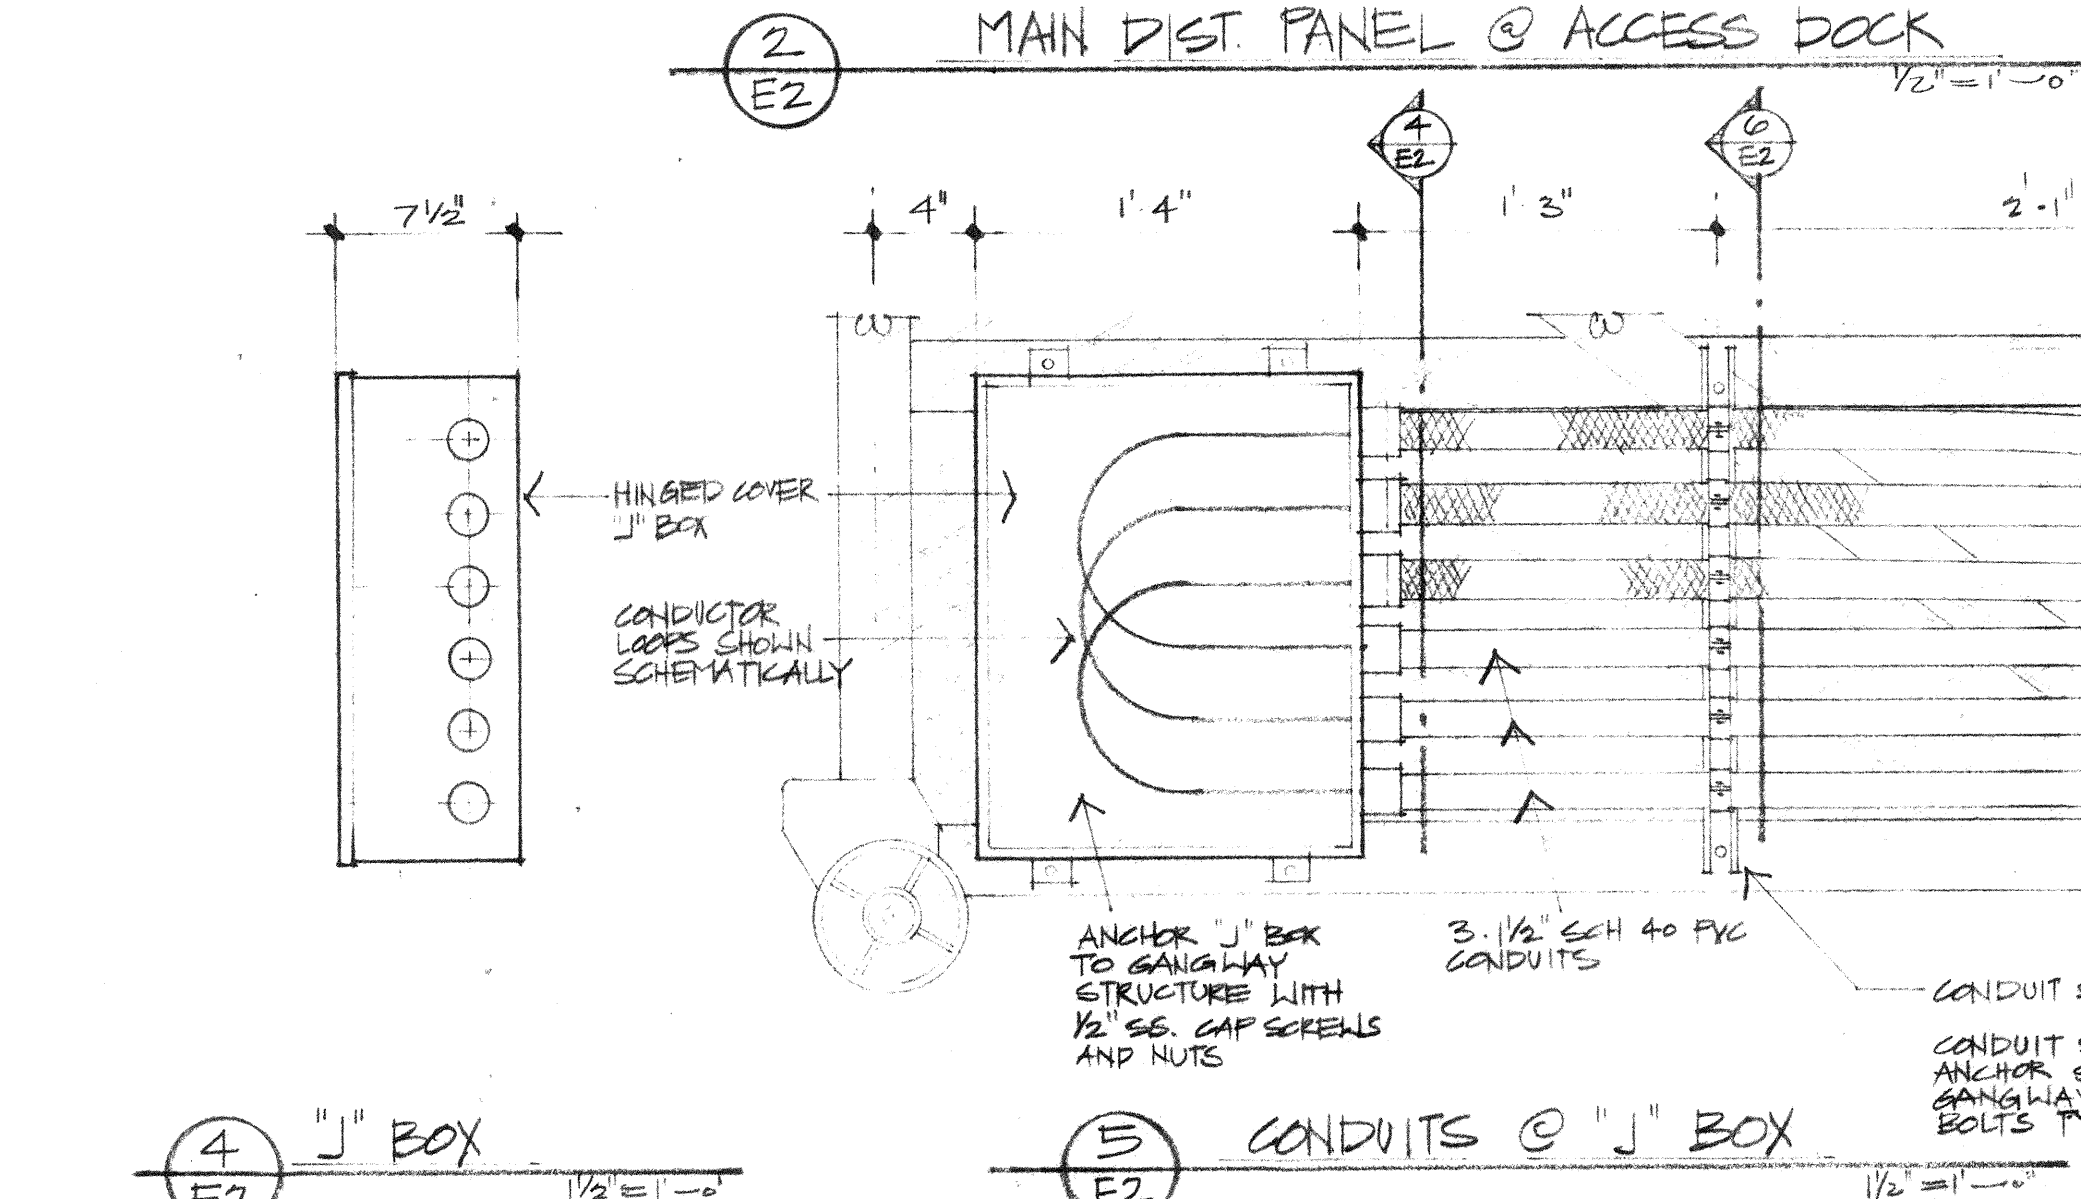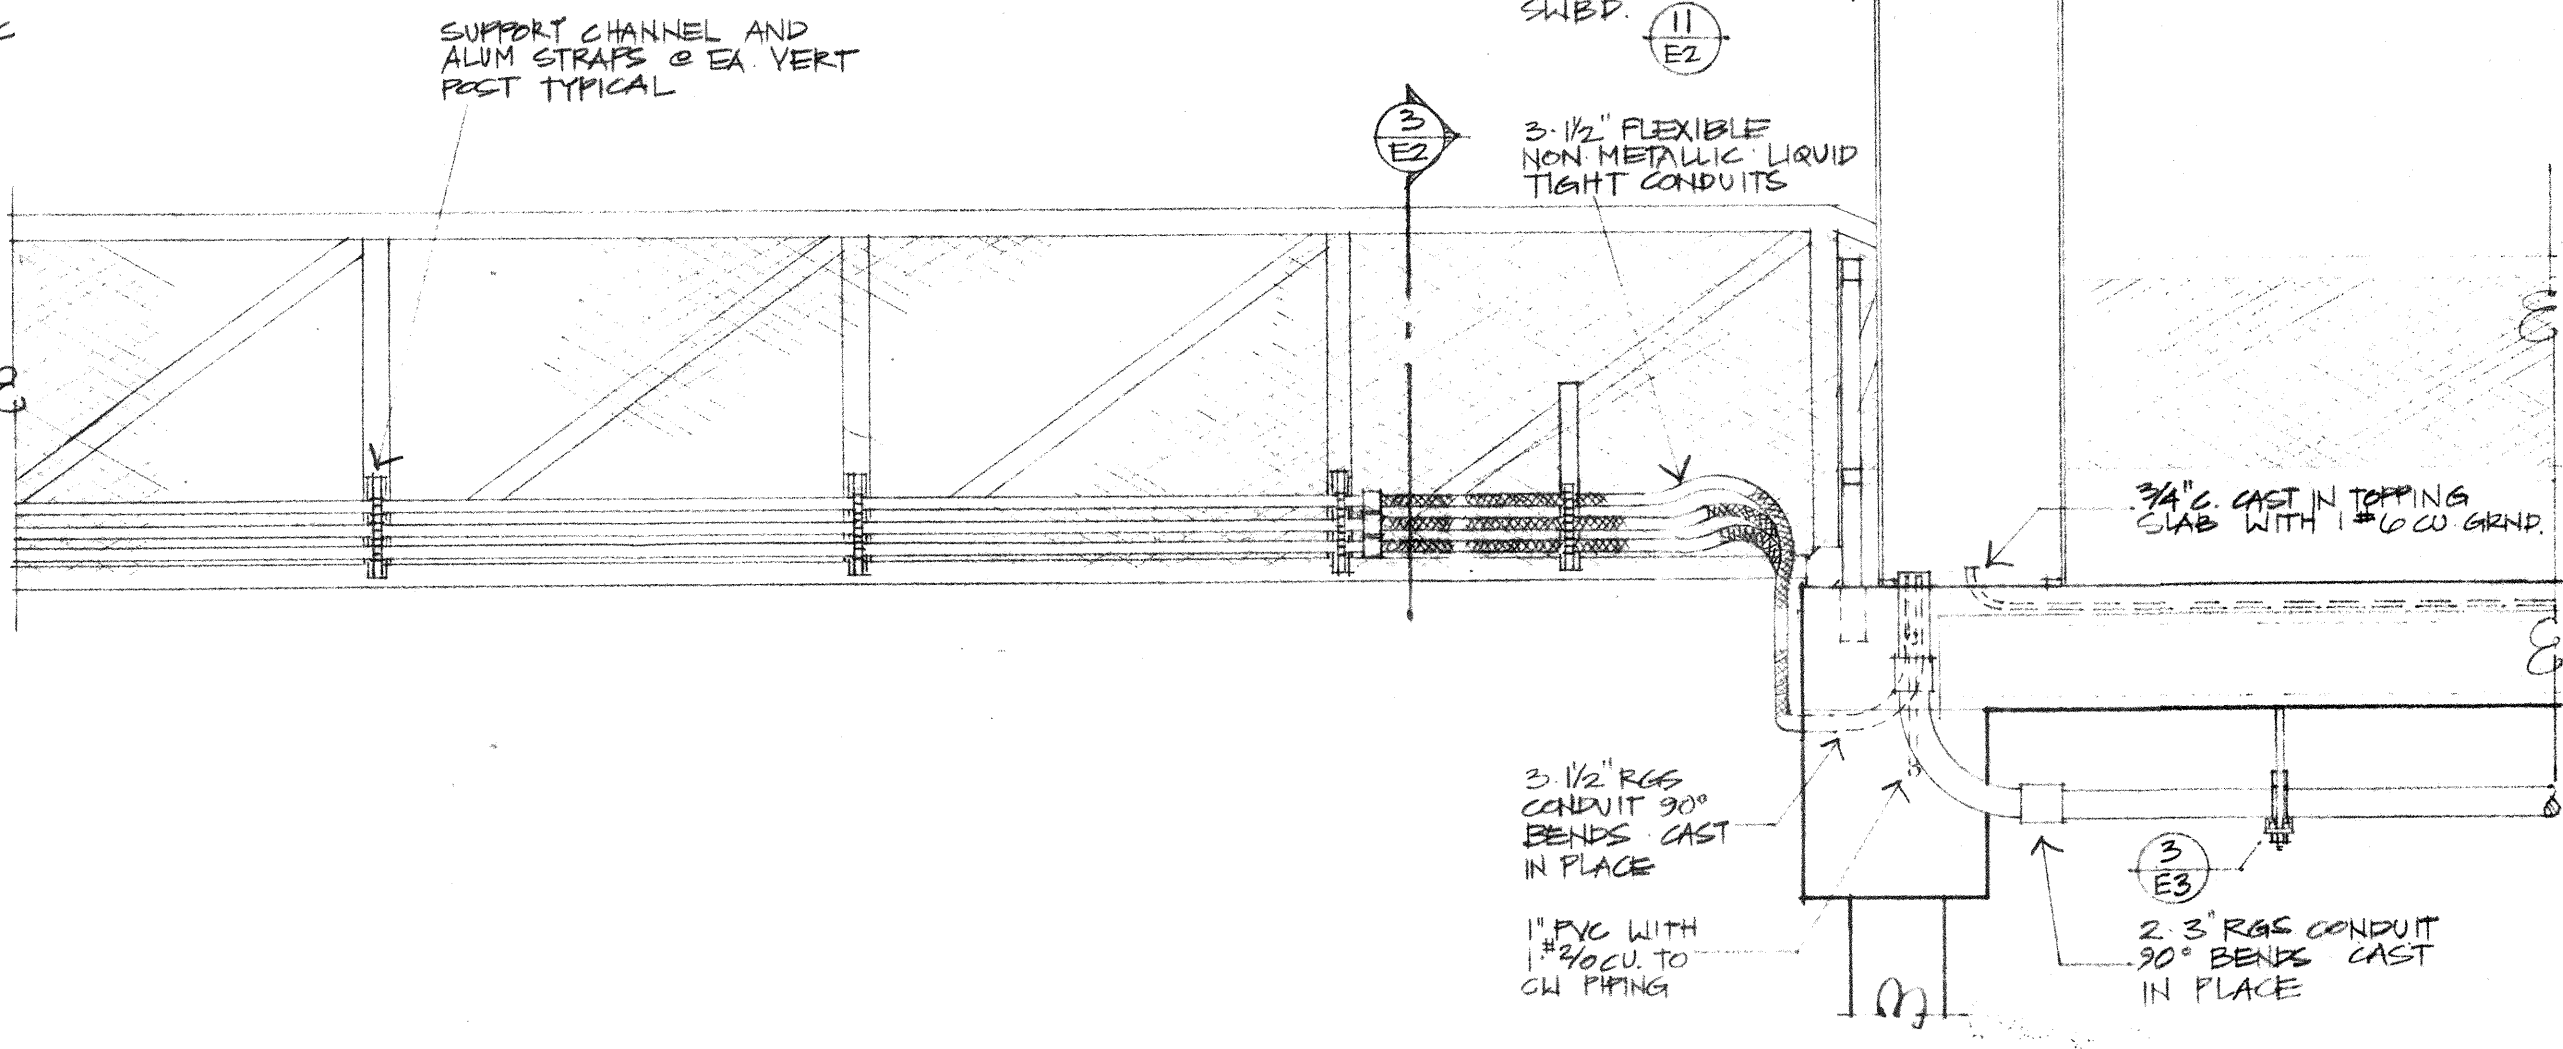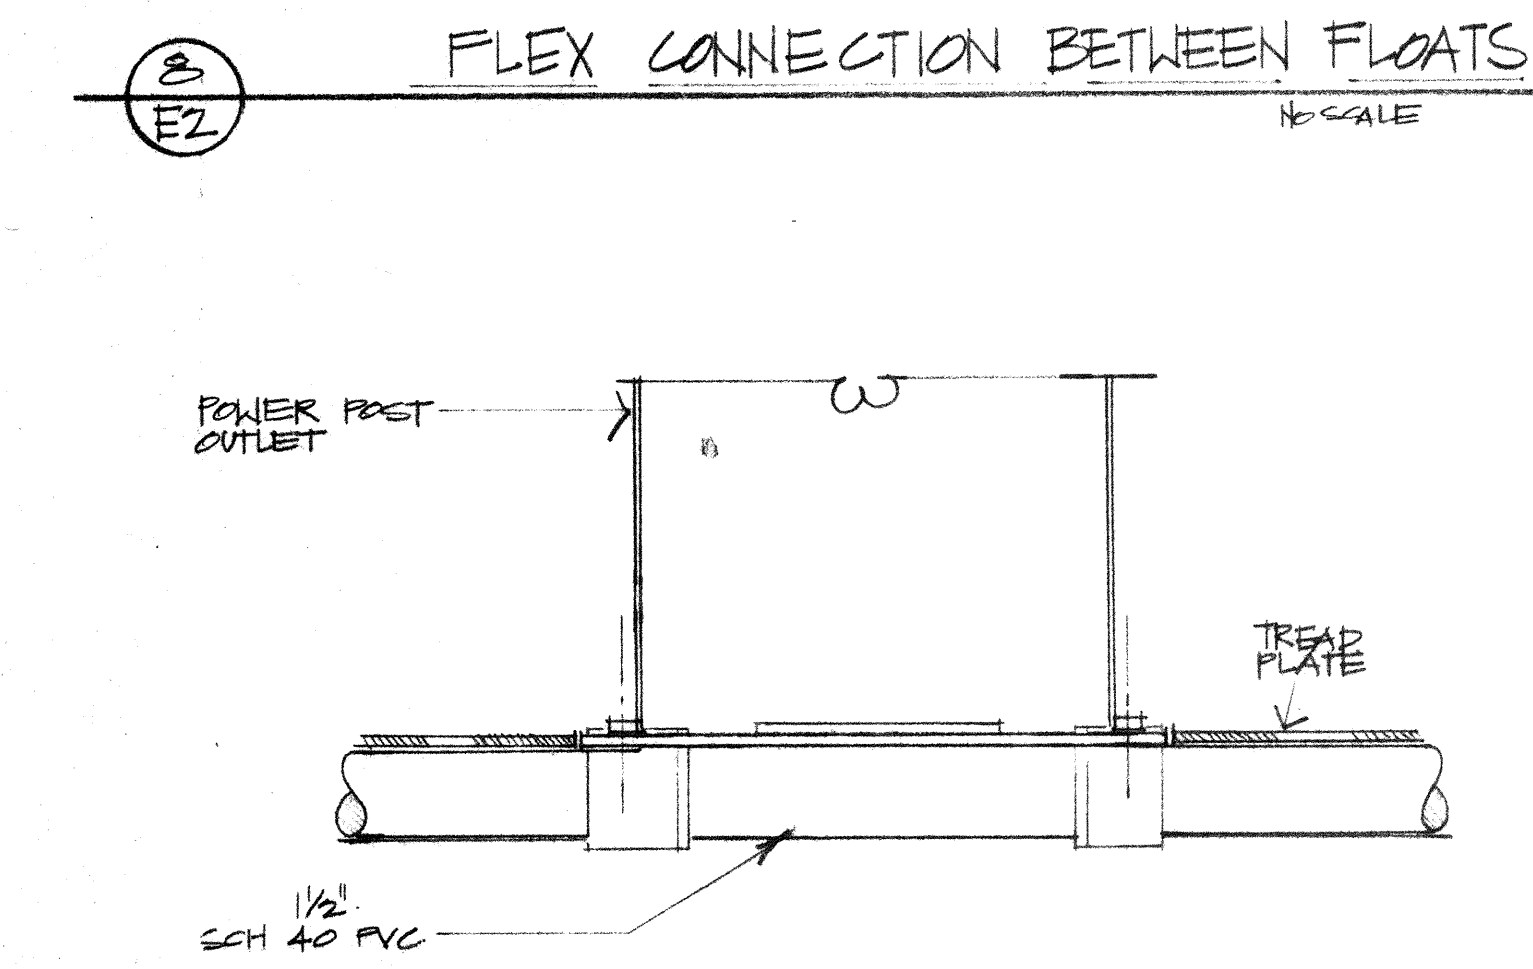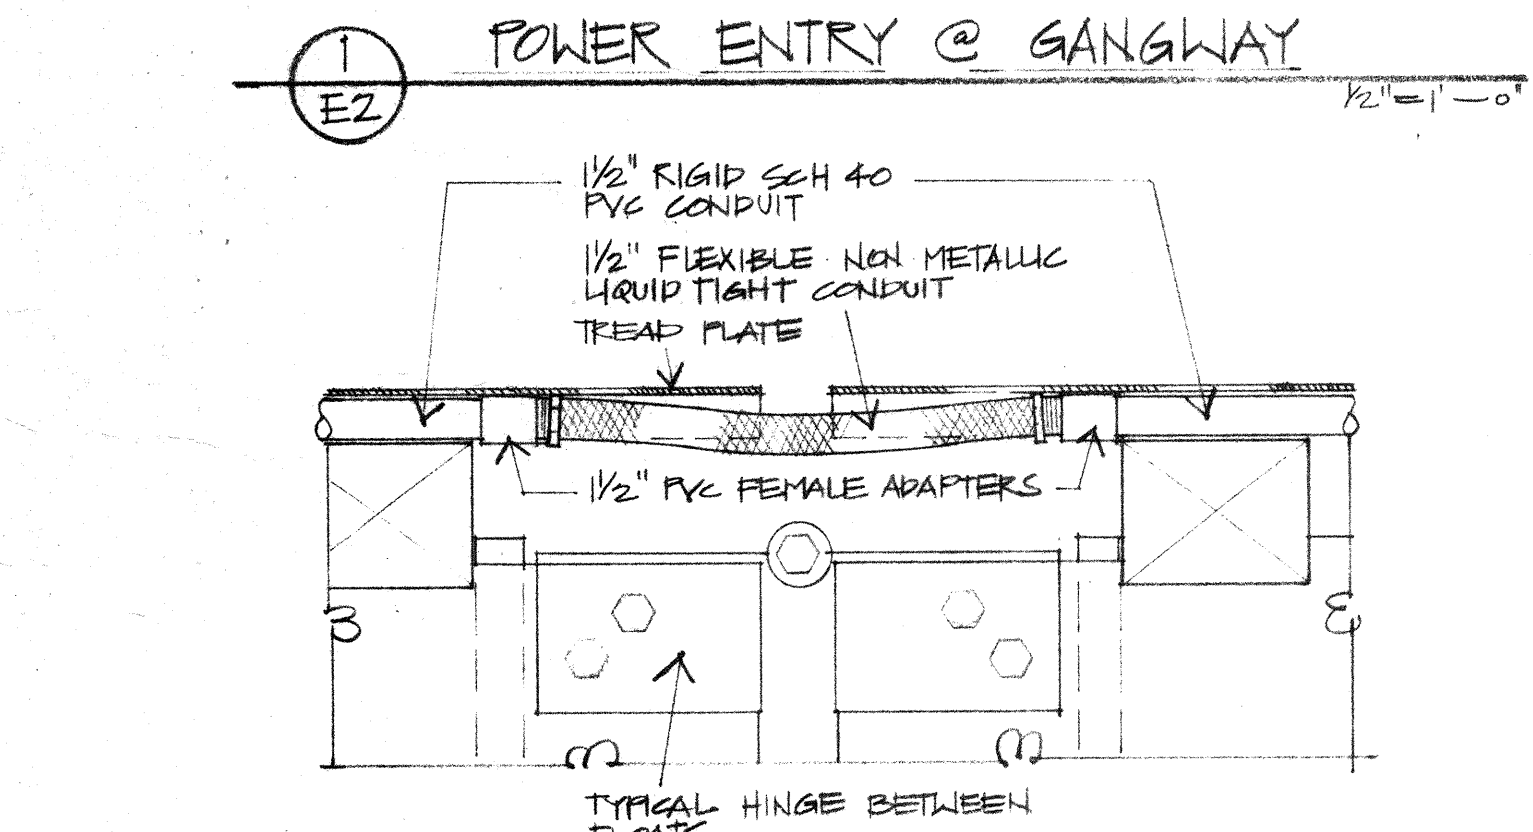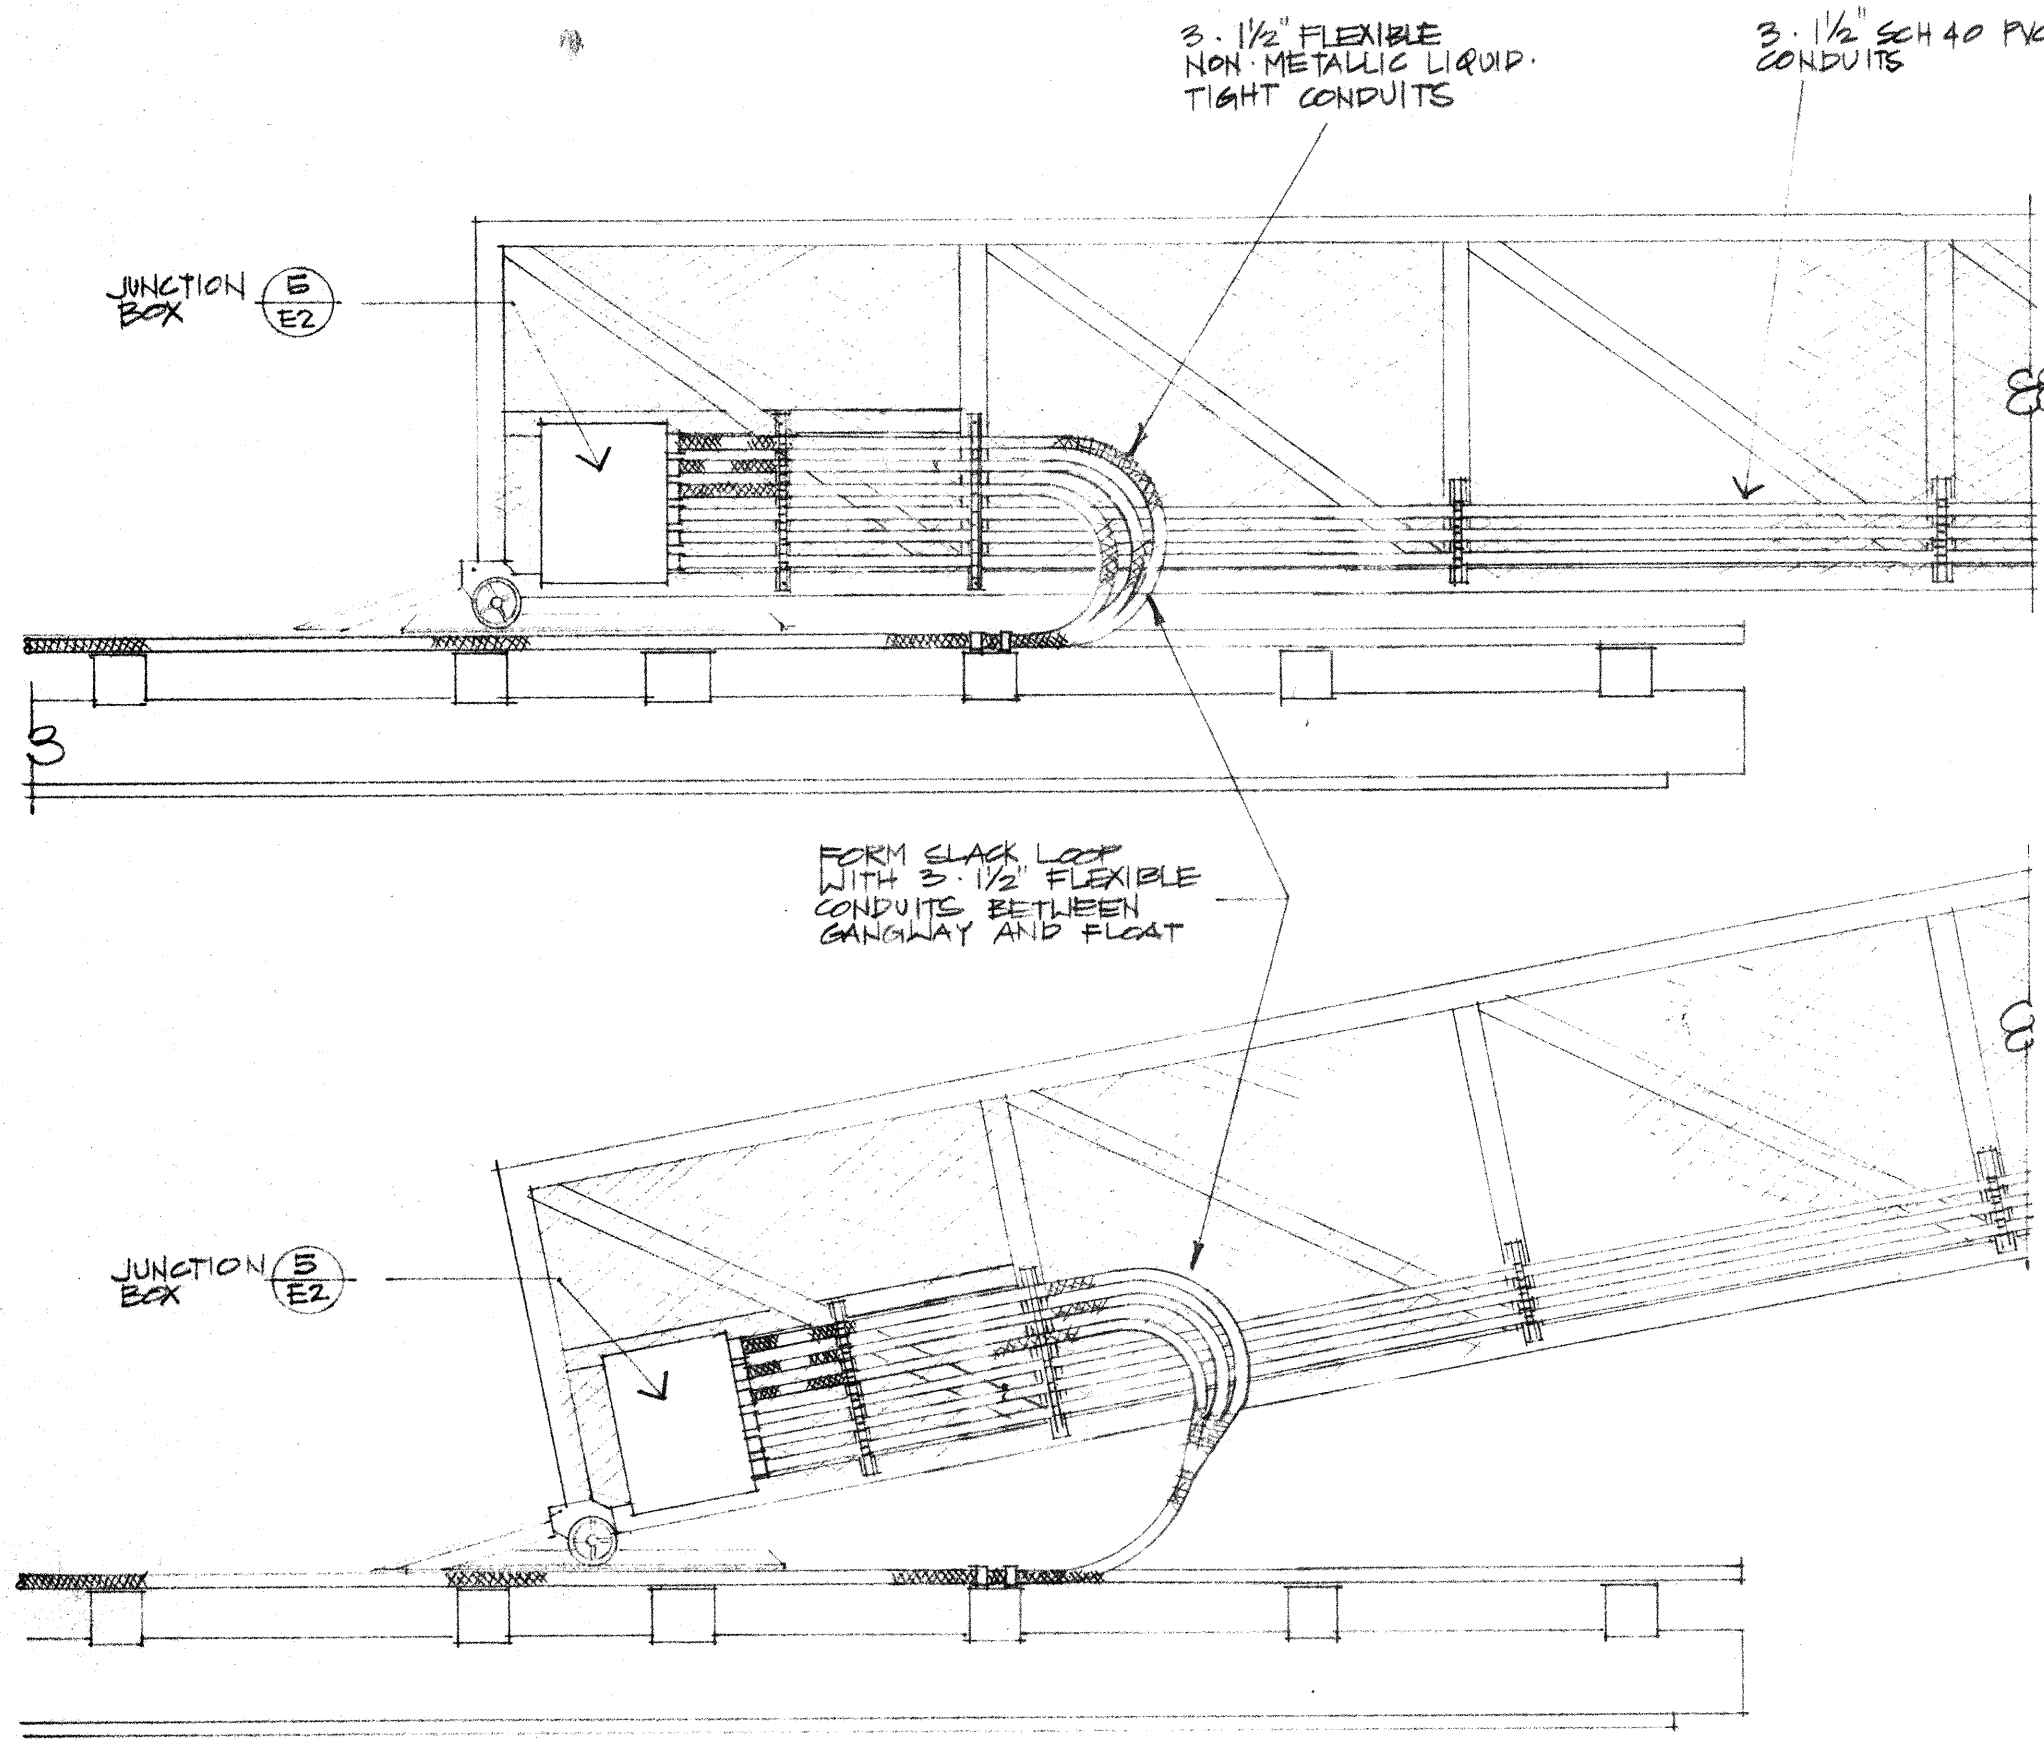

HCE INC./ENGINEERS & PLANNERS
 375 Park Avenue SE
 Portland, Oregon 97204
 Albany, Oregon 97321



SHEET TITLE
 ELECTRICAL DETAILS


PROJECT PORT OF BANDON
 CORVILLE RIVER BOAT BASIN
 COOS COUNTY, OREGON

PROJECT # 2071
 DATE JULY, 1962

SHEET NO. E2



Attachment C: Geologic Map of Bandon

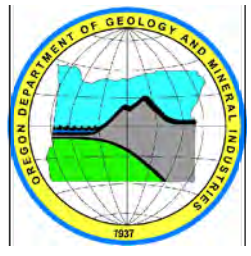

STATE OF OREGON
DEPARTMENT OF GEOLOGY AND MINERAL INDUSTRIES
www.OregonGeology.org
W. Lawrence Givens, Governing Board Chair
Vicki S. McConnell, Director and State Geologist
Andrew V. Fillock, Assistant Director, Geologic Survey and Services
Rachel L. Smith, Project Operations Manager
Ian P. Madin, Chief Scientist

Geologic Map of the Bandon 7.5' Quadrangle, Coos County, Oregon

2014


OPEN-FILE REPORT O-14-01

Geologic Map of the Southern Oregon Coast
Between Port Orford and Bandon,
Curry and Coos Counties, Oregon

By Thomas J. Wiley, Jason D. McLaughry, Lina Ma,
Katherine A. Mickelson, Clark A. Niewendorf, Laura L. Stimeley,
Heather H. Herinckx, and Jonathan Rivas

This project was supported by the U.S. Geological Survey, National
Cooperative Geologic Mapping Program under USGS award number
G13AC00137.

PLATE 3

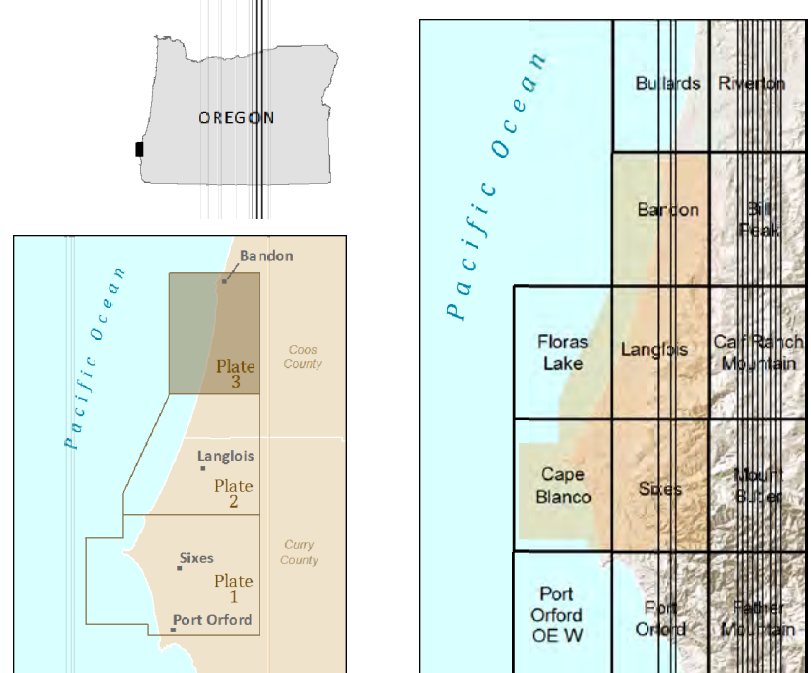

Clockwise starting at top left:
Location map.
Project area, U.S. Geological Survey 7.5-minute quadrangles.
Map plate extent shown with a filled semi-transparent dark brown polygon.

NOTE: These data were mapped at 1:8,000 scale; 1:24,000-scale plates cannot show all the detail of 1:8,000-scale mapping. Please use the geodatabase to explore in full detail.

EXPLANATION OF MAP UNITS

See Explanation of Map Units (in pamphlet) for complete unit descriptions.

UPPER CENOZOIC SURFICIAL DEPOSITS

- ANTHROPOCENE SURFICIAL DEPOSITS**
- At** modern fill and construction material (Anthropocene)
 - Aa** alluvium (Anthropocene)
 - Ala** landslide deposits (Anthropocene)
 - Aaf** debris fan deposits (Anthropocene)
 - Abc** beach and berm deposits (Anthropocene)
 - Ada** foredune deposits (Anthropocene)
- ANTHROPOCENE AND HOLOCENE SURFICIAL DEPOSITS**
- Ahcl** coastal lacustrine deposits (Anthropocene and Holocene)
 - Ahcm** coastal marsh deposits (Anthropocene and Holocene)
 - Ahdu** unvegetated dune deposits (Anthropocene and Holocene)
 - Ahfv** vegetated dune deposits (Anthropocene and Holocene)
 - Ahmp** deflation plain sand (Anthropocene and Holocene)

HOLOCENE SURFICIAL DEPOSITS

- Ha** alluvium (Holocene)
- Haf** alluvial fan deposits (Holocene)
- Hdf** debris fan deposits (Holocene)
- Hls** landslide deposits (Holocene)

QUATERNARY SURFICIAL DEPOSITS

- Qls** landslide deposits (Holocene and upper Pleistocene)
- Qds** upland coastal dune deposits (Holocene and upper Pleistocene)

Fluvial terrace deposits and strath terraces (upper Pleistocene)

- Qnt1** fluvial terrace sediments 1 (upper Pleistocene)
- Qnt2** fluvial terrace sediments 2 (upper Pleistocene)

Coastal marine terrace deposits (Pleistocene)

- Qmwh** Whiskey Run terrace sediments (north of Floras Creek, upper Pleistocene, ~80 ka)
- Qmp** Pioneer terrace sediments (upper Pleistocene, ~105 ka)
- Qm7d** Seven Devils terrace sediments (north of Floras Creek, upper Pleistocene, ~125 ka)

Unconformity

LOWER PLEISTOCENE AND MIOCENE ROCKS

MIOCENE SEDIMENTARY ROCKS

- Tmc** diatomite of China Creek (upper Miocene, Messinian Stage)
- Tme** Empire Formation (upper Miocene, Wisshakan and Newportian Pacific Northwest Molluscan Stage)

Unconformity

- Tef** sandstone of Floras Lake (lower and middle Miocene, Wisshakan and Newportian Pacific Northwest Molluscan Stages)

Unconformity

LOWER CENOZOIC AND MESOZOIC ROCKS

PALEOGENE SEDIMENTARY ROCKS

- Tau** Umpqua Group (lower to middle Eocene)

Unconformity (?)


SIXES RIVER TERRANE

Fulmar (central) subterrane

- Tefm** sandstone of Fivemile Point (lower Eocene)


Unconformity

- Kjs** melange of Sixes River (Upper?T) Cretaceous to Jurassic)
- Kas** sandstone
- Kav** volcanic and meta-volcanic rocks
- Kac** chert
- Knb** blueschist
- Kng** conglomerate
- Khg** garnet schist
- Kgl** coarse-grained igneous rocks
- Ksm** other metamorphic rocks
- Khp** serpentinite and meta-serpentinite
- Kal** siltstone
- Kax** melange blocks, undivided

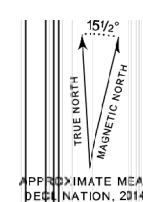

SCALE 1:24,000 (1 inch equals 2,000 feet)

Contour interval is 40 feet.

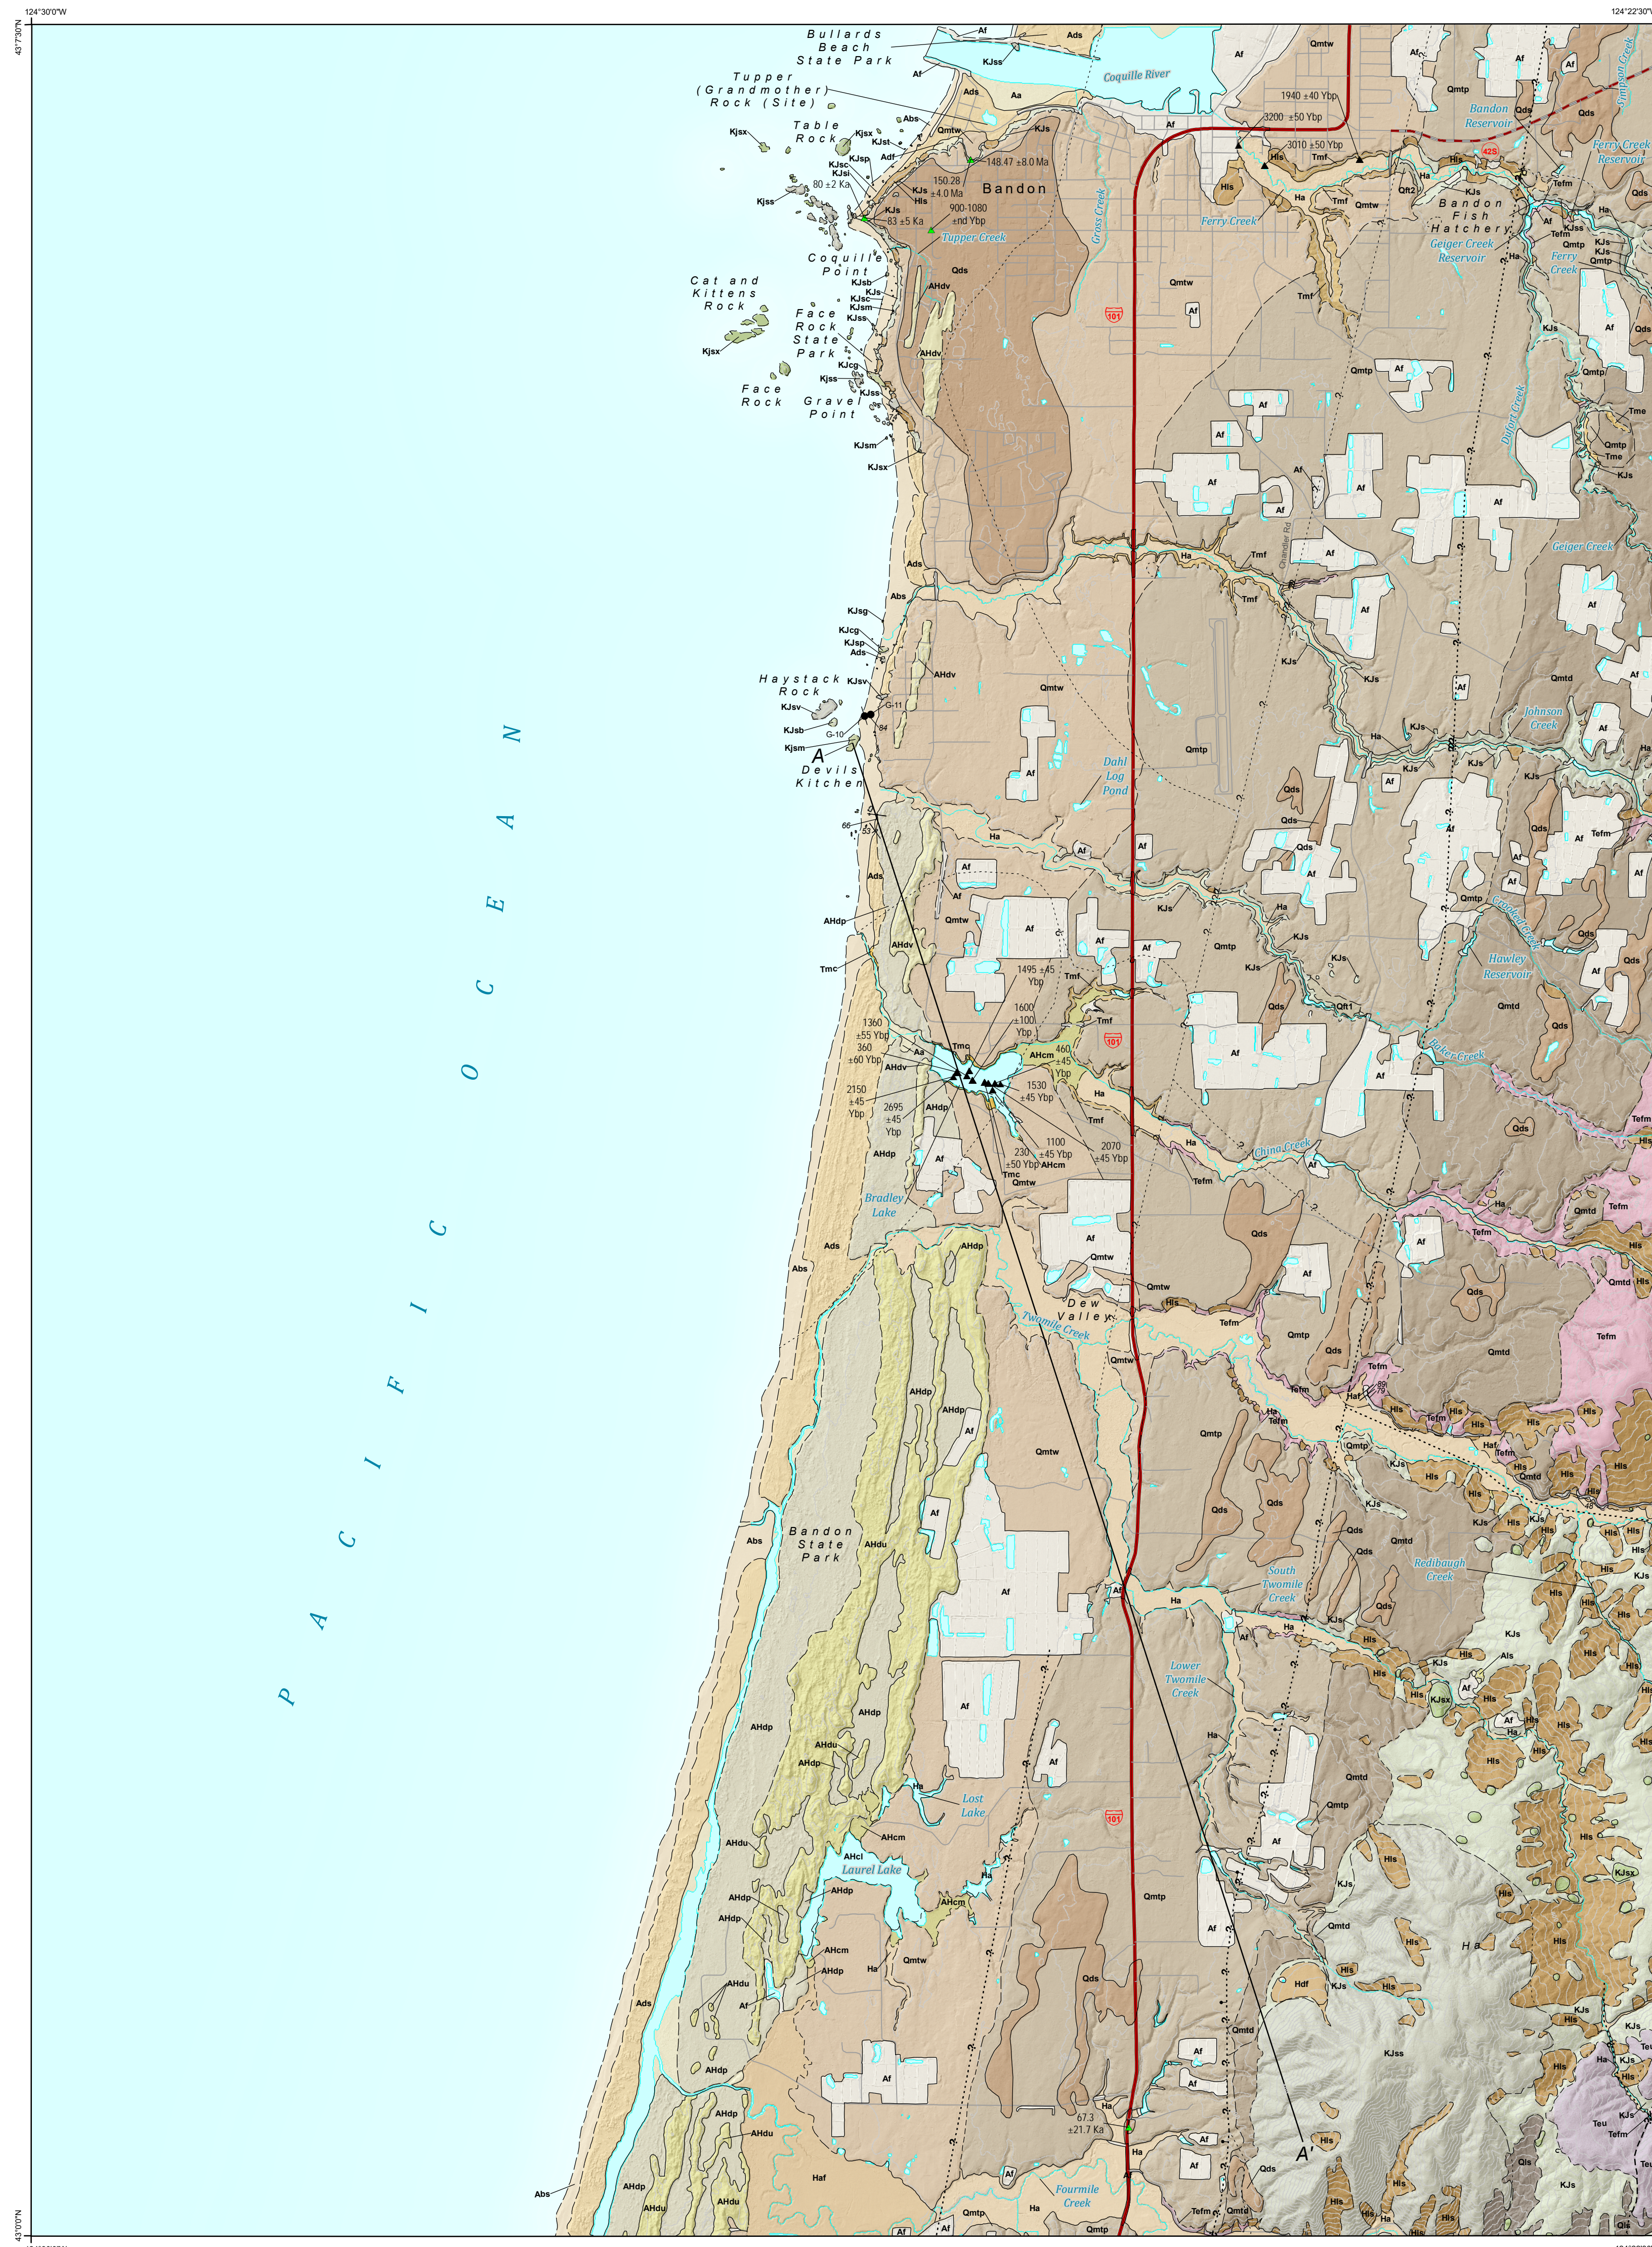


EXPLANATION OF SYMBOLS FOR ALL MAP PLATES

- Waterbody
- Stream
- Road
- State Highway
- U.S. Highway
- Cross Section
- Litar-derived elevation
- Location of whole-rock XRF geochemical analysis sample (see Table 2 in pamphlet)
- Incline bedding-Showing strike and dip
- Vertical bedding-Showing strike
- Overturned bedding-Showing strike and dip
- Inclined metamorphic or tectonic foliation-Showing strike and dip
- Location of radiometric age obtained from subsurface core sample. Only the uppermost or youngest age is labeled on the map. Age in thousands of years (Ka) or years before present (Ybp). See geodatabase for complete data.
- Location of radiometric age (Age in millions of years (Ma), thousands of years (Ka), or years before present (Ybp)). See geodatabase for complete data.
- Contact — solid line where accurately located, long-dashed where approximate, short-dashed where inferred, dotted where uncertain.
- Fault — solid line where accurately located, long-dashed where approximate, short-dashed where inferred, dotted where concealed, querted where uncertain.
- Normal fault — ball and bar on downthrown block; solid line where accurately located, long-dashed where approximate, short-dashed where inferred, dotted where concealed, querted where uncertain.
- Strike-slip fault, right-lateral offset — short-dashed where inferred, dotted where concealed, querted where uncertain. Arrows show relative motion. Arrows show relative motion.
- Oblique-slip fault, right-lateral offset — short-dashed where inferred, dotted where concealed, querted where uncertain. Arrows show relative motion. Ball and bar on downthrown block.
- Thrust fault — long-dashed where approximate, short-dashed where inferred, dotted where concealed, querted where uncertain. Sawtooth on upper (tectonically higher) plate.

GEOLOGIC CROSS SECTION

Selected Quaternary units not shown in cross section.

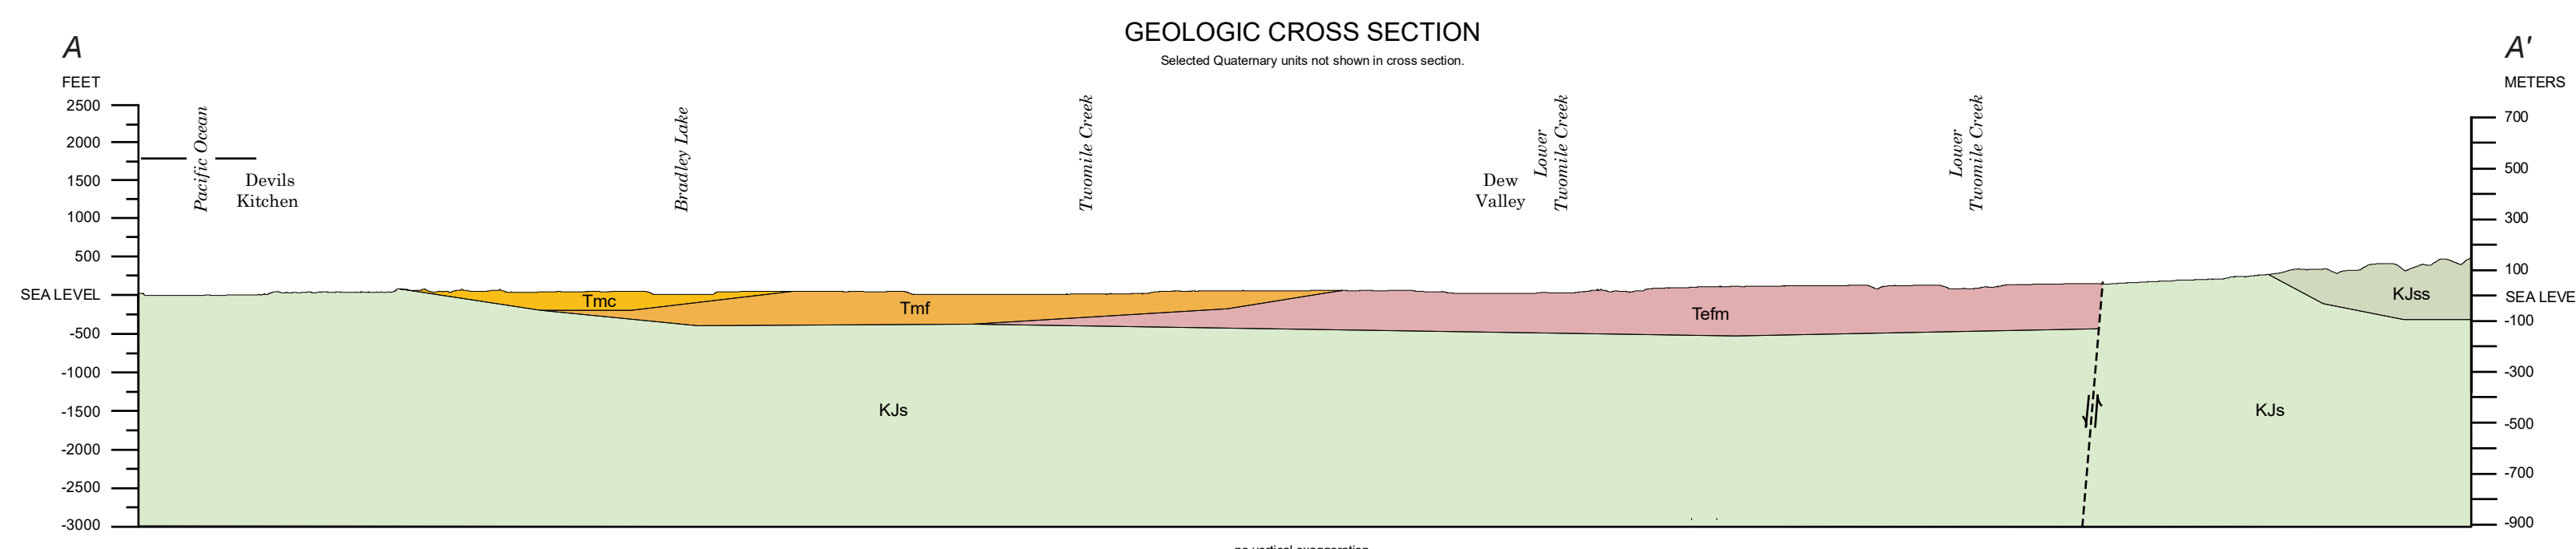

Source Data: DOGAMI Lidar Data Quadrangles LDQ-2009-43121-A4-Bandon. Geologic data, water features (mapped to lidar extent), and 10-m digital elevation models from Oregon Department of Geology and Mineral Industries (2014). Transportation data are from Curry and Coos Counties (2010) and were edited by DOGAMI to improve spatial accuracy of features or to add newly constructed features not present in the original data layer.

Projection: Oregon Statewide Lambert Conformal Conic, Unit: International Foot, Horizontal Datum: NAD 1983 HARN.

Software: Esri ArcGIS 10.1 and Adobe® Illustrator® CS6

Time-Rock Chart References: Gradstein, F. M., Ogg, J. G., and Smith, A. G., eds., 2004. A geologic time scale 2004. Cambridge, U.K.: Cambridge University Press, 369 p.; Ogg, J. G., Ogg, G., and Gradstein, F. M., 2008. The concise geologic time scale. Cambridge University Press, 177 p.

Field Work: Conducted in 2013 and 2014 by Thomas J. Wiley, Jason D. McLaughry, Lina Ma, Katherine A. Mickelson, Clark A. Niewendorf, and Heather H. Herinckx

Cartography: Daniel E. Coe


NOTICE: This map cannot serve as a substitute for site-specific investigations by qualified practitioners. Site-specific data may give results that differ from those shown on the map. The views and conclusions contained in this document are those of the authors and should not be interpreted as necessarily representing the official policies, either expressed or implied, of the U.S. government.



For copies of this publication contact:
Nature of the Northwest Information Center
800 NE Oregon Street, Ste. 965
Portland, OR 97232
Telephone (503) 673-2331
http://www.NatureNW.org

Attachment D: Historic Geotechnical Data

WATER JET PROBE RESULTS									
PROBE #	REFUSAL ELEV.	PROBE #	REFUSAL ELEV.	PROBE #	REFUSAL ELEV.	PROBE #	REFUSAL ELEV.	PROBE #	REFUSAL ELEV.
P.1	-8.3	P.16	-9.2	P.31	-5.6	P.46	-4.6	P.68	-9.7
P.2	-11.8	P.17	-11.0	P.32	-0.7	P.47	-11.5	P.69	-12.3
P.3	-7.2	P.18	-9.7	P.33	-1.8	P.48	-2.6	P.70	-15.7
P.4	-15.7	P.19	-9.6	P.34	-3.0	P.49	-1.5	P.71	-3.7
P.5	-15.7	P.20	-9.4	P.35	-4.0	P.50	-1.0	P.72	-15.3
P.6	-1.6	P.21	-9.1	P.36	-9.5	P.51	-0.4	P.73	-12.8
P.7	-4.5	P.22	-10.1	P.37	-9.5	P.52	-2.0	P.74	-5.6
P.8	-2.5	P.23	-11.0	P.38	-4.3	P.53	-1.8	P.81	-4.9
P.9	-2.4	P.24	-8.8	P.39	-11.1	P.54	-1.6	P.91	-4.3
P.10	-2.3	P.25	-10.7	P.40	-11.0	P.55	-1.6	P.92	-9.7
P.11	-4.3	P.26	-1.7	P.41	-12.0	P.56	-1.0	P.93	-4.6
P.12	-4.3	P.27	-1.7	P.42	-6.8	P.57	-0.9	P.94	-4.9
P.13	-0.3	P.28	-8.7	P.43	-10.7	P.58	-1.5		
P.14	-2.2	P.29	-7.7	P.44	-11.7	P.59	-1.5		
P.15	-4.2	P.30	-6.6	P.45	-3.6	P.62	-4.0		

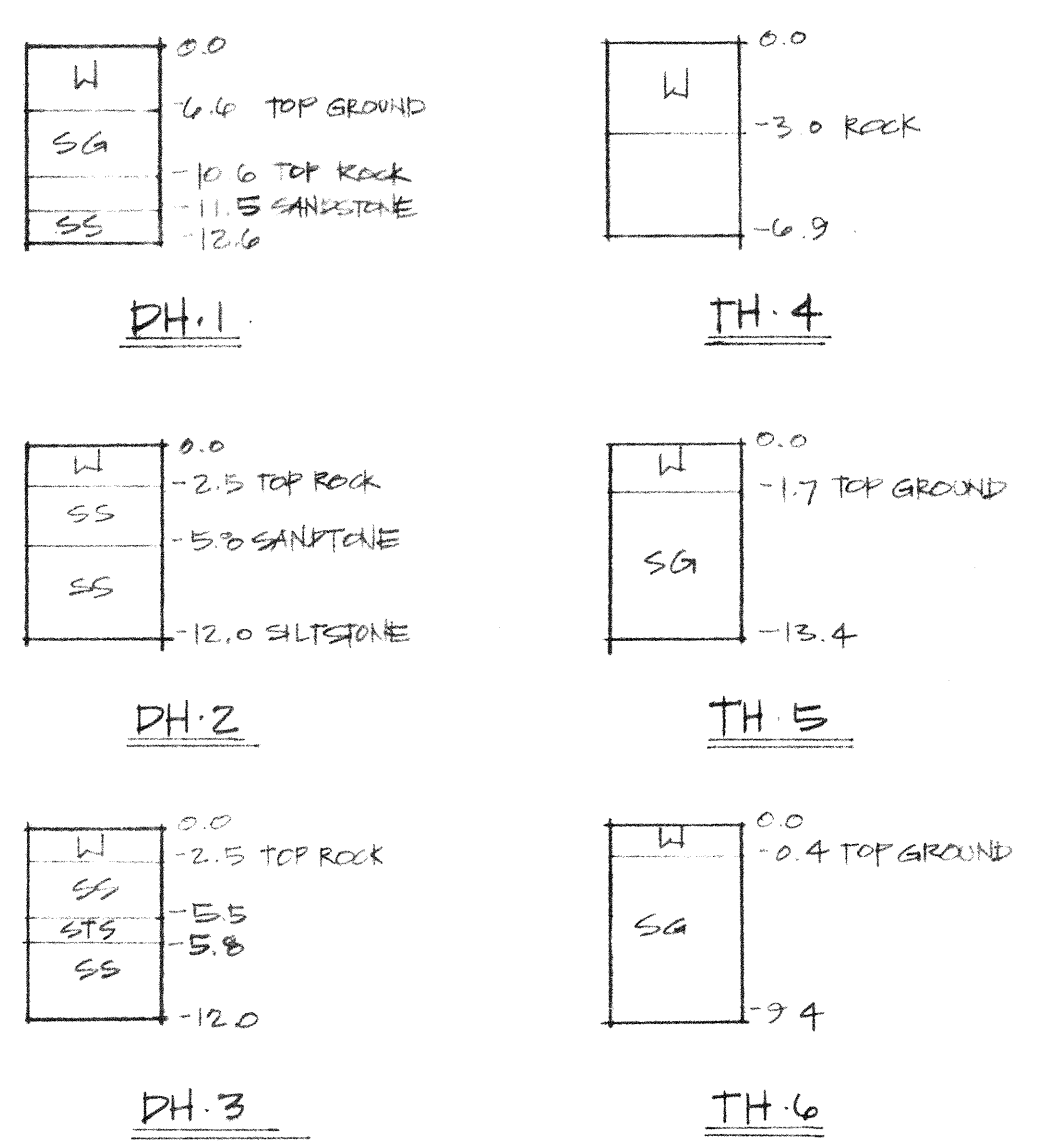

LEGEND


- EXISTING ELEVATION
- TOP OF RIP RAP SLOPE
- A.C. PAVEMENT
- EXISTING CONTOUR LINE W/ELEV.
- EXIST. TOP OF BANK
- EXIST. TOE OF BANK
- EXIST. EDGE OF GRAVEL

CORE DRILLING ABBREVIATIONS


- W - WATER
- SS - SANDSTONE
- STS - SILTSTONE
- SG - SAND AND GRAVEL

NOTES:

- INFERRED SANDSTONE/SILTSTONE ROCK CONTOURS FROM GEO. RECON INTERNATIONAL LTD'S GEO-PHYSICAL SURVEY.
- INFERRED SANDSTONE/SILTSTONE ROCK CONTOURS BASED ON GEOM. REFRACTION SURVEY RESULTS.
- ELEVATIONS SHOWN ARE MEAN LOWER LOW WATER (MLLW) DATUM.
- EXISTING ELEVATIONS AND SURFACE CONTOURS BASED ON SURVEYS OF AUGUST 11, 1980
- CORE DRILLING AND TRIGON DRILLING LOGS AND PROBE RESULTS, P.1 THRU P.59 FROM US. ARMY CORP OF ENGINEERS' SURVEYS OF JUNE 1978.
- PROBE RESULTS P.60 THRU P.101, FROM US. ARMY CORP OF ENGINEERS' SURVEYS OF FEBRUARY, 1982.
- BEARING - LAMBERT PROJECTION OF OREGON, SOUTH ZONE

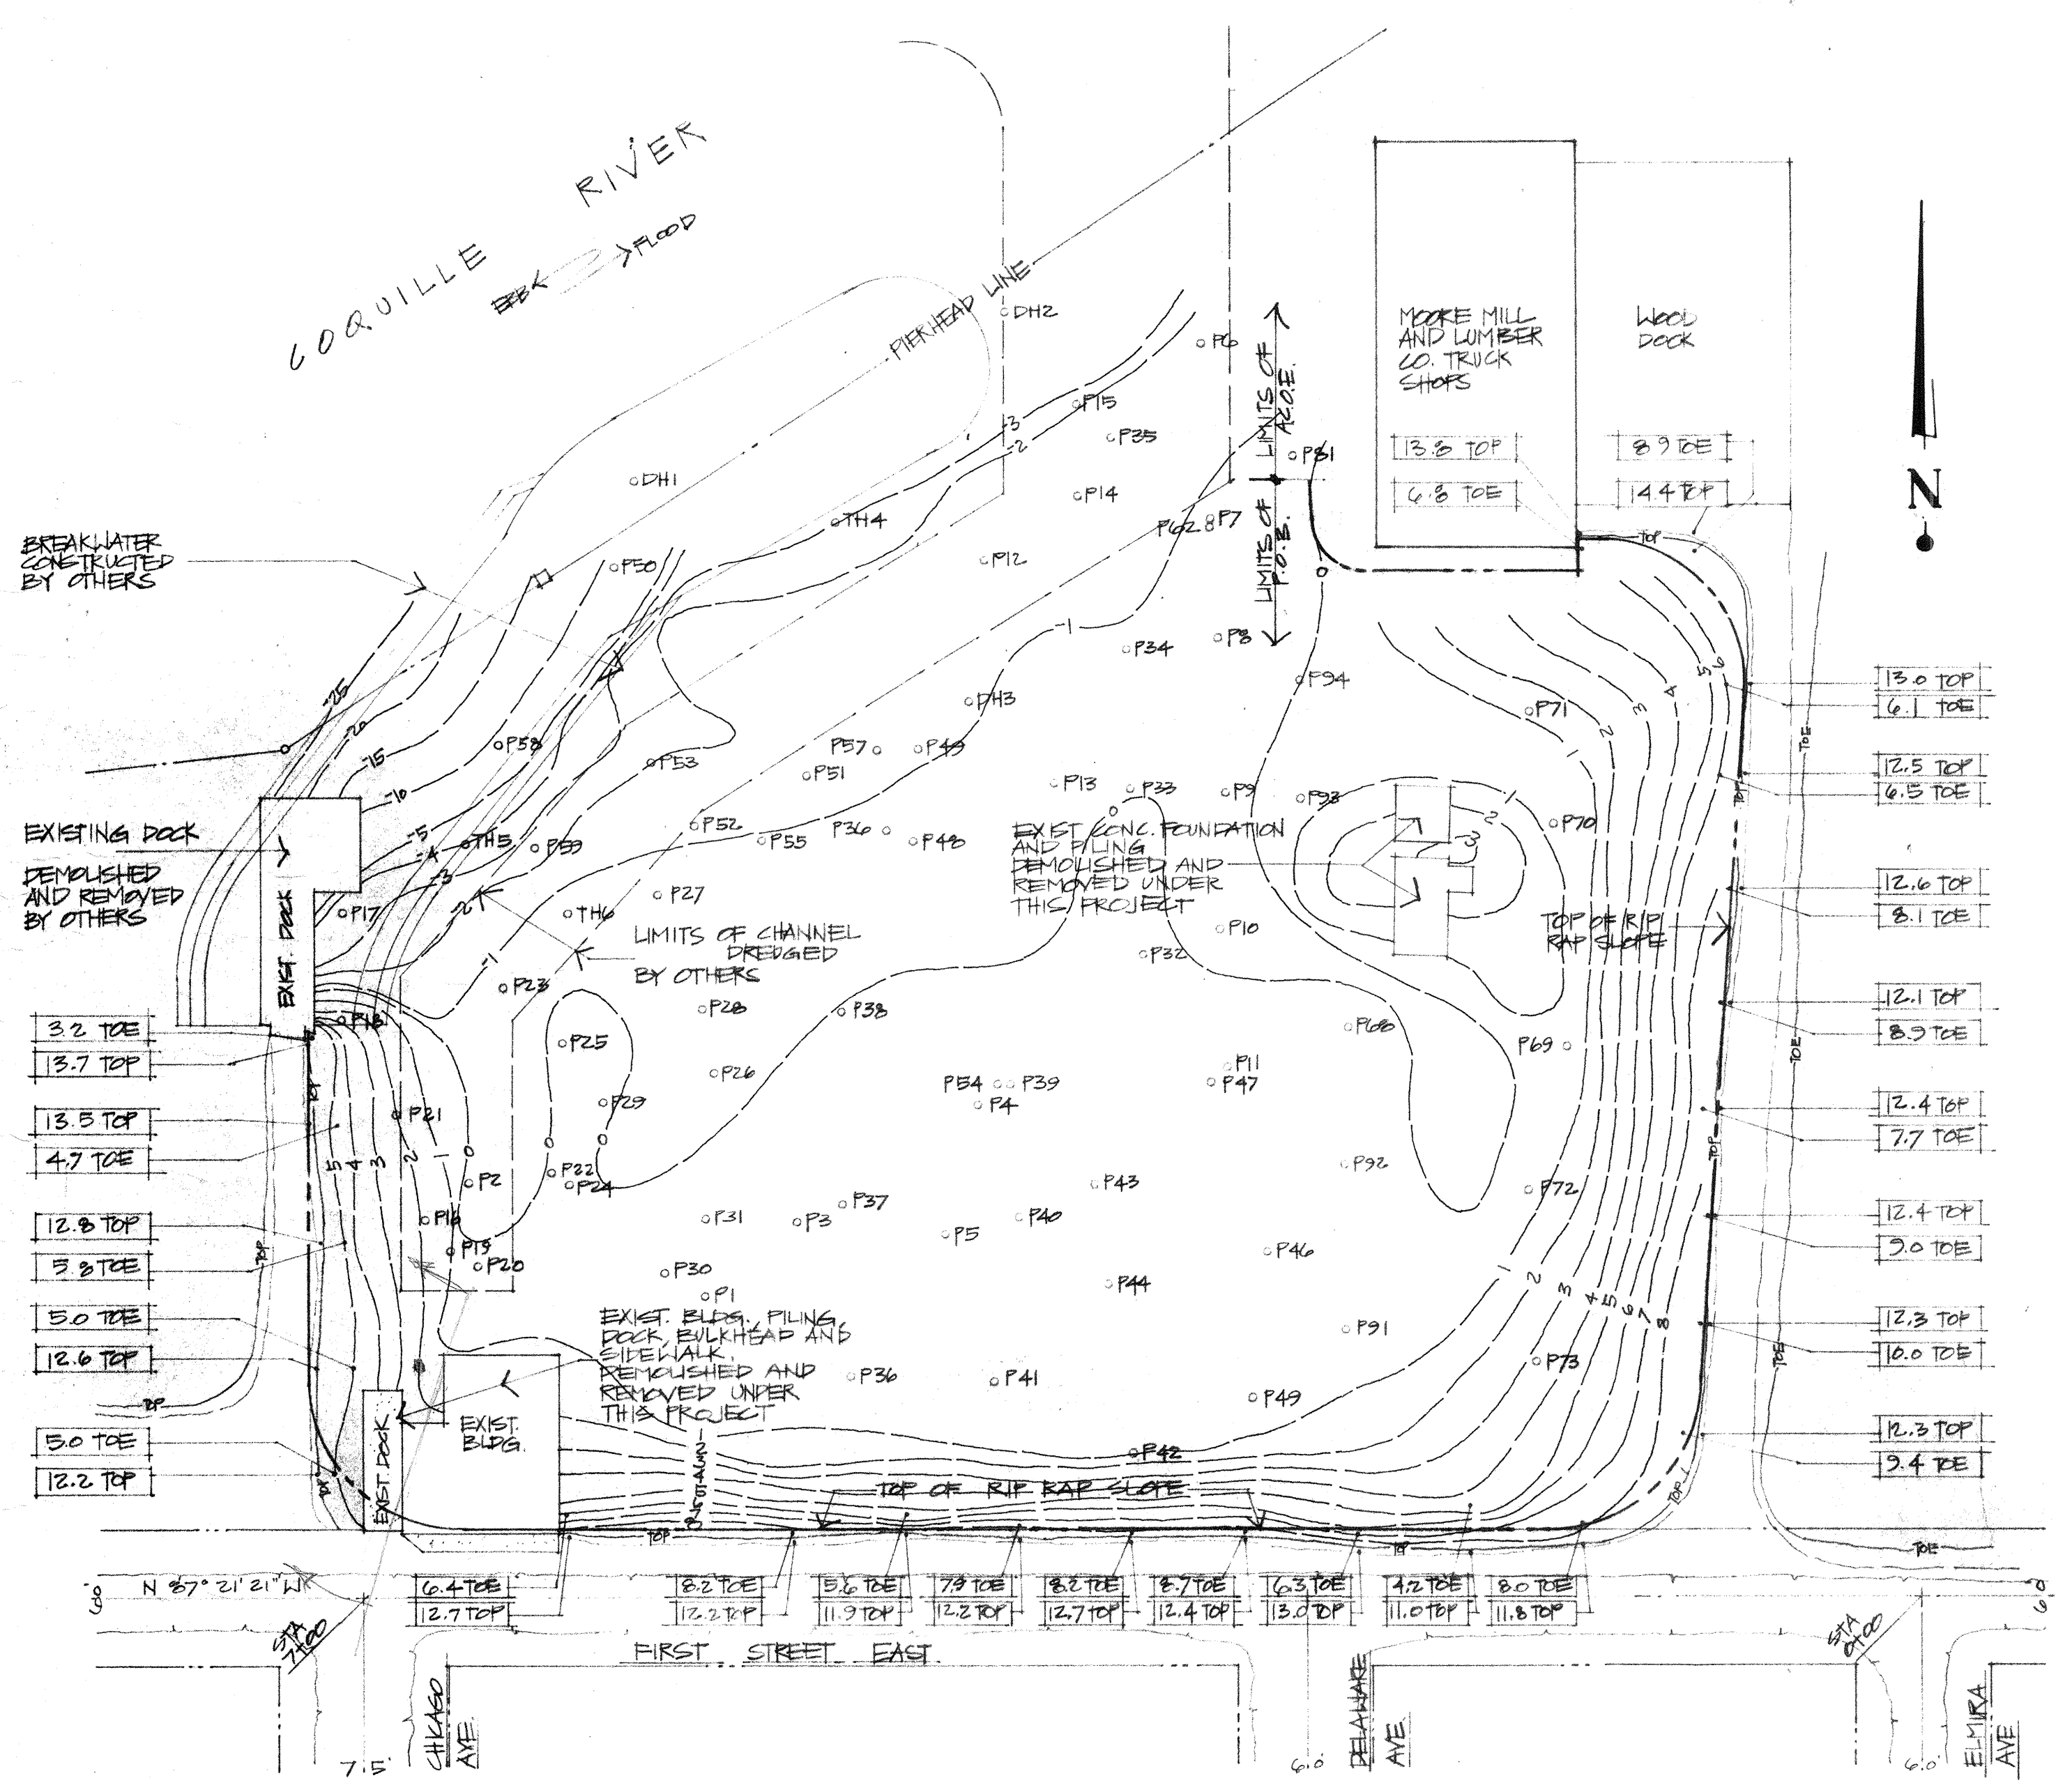

SURFACE CONTOURS AND DEMOLITION PLAN
 1" = 60'

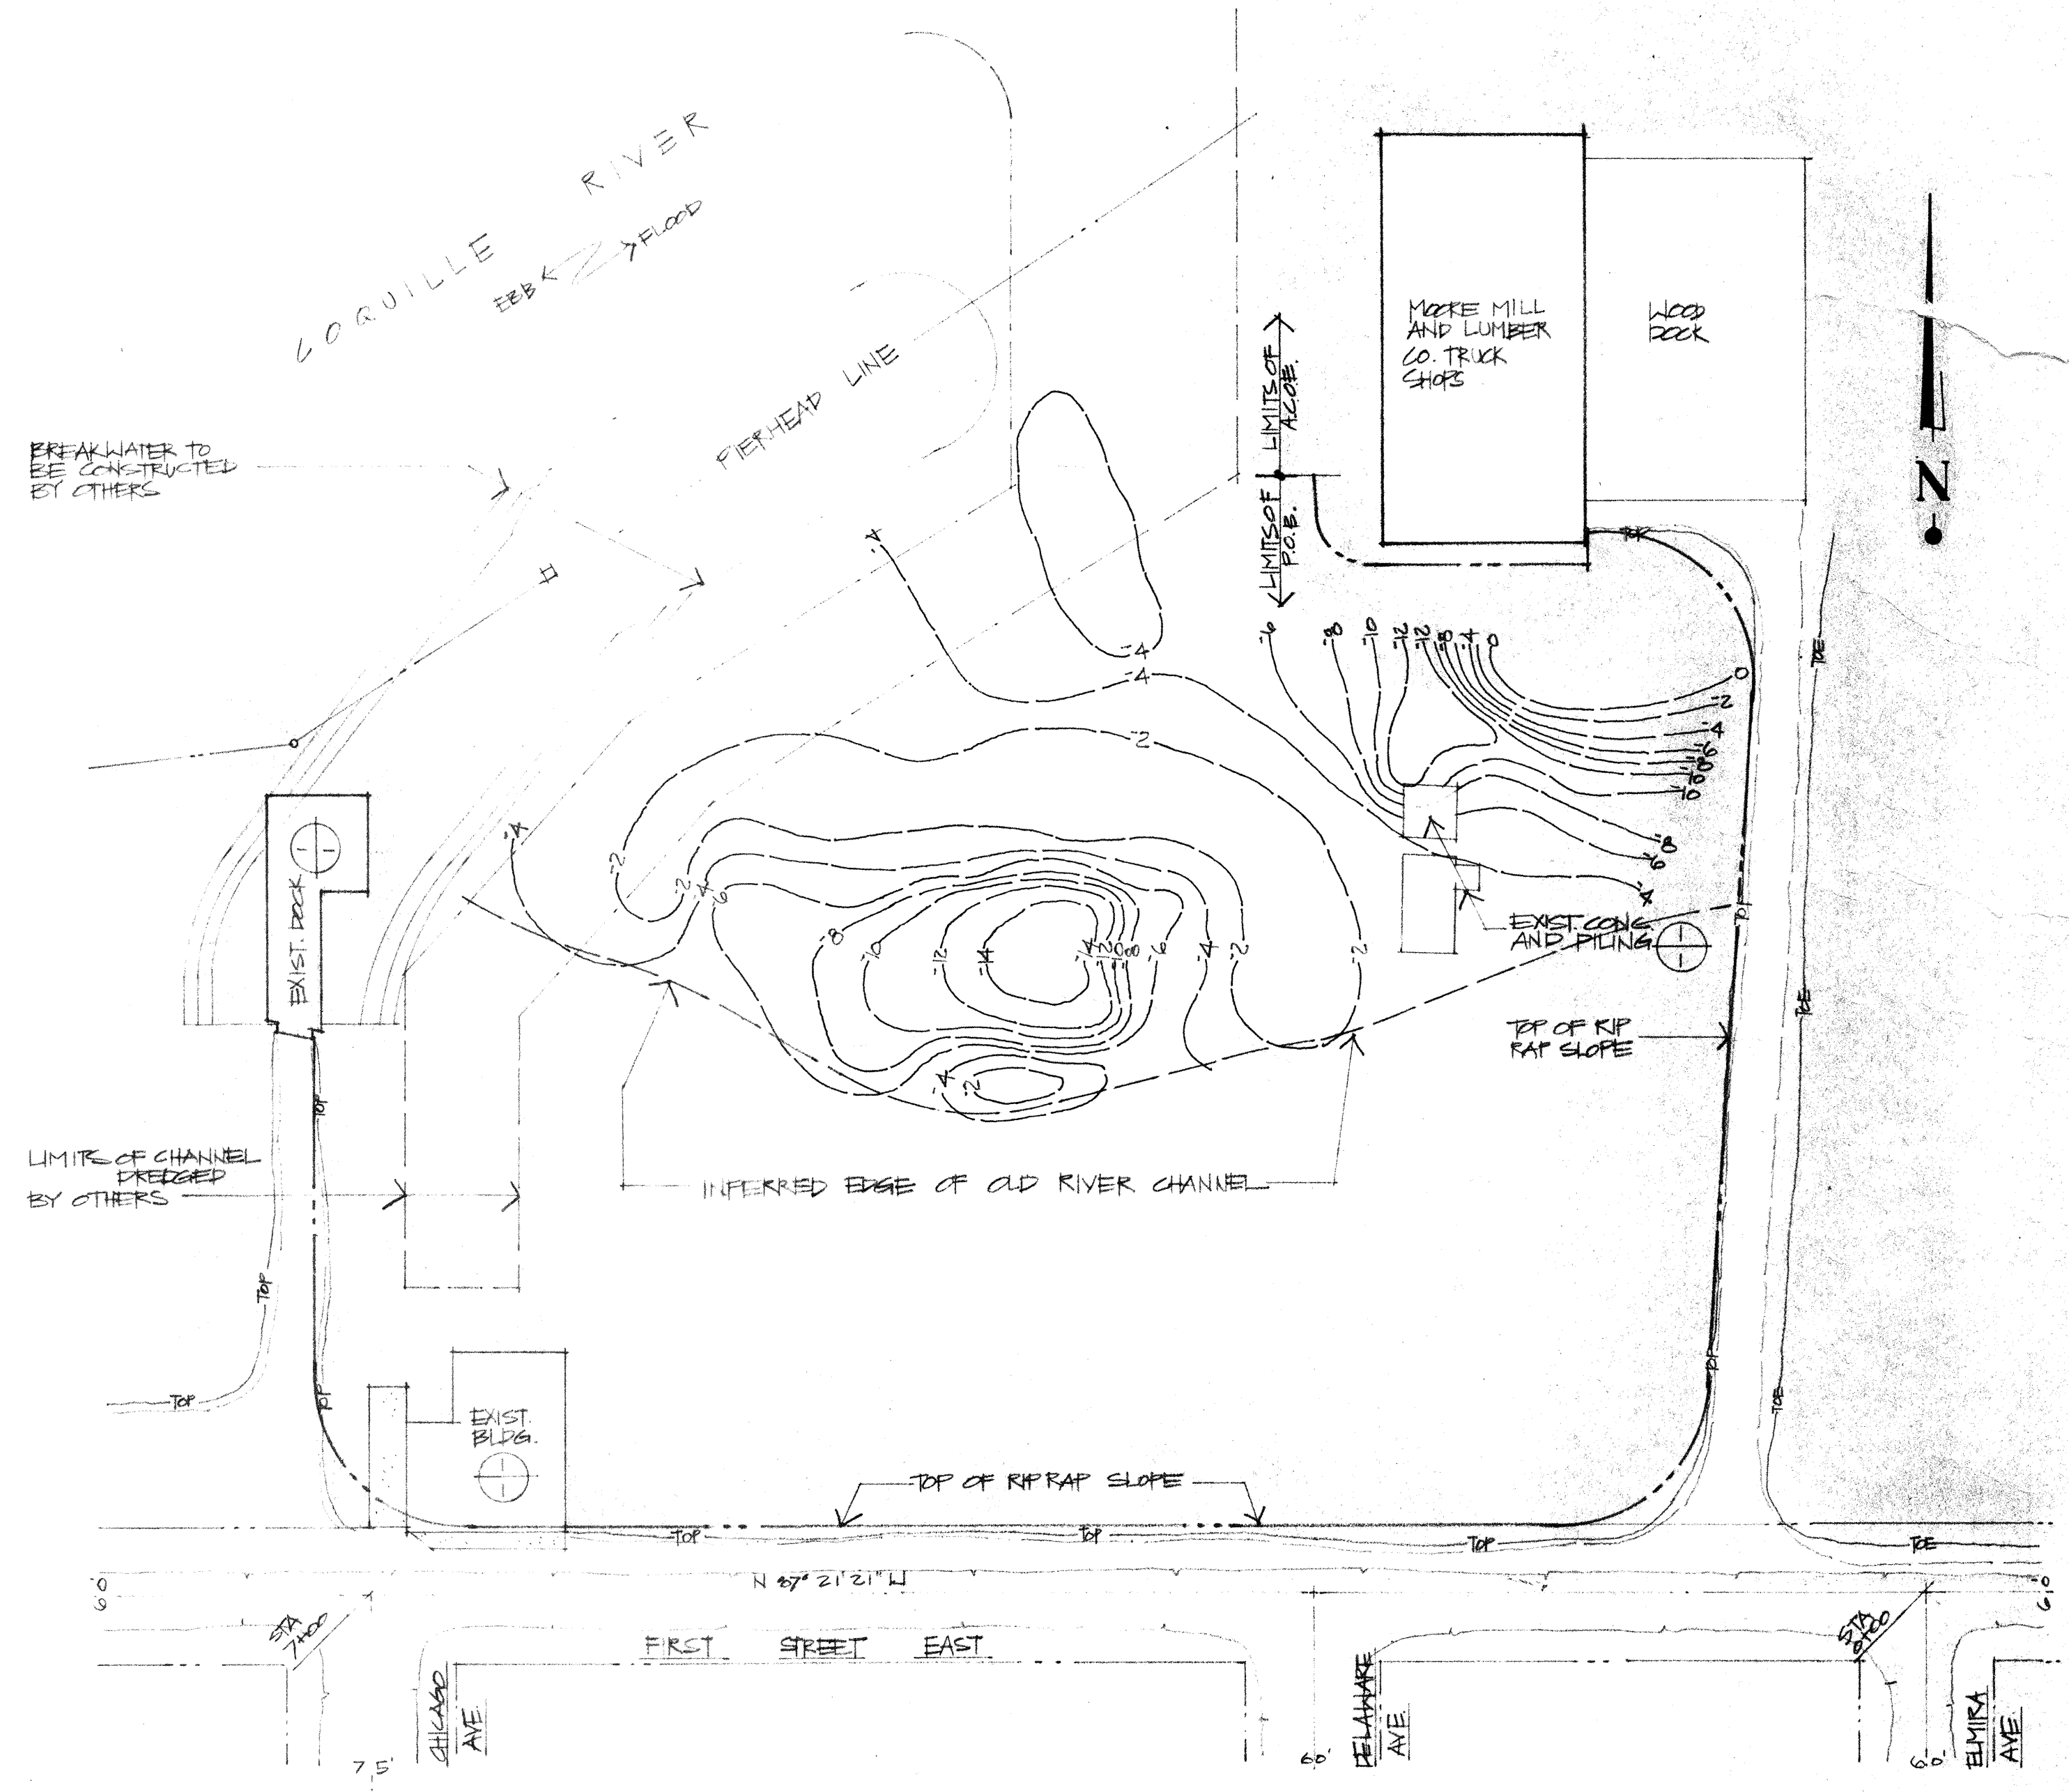


INFERRED ROCK CONTOURS
 1" = 60'













Attachment E: Wave and Wind Loading on Piles

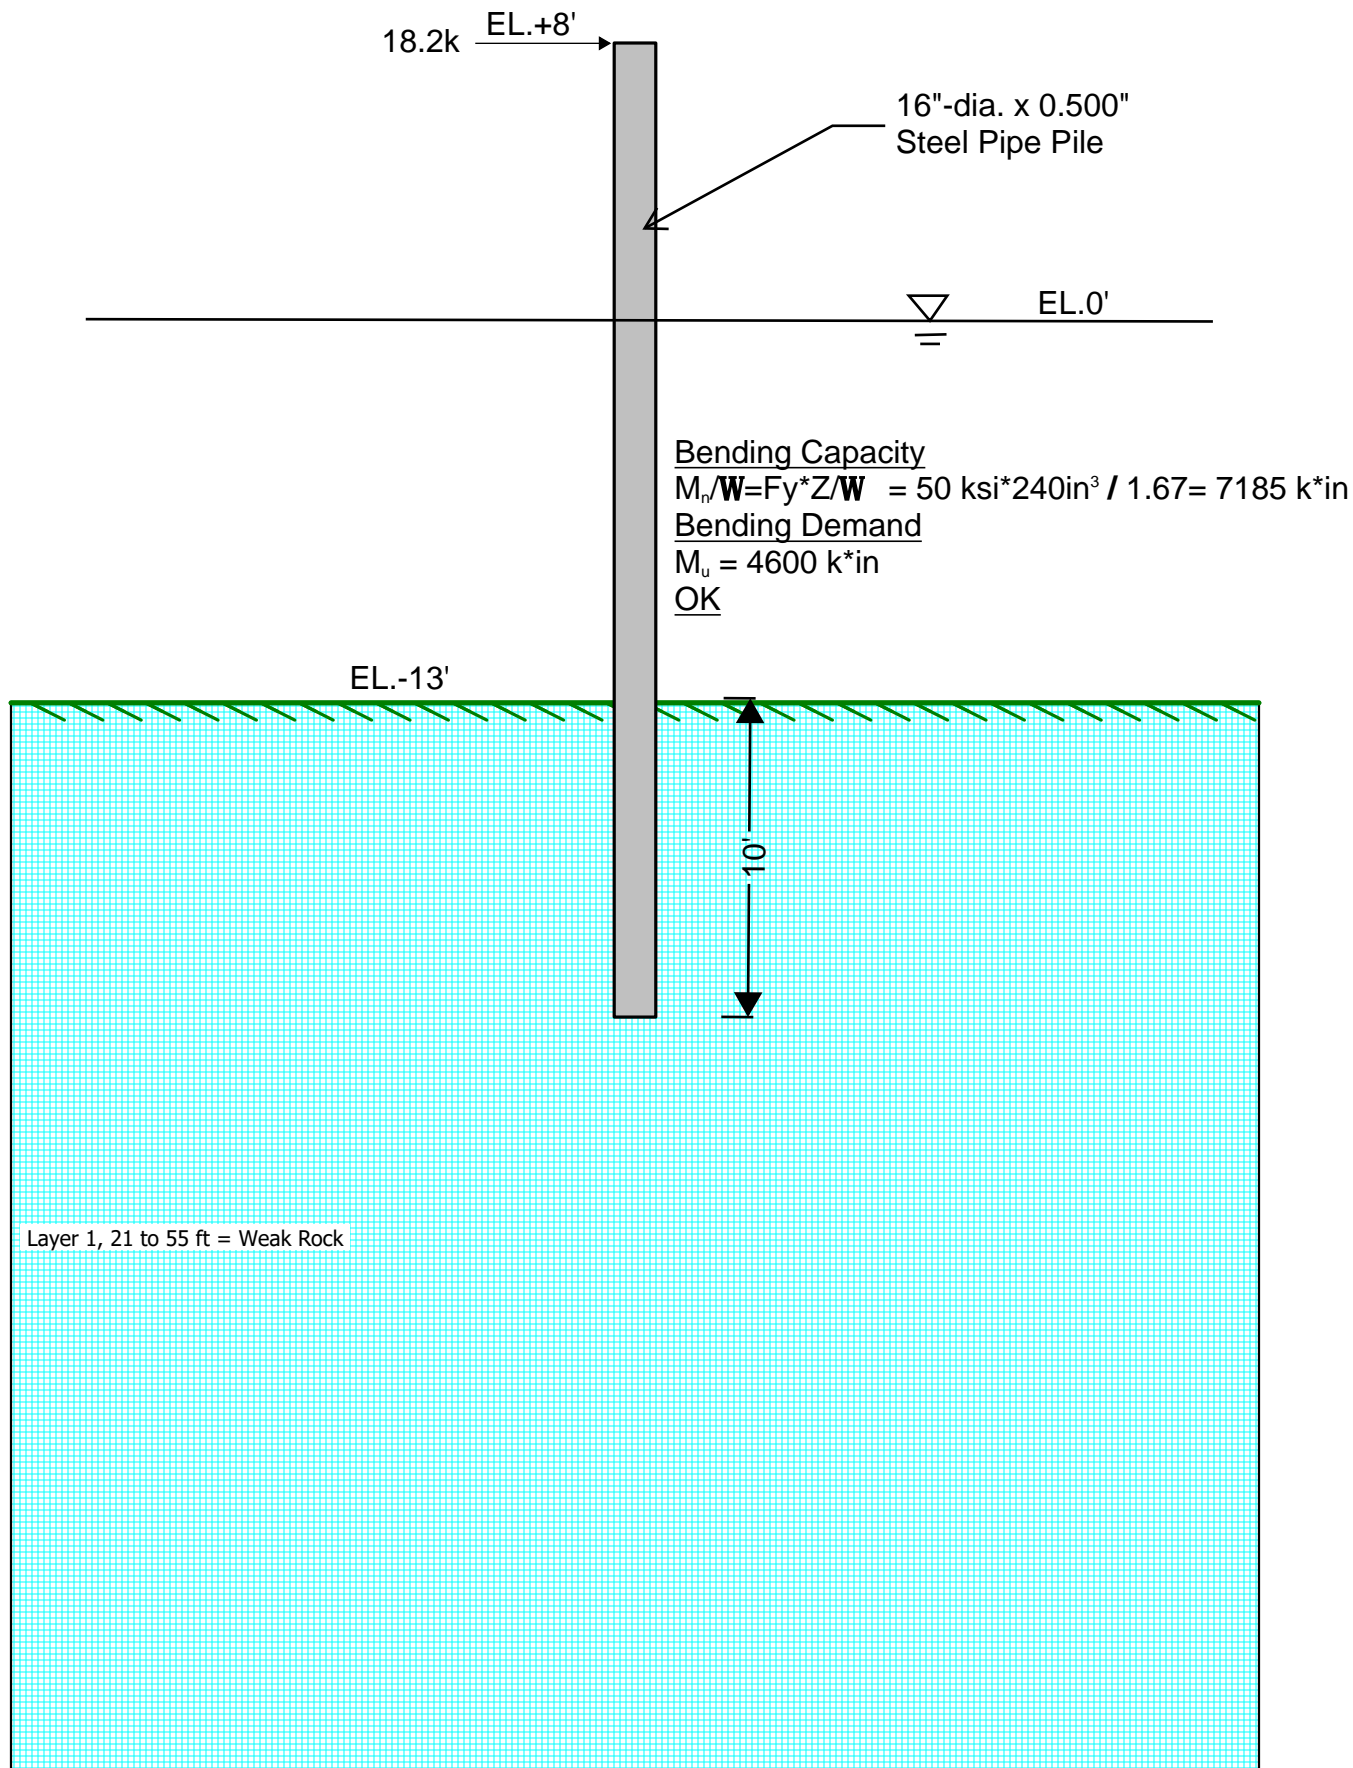

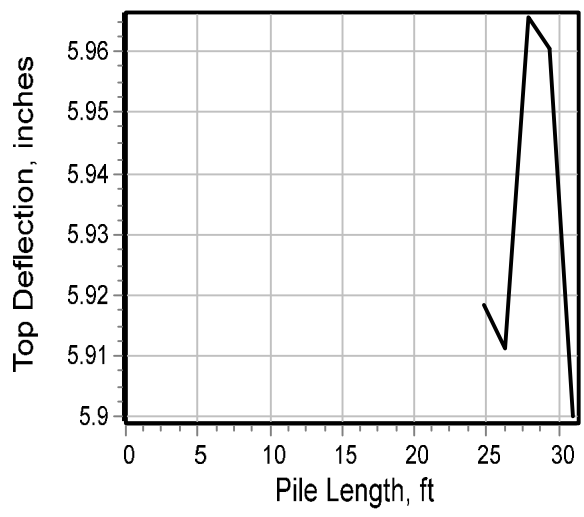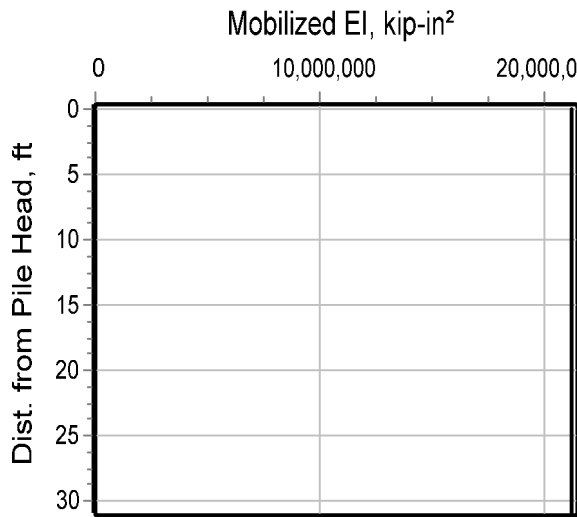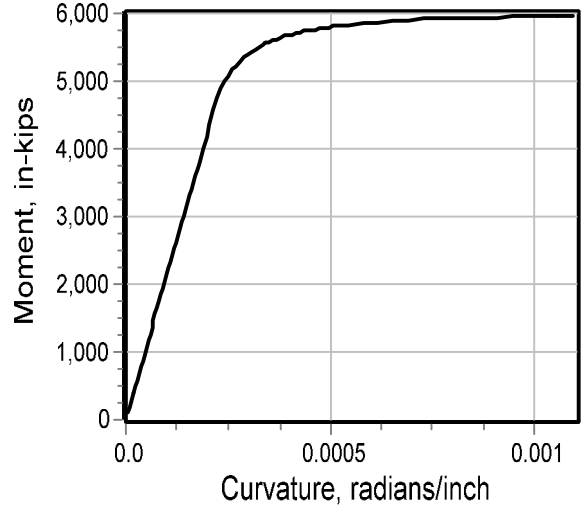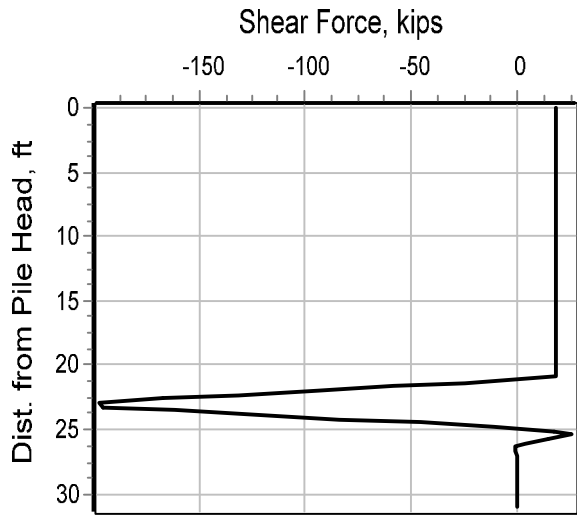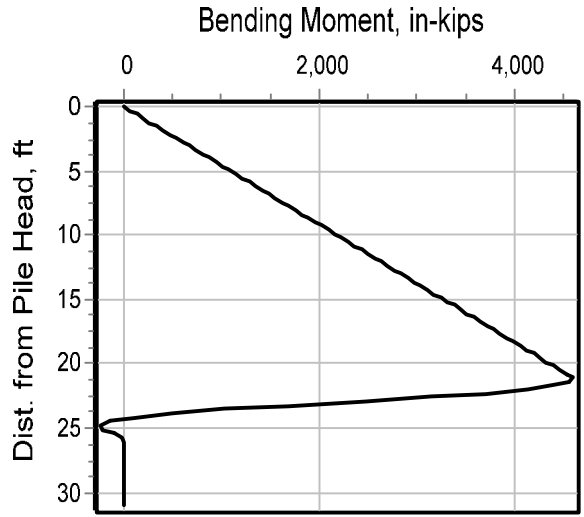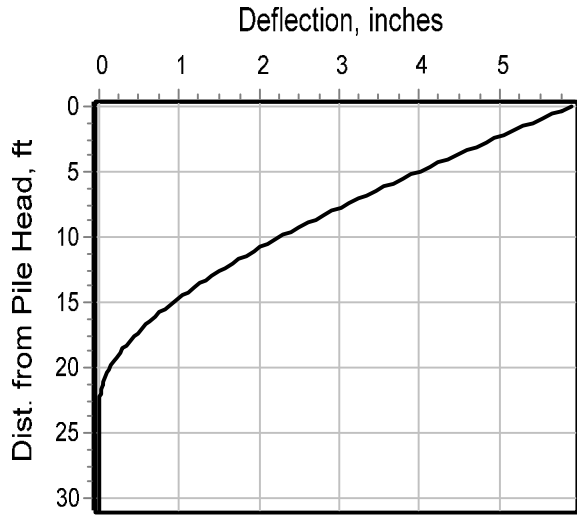

WAVE LOADING ON FLOAT C


NOTES

$H_s = 2.3'$

$H_p = 4.3'$

$T_p = 2.5s$

$H_{max} = 4.3'$

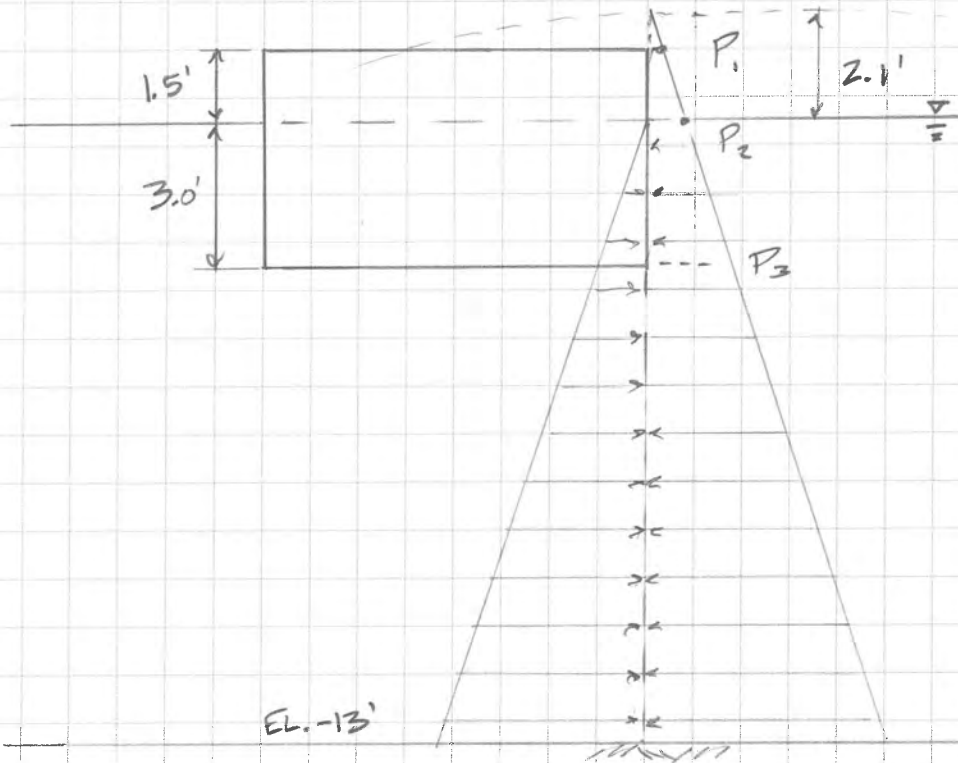

$P_1 = 64 \text{ psf} (0.6') = 39 \text{ psf}$


$P_2 = 64 \text{ psf} (2.1') = 134 \text{ psf}$

$P_3 = 64 \text{ psf} (2.1' + 3' - 3') = 134 \text{ psf}$

TOTAL FORCE = $[(134 \text{ psf} + 39 \text{ psf}) / 2] \times 1.5' + [(134 \text{ psf})] \times 3'$
 $= 532 \text{ plf}$

LOAD TO PILE = $532 \text{ plf} \times 18.7' \text{ o.c.} = 10 \text{ k/pile}$

WIND LOADING ON FLOAT 'C' NOTES

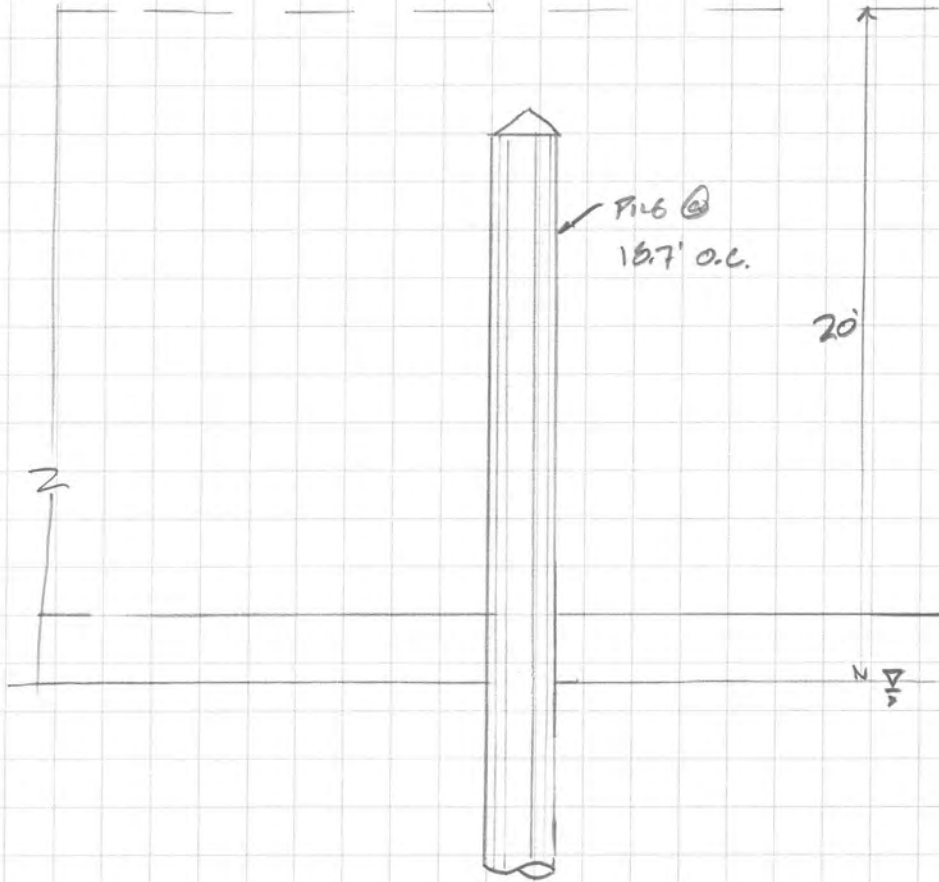

$A_{\text{PILE}} = 374 \text{ ft}^2$

WIND PRESSURE = $p = C_p \cdot 0.00256 V^2$
 $= 1.2 (0.00256) (85 \text{ mph})^2 = 22 \text{ psf}$

$P_{\text{WIND}} = p \cdot A = 22 \text{ psf} \cdot 374 \text{ ft}^2 = 8.2 \text{ k}$

TOTAL LOAD PER PILE = WAVE + WIND
 $= 10 \text{ k} + 8.2 \text{ k} = 18.2 \text{ k/pile}$

CURRENT IN
 BASIN IS NEGLIGIBLE